

TEMPORARY EDGE PROTECTION

1. IN THE EVENT THAT THE DECONSTRUCTED BALUSTRADE CANNOT BE RECONSTRUCTED, TEMPORARY EDGE PROTECTION NEEDS TO BE PROVIDED.
2. THE SCAFFOLDING FOR THE EDGE PROTECTION NEEDS TO BE INSTALLED BY A QUALIFIED SCAFFOLDER.
3. THE EXISTING SCAFFOLD NEEDS TO BE RETAINED AND NOT INTERFERED WITH.

NOTES

1. THIS DRAWING IS TO BE READ IN CONJUNCTION WITH ALL RELEVANT DRAWINGS, DETAILS AND SPECIFICATIONS.
2. CDM DETAILS REFERS TO THE CONSTRUCTION (DESIGN AND MANAGEMENT) REGULATIONS. THE READER MUST REFER TO METHOD STATEMENTS OR RISK ASSESSMENTS AS APPROPRIATE, WHICH IDENTIFY UNUSUAL AND ABNORMAL RISKS THAT A COMPETENT CONTRACTOR COULD NOT BE EXPECTED TO ANTICIPATE.

CDM DETAILS (Refer note 2)

ENG

Hurst Peirce + Malcolm LLP
CONSULTING CIVIL & STRUCTURAL ENGINEERS

HPM

CELTIC HOUSE
33 JOHN'S MEWS
HOLBORN
LONDON WC1N 2QL

©
TEL: 020 7242 3593
FAX: 020 7405 5274

E-MAIL:
enquiries@hurstpm.co.uk

WEB PAGE
www.hurstpm.co.uk

Architect

Project

CEPC CHESTER TERRACE

Status

FOR COMMENT

Scale

1:20 APPROX. AT A3


Title

**BALUSTRADE
DECONSTRUCTION
SHEET 2**

Drawn DMC	Checked	Passed	Date SEPT 20
--------------	---------	--------	-----------------

Drawing No.

24509/SK12

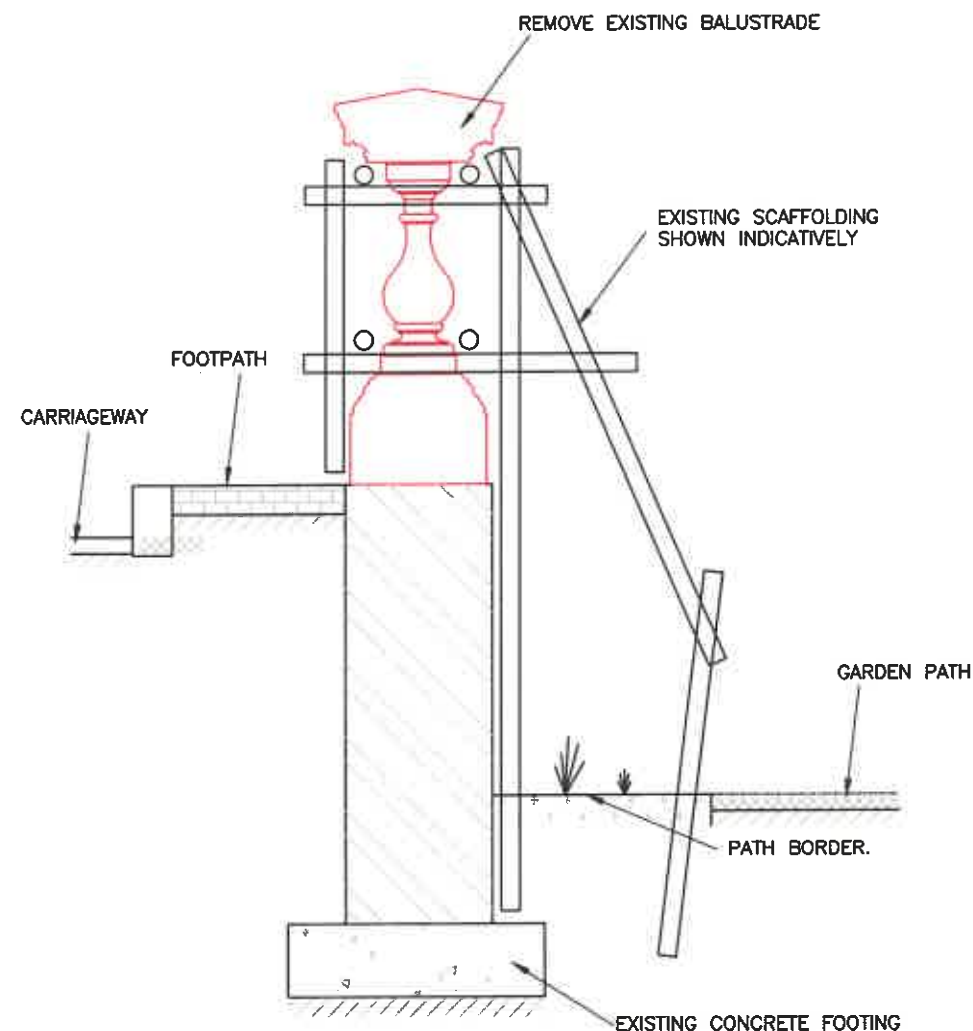

CROSS SECTION SHOWING
DECONSTRUCTION OF
BALUSTRADE

DECONSTRUCTION OF EXISTING BALUSTRADE

1. CONTRACTOR TO PROVIDE METHOD STATEMENT PRIOR TO ANY WORKS. CONTRACTOR TO BE AWARE OF THE REGULATIONS BY CEPC FOR UNDERTAKING WORKS ON THE ESTATE. NOTE ROAD TRAFFIC AND THE NEED TO PROVIDE PROTECTION AROUND THE WORKS AREA.
2. PRIOR TO REMOVAL MARK-UP INDIVIDUAL COMPONENTS SO THAT THEY CAN BE PUT BACK IN THE SAME LOCATIONS.
3. WITHIN THE 2 VERTICAL RED LINES SHOWN ON THE PHOTO (I.E. WITHIN 1 BAY), CAREFULLY REMOVE THE CONCRETE PLINTHS, BOTTLES, DI-BLOCK AND PLINTHS DOWN TO THE TOP OF THE EXISTING BRICK WALL.
4. EXISTING SCAFFOLD RESTRAINT TO BE RETAINED AS FAR AS POSSIBLE.
5. DURING THE DECONSTRUCTION, NOTE THE PRESENCE OF ANY FIXINGS AND PHOTOGRAPH EACH ONE FOR RECORD PURPOSES.
6. SAVE ALL COMPONENTS FOR RE-INSTALLATION.
7. ALLOW FOR INSPECTION BY HPM, CEPC, ETC.
8. RECONSTRUCT BALUSTRADE USING EXISTING FIXINGS AS NECESSARY. USE NEW CEMENT MORTAR.
9. REINSTATE EXISTING SCAFFOLD.

- 1) Do we want to do the analysis on the work section?
- 2) Do we want to lift the parapet?
- 3) why such a long section?



SITE PHOTOS

NOTES

1. THIS DRAWING IS TO BE READ IN CONJUNCTION WITH ALL RELEVANT DRAWINGS, DETAILS AND SPECIFICATIONS.
2. CDM DETAILS REFERS TO THE CONSTRUCTION (DESIGN AND MANAGEMENT) REGULATIONS. THE READER MUST REFER TO METHOD STATEMENTS OR RISK ASSESSMENTS AS APPROPRIATE, WHICH IDENTIFY UNUSUAL AND ABNORMAL RISKS THAT A COMPETENT CONTRACTOR COULD NOT BE EXPECTED TO ANTICIPATE.

CDM DETAILS (Refer note 2)

No	Revision	By	Chk'd	Passed	Date

ENG

Hurst Peirce + Malcolm LLP **HPM**
CONSULTING CIVIL & STRUCTURAL ENGINEERS

CELTIC HOUSE
33 JOHN'S MEWS
HOLBORN
LONDON WC1N 2QL
©
TEL: 020 7242 3593
FAX: 020 7405 5274

E-MAIL: enquiries@hurstm.co.uk
WEB PAGE: www.hurstm.co.uk

Architect

Project

CEPC CHESTER TERRACE

Status

FOR COMMENT

Scale

1:20 APPROX. AT A3

Title

BALUSTRADE
DECONSTRUCTION
SHEET 1

Drawn DMC	Checked	Passed	Date SEPT 20
--------------	---------	--------	-----------------

Drawing No.
24509/SK11