



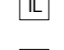




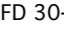


NOTE:
- These plans are for identification purposes only

LEGEND.

-  Non maintained Emergency Lighting Unit
-  Maintained Emergency Lighting Unit
-  Heat Detector
-  Smoke Detector
-  Illuminated Exit Sign
-  Push pad to open lock
-  2Kg CO₂ Fire Extinguisher
-  9 litre H₂O Fire Extinguisher
-  Fire Alarm Break glass call point
-  Fire Alarm panel
- FD 30-S Fire Door - 30 minutes - Keep Shut
- FD 30-KLS Fire Door - 30 minutes - Keep Locked Shut

B	Nov'07	As Built

Client:
Low Profile Holdings



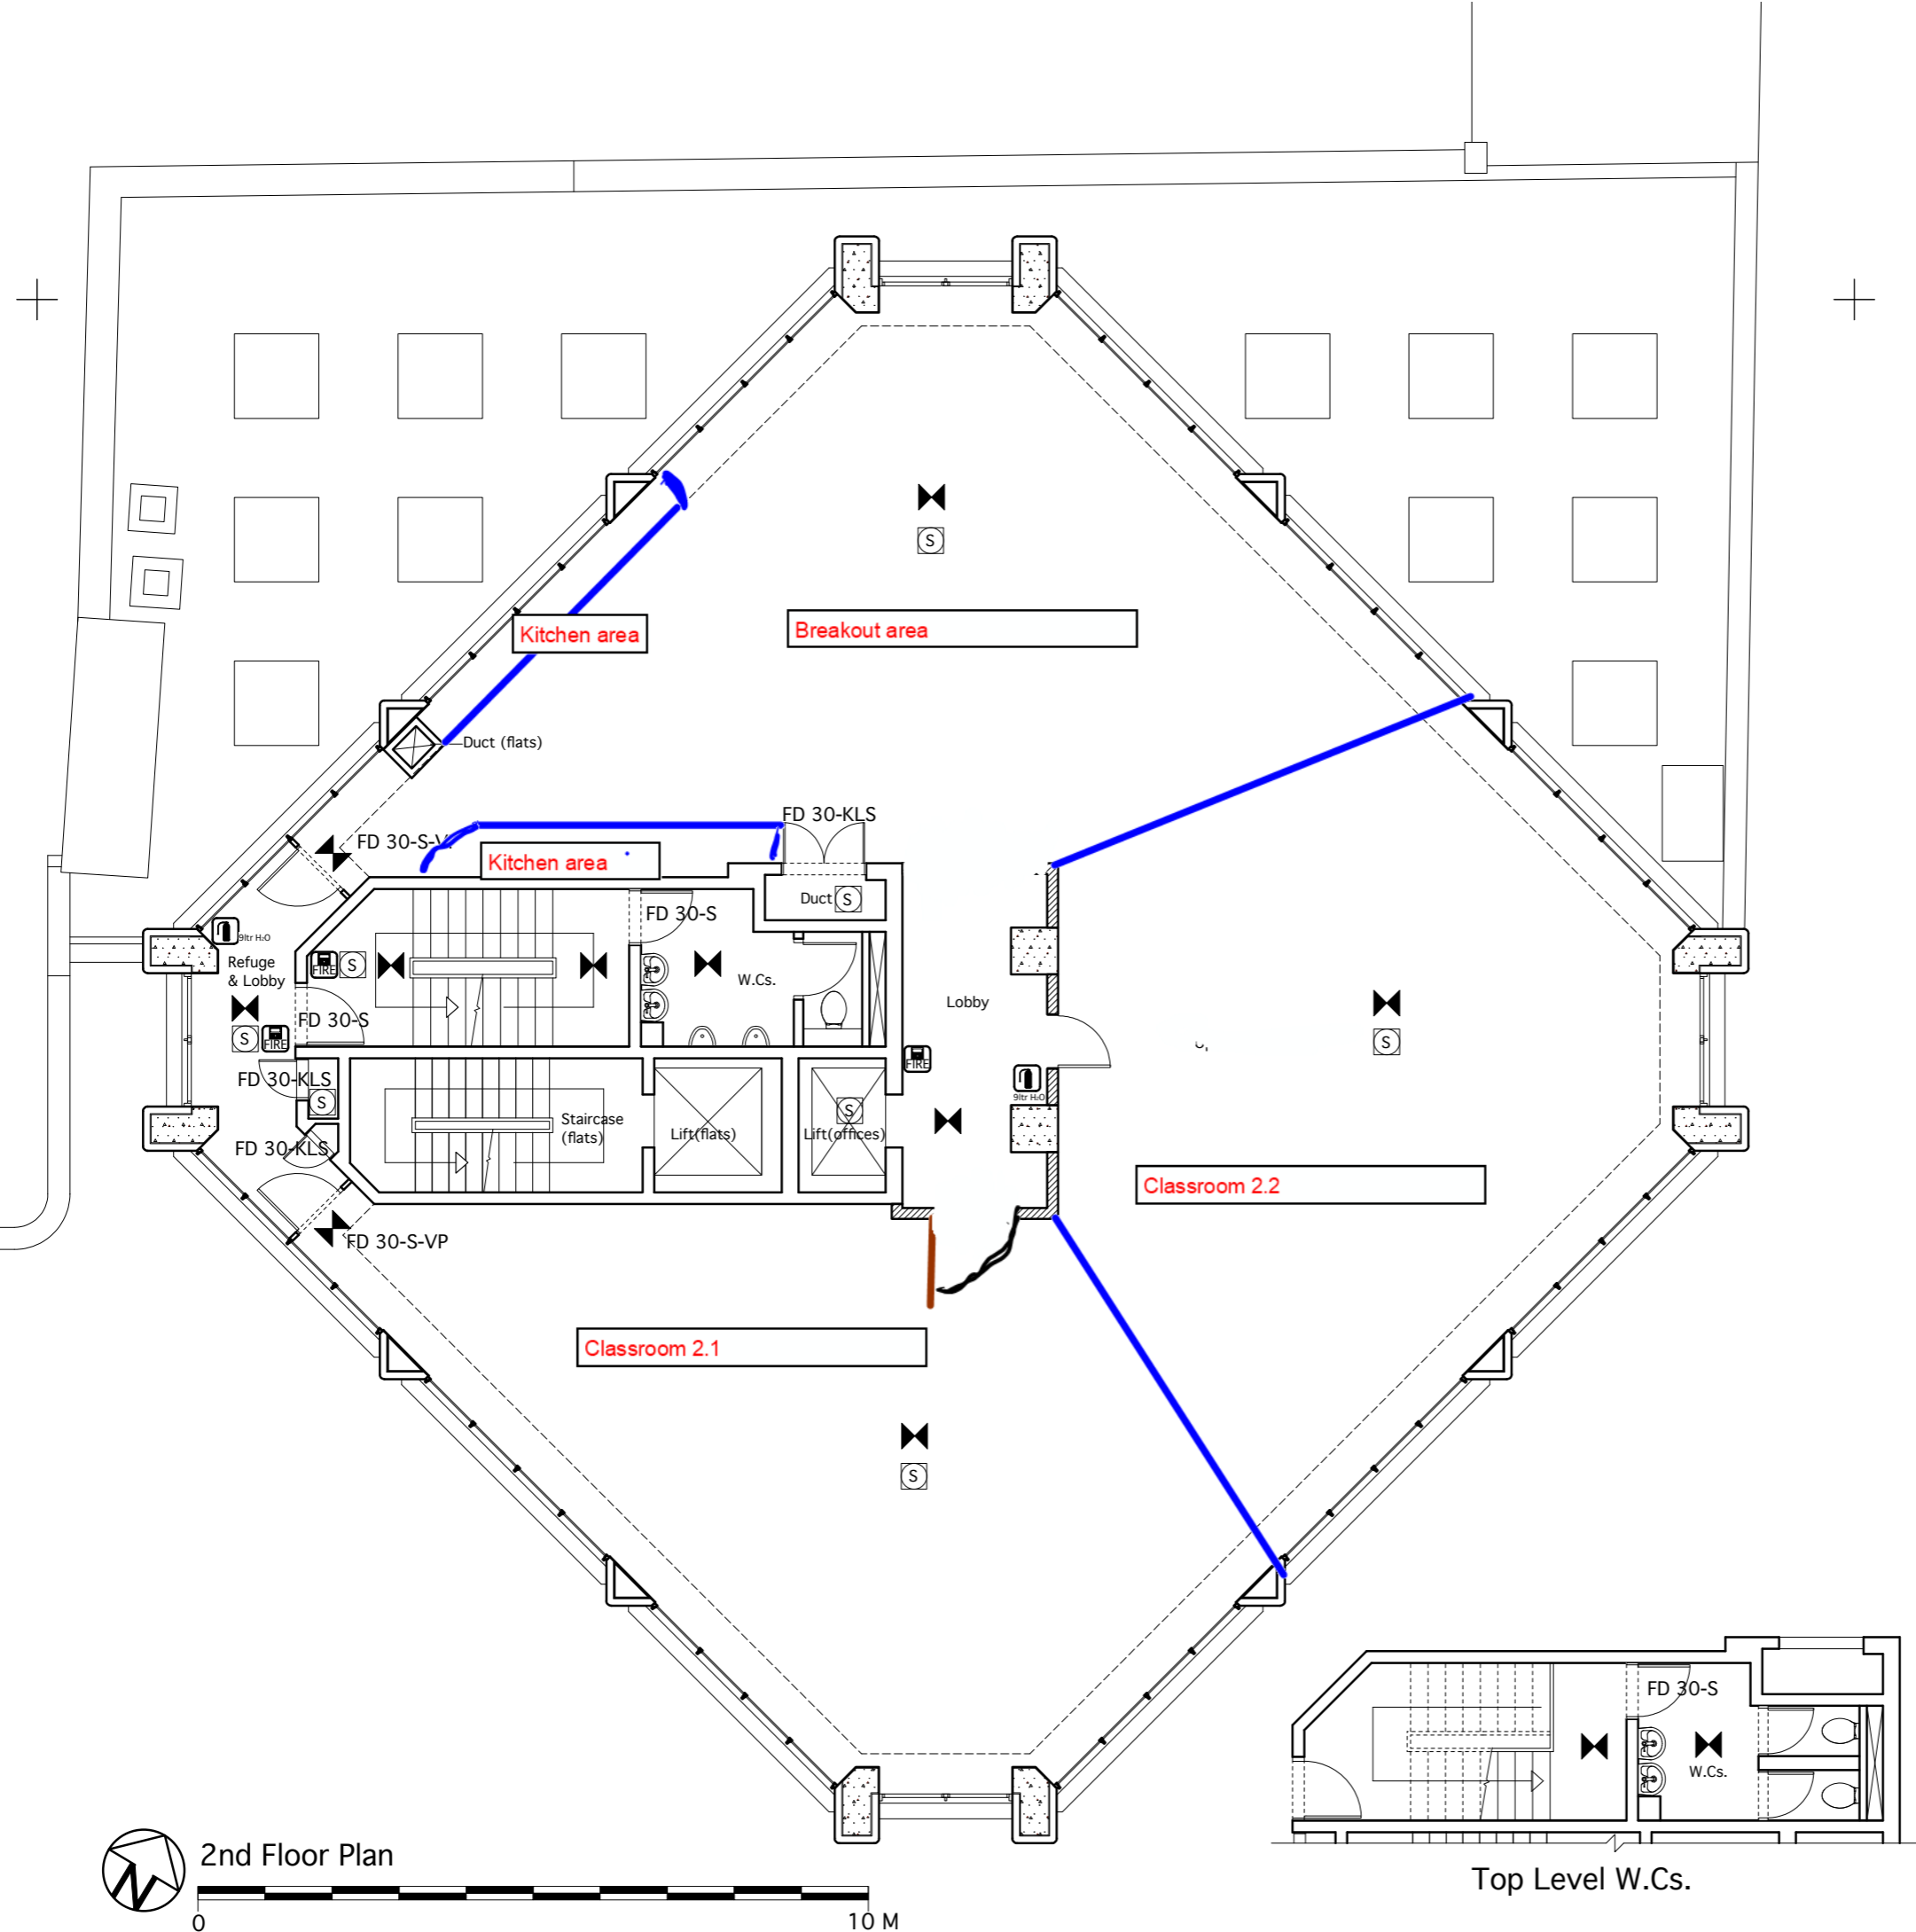
Project:
County House

Tenant Fit Out

Drawing:
**SECOND FLOOR
GENERAL ARRANGEMENT PLAN**

Design	B of Q	Tender	Construction	Record
Drawn by:	Date	Checked by:	Date	

scale:	see ruled scales	Drawing No.
	1:100 @A3	LCH/4/GA/12B
date:	Nov '07	



 **2nd Floor Plan**
0 10 M