


This drawing is the copyright of Axiom Architects. The contractor is to check all site dimensions and levels before work starts. This drawing must be read with and checked against all structural and other specialist drawings, specification and bills of quantities. Notify architect of any discrepancies. The contractor is to comply with all current British Standards and Building Regulations whether or not specifically stated on these drawings. **Do not scale** from drawings.



Rev	Date	Description	By	Chk
-----	------	-------------	----	-----

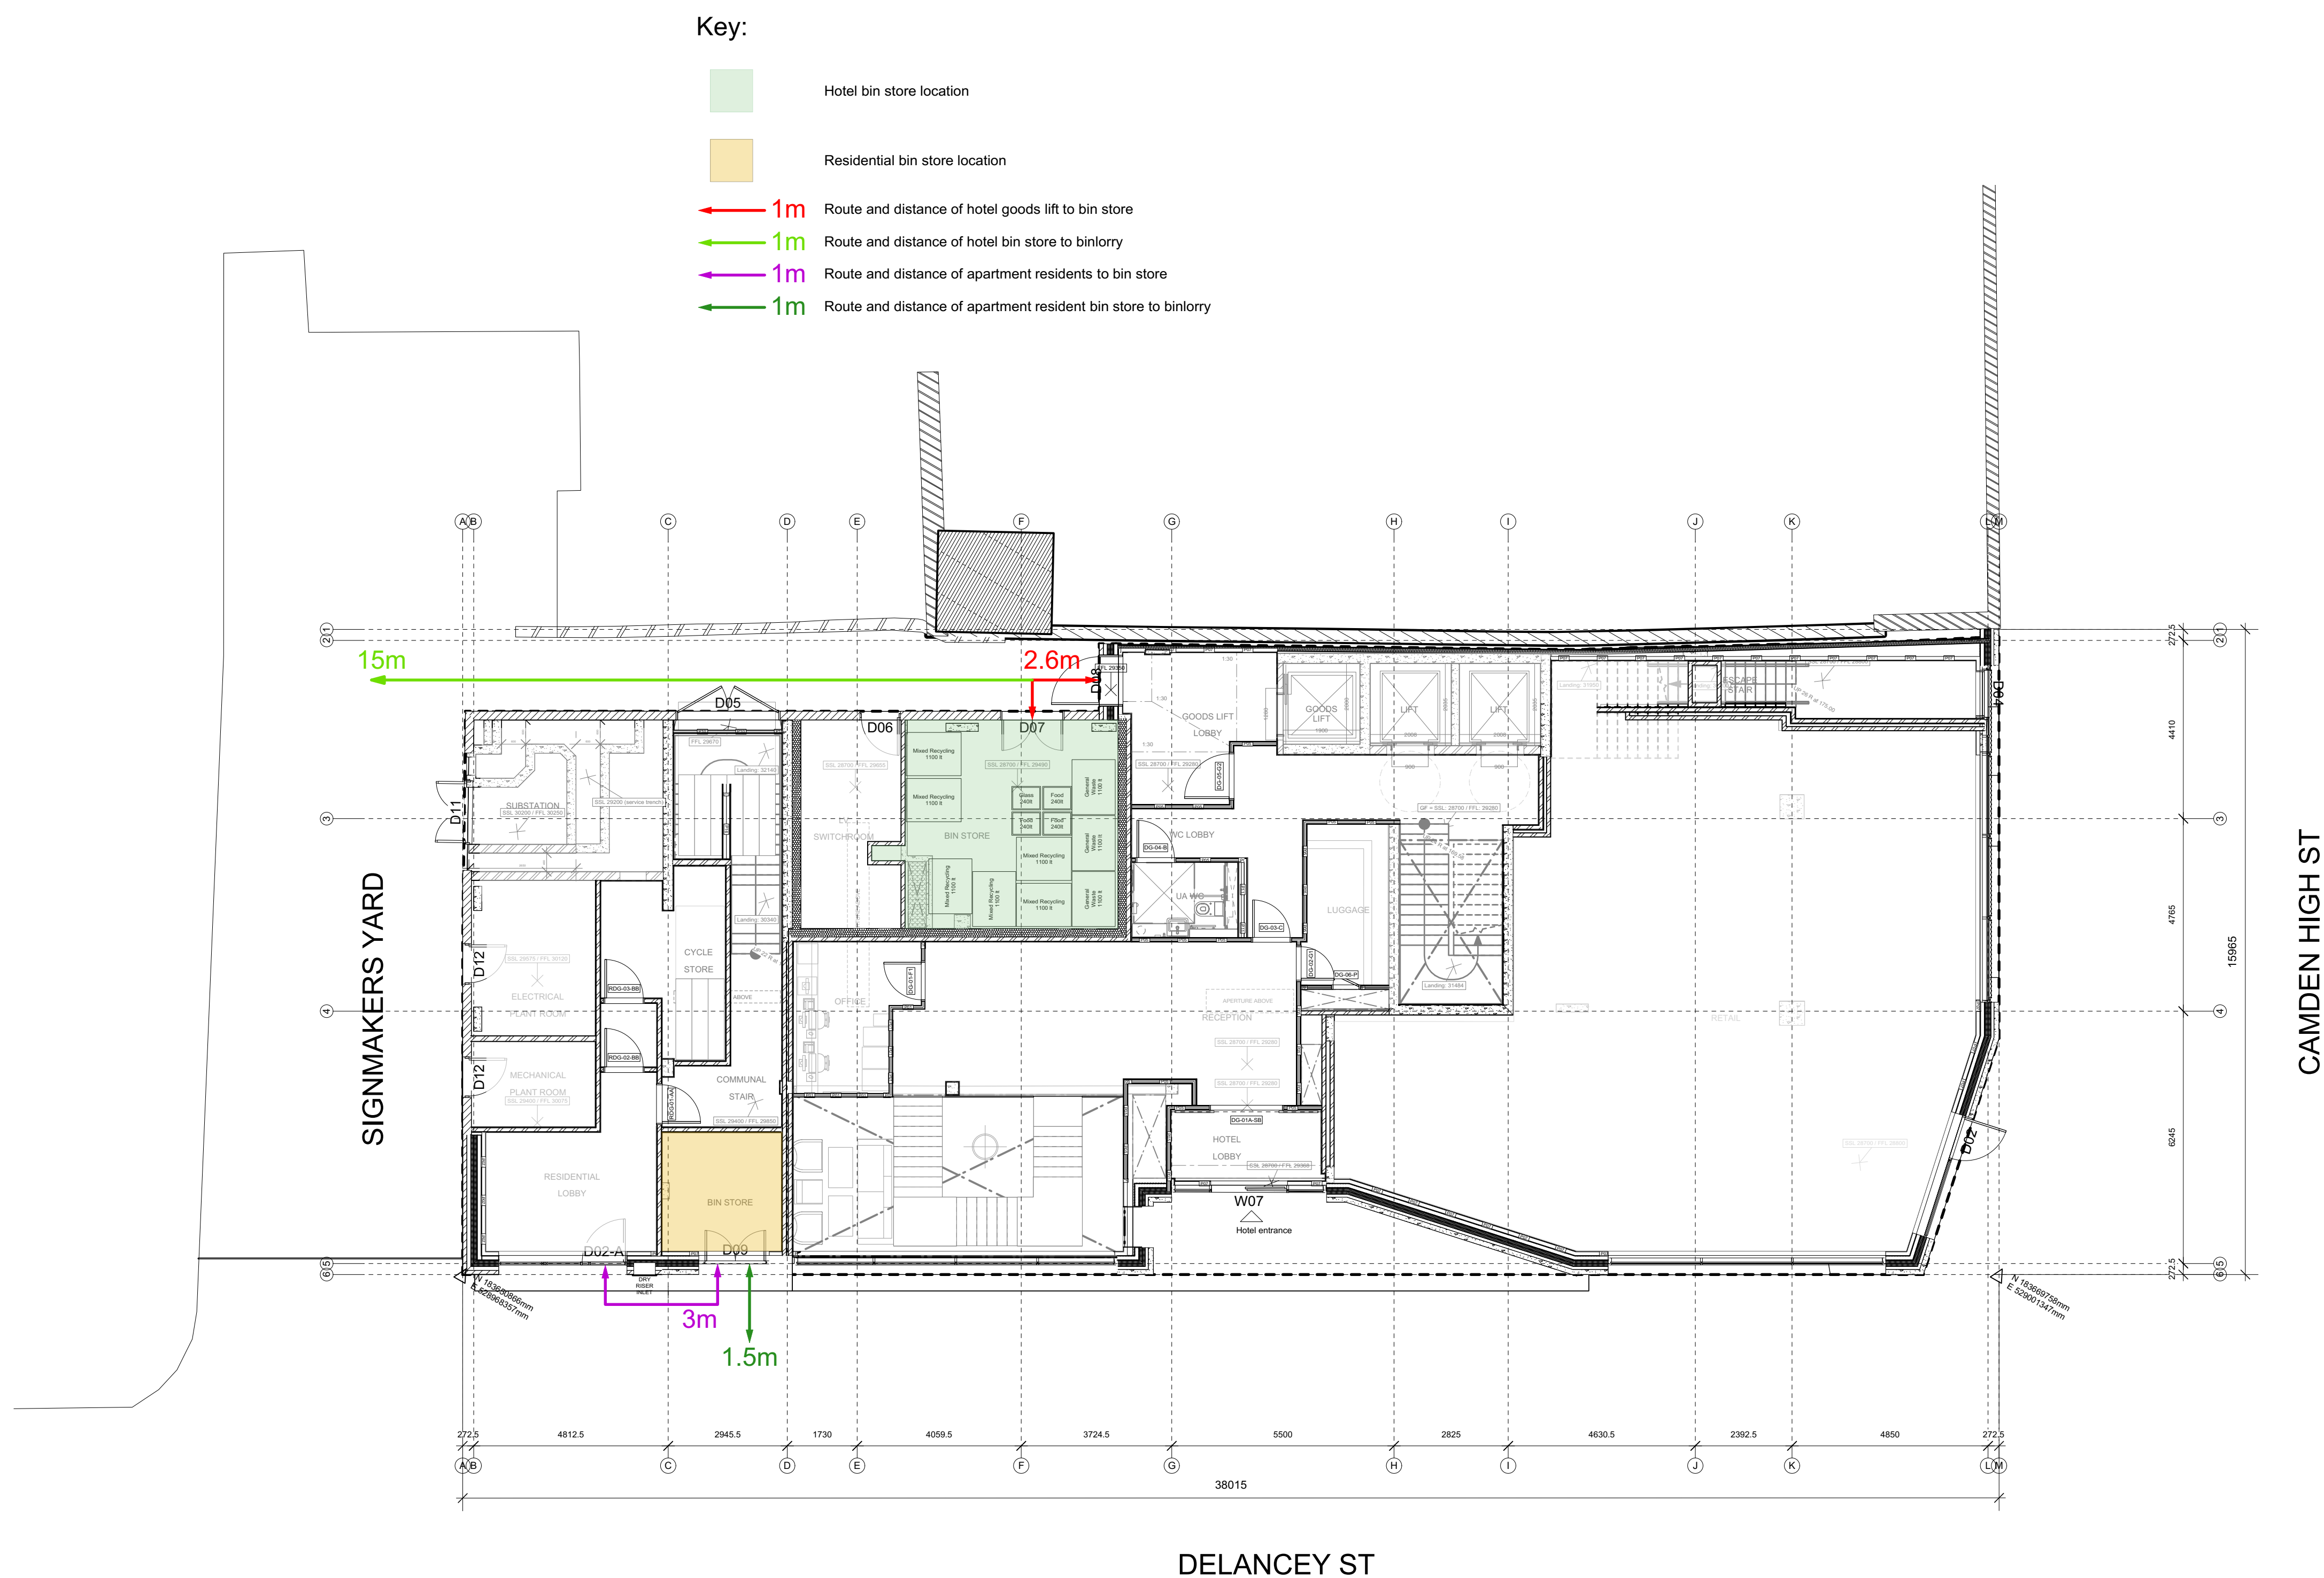

1 Brooklands Yard Southover High Street Lewes East Sussex BN7 1HU
Tel. 01273 479434 www.axiomarchitects.co.uk

Client

Demar BVI Ltd.

Project

hub by Premier Inn
115-119 Camden High Street London

Drawing

Ground Floor Bin Store Locations

Scale	Status	Date	Drawn	Checked
1:100	As Built	23/04/21		

Drawing No.

Revision

4603-PL-900