
NOTE 1. THE CONTRACTOR MUST CHECK ALL DIMENSIONS ON SITE BEFORE COMMENCING WORK

2.ALL WORK MUST CONFORM TO CURRENT BUILDING REGULATIONS, BRITISH STANDARDS & CODES OF PRACTICE AND NHBC STANDARDS

3.THESE DRAWINGS ARE TO BE READ IN CONJUNCTION WITH ALL RELEVANT DESIGNER, ENGINEER OR SPECIALIST DRAWINGS AND SPECIFICATIONS

4. ALL DIMENSIONS ARE IN MILLIMETERS UNLESS STATED OTHERWISE

5. THE CONTRACTOR IS RESPONSIBLE FOR PROVIDING ALL NECESSARY TEMPORARY SUPPORT TO THE BUILDING AND ANY ADJACENT STRUCTURES

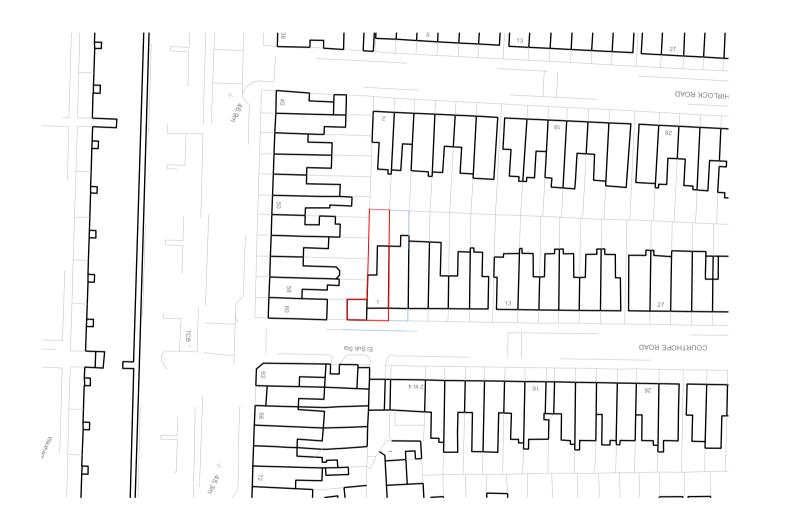

DRAWING TITLE

Rev

1

DATE OF ISSUE

09/02/2023

SCALE @ A2

Ν

Type As-Built Issue 09/02/2023

PURPOSE OF ISSUE As-Built

REVISION NO.

1

DRAWING NO.

S-100

PROJECT NAME

1 COURTHOPE ROAD, LONDON, NW3 2LE

> 5-7 Tanner Street London, SE1 3LE Tel: +44 (0)203 008 0215 Email: admin@cognition.london

