

Site Plan - Proposed 1 : 100

Rev	Description	Date	Chk	
1	Planning	20/04/23		P.01
				G.02
				0.00
				G.01
				D.03
				B.03
				B.02
				B.01
areas dimen dimen intent devel Buildi	for the purposes isions to be chec isions to be their only and are sub opment. All work	of valuation. Do not scale this drawing. All ked on site by the contractor and such responsibility. All Drawings illustrate design ject to revisions following site survey and design must comply with relevant British Standards and quirements. Drawing errors and ornissions to be		Materi
No im	nlied licence exis	ts. This drawing should not be used to calculate		
Ger	neral Notes			Notes

------ Assumed Site Boundary

Material Key

Brick, Existing Masonry, Brick or Stone Masonry, Clay Brick Glass, Double Glazed, Aluminium Frame Glass, Obscure Glazed, Glass Blocks

Paint, White


R.01 T.01


Roof, Existing Cladding, Timber


21-23 Dartmouth Park Avenue

15 Dartmouth Park Avenue


London Studio Studio 8A, Stamford X Gillet Street, N16 8JH hello@unknown.works +44 (0) 2081917134 Hong Kong Studio Unit 20B 64 Victoria Road Kwong Ga Factory Building © unknown works @ 1:

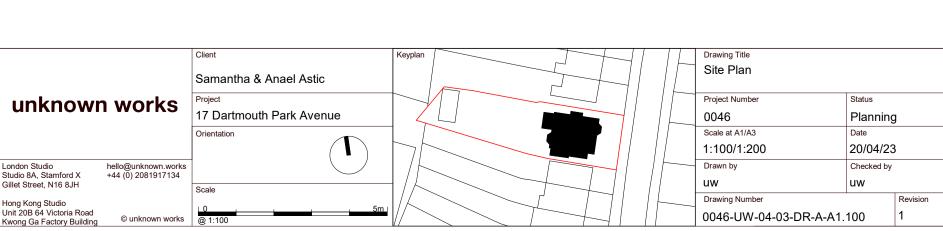


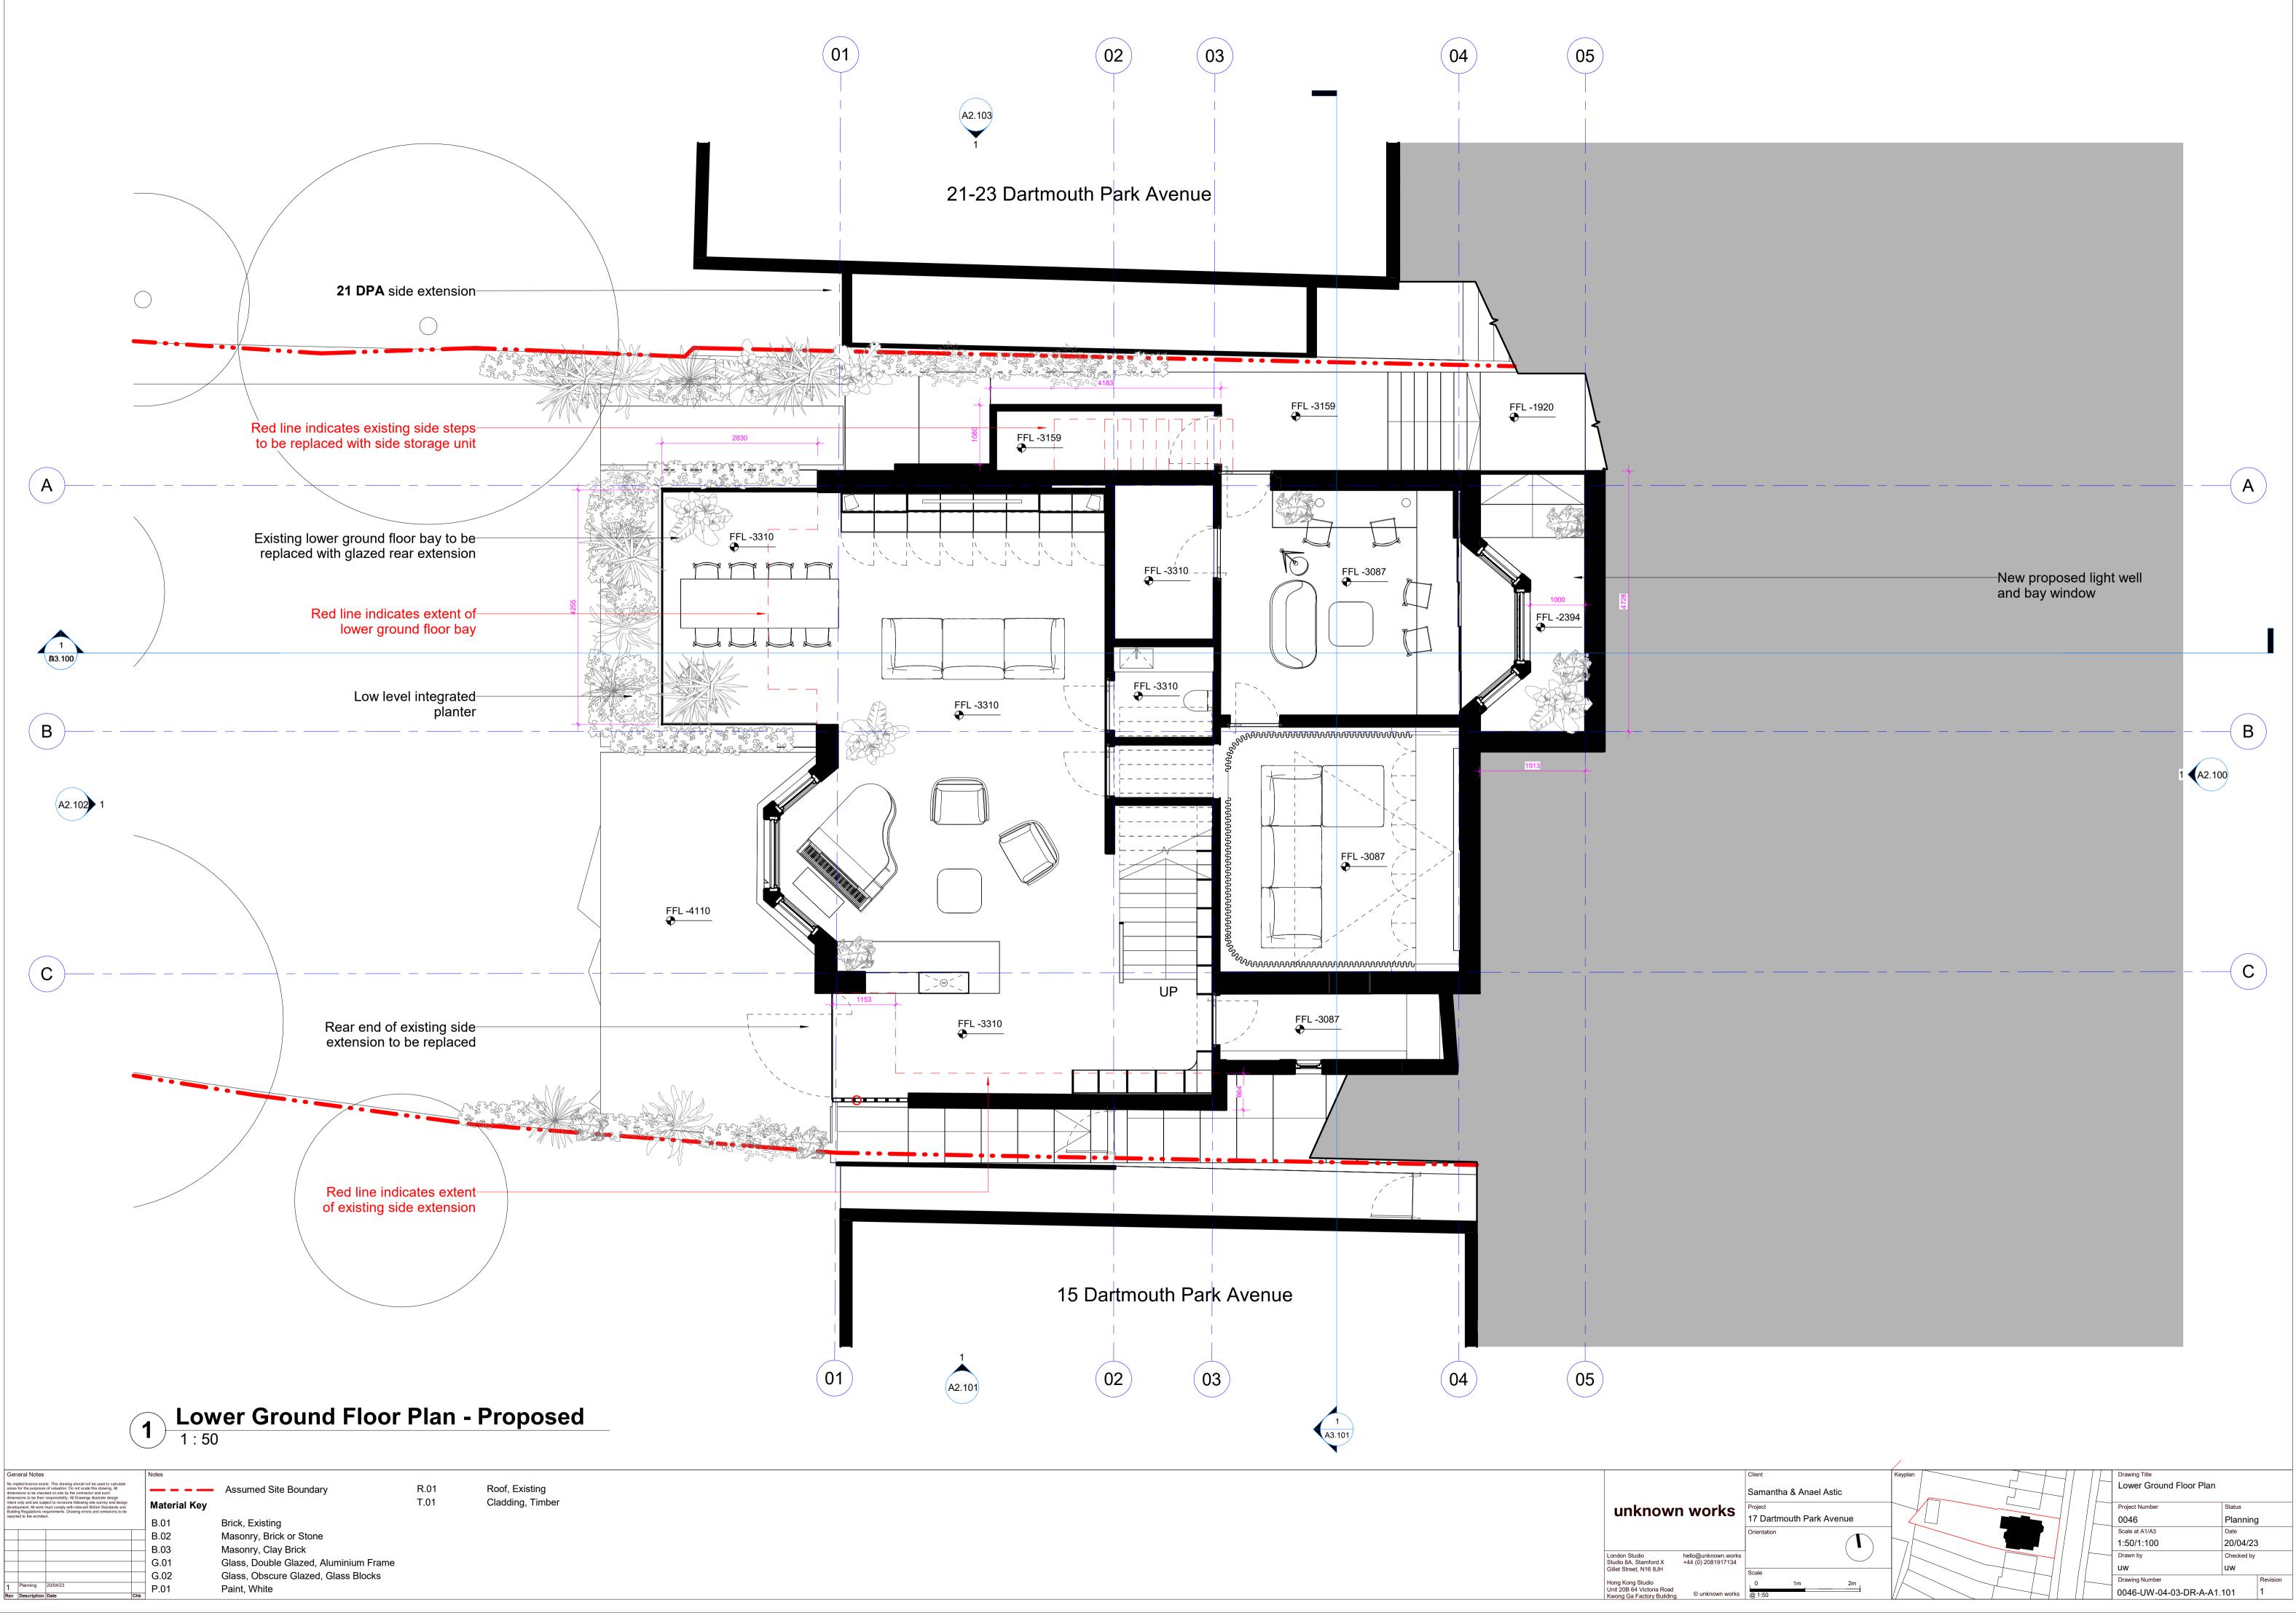


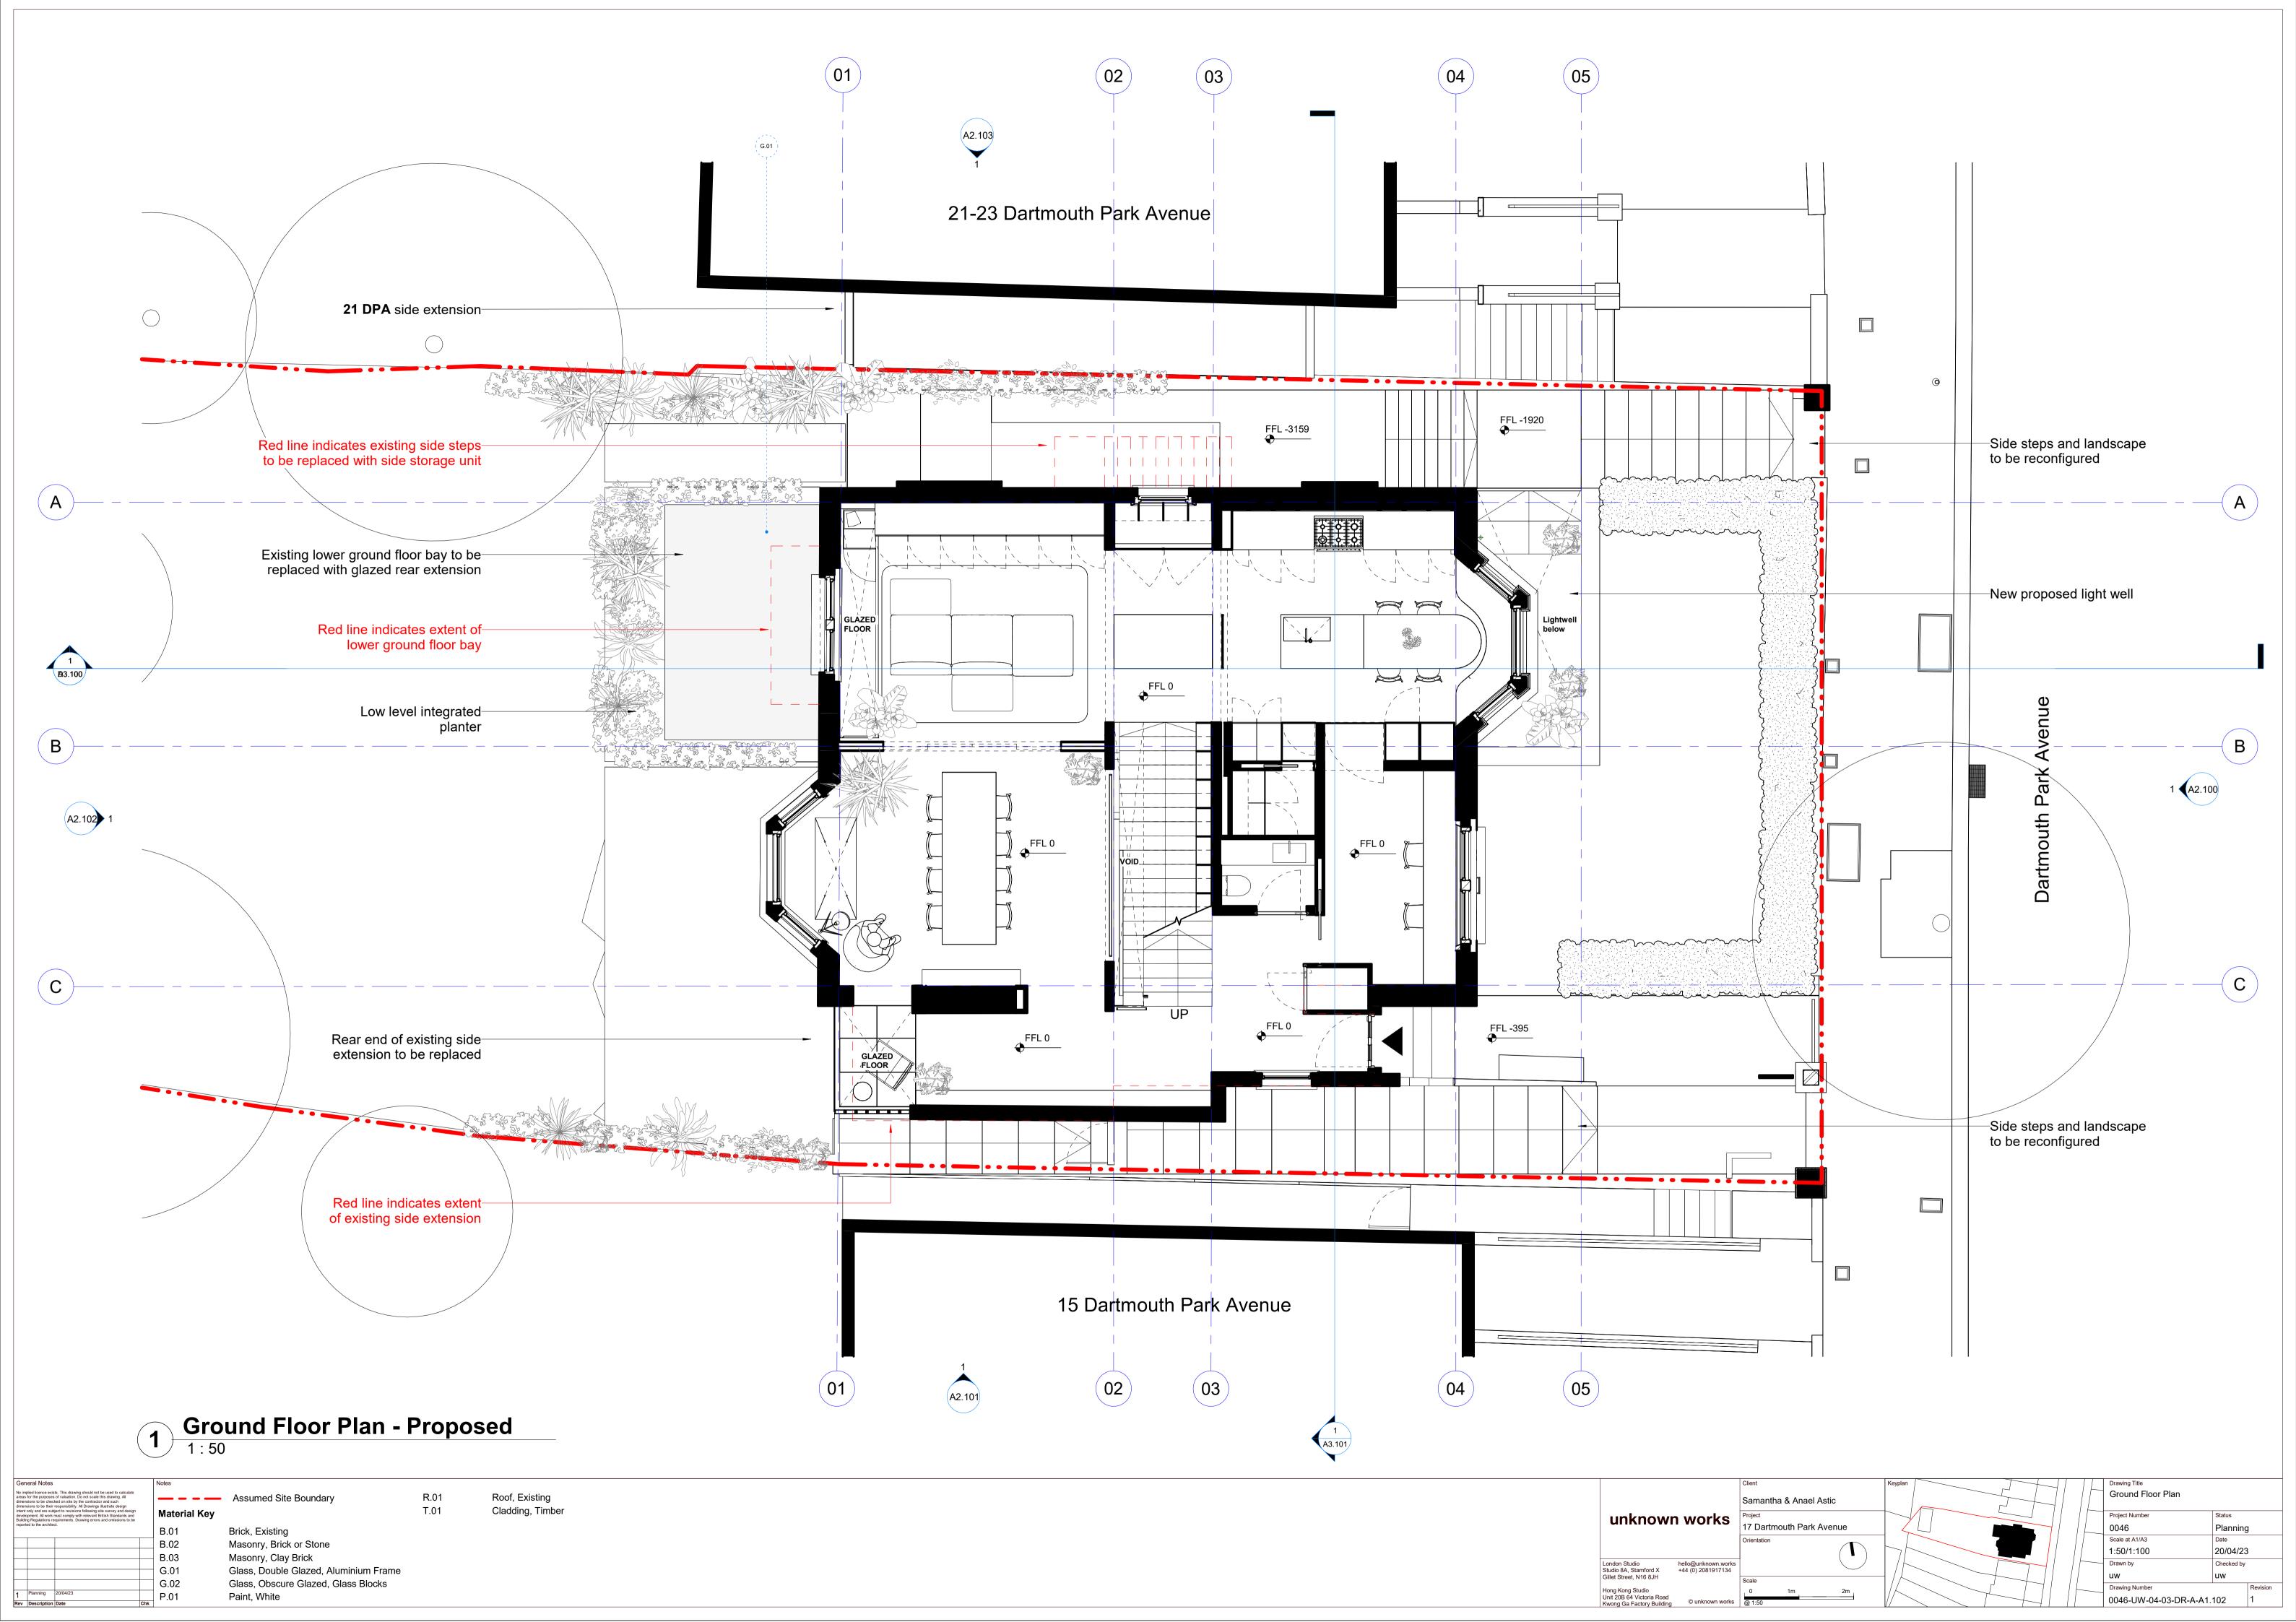




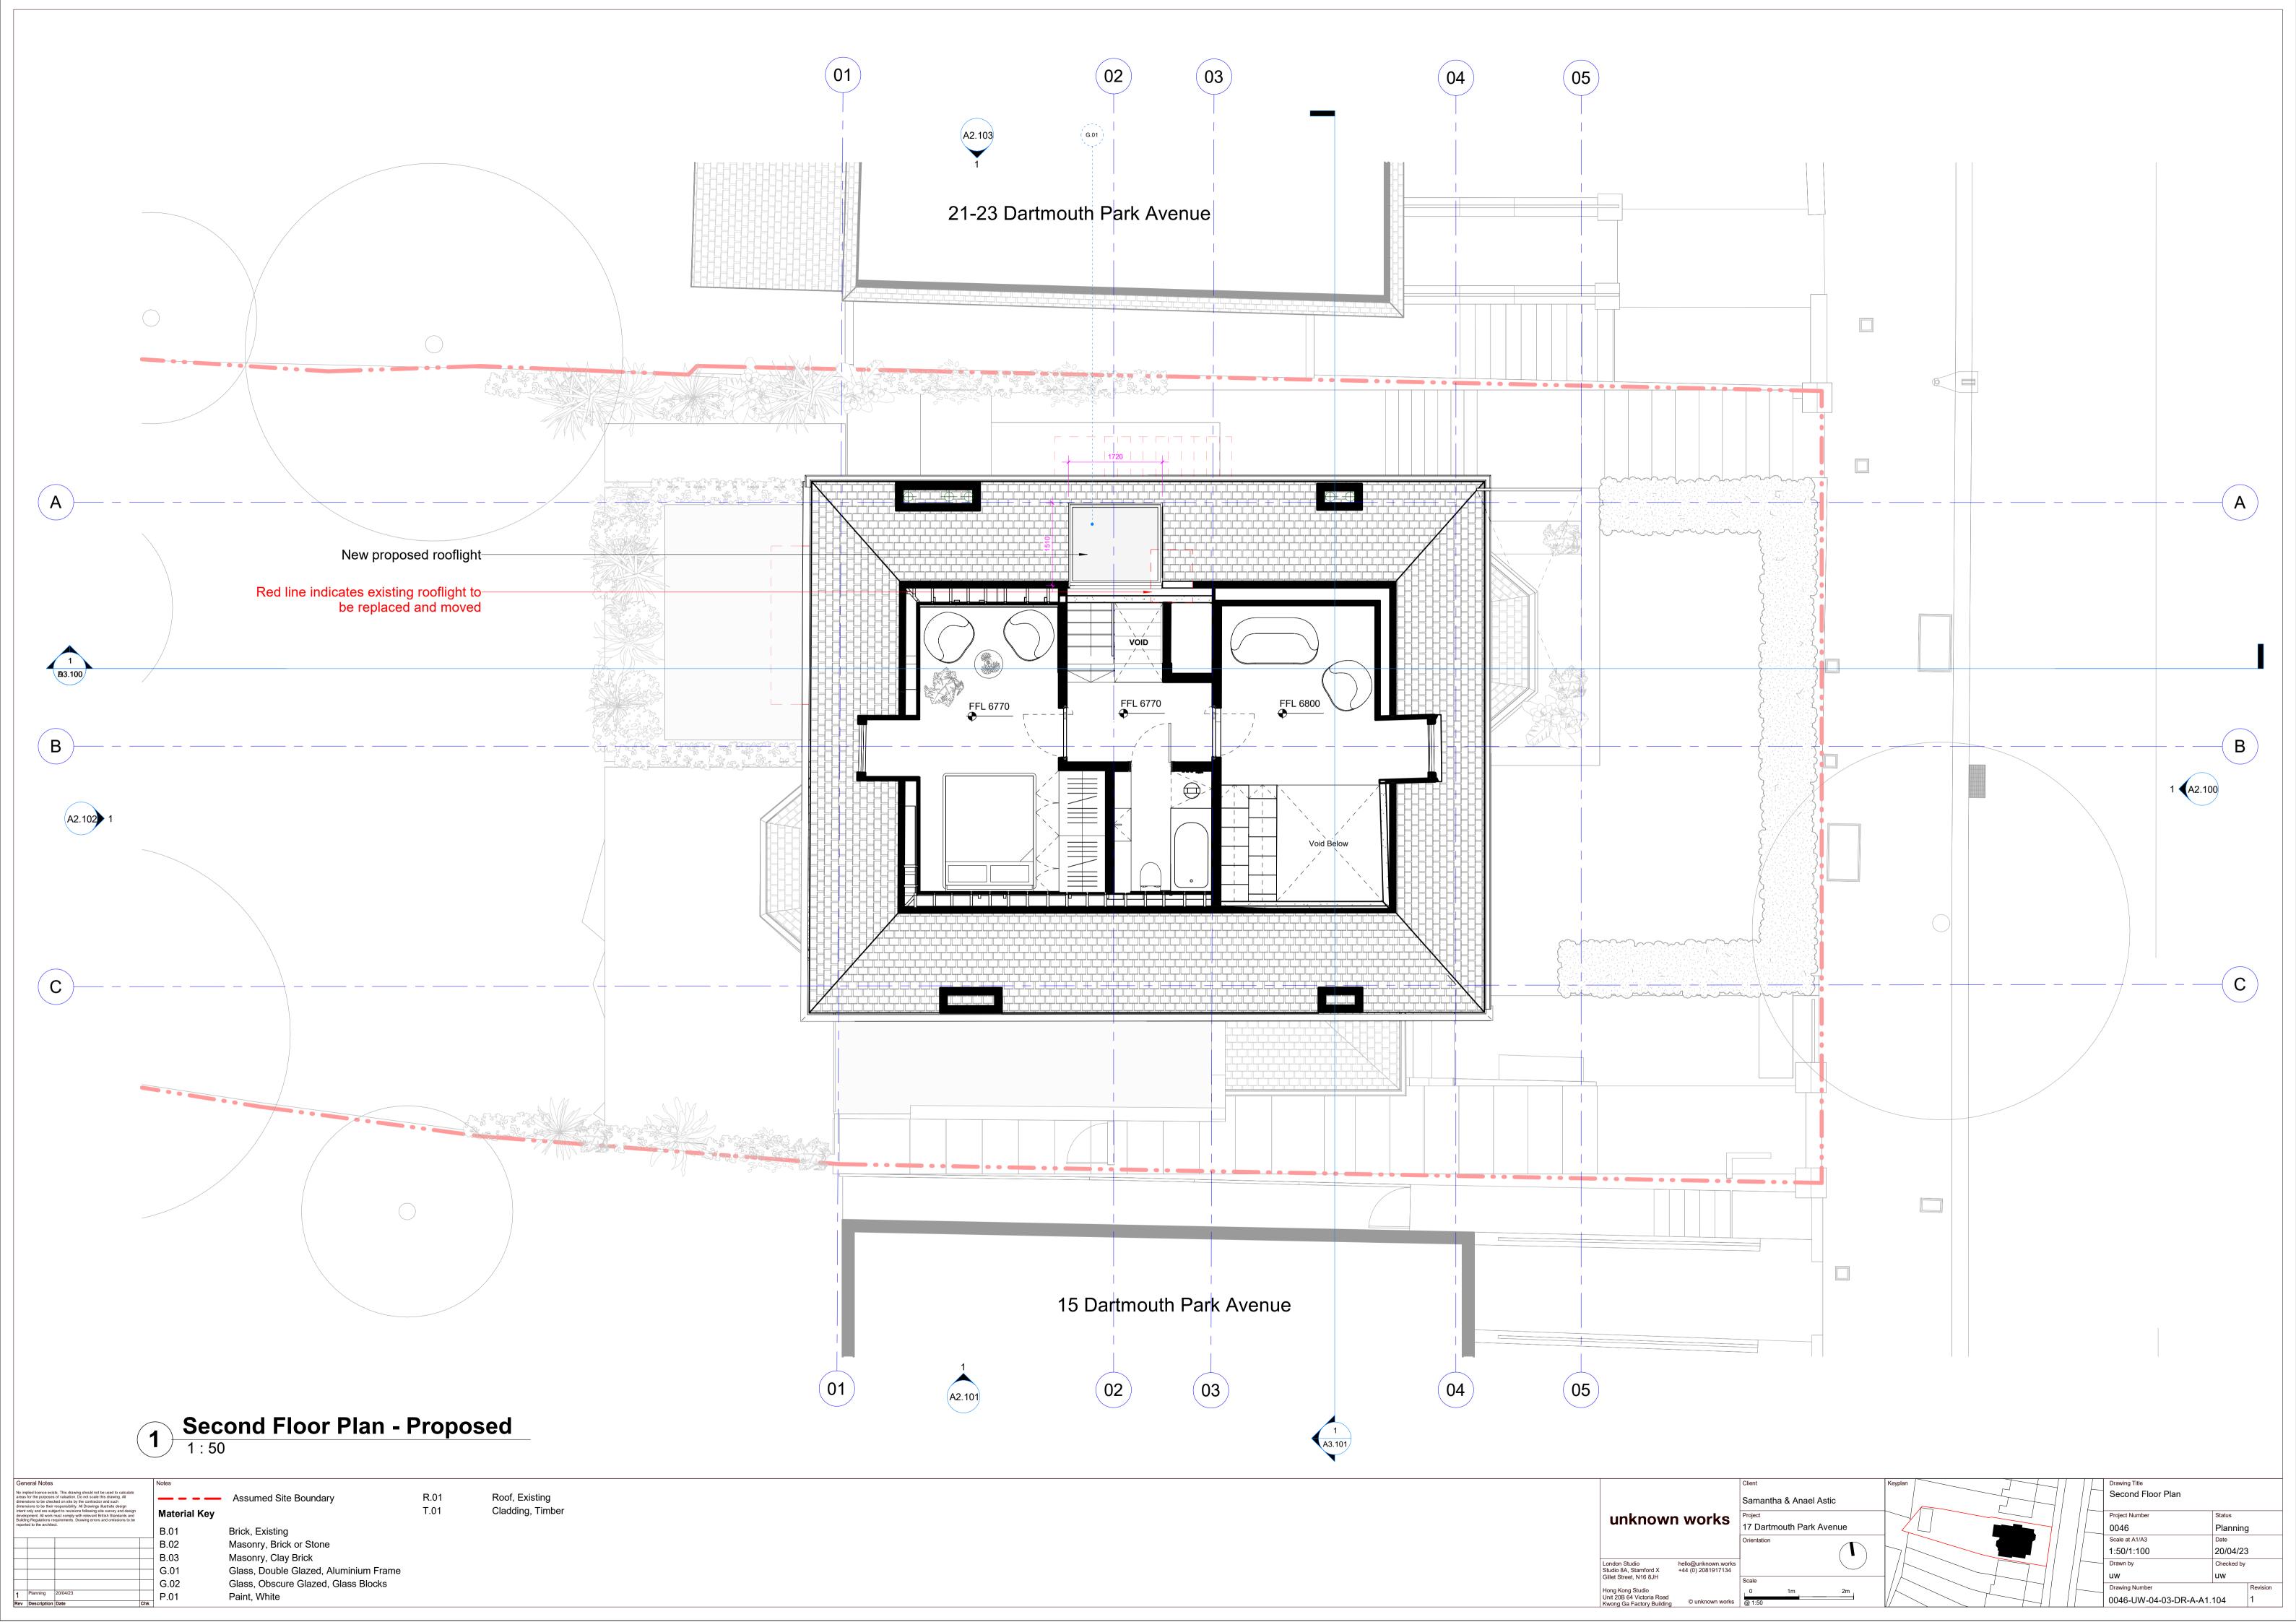

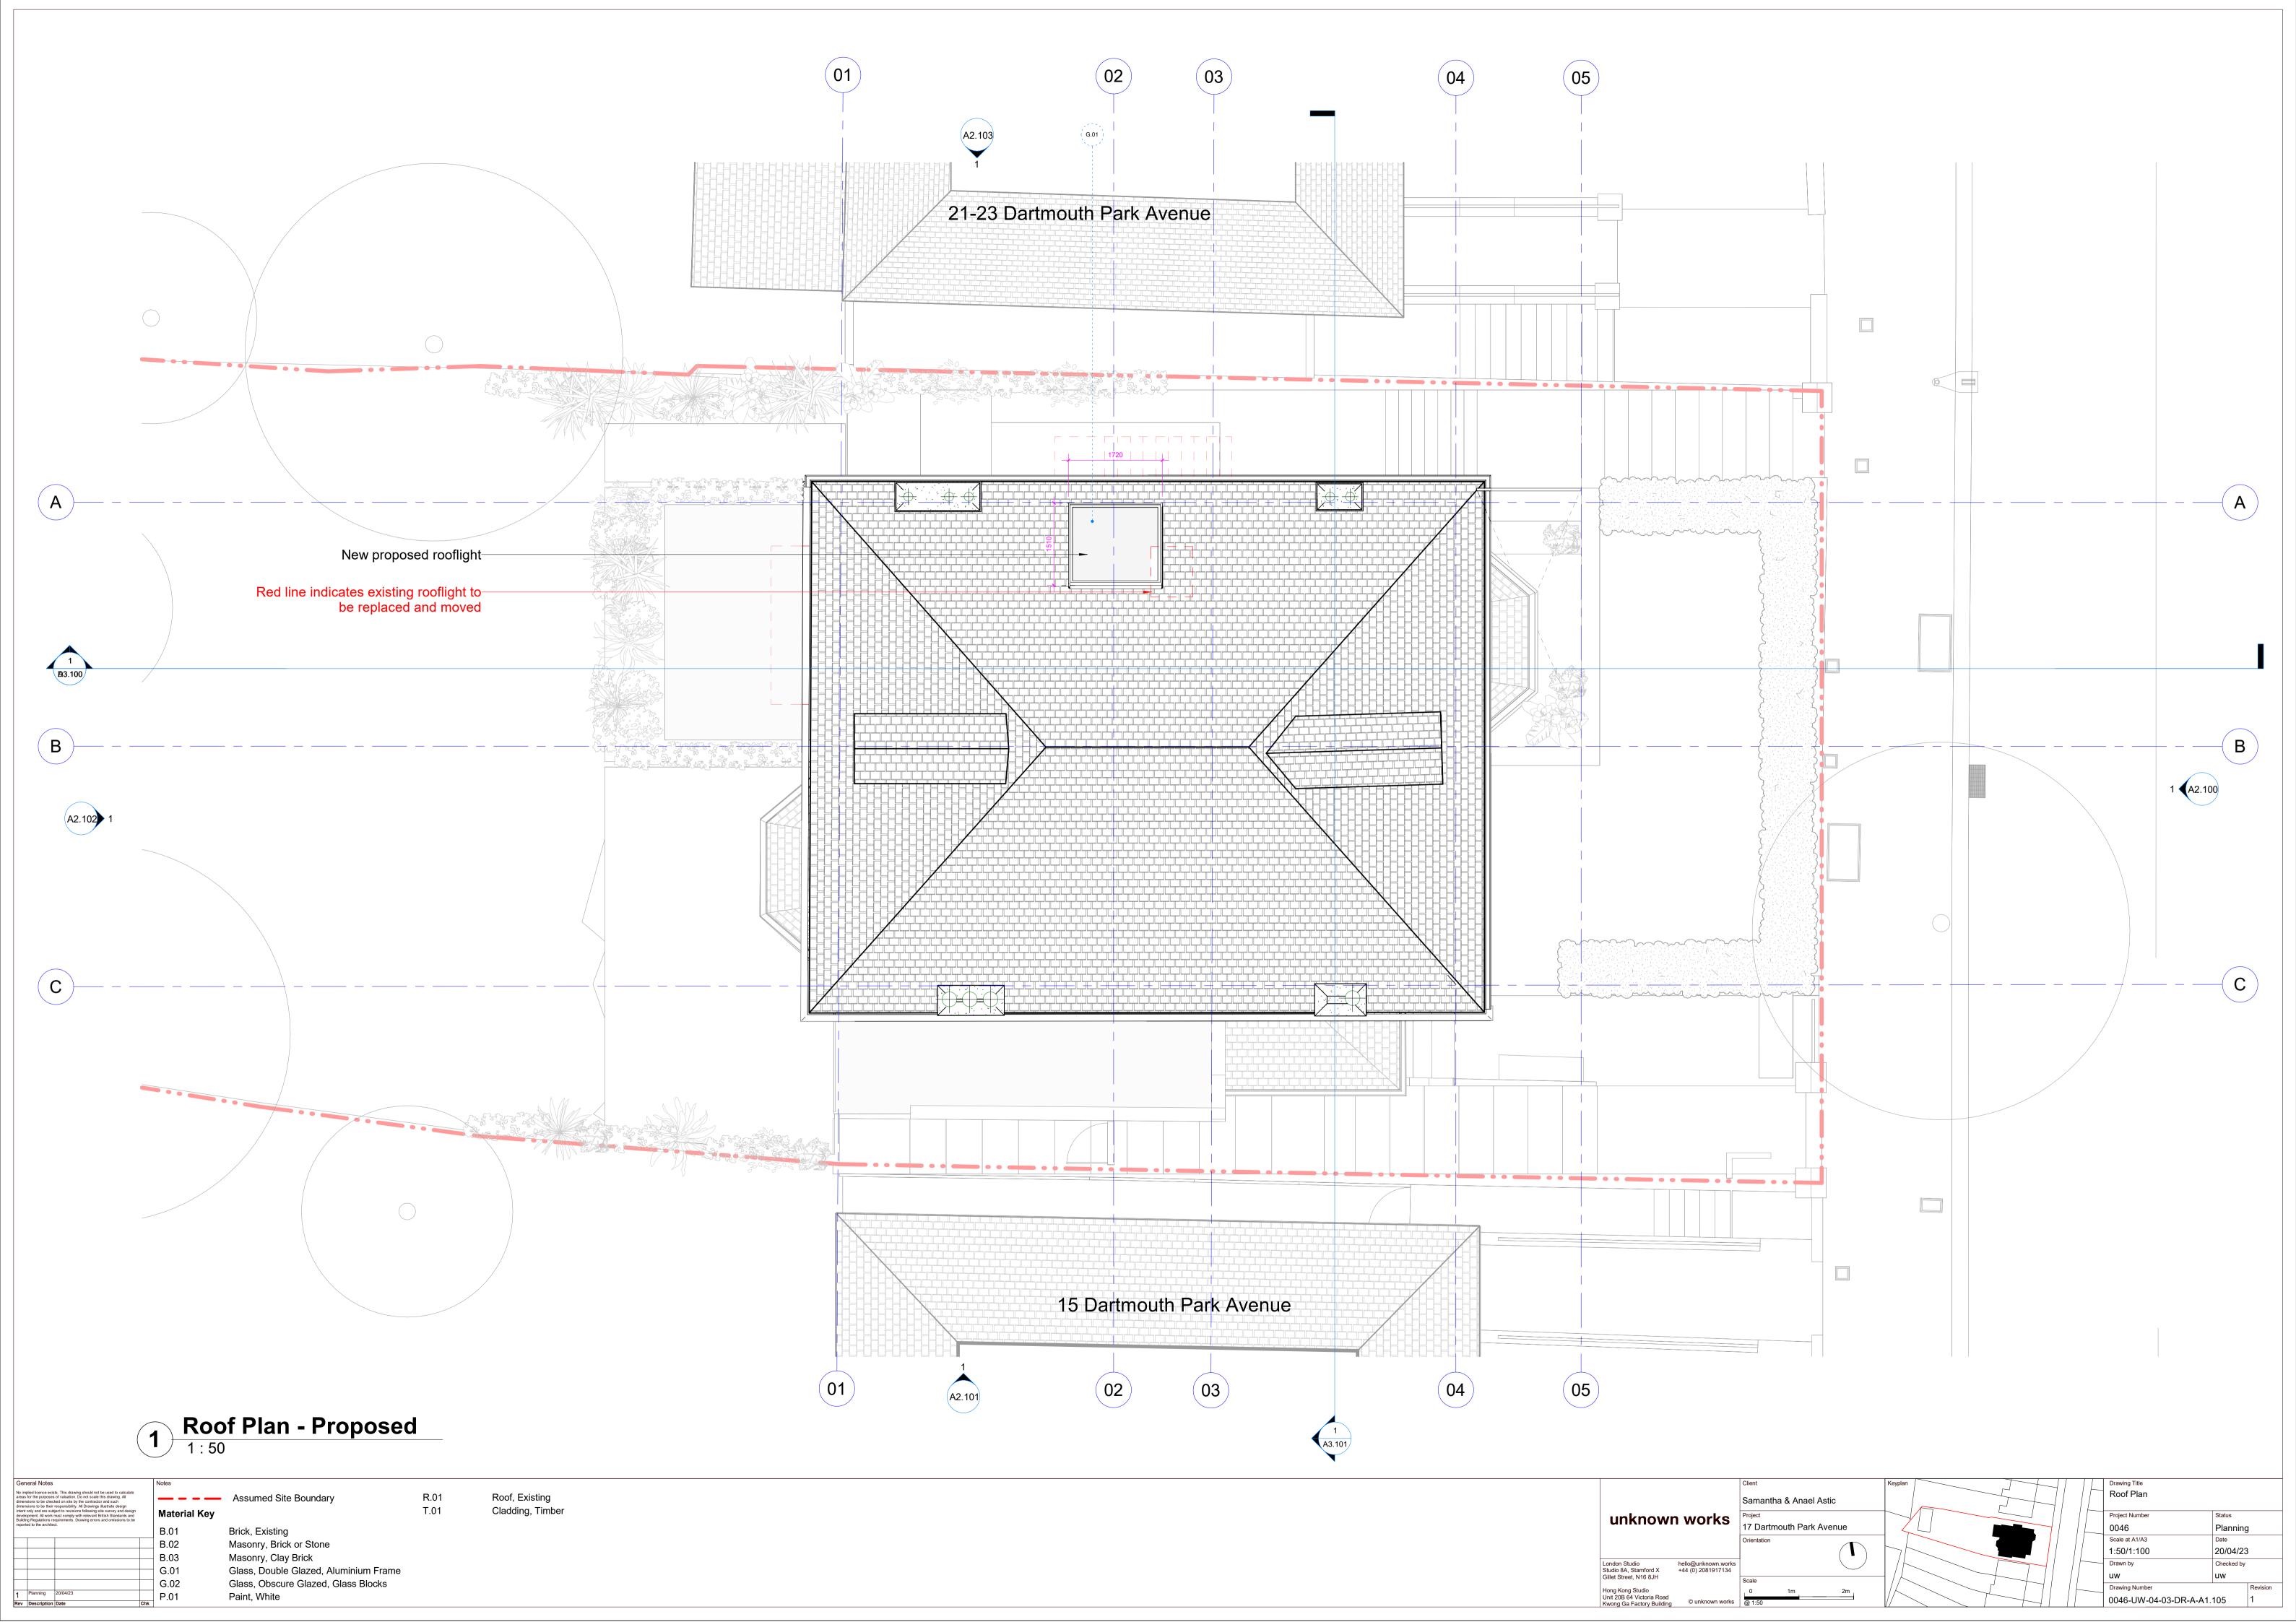

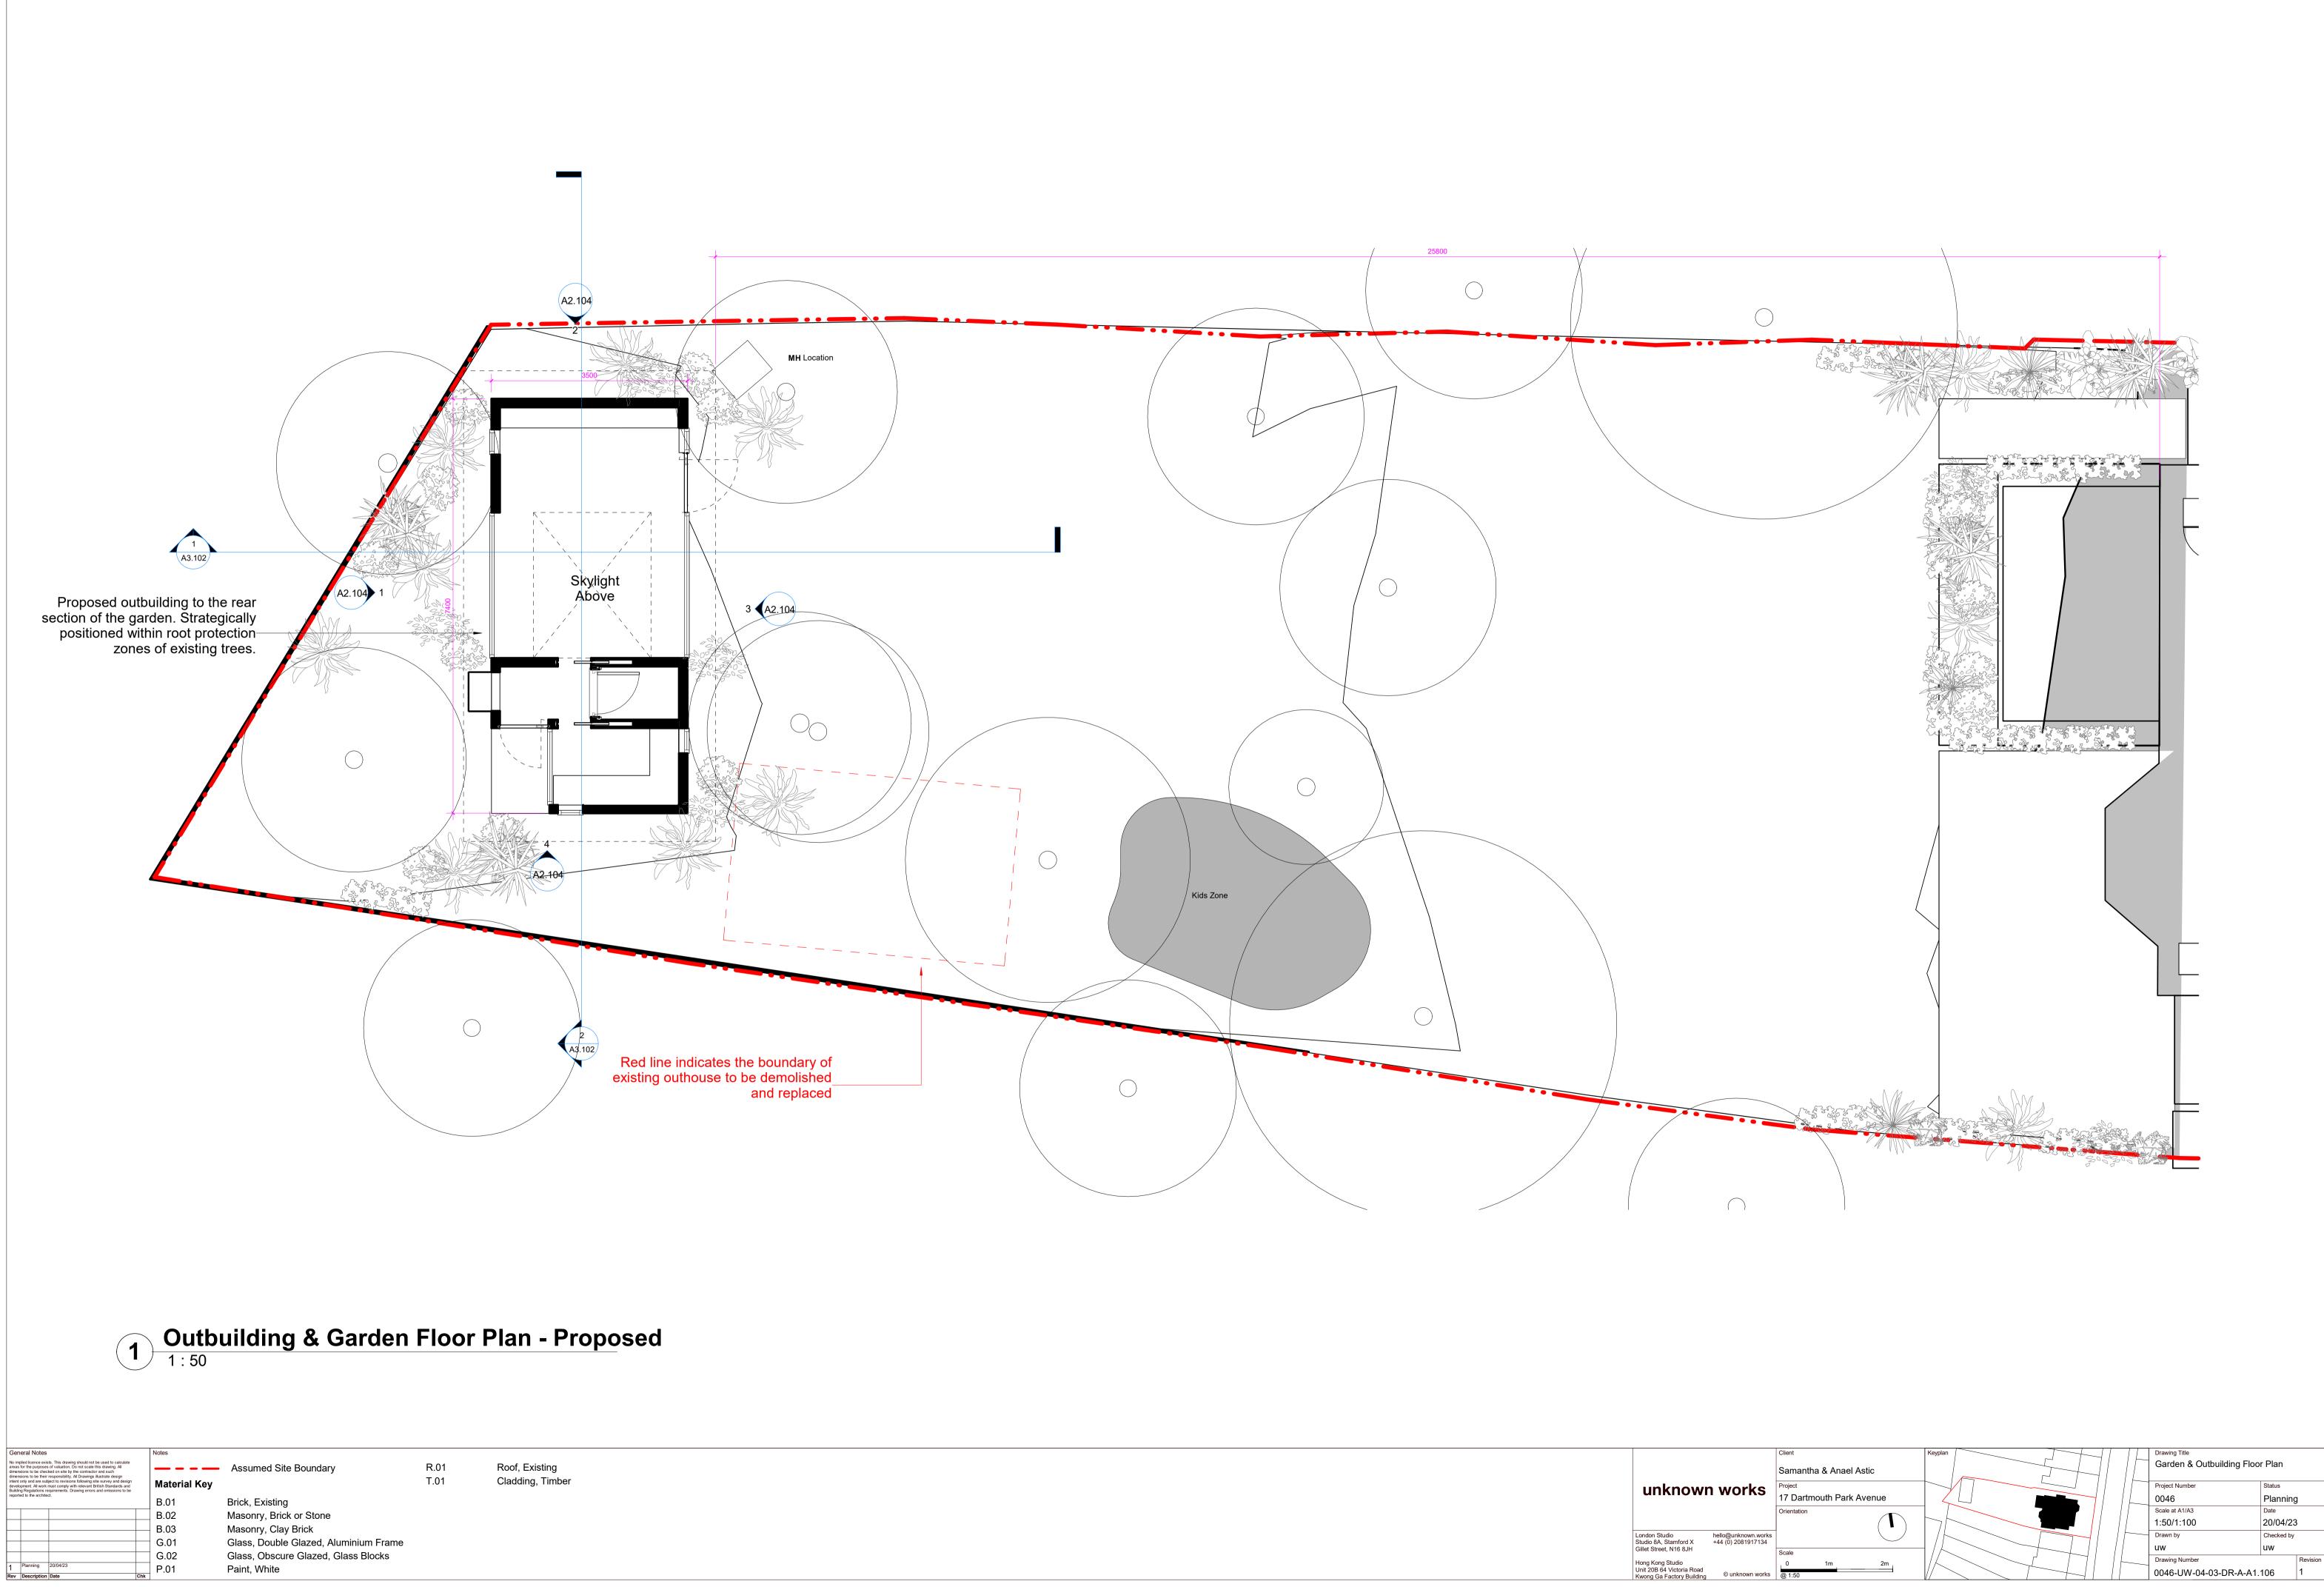

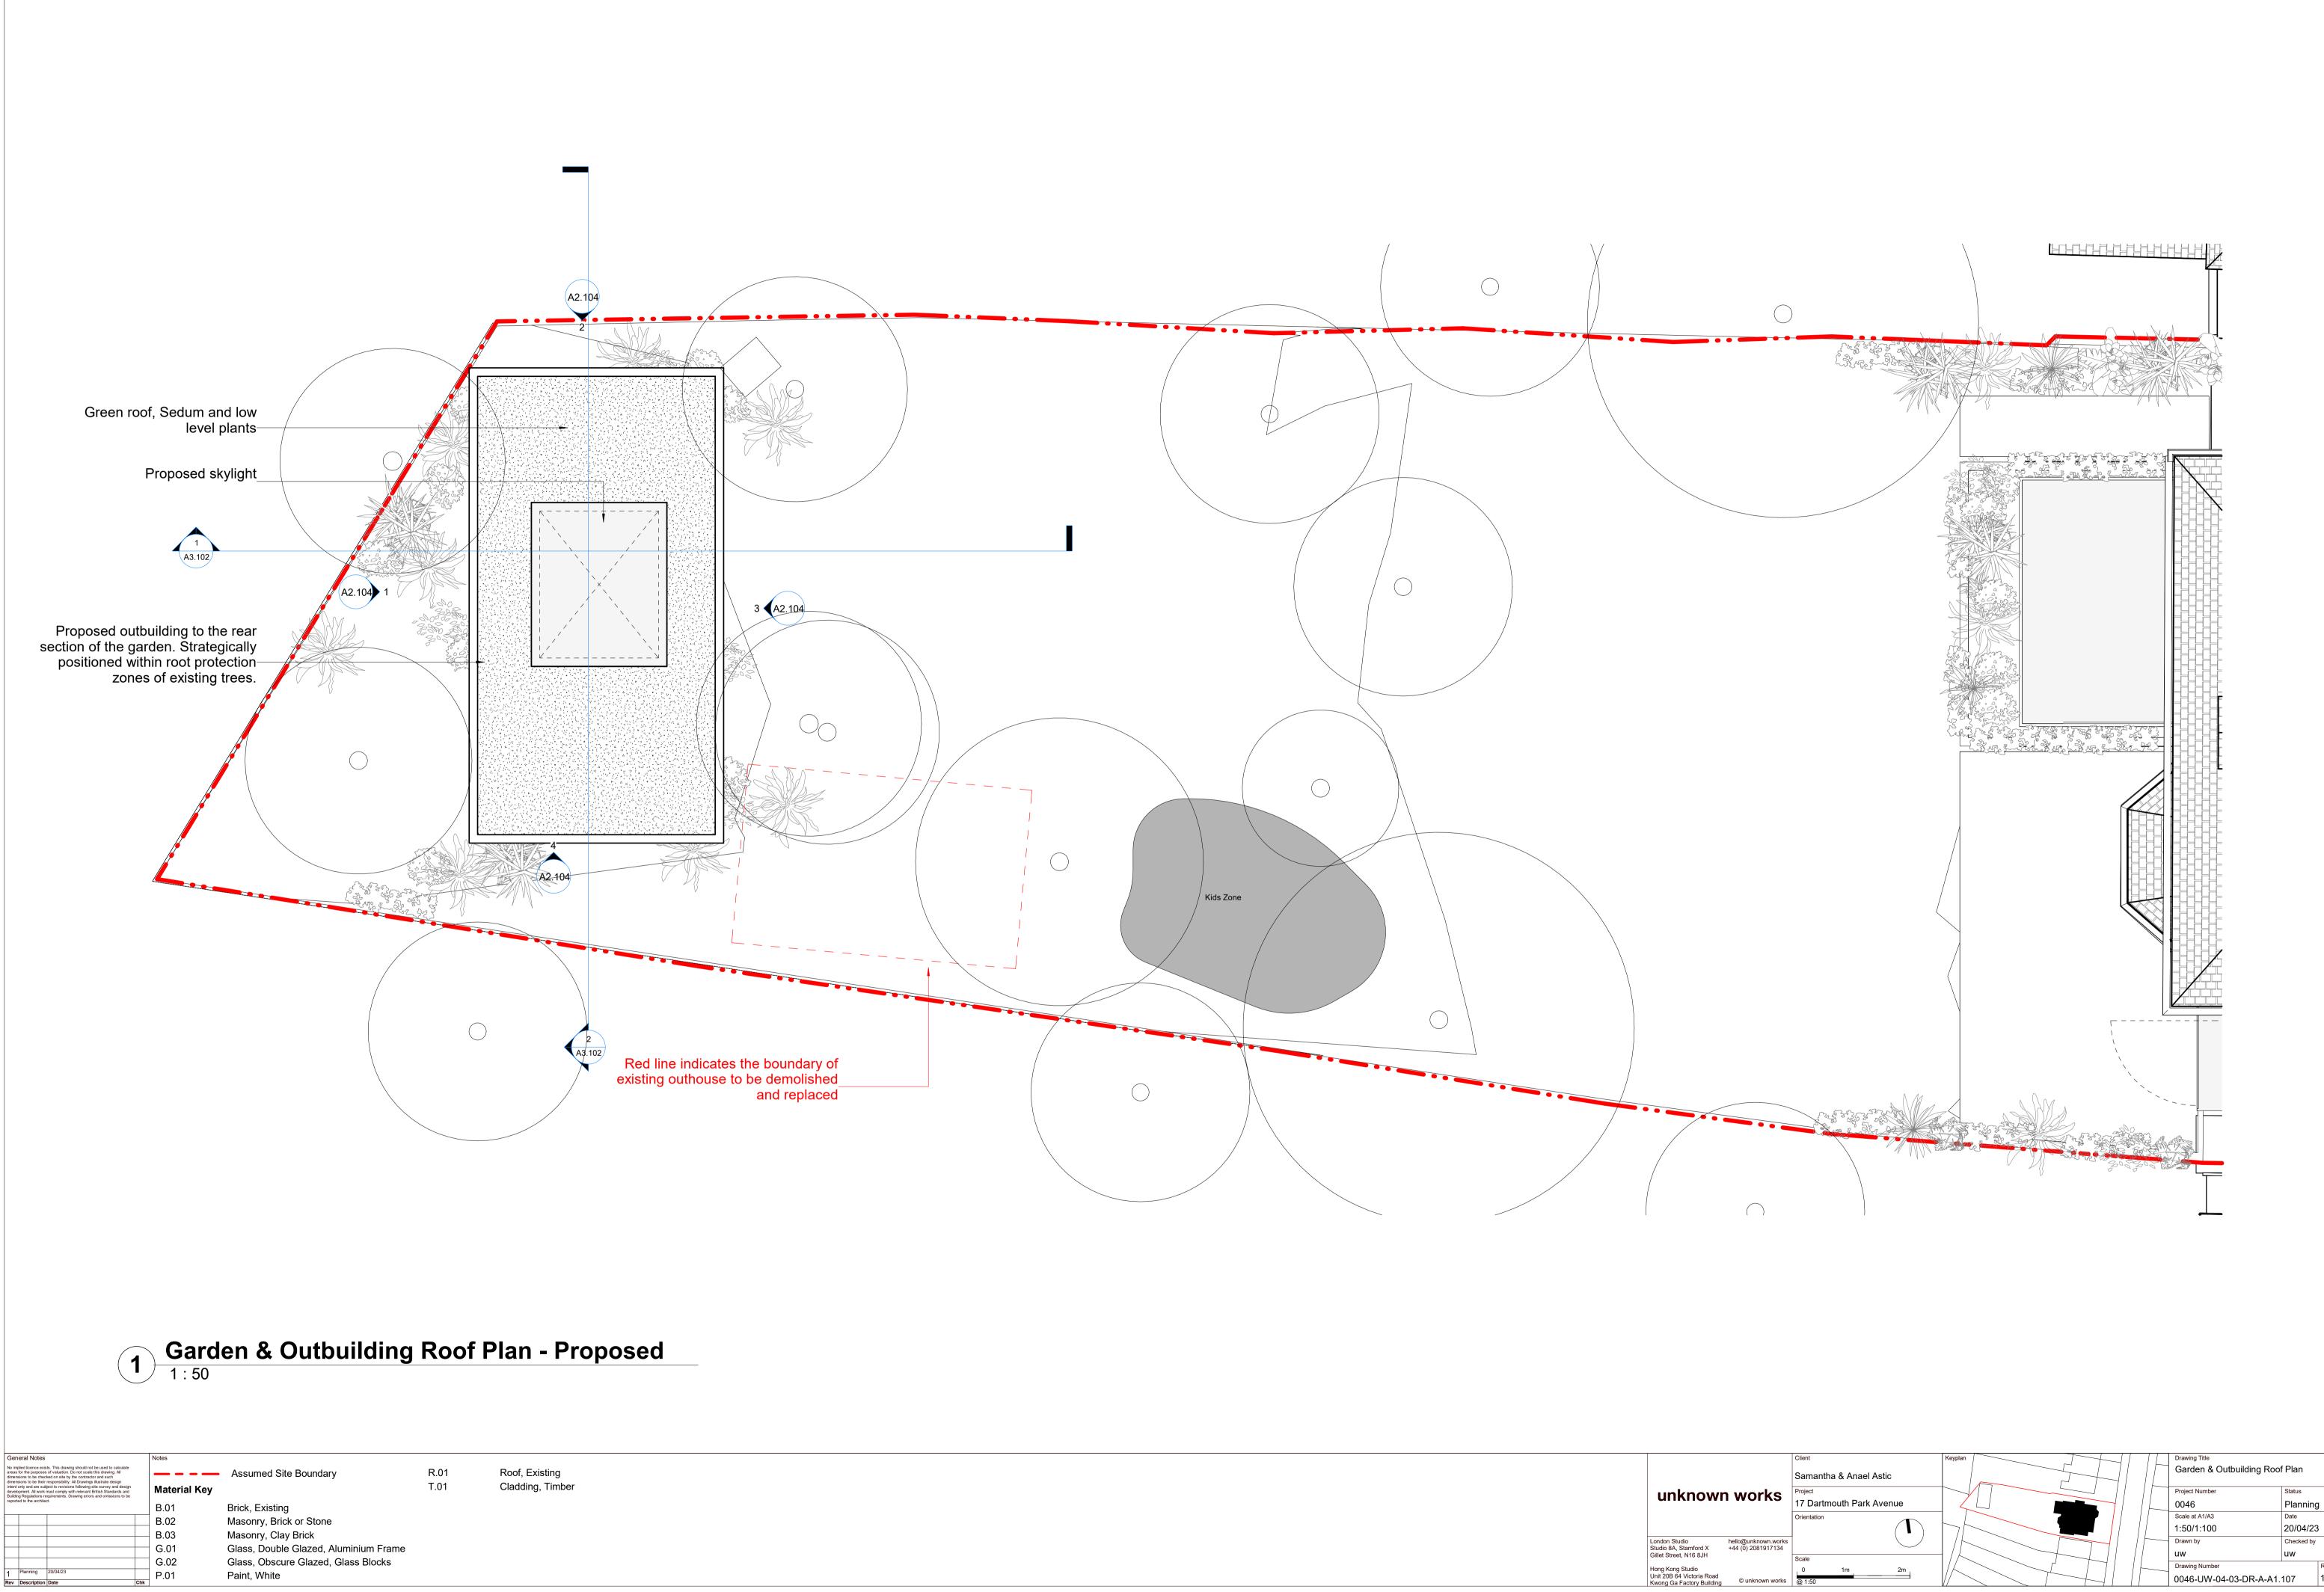

Revisior

1



Ger	Notes			
areas dimen dimen intent devel Buildi	for the purposes isions to be chec isions to be their only and are sub opment. All work ing Regulations re	ts. This drawing should not be used to calculate of valuation. Do not scale this drawing. All ked on site by the contractor and such responsibility. All Drawings illustrate design figet to revisions following site survey and design must comply with relevant British Standards and quirements. Drawing errors and omissions to be		Materi
report	ted to the archite	ct.		B.01
				B.02
				B.03
				G.01
				G.02
1	Planning	20/04/23		P.01
Rev	Description	Date	Chk	

Assumed Site BoundaryMaterial KeyB.01Brick, ExistingB.02Masonry, Brick or StoneB.03Masonry, Clay BrickG.01Glass, Double Glazed, Aluminium FrameG.02Glass, Obscure Glazed, Glass BlocksP.01Paint, White

R.01 T.01 Roof, Existing Cladding, Timber

unknown works

London Studio hello@unknown.works Studio 8A, Stamford X +44 (0) 2081917134 Gillet Street, N16 8JH Hong Kong Studio Unit 20B 64 Victoria Road Kwong Ga Factory Building © unknown works

(B.01)				
(P.01)				
(B.01)				
Client Samantha & Anael Astic Project 17 Dartmouth Park Avenue Orientation Scale 0 1m 2m @ 1:50	Keyplan	Proje 004 Scale 1:50 Draw UW Draw	16 e at A1/A3 D/1:100 m by	Status Planning Date 20/04/23 Checked by uW Revision 00







General Notes No implied licence exists. This drawing sh areas for the purposes of valuation. Do n dimensions to be checked on asite by the dimensions to be their responsibility. All D intent only and are subject to revisions fol development. All work mast comply with re Building Regulations requirements. Drawin reported to the architect. G.01
 1
 Planning
 20/04/23

 Rev
 Description
 Date
 P.01

- --- Assumed Site Boundary ____ Material Key B.01 Brick, Existing Masonry, Brick or Stone B.02 Masonry, Clay Brick B.03

Paint, White

Glass, Double Glazed, Aluminium Frame Glass, Obscure Glazed, Glass Blocks

Notes

G.02

R.01 T.01

Roof, Existing Cladding, Timber

London Studio Studio 8A, Stamford X Gillet Street, N16 8JH hello@unknown.works +44 (0) 2081917134 Hong Kong Studio Unit 20B 64 Victoria Road Kwong Ga Factory Building © unknown works @ 1:50

(R.01) B.01 - P.01 Rear end of existing side extension to be replaced -Red line indicates extent


of existing side extension -Red line indicates extent of existing bay window

fenestration


G.01

Drawing Title West Elevation Samantha & Anael Astic unknown works \bigcirc ientatio \smile 2m

Project Number	Status	
0046	Planning	J
Scale at A1/A3	Date	
1:50/1:100 20/04/23		3
Drawn by	Checked by	
uw	uw	
Drawing Number	Revision	
0046-UW-04-03-DR-A-A2.	1	

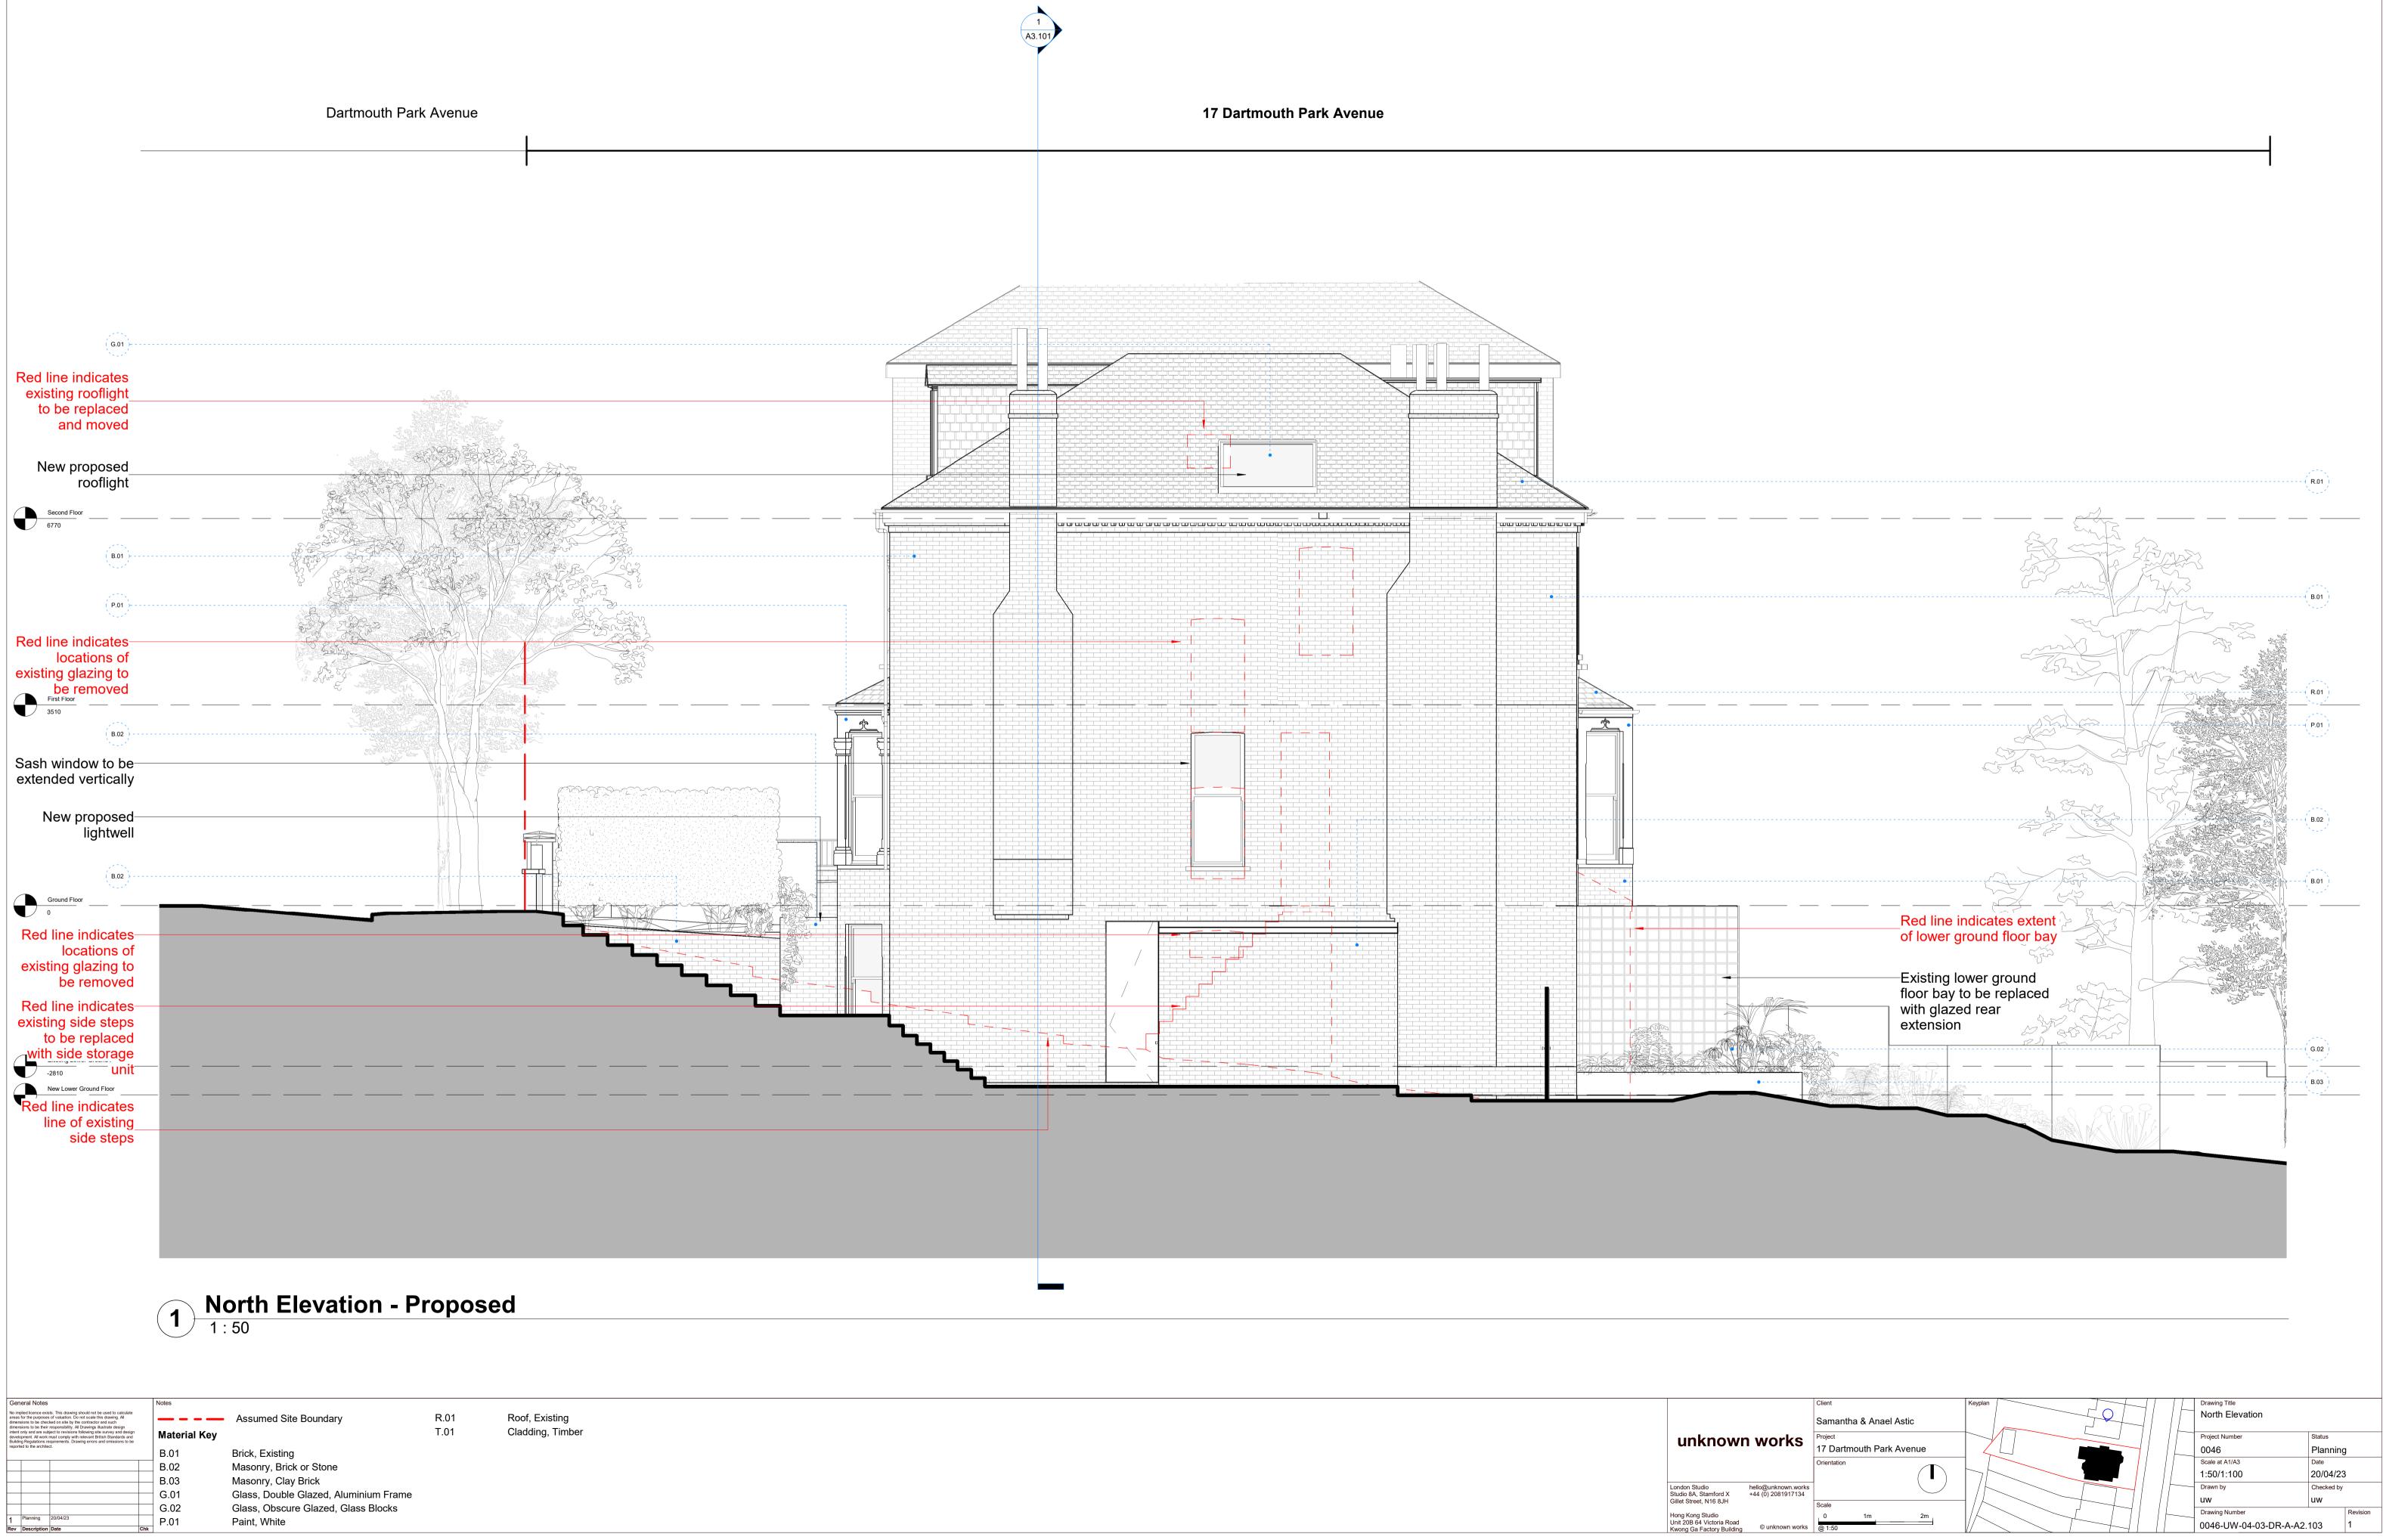



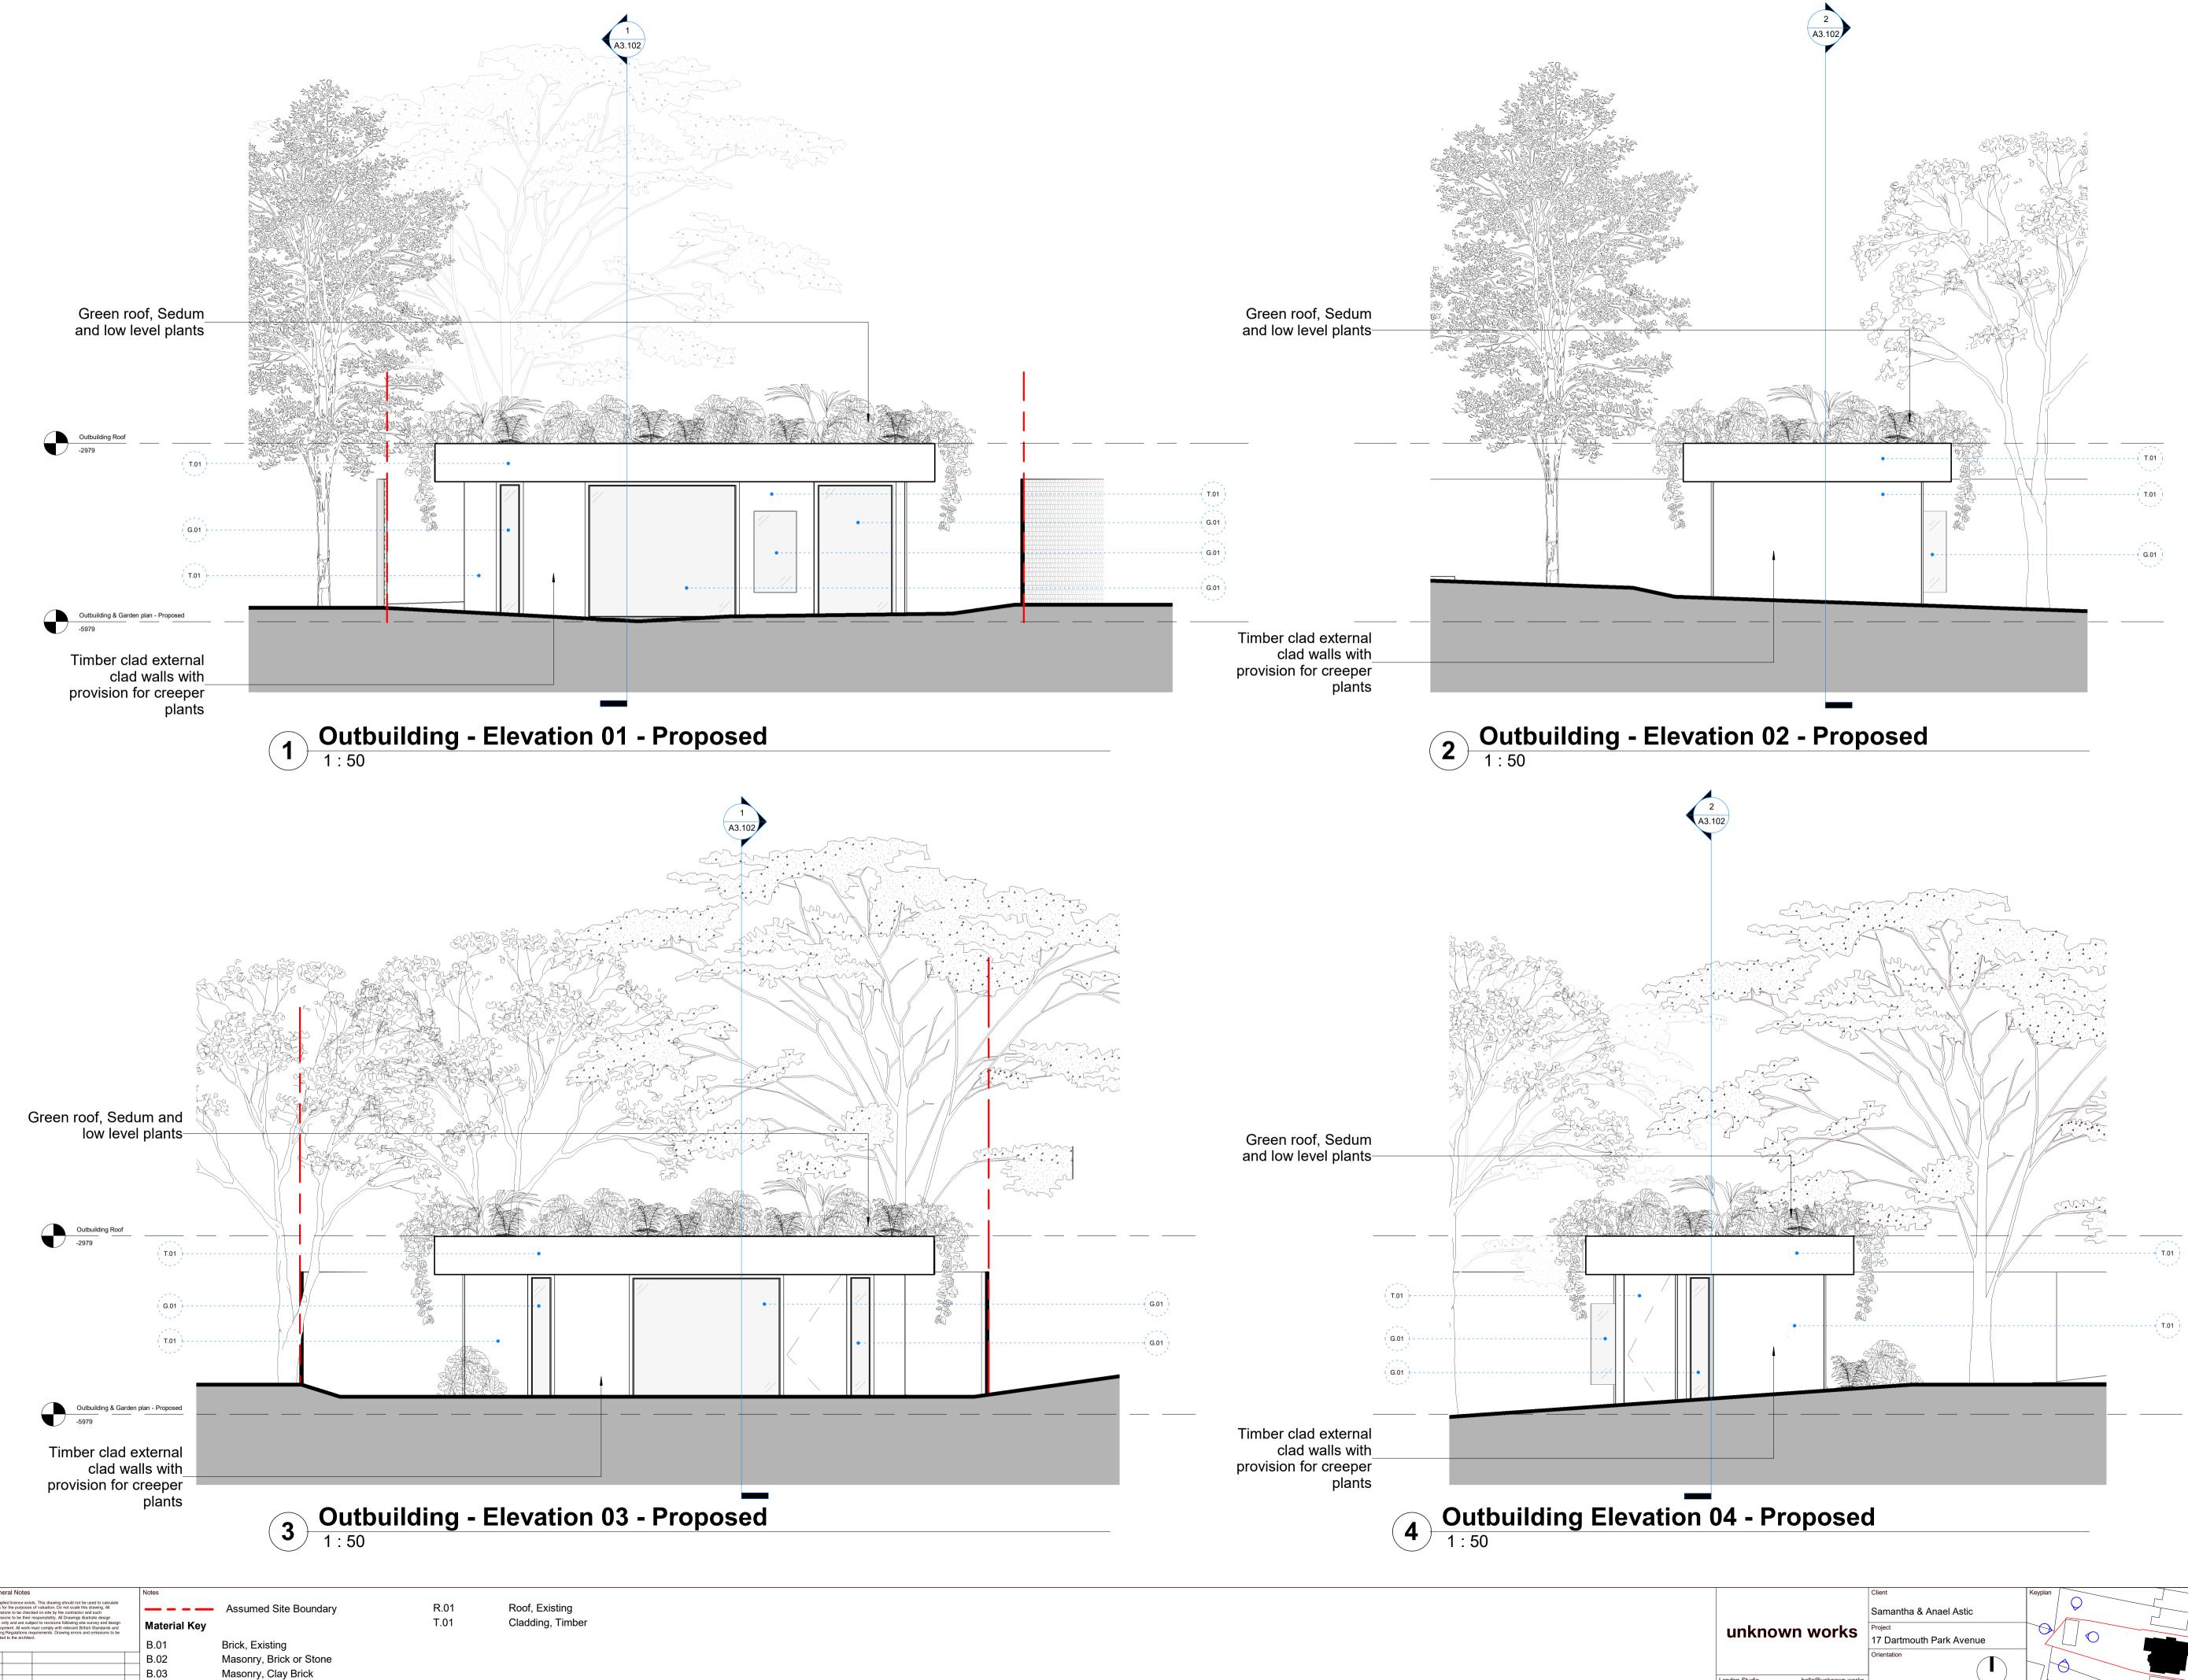

Glass, Double Glazed, Aluminium Frame

Glass, Obscure Glazed, Glass Blocks

Paint, White

G.01 G.02


P.01


 1
 Planning
 20/04/2

 Rev
 Description
 Date

London Studio Studio 8A, Stamford X Gillet Street, N16 8JH hello@unknown.works +44 (0) 2081917134 Hong Kong Studio Unit 20B 64 Victoria Road Kwong Ga Factory Building © unknown works

	Client	Keyplan Drawing Title	
	Samantha & Anael Astic	Outbuilding Elevations	
	Project	Project Number Status	
	17 Dartmouth Park Avenue		ing
	Orientation	Scale at A1/A3 Date	
		20/04/	23
3		Drawn by Checked	by
	Scale	uw	
	0 1m 2m	Drawing Number	Revision
	@ 1:50	0046-UW-04-03-DR-A-A2.104	1

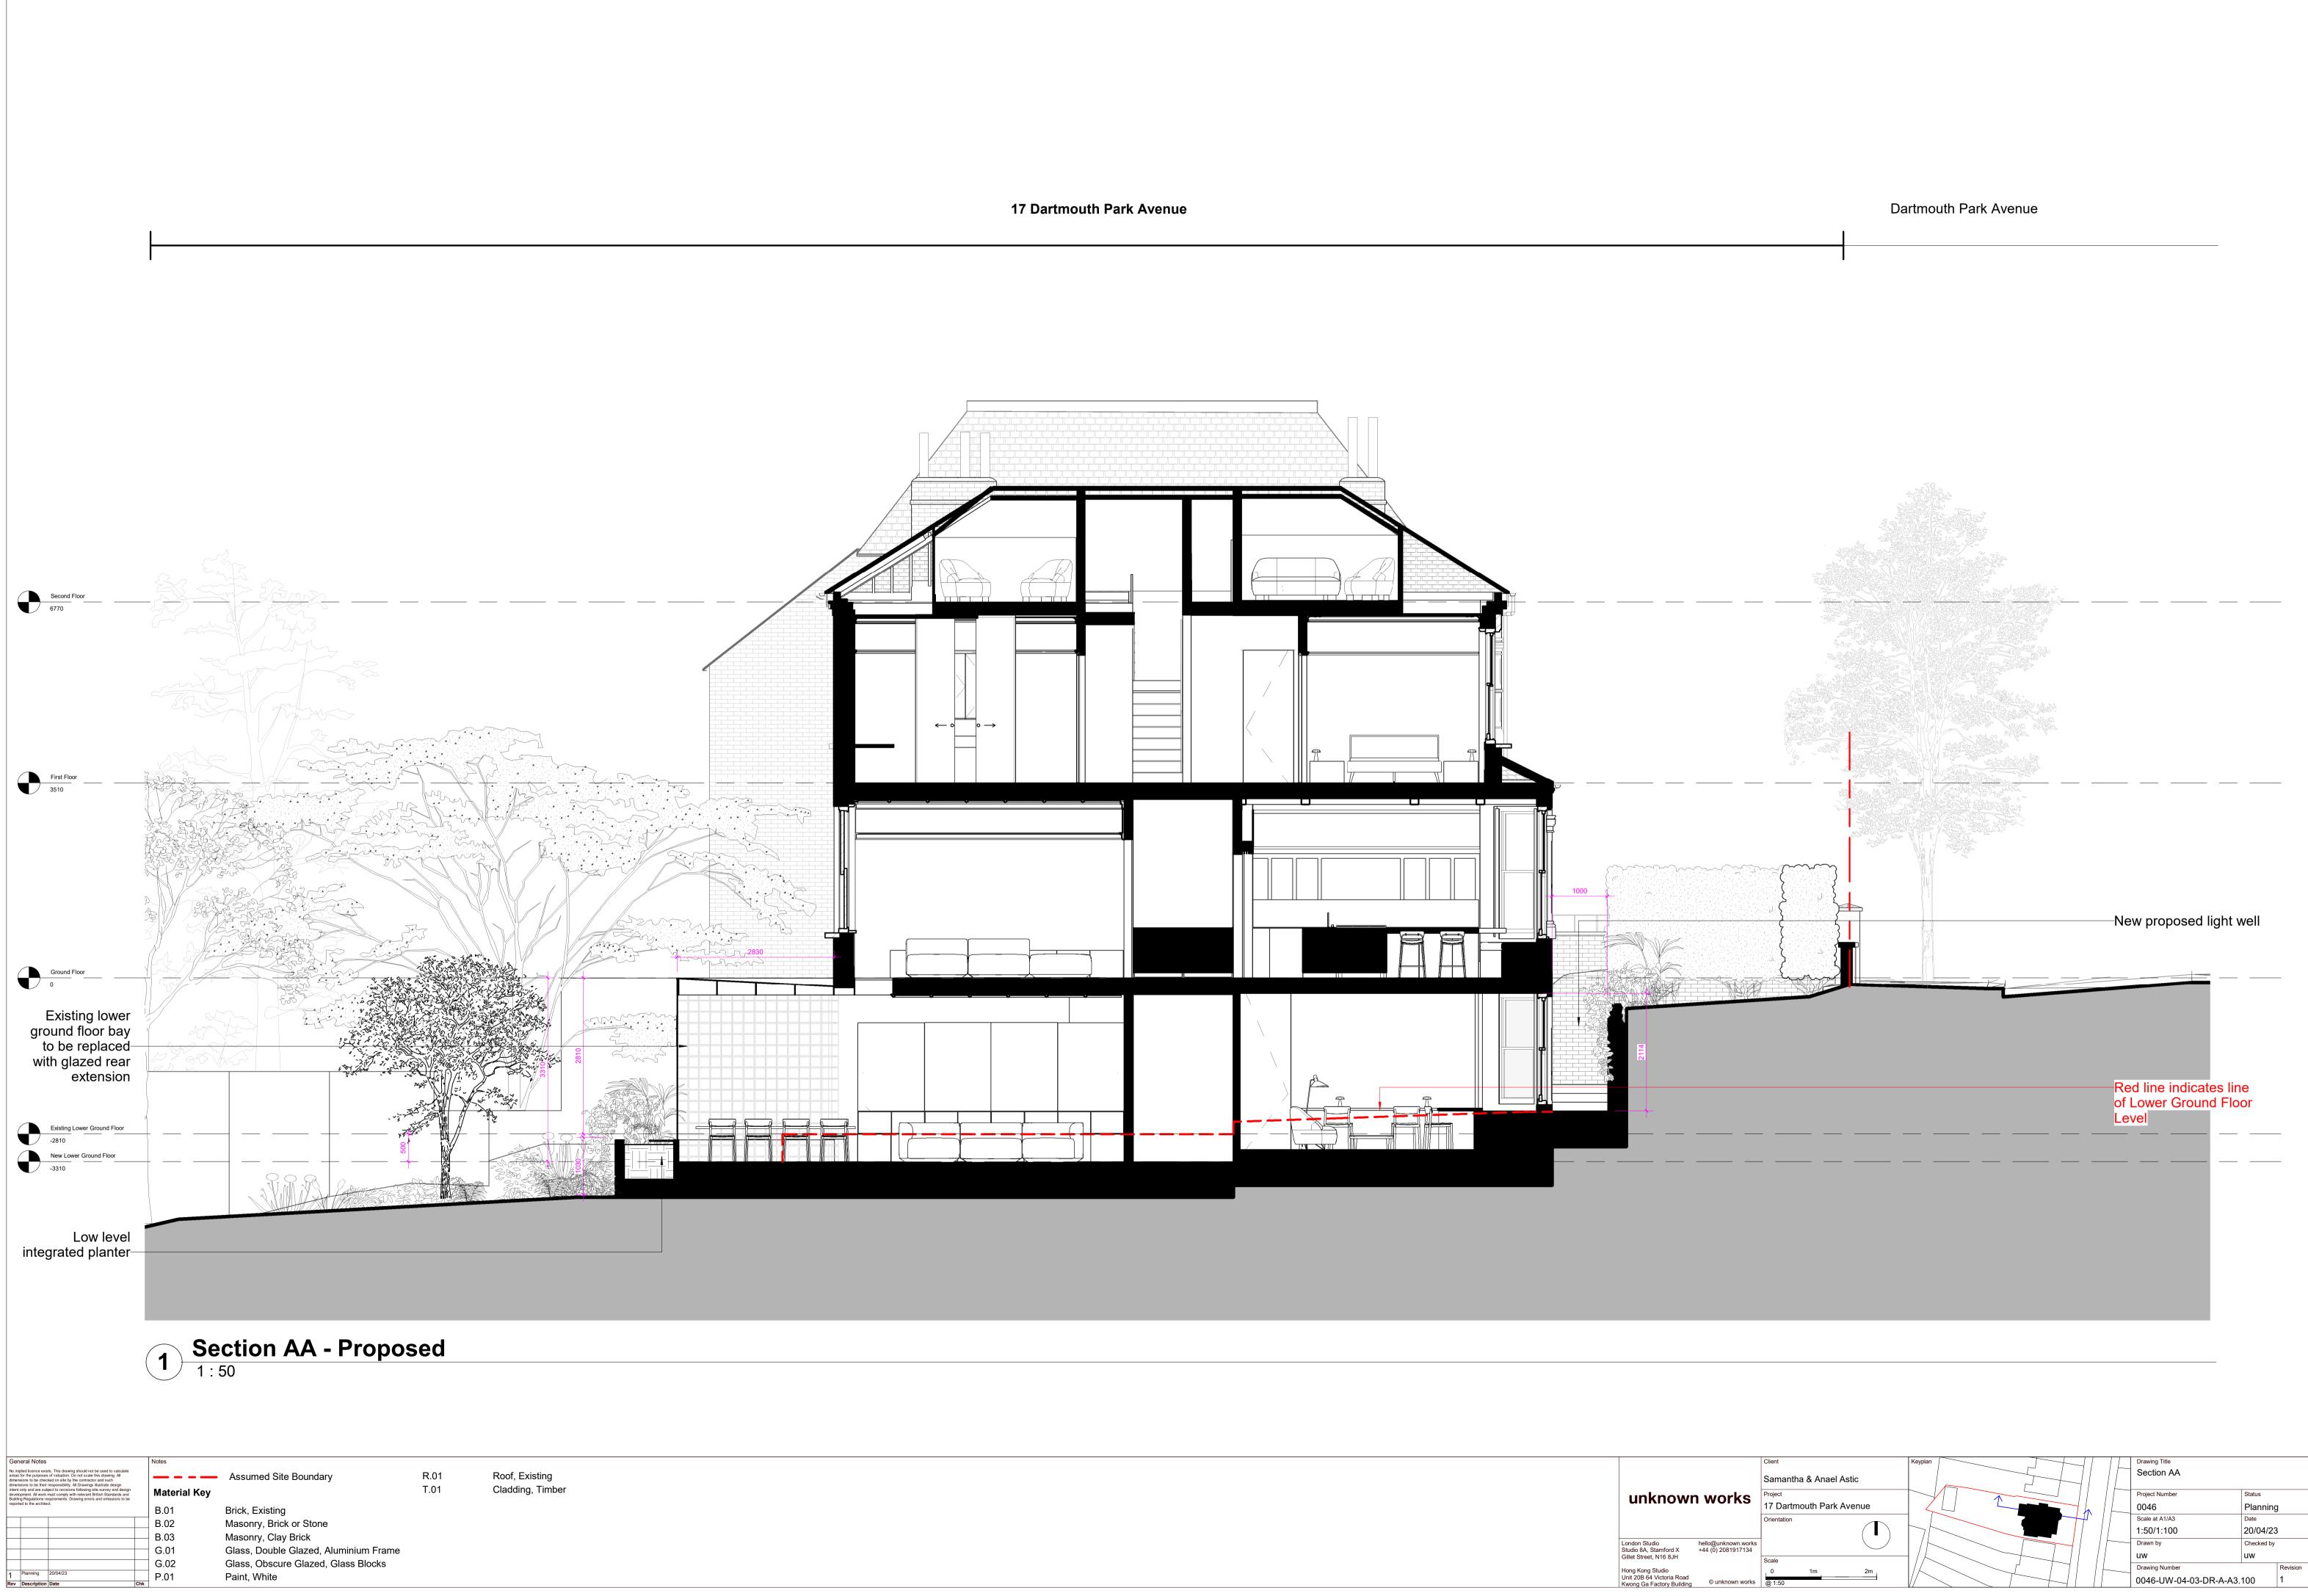

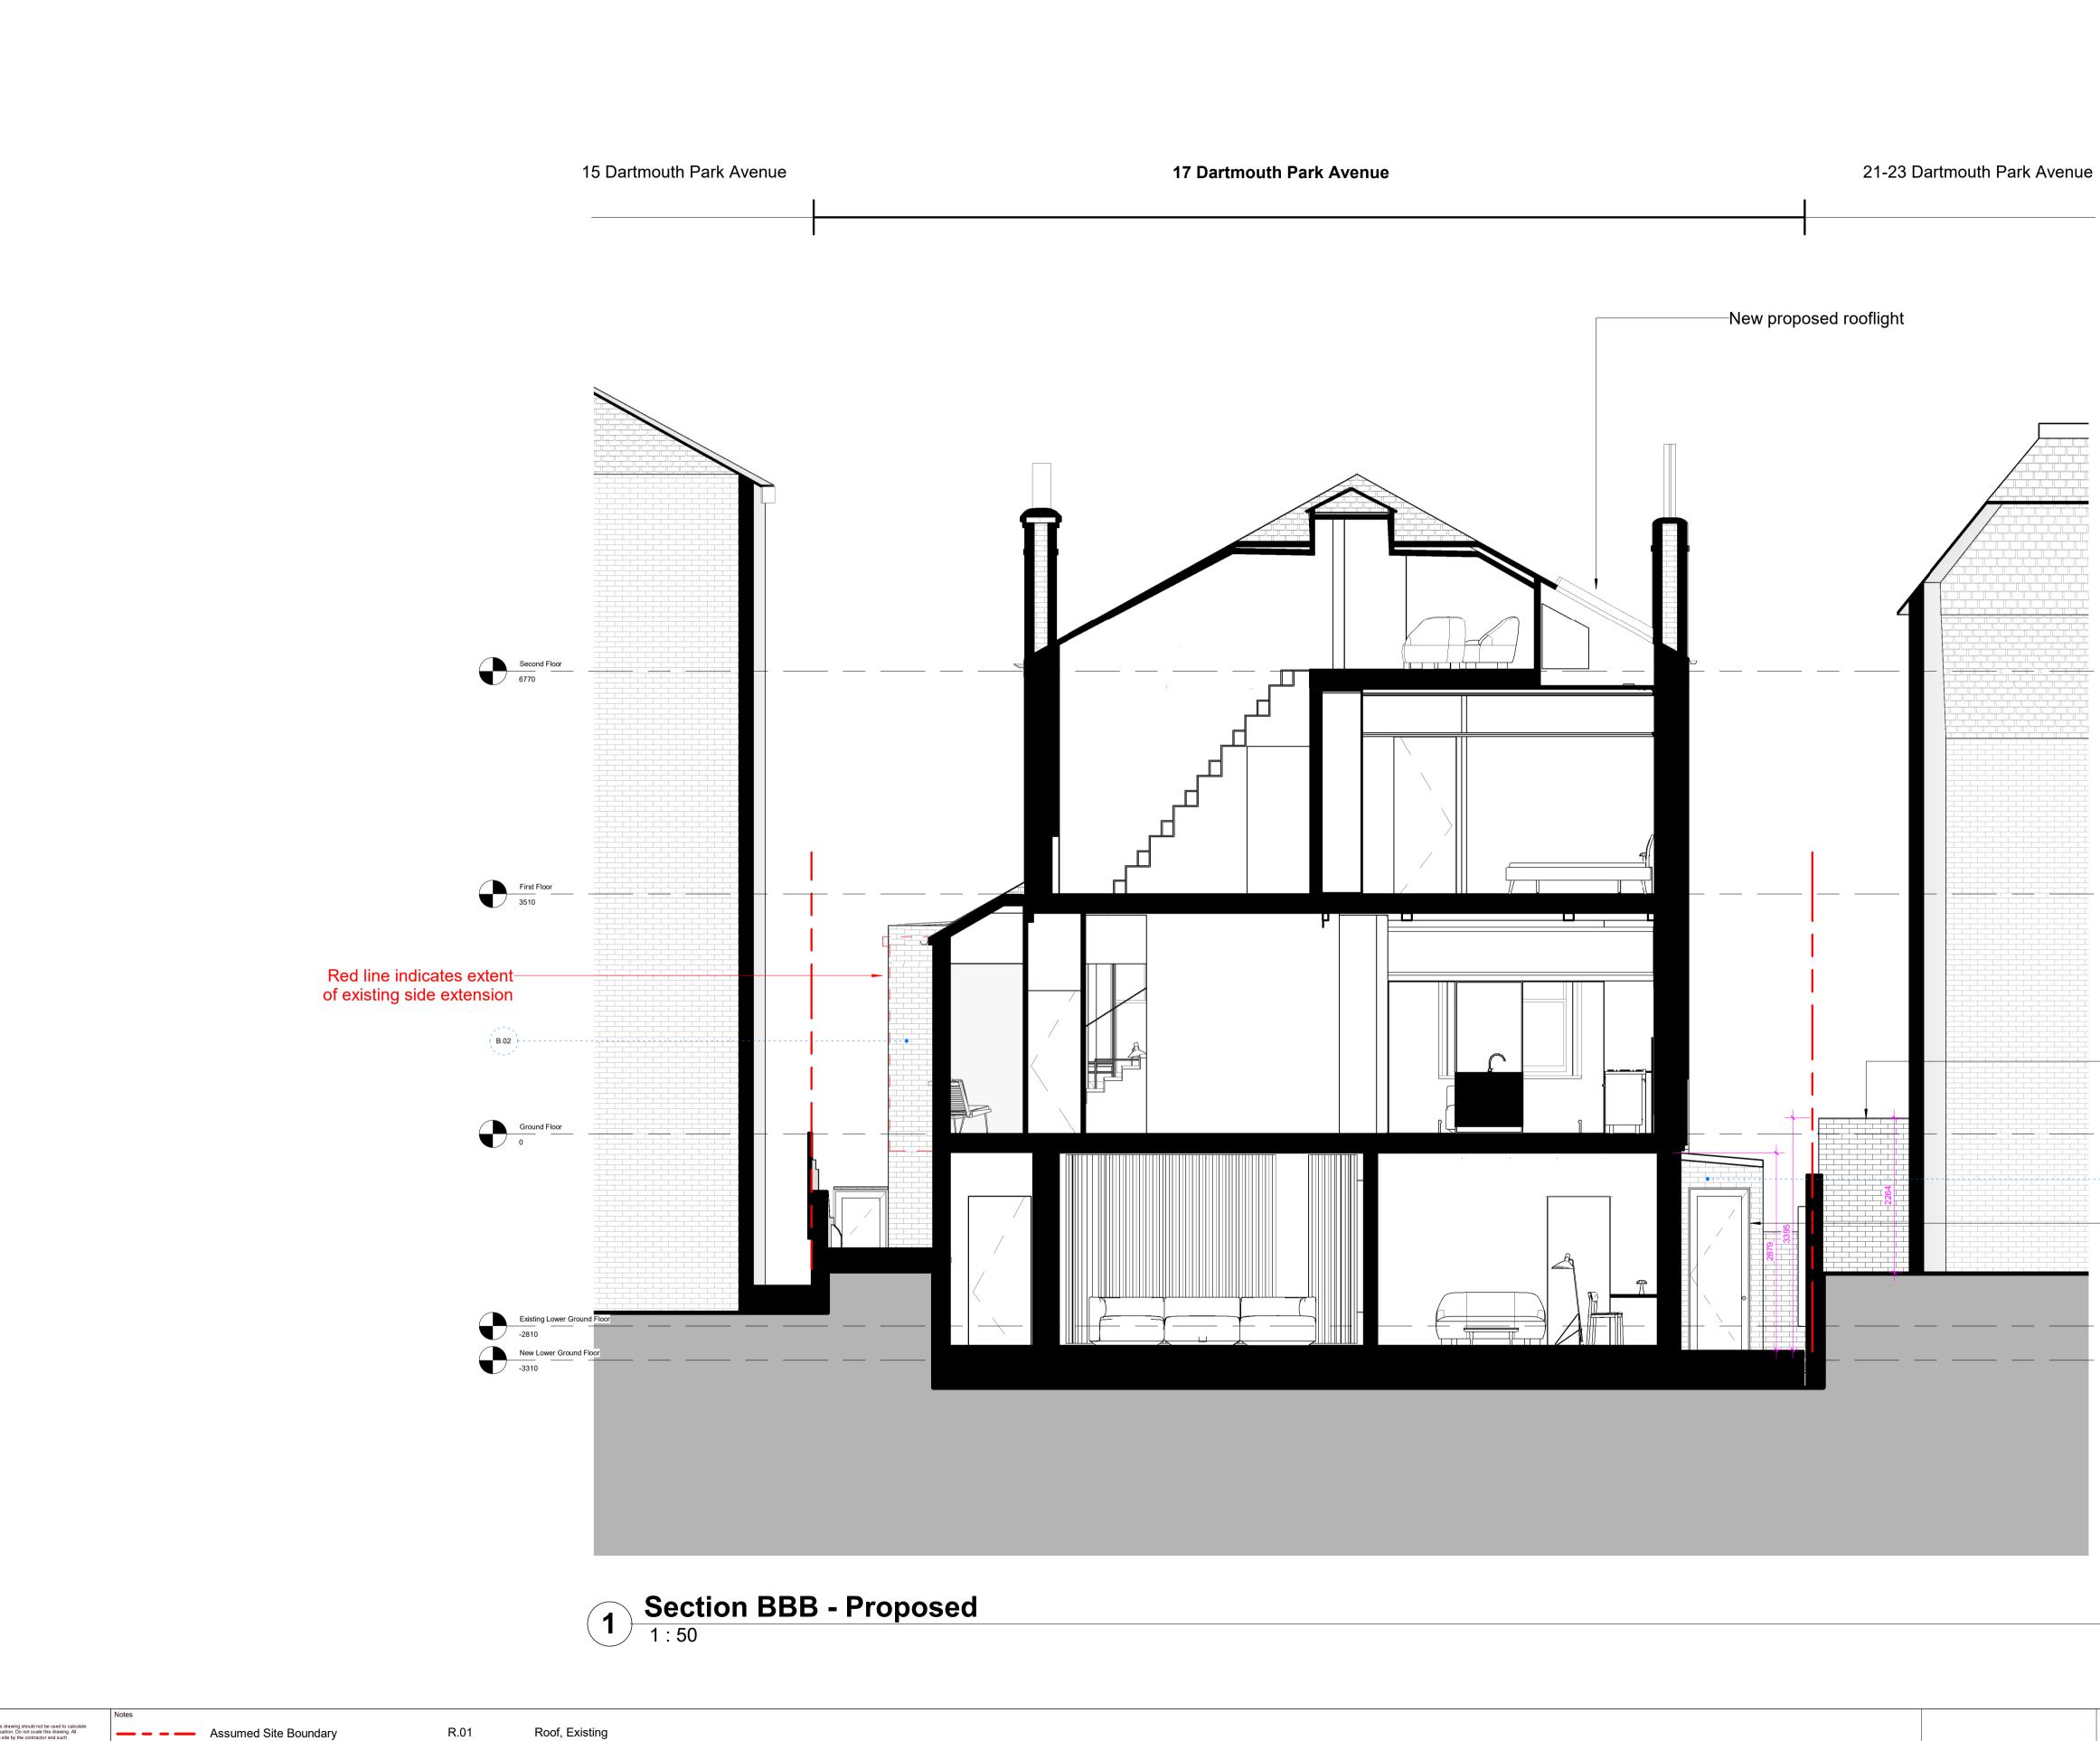

Ger	neral Notes			Notes
areas dimer dimer intent devel Buildi	for the purposes isons to be chec isons to be their only and are sub opment. All work ng Regulations re	ts. This drawing should not be used to calculate of valuation. Do not scale this drawing. All ked on site by the contractor and such responsibility. All Drawings illustrate design ject to revisions following site survey and design must comply with relevant British Standards and quirements. Drawing errors and omissions to be		Material Key
repor	ted to the archite	cl.		B.01
				B.02
				B.03
				G.01
				G.02
1	Planning	20/04/23		P.01
Rev	Description	Date	Chk	1

Brick, Existing Masonry, Brick or Stone Masonry, Clay Brick Glass, Double Glazed, Aluminium Frame Glass, Obscure Glazed, Glass Blocks Paint, White

R.01 T.01

Roof, Existing Cladding, Timber


unknown works

London Studio Studio 8A, Stamford X Gillet Street, N16 8JH hello@unknown.works +44 (0) 2081917134 Hong Kong Studio Unit 20B 64 Victoria Road Kwong Ga Factory Building © unknown works Neighbour's existing side return

—New proposed side storage unit

- (B.02)

Client	Keyplan	Drawing Title		
Samantha & Anael Astic		Section BB		
Project		Project Number	Status	
17 Dartmouth Park Avenue		0046	Plannin	g
Orientation		Scale at A1/A3	Date	
		1:50/1:100	20/04/2	3
		Drawn by	Checked b	y
Scale	$-1/k \sim$	uw	uw	
. 0 1m 2m .		Drawing Number		Revision
@ 1:50		0046-UW-04-03-E	DR-A-A3.101	1

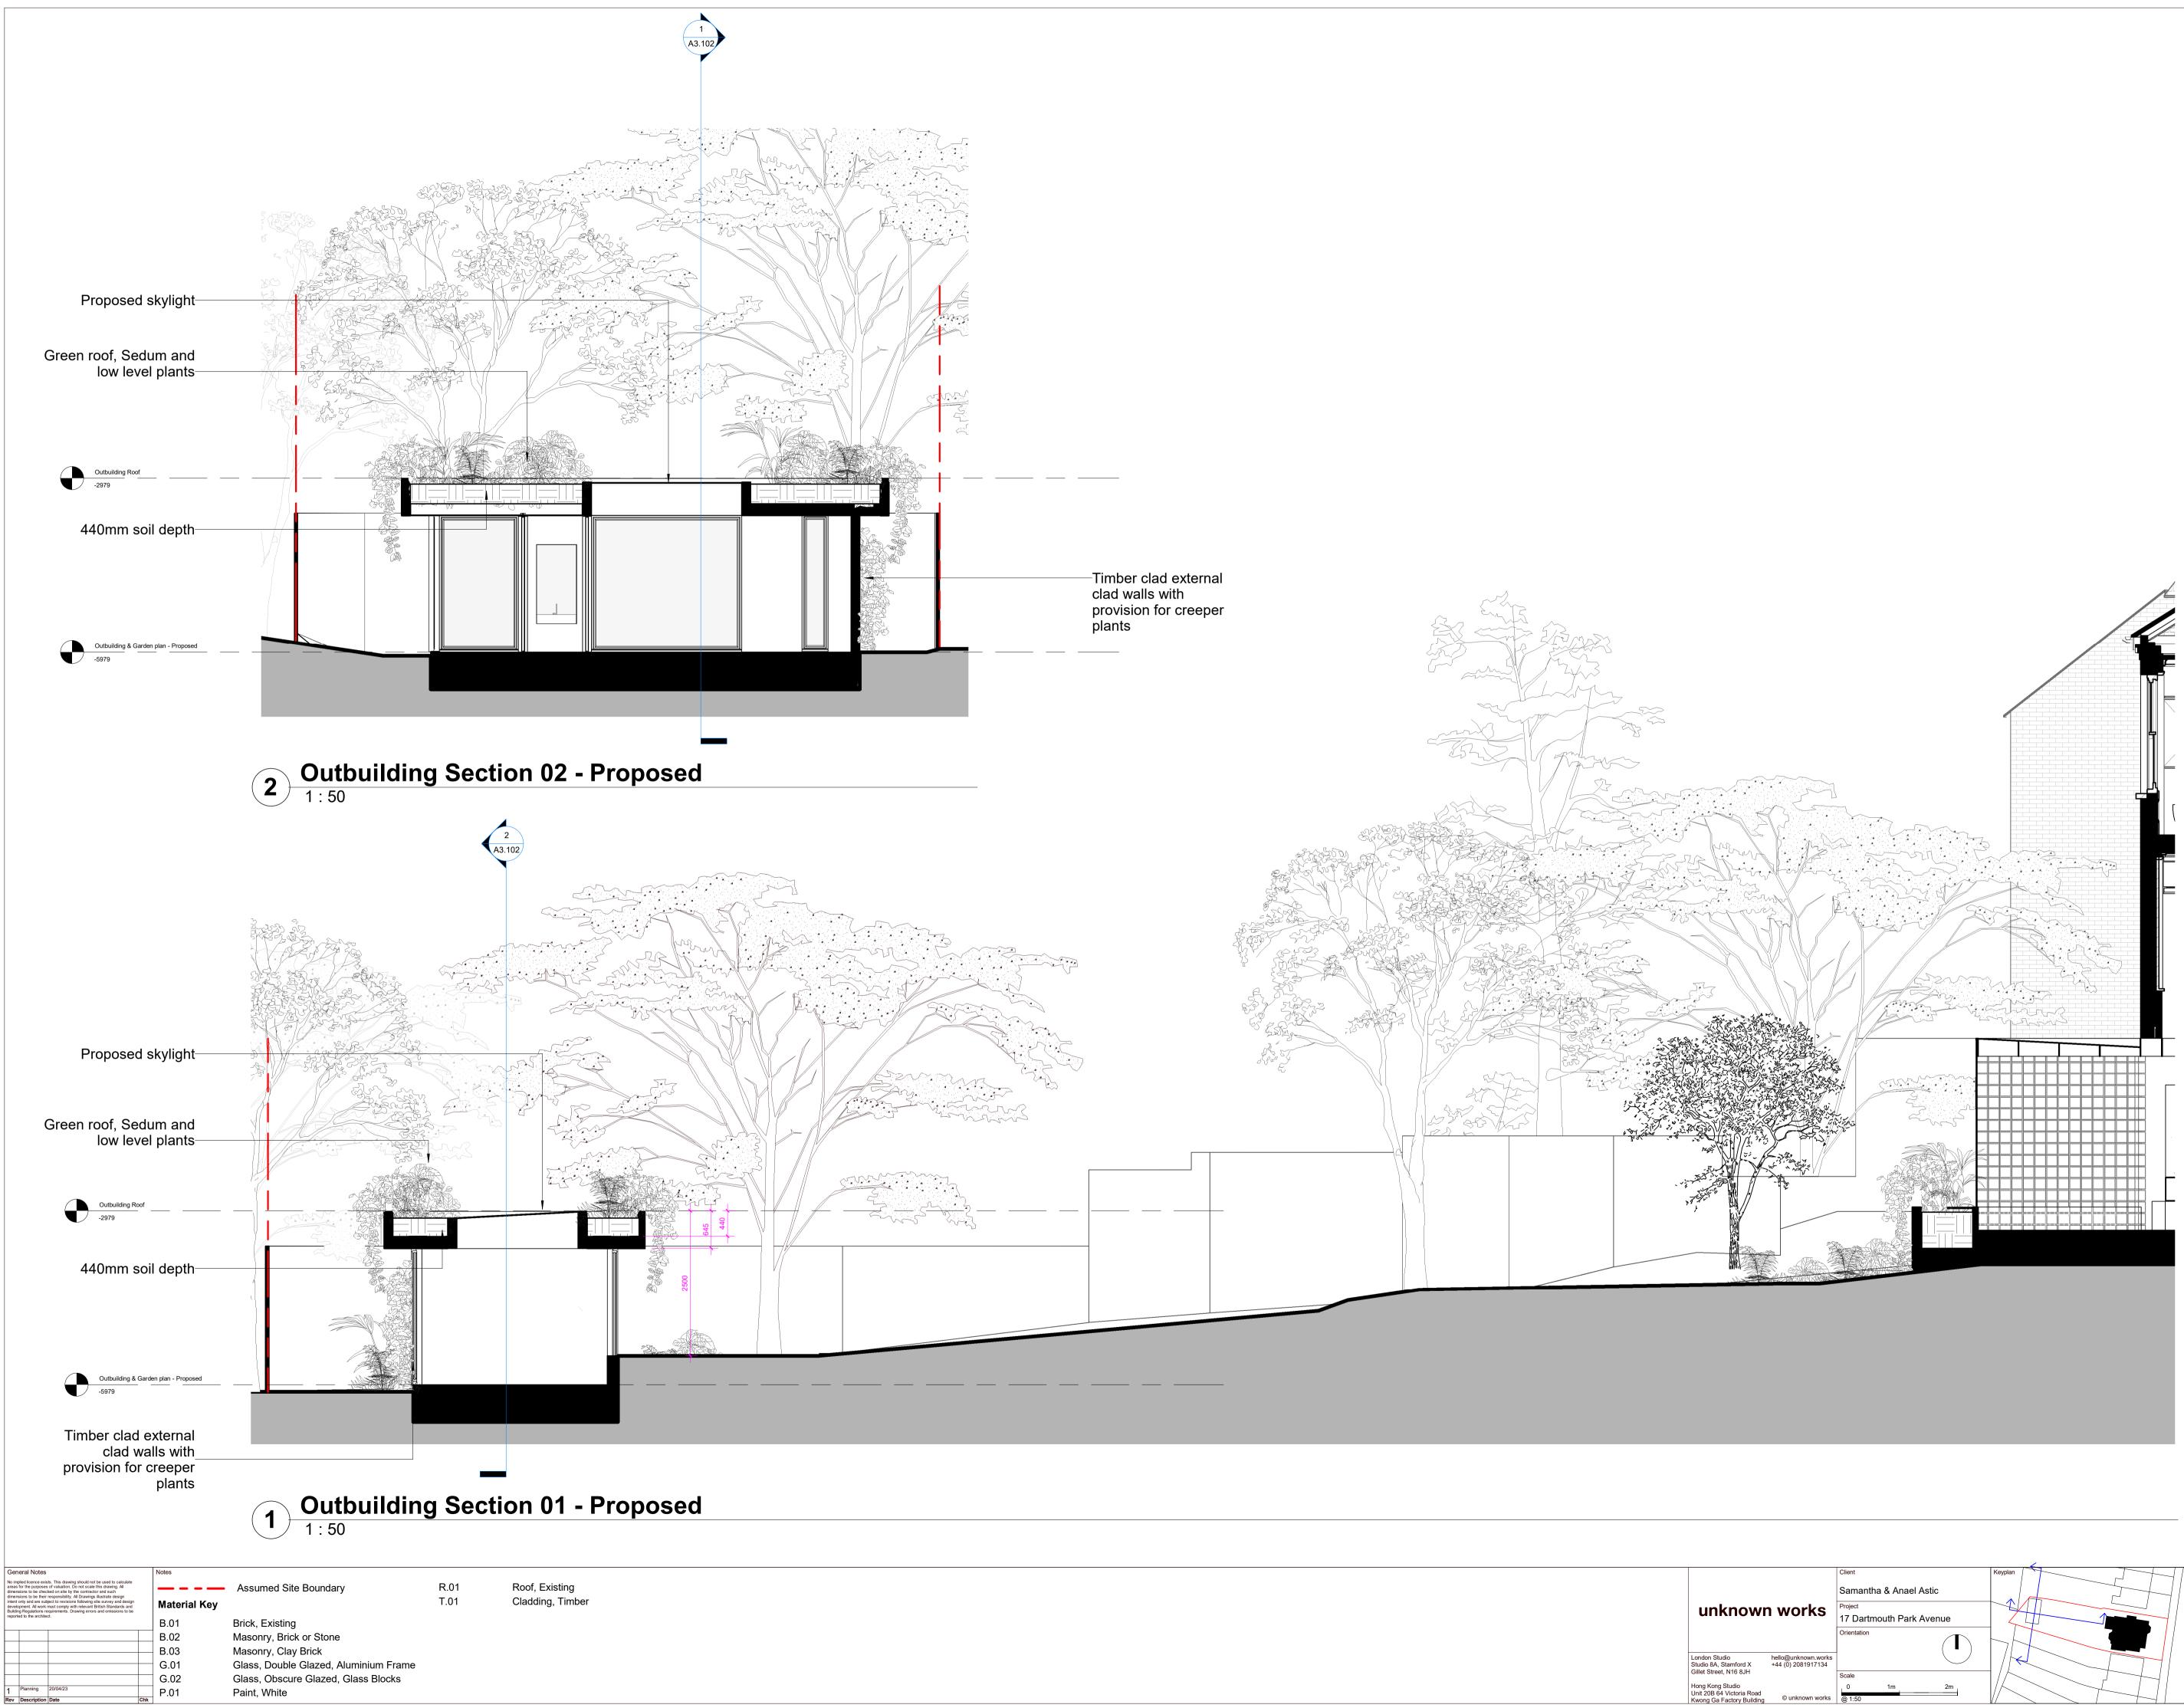

P.01

Paint, White

Hong Kong Studio Unit 20B 64 Victoria Road Kwong Ga Factory Building © unknown works

2m

Drawing Title Outbuilding Sections

Project Number	Status	
0046	Planning	
Scale at A1/A3	Date	
1:50/1:100	20/04/23	
Drawn by	Checked by	
uw	uw	
Drawing Number		Revision

0046-UW-04-03-DR-A-A3.102 1