


notes:  
 Do not scale from this drawing  
 All dimensions to be checked on site and any discrepancies reported to the Architect/Contract Administrator before proceeding with the works on site, or off-site fabrication  
 Subject to site survey and inspection




AS INSTALLED A/C UNITS

5 to 7 Brecon Mews

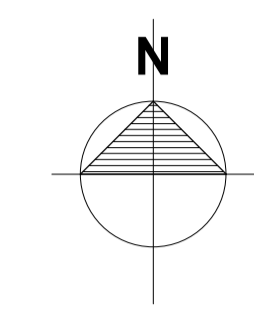

LOCATION PLAN 1:1250

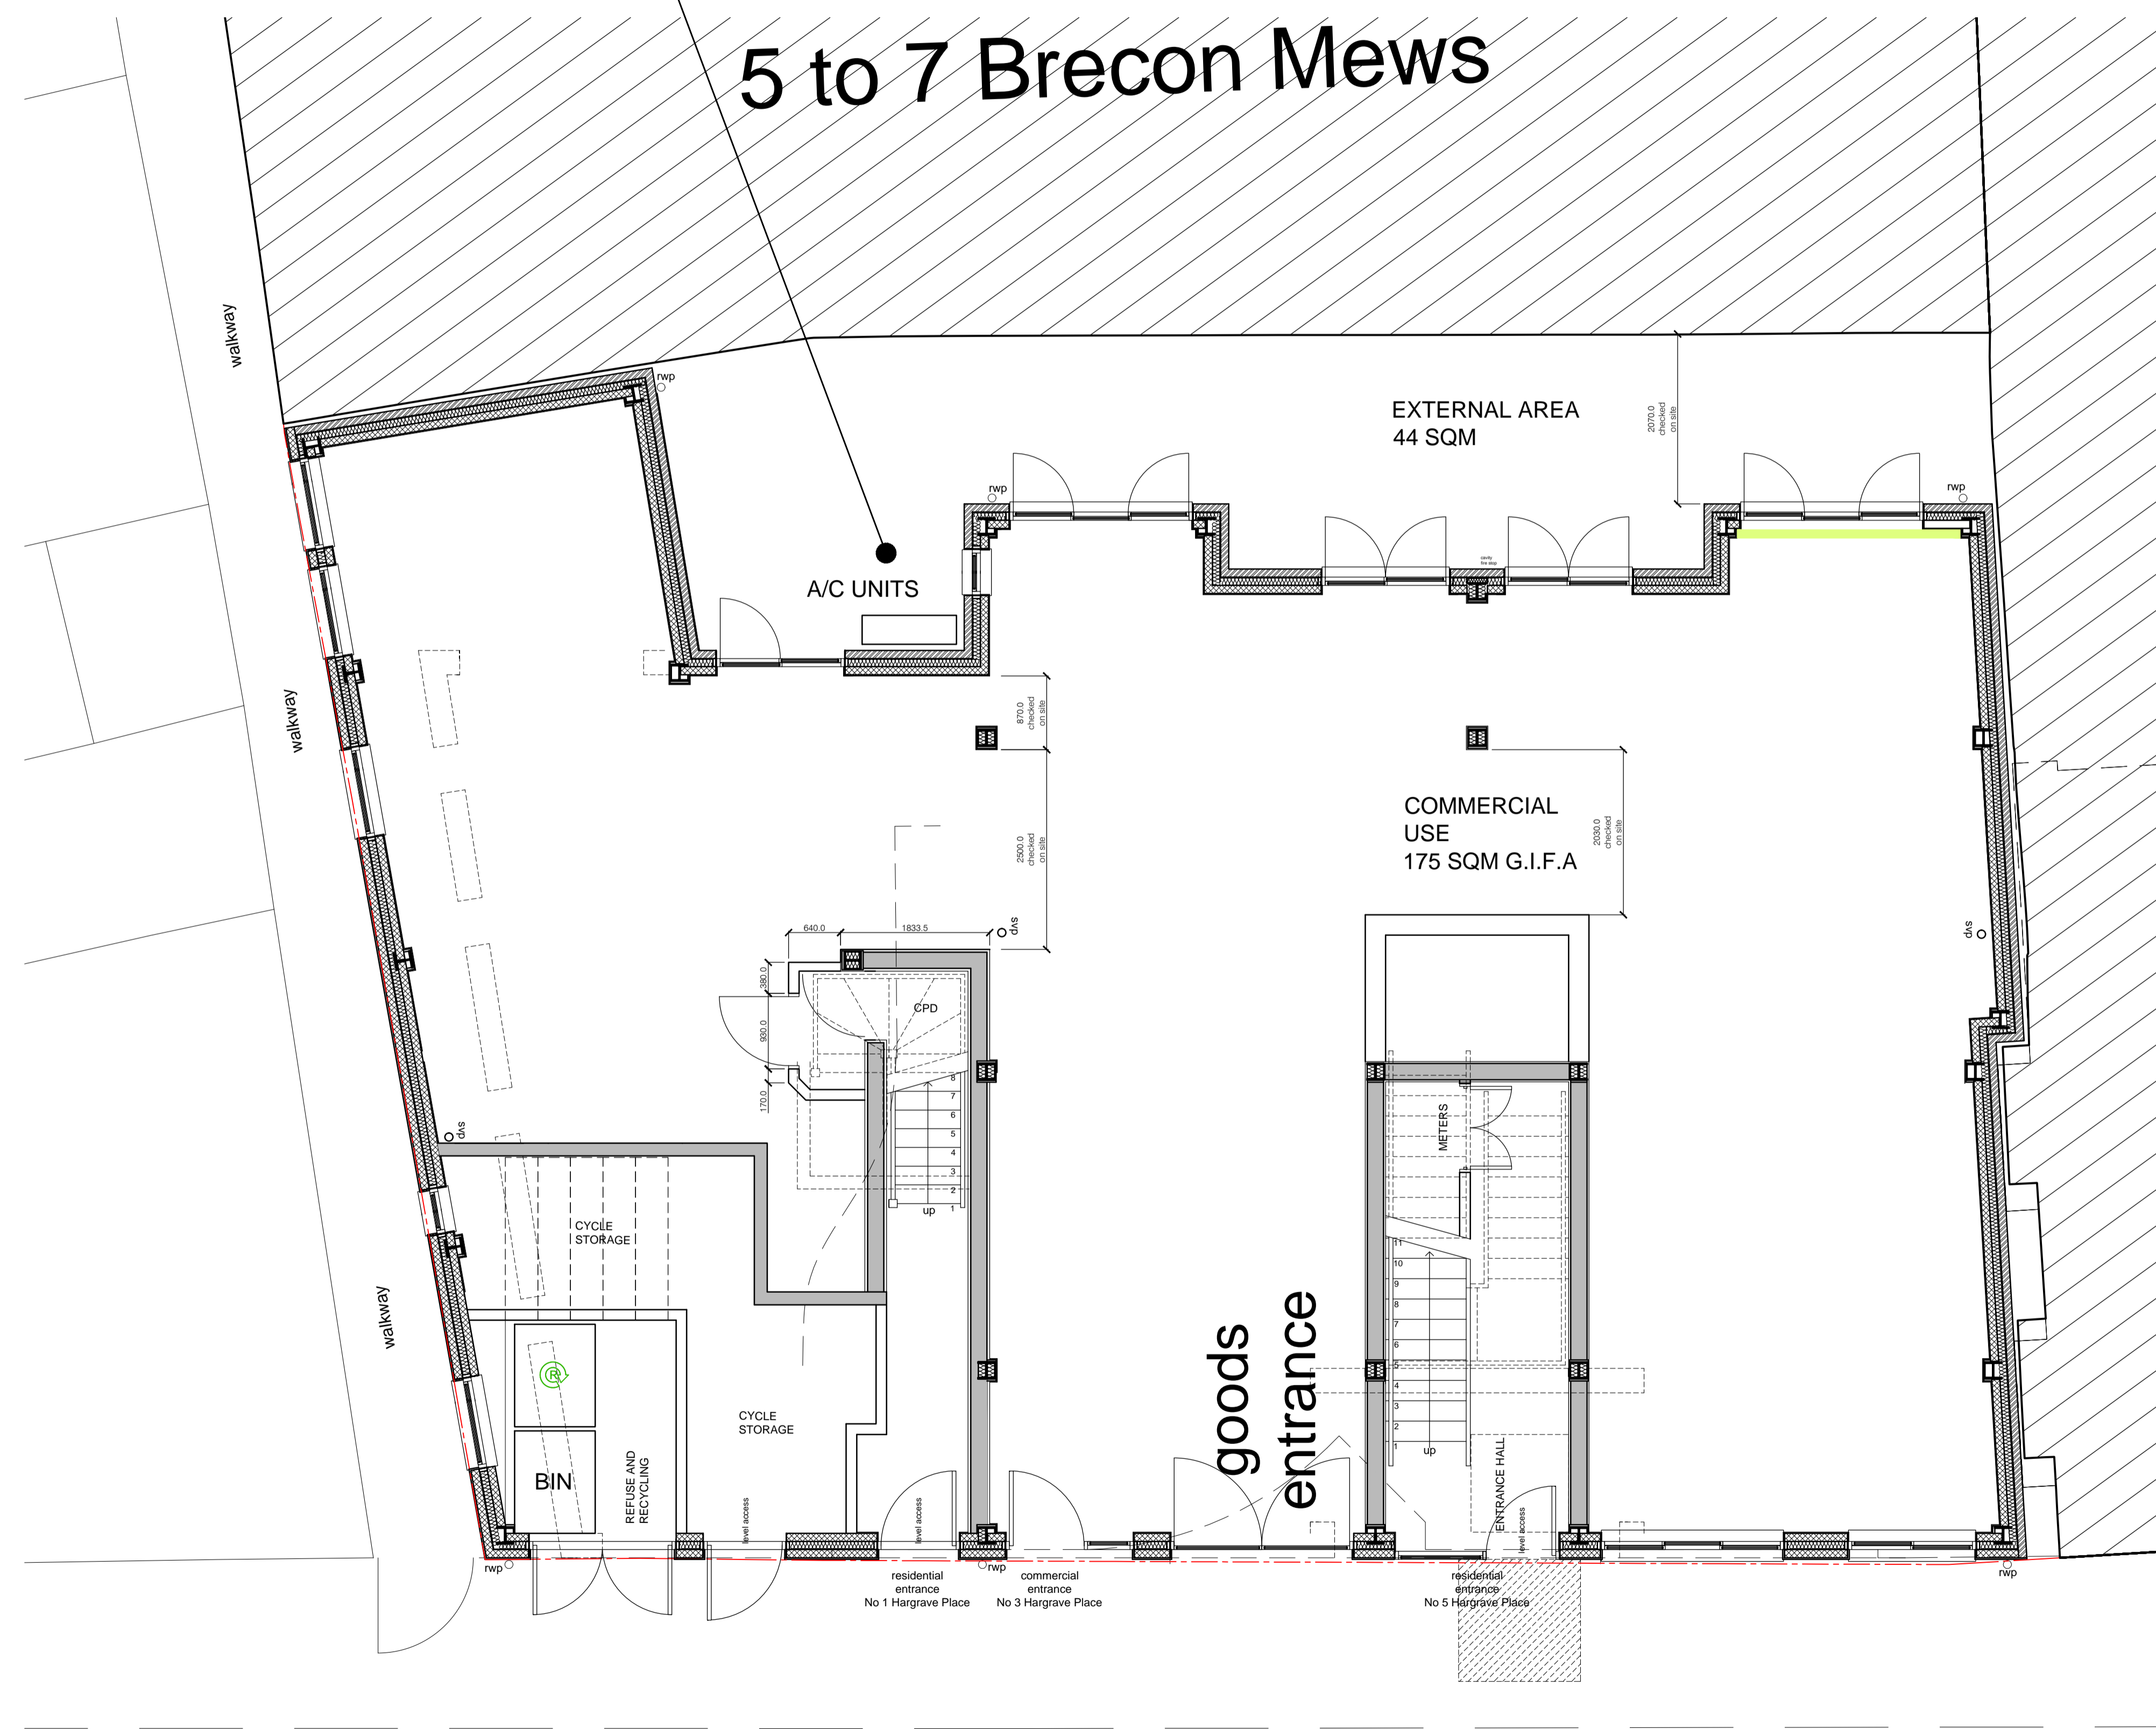

GROUND FLOOR PLAN 1:50



BLOCK PLAN 1:500

For Approval

| revision   | description | date  |
|--|-------------|-------|
| <p>GENESIS ARCHITECTS LTD<br/>                     7 St Margarets Road, Stanstead Abbots<br/>                     Ware Hertfordshire SG12 8BP<br/>                     T: 01920 877998<br/>                     F: 01920 877998<br/>                     E: genesisarchitects@btconnect.com<br/>                     W: www.genesisarchitects.ltd.uk</p> |             |       |
| <p>client<br/>                     Hargrave Developments Ltd</p>   |             |       |
| <p>project<br/>                     PROPOSED GF A/C UNITS<br/>                     3 HARGRAVE PLACE<br/>                     LONDON<br/>                     N7 0BP</p>  |             |       |
| <p>title<br/>                     PROPOSED<br/>                     SITE PLANS<br/>                     GROUND FLOOR PLAN</p>  |             |       |
| date   | scale       | drawn |
| SEPT 17  | AS SHOWN    | IRMB  |
| drawing no   | revision    |       |
| GAL 200 (PC) 200 /   |             |       |