


Rev	Date

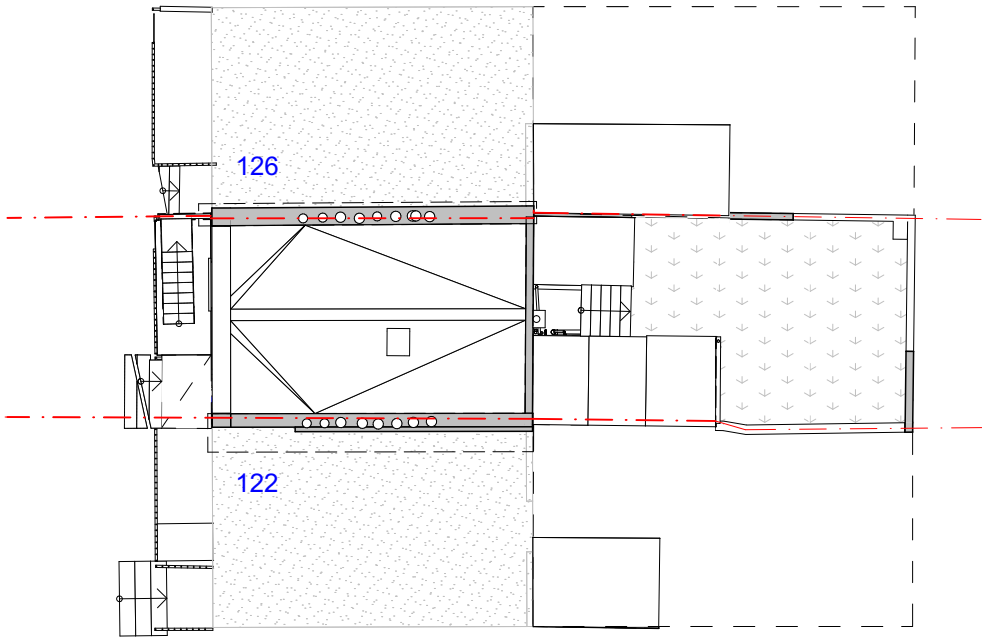

Existing Site plan

1:200



10b Branch Place
London N1 5PH
p: 0207 686 3445
e: info@scenarioarchitecture.com
w: www.scenarioarchitecture.com

Project Name:
124&124A St Pancras Way

Client:
Anya Thomas

Site Location:
**124&124A St Pancras Way
London NW1 9NB UK**

Drawing not to be used other than the purpose for which it was prepared. It's supplied without liability for errors or omissions. All dimensions are to be checked on site. This drawing is to be read in conjunction with all other drawings. Notes on this drawing will apply to all other drawings where a similar position exists.

Scale @ A3
1:200


Project No.
146

Drawing Name
Existing Site Plan

Drawing Number
EX-A0.01


Rev

SCALE 1:200
0 4 8m

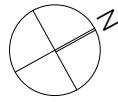

FOR PLANNING
Not For Construction

Rev Date

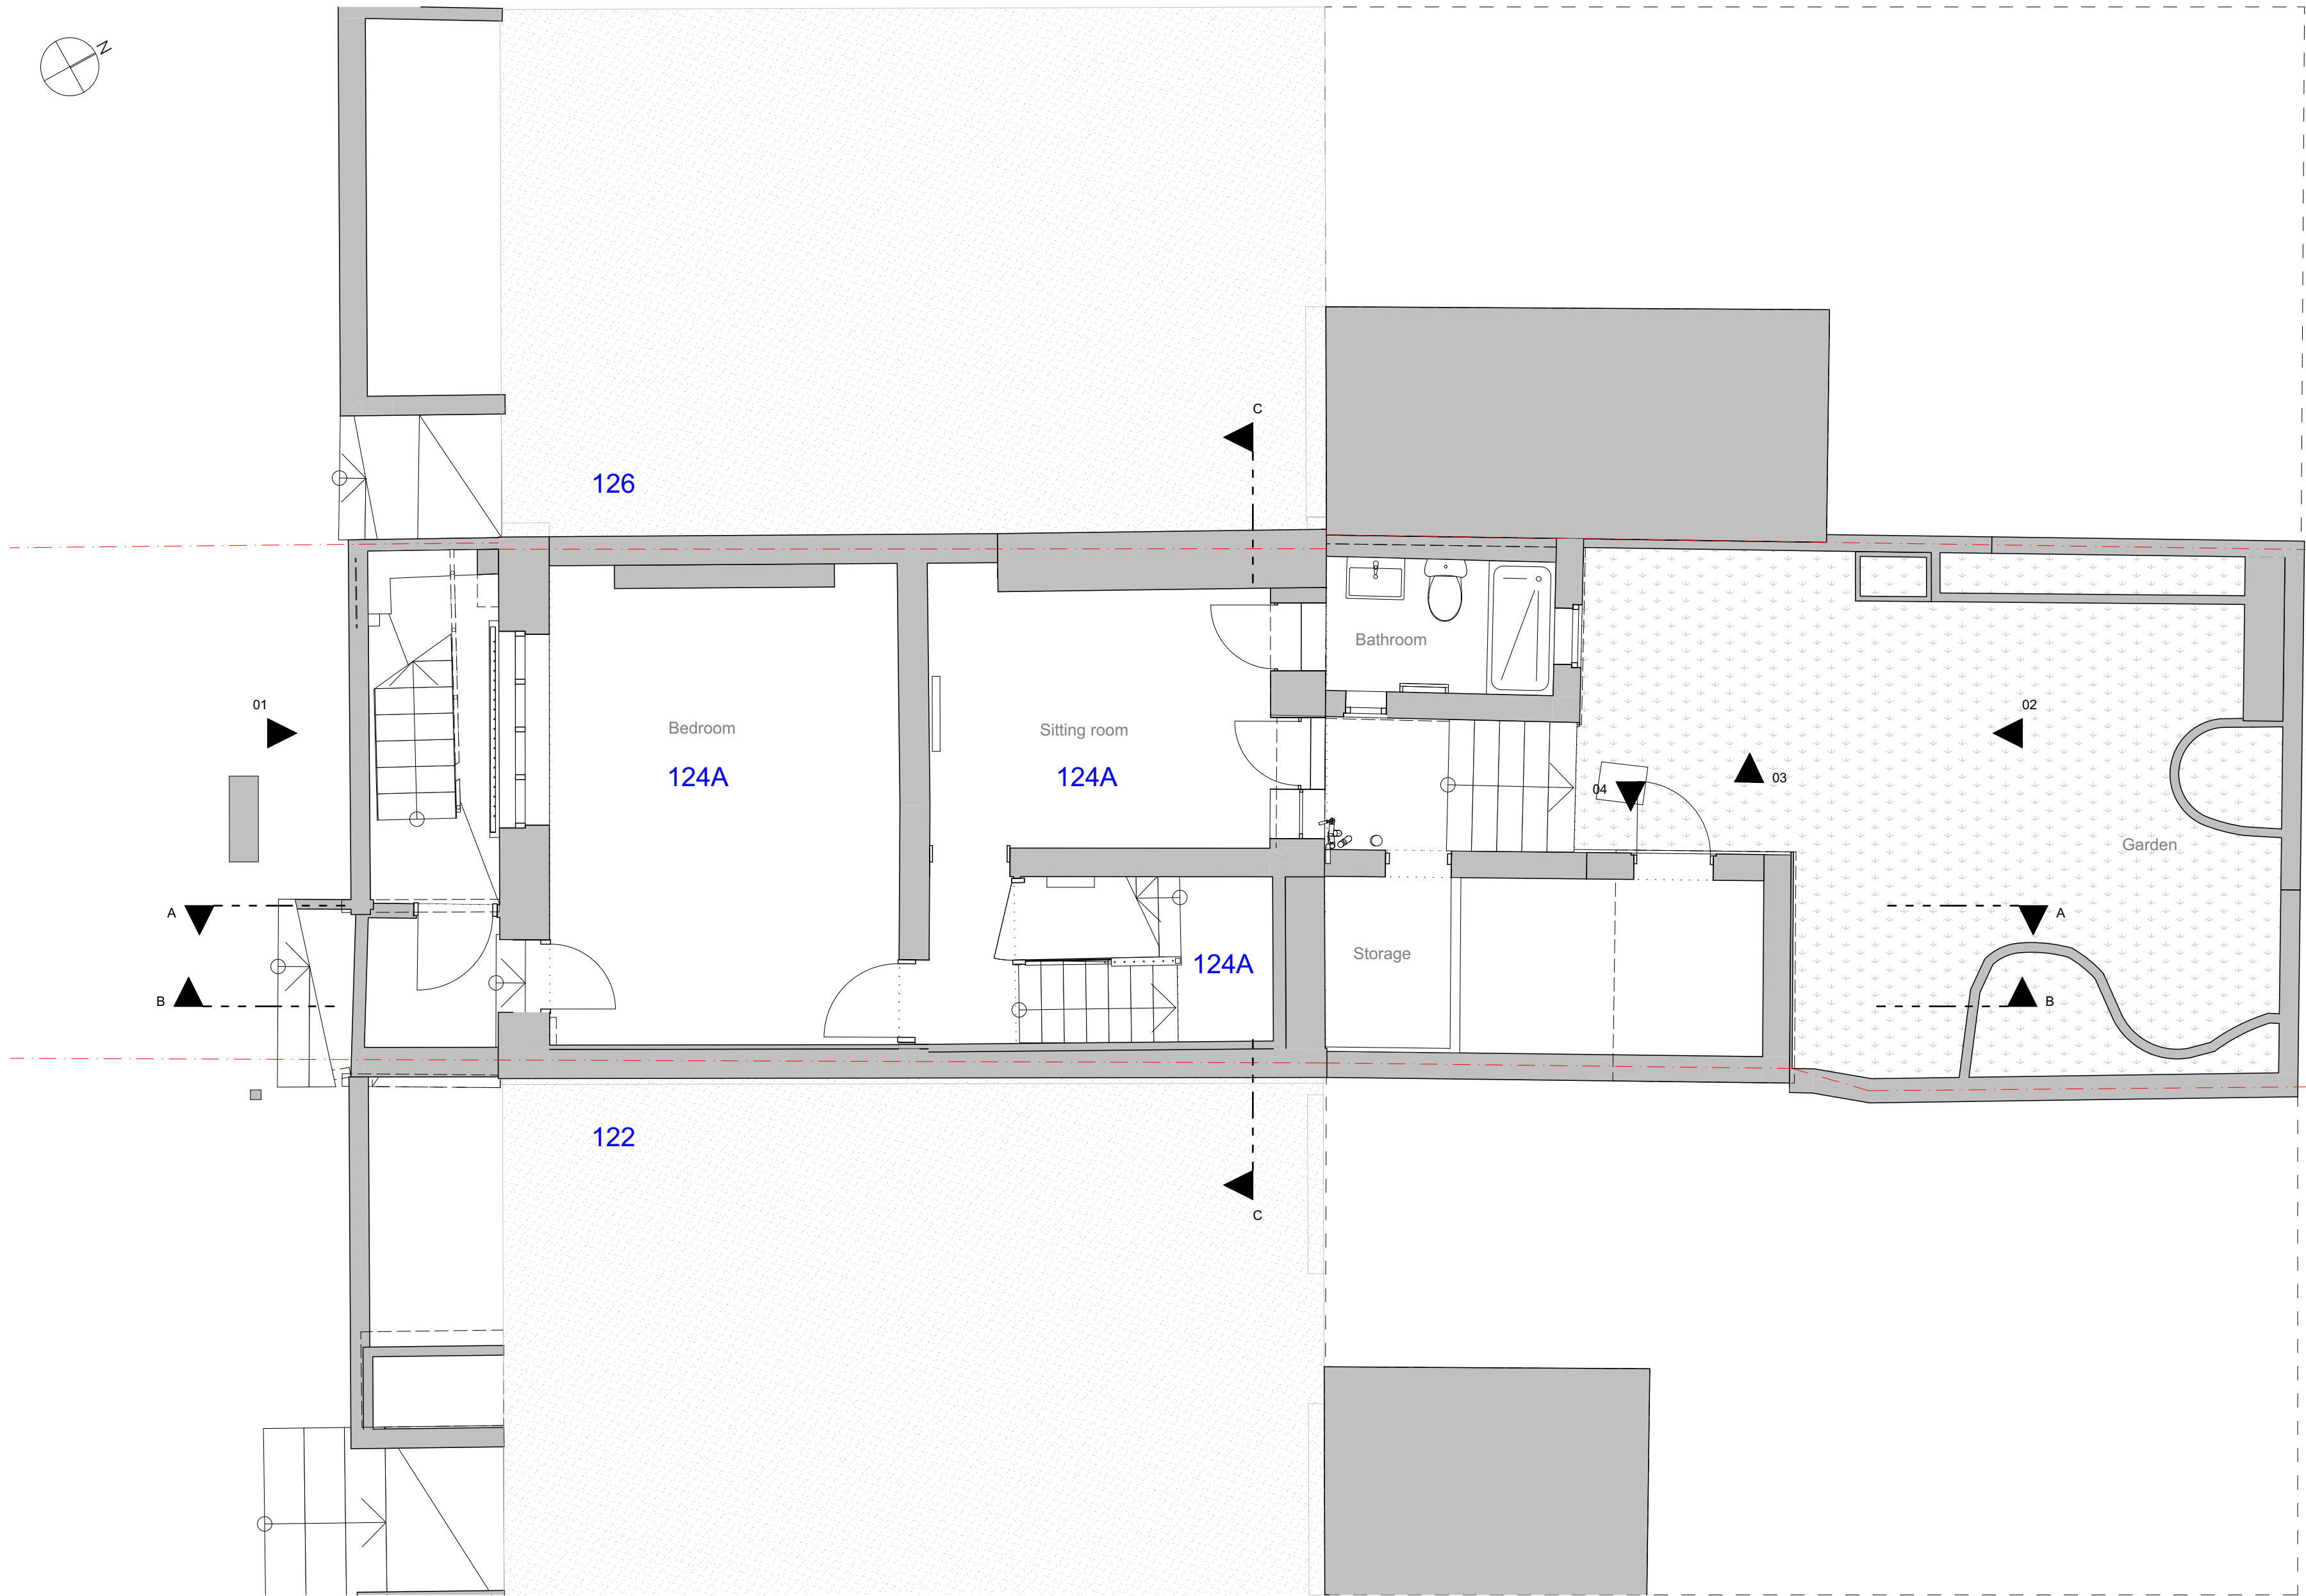

Lower Ground Floor

1:50

S/A

10b Branch Place
London N1 5PH
p: 0207 686 3445
e: info@scenarioarchitecture.com
w: www.scenarioarchitecture.com

Project Name:
124&124A St Pancras Way

Client:
Anya Thomas

Site Location:
124&124A St Pancras Way
London NW1 9NB UK

Drawing not to be used other than the purpose for which it was prepared. It's supplied without liability for errors or omissions. All dimensions are to be checked on site. This drawing is to be read in conjunction with all other drawings. Notes on this drawing will apply to all other drawings where a similar position exists.


Scale @ A2 Project No.
1:50 146

Drawing Name
Existing Lower Ground
Floor Plan

Drawing Number Rev


EX-A1.01

SCALE 1:50
0 1000 2000mm

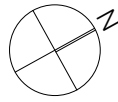

FOR PLANNING
Not For Construction

Rev Date

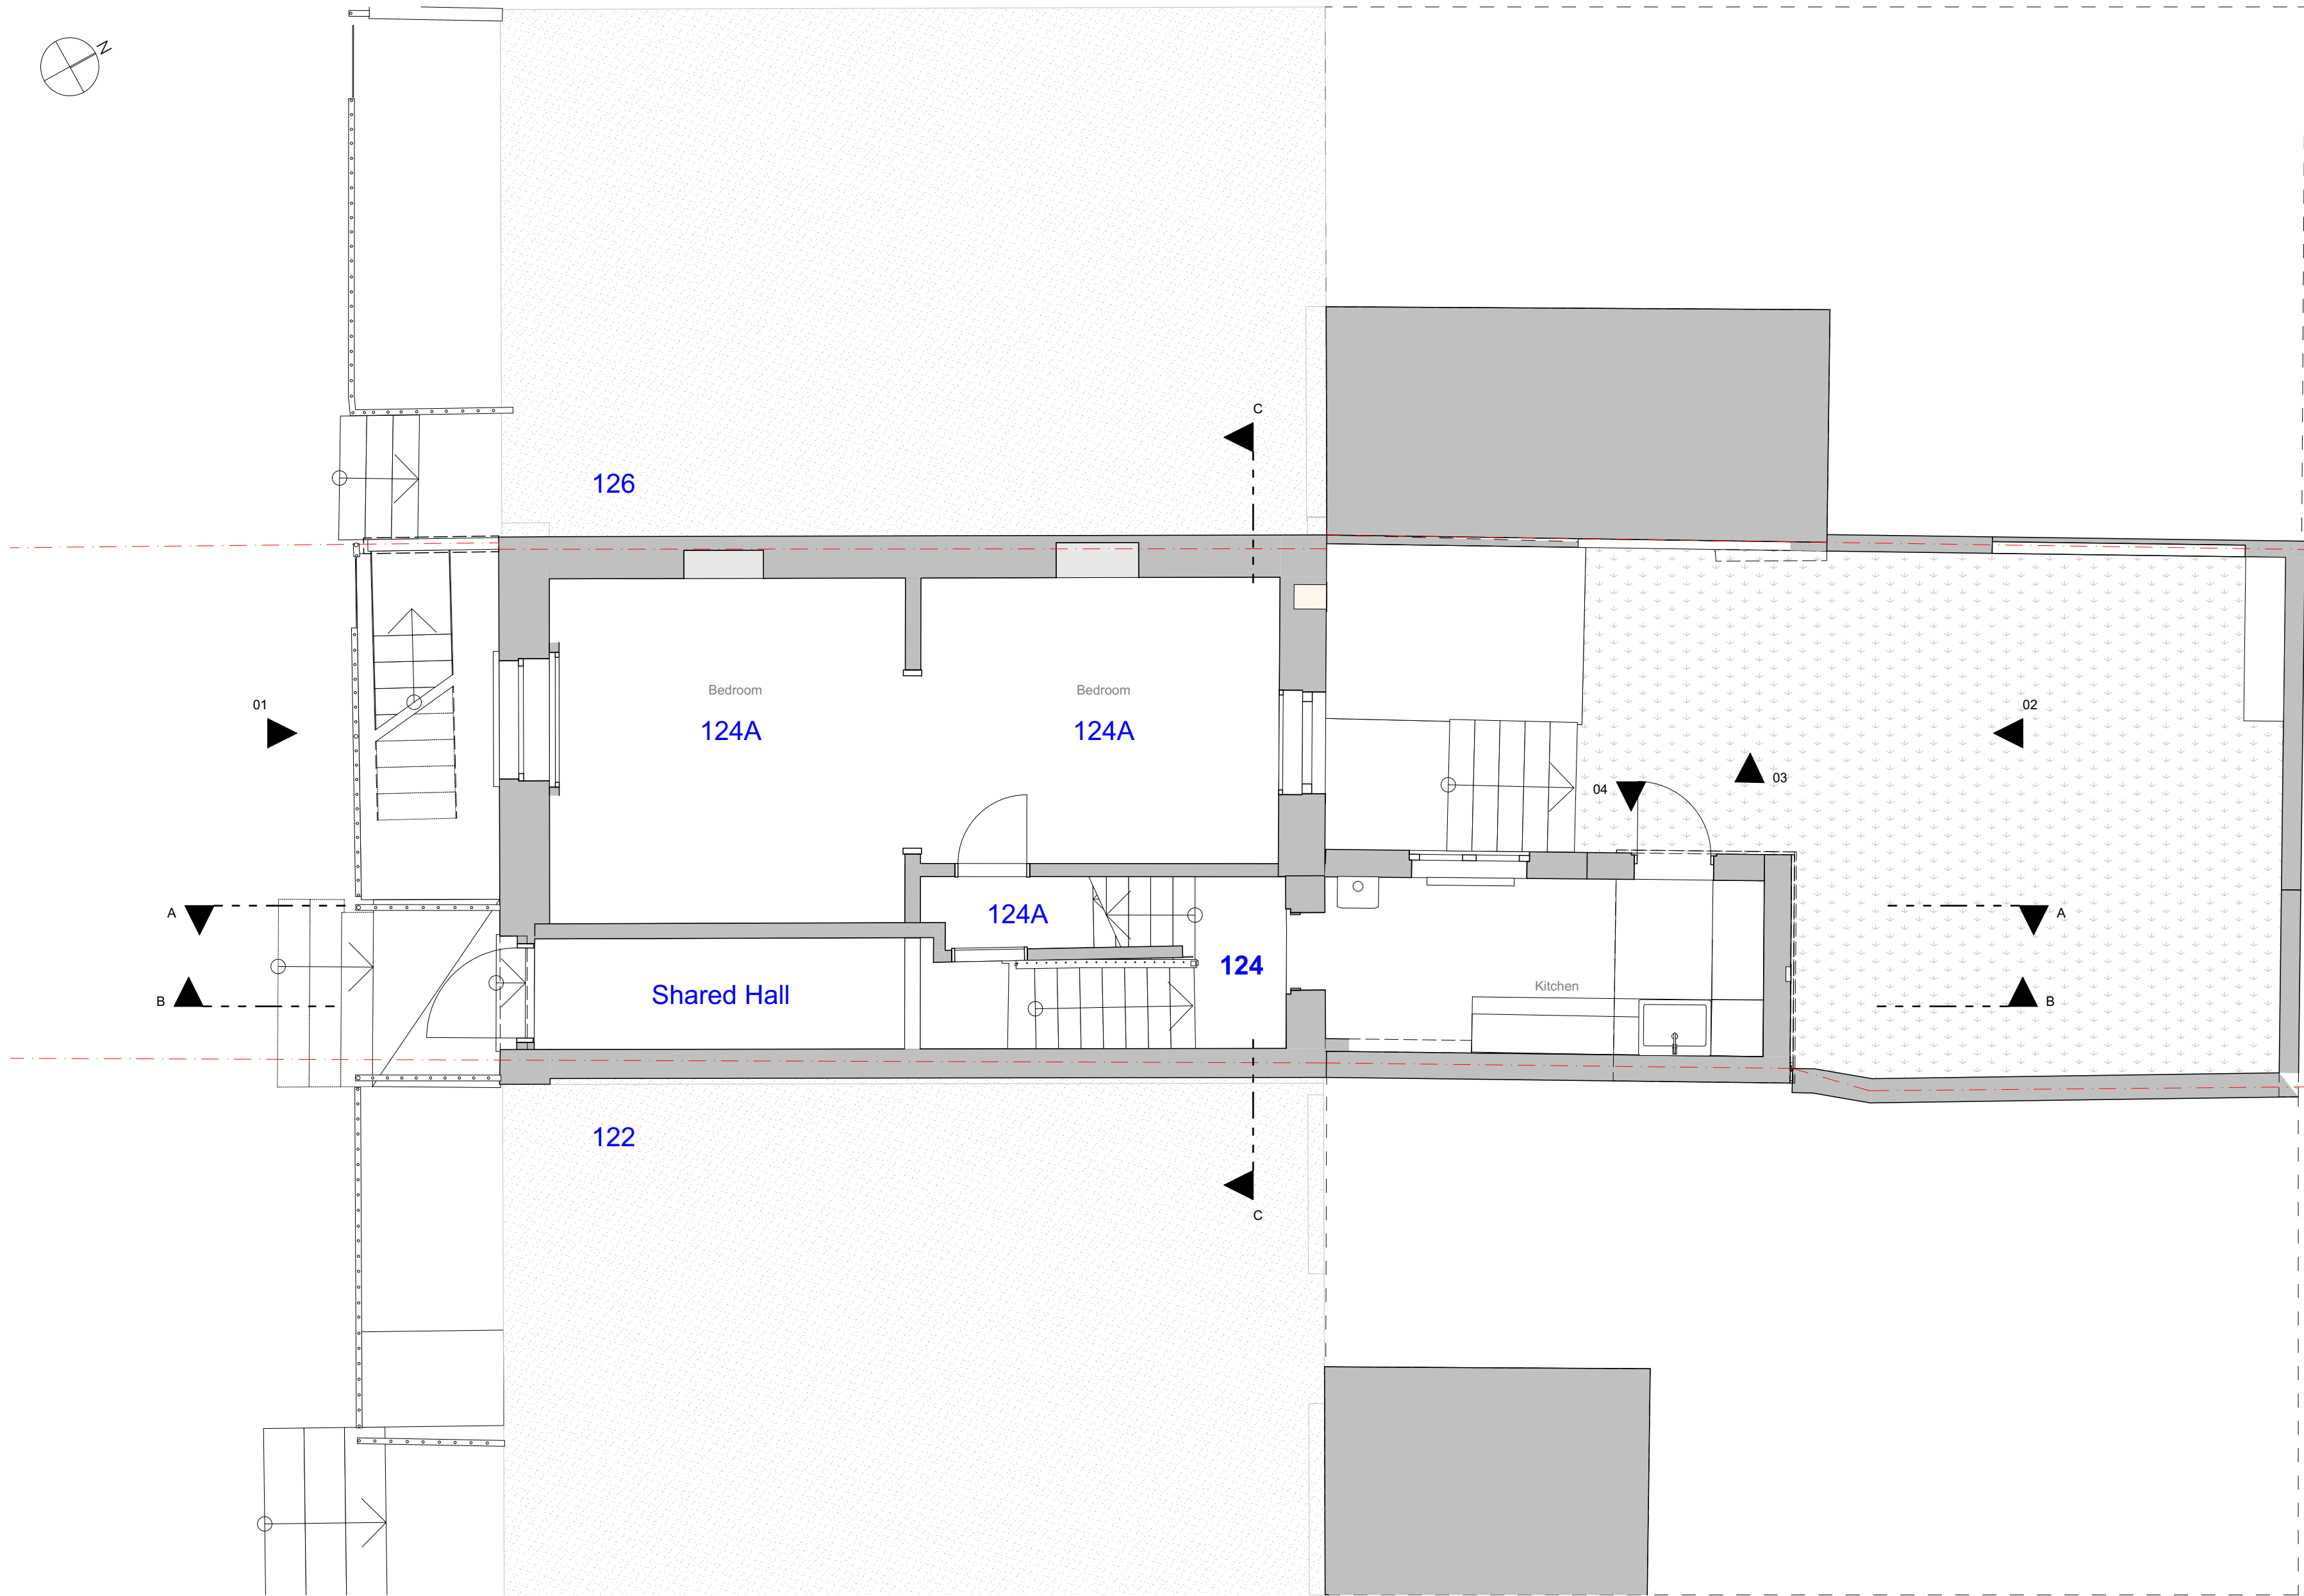

Ground Floor Plan

1:50

S/A

10b Branch Place
London N1 5PH
p: 0207 686 3445
e: info@scenarioarchitecture.com
w: www.scenarioarchitecture.com

Project Name:
124&124A St Pancras Way

Client:
Anya Thomas

Site Location:
124&124A St Pancras Way
London NW1 9NB UK

Drawing not to be used other than the purpose for which it was prepared. It's supplied without liability for errors or omissions. All dimensions are to be checked on site. This drawing is to be read in conjunction with all other drawings. Notes on this drawing will apply to all other drawings where a similar position exists.


Scale @ A2 Project No.
1:50 146

Drawing Name
Existing Ground Floor Plan

Drawing Number Rev


EX-A1.02

SCALE 1:50
0 1000 2000mm

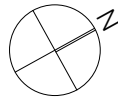

FOR PLANNING
Not For Construction

Rev Date

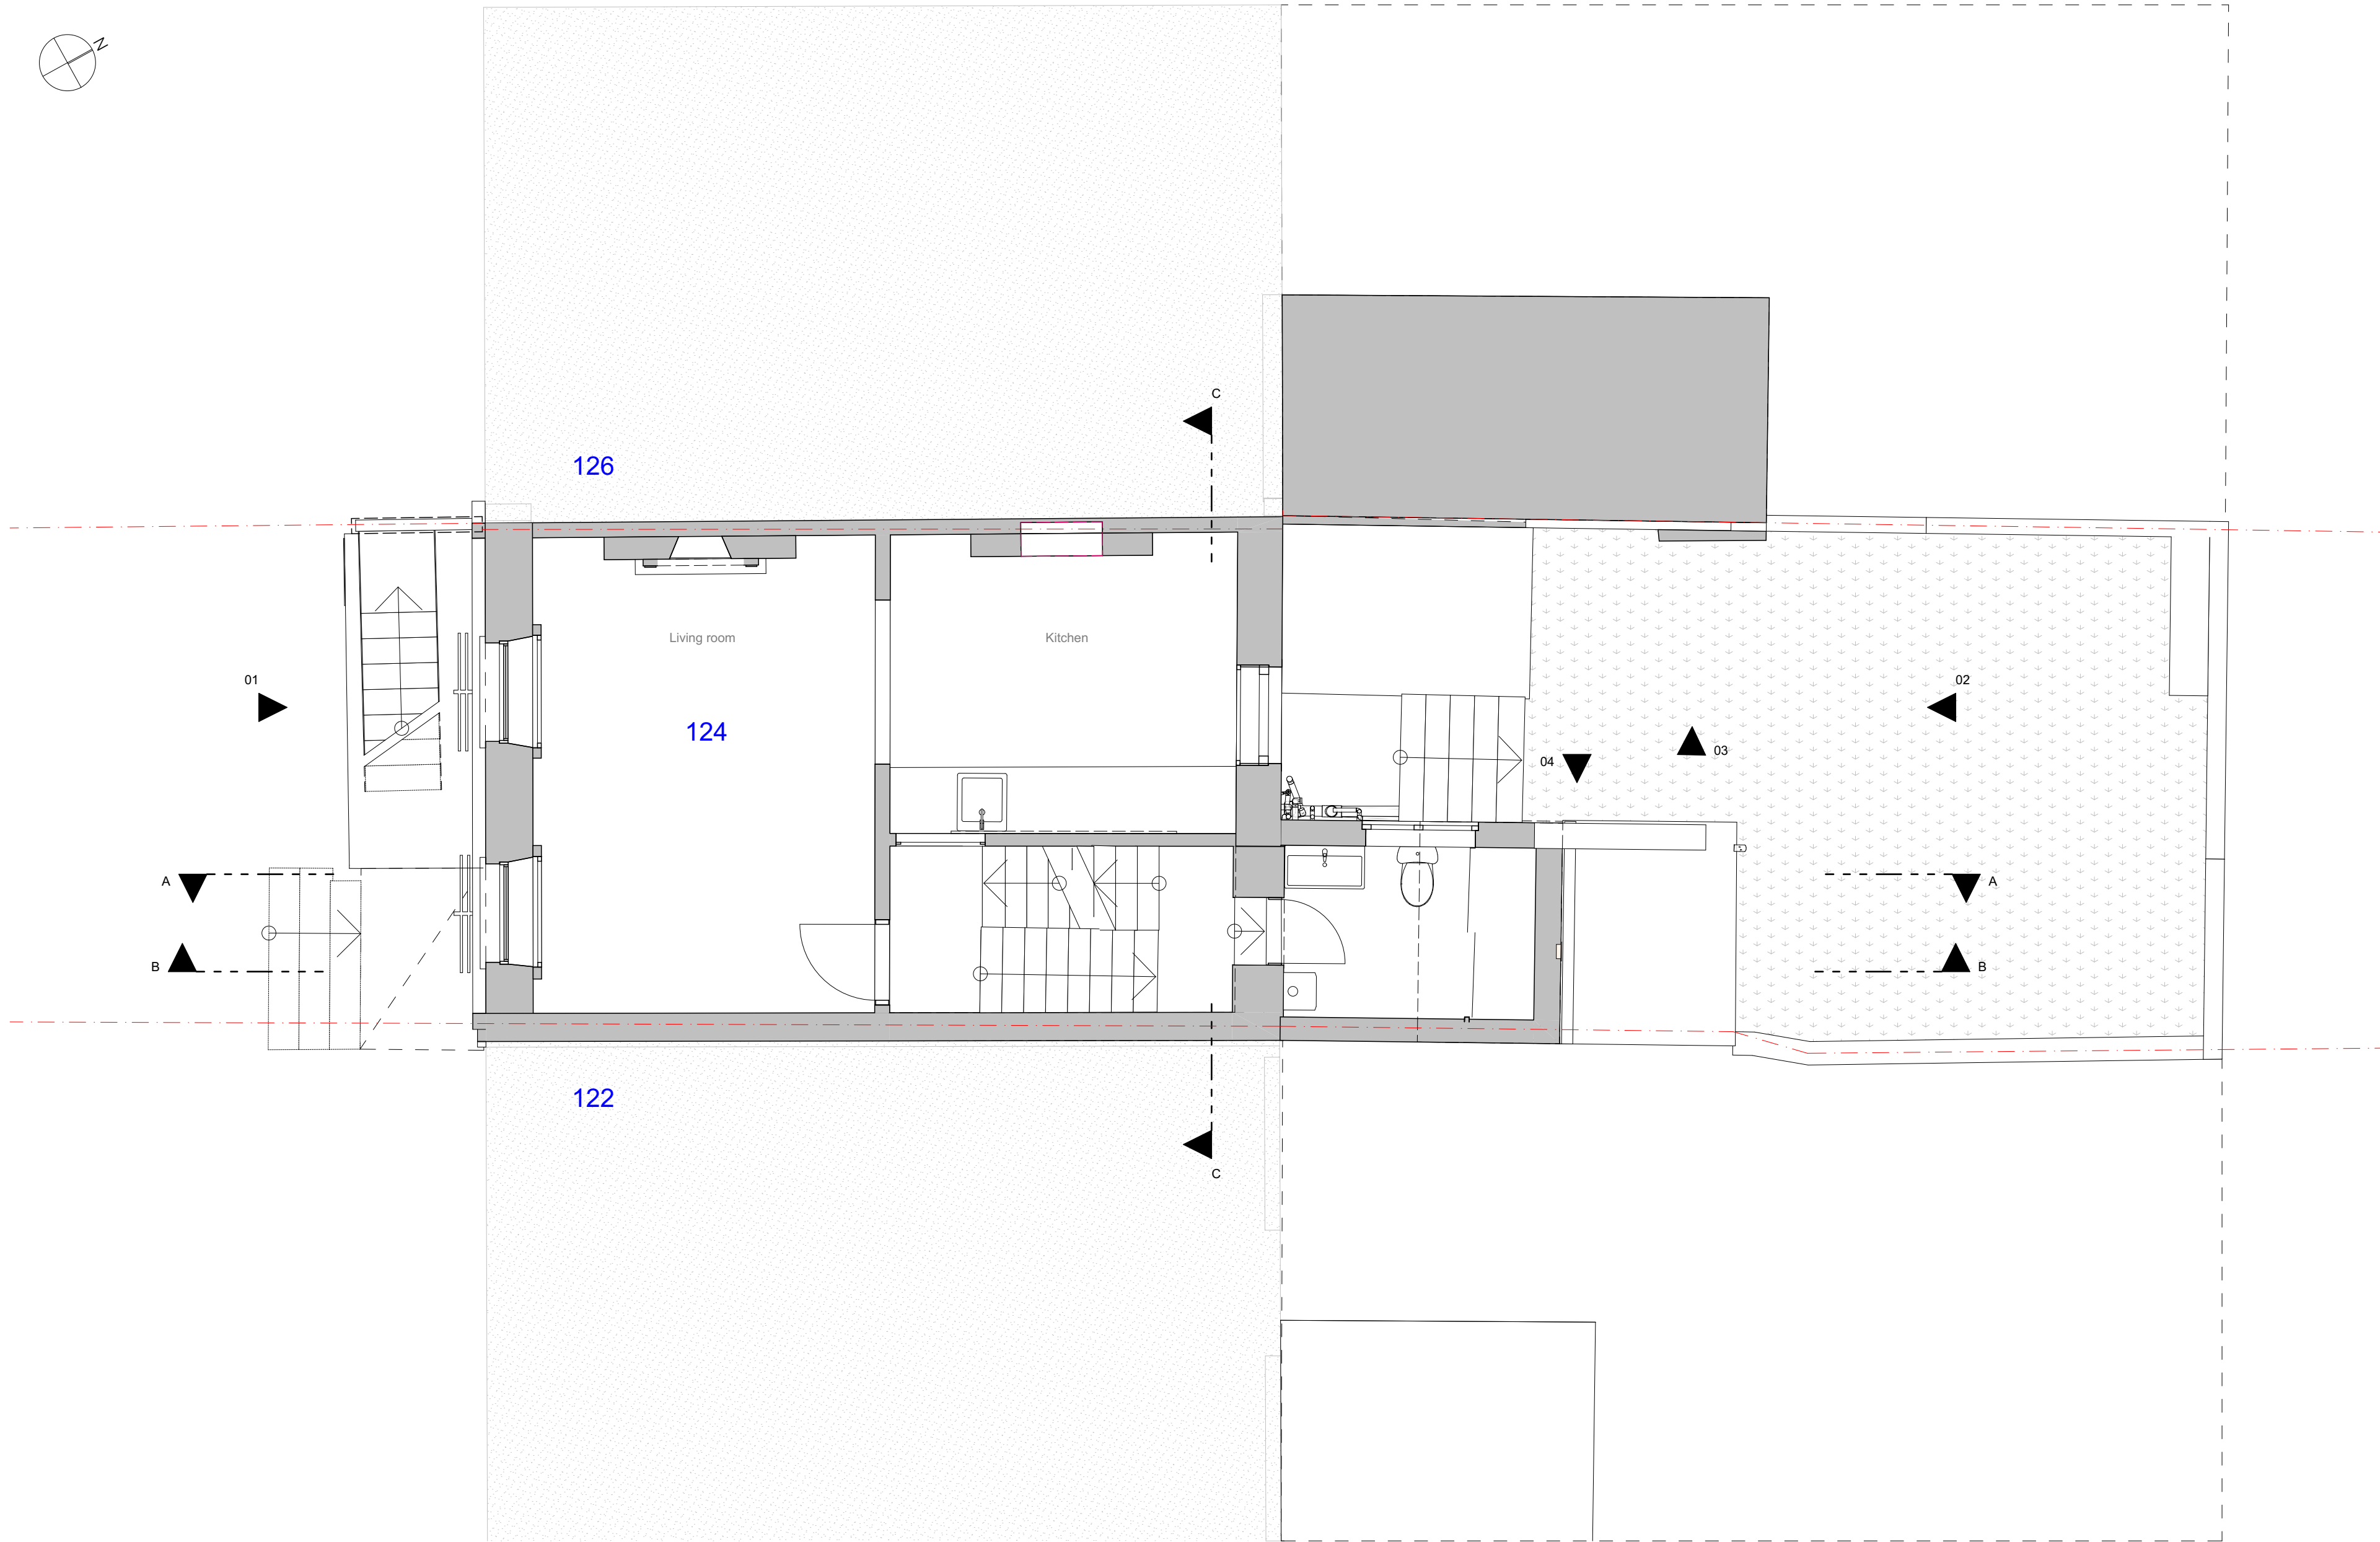

First Floor Plan

1:50

S/A

10b Branch Place
London N1 5PH
p: 0207 686 3445
e: info@scenarioarchitecture.com
w: www.scenarioarchitecture.com

Project Name:
124&124A St Pancras Way

Client:
Anya Thomas

Site Location:
**124&124A St Pancras Way
London NW1 9NB UK**


Drawing not to be used other than the purpose for which it was prepared. It's supplied without liability for errors or omissions. All dimensions are to be checked on site. This drawing is to be read in conjunction with all other drawings. Notes on this drawing will apply to all other drawings where a similar position exists.

Scale @ A2 Project No.
1:50 146

Drawing Name
Existing First Floor Plan


Drawing Number Rev
EX-A1.03

SCALE 1:50
0 1000 2000mm

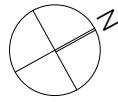

FOR PLANNING
Not For Construction

Rev Date

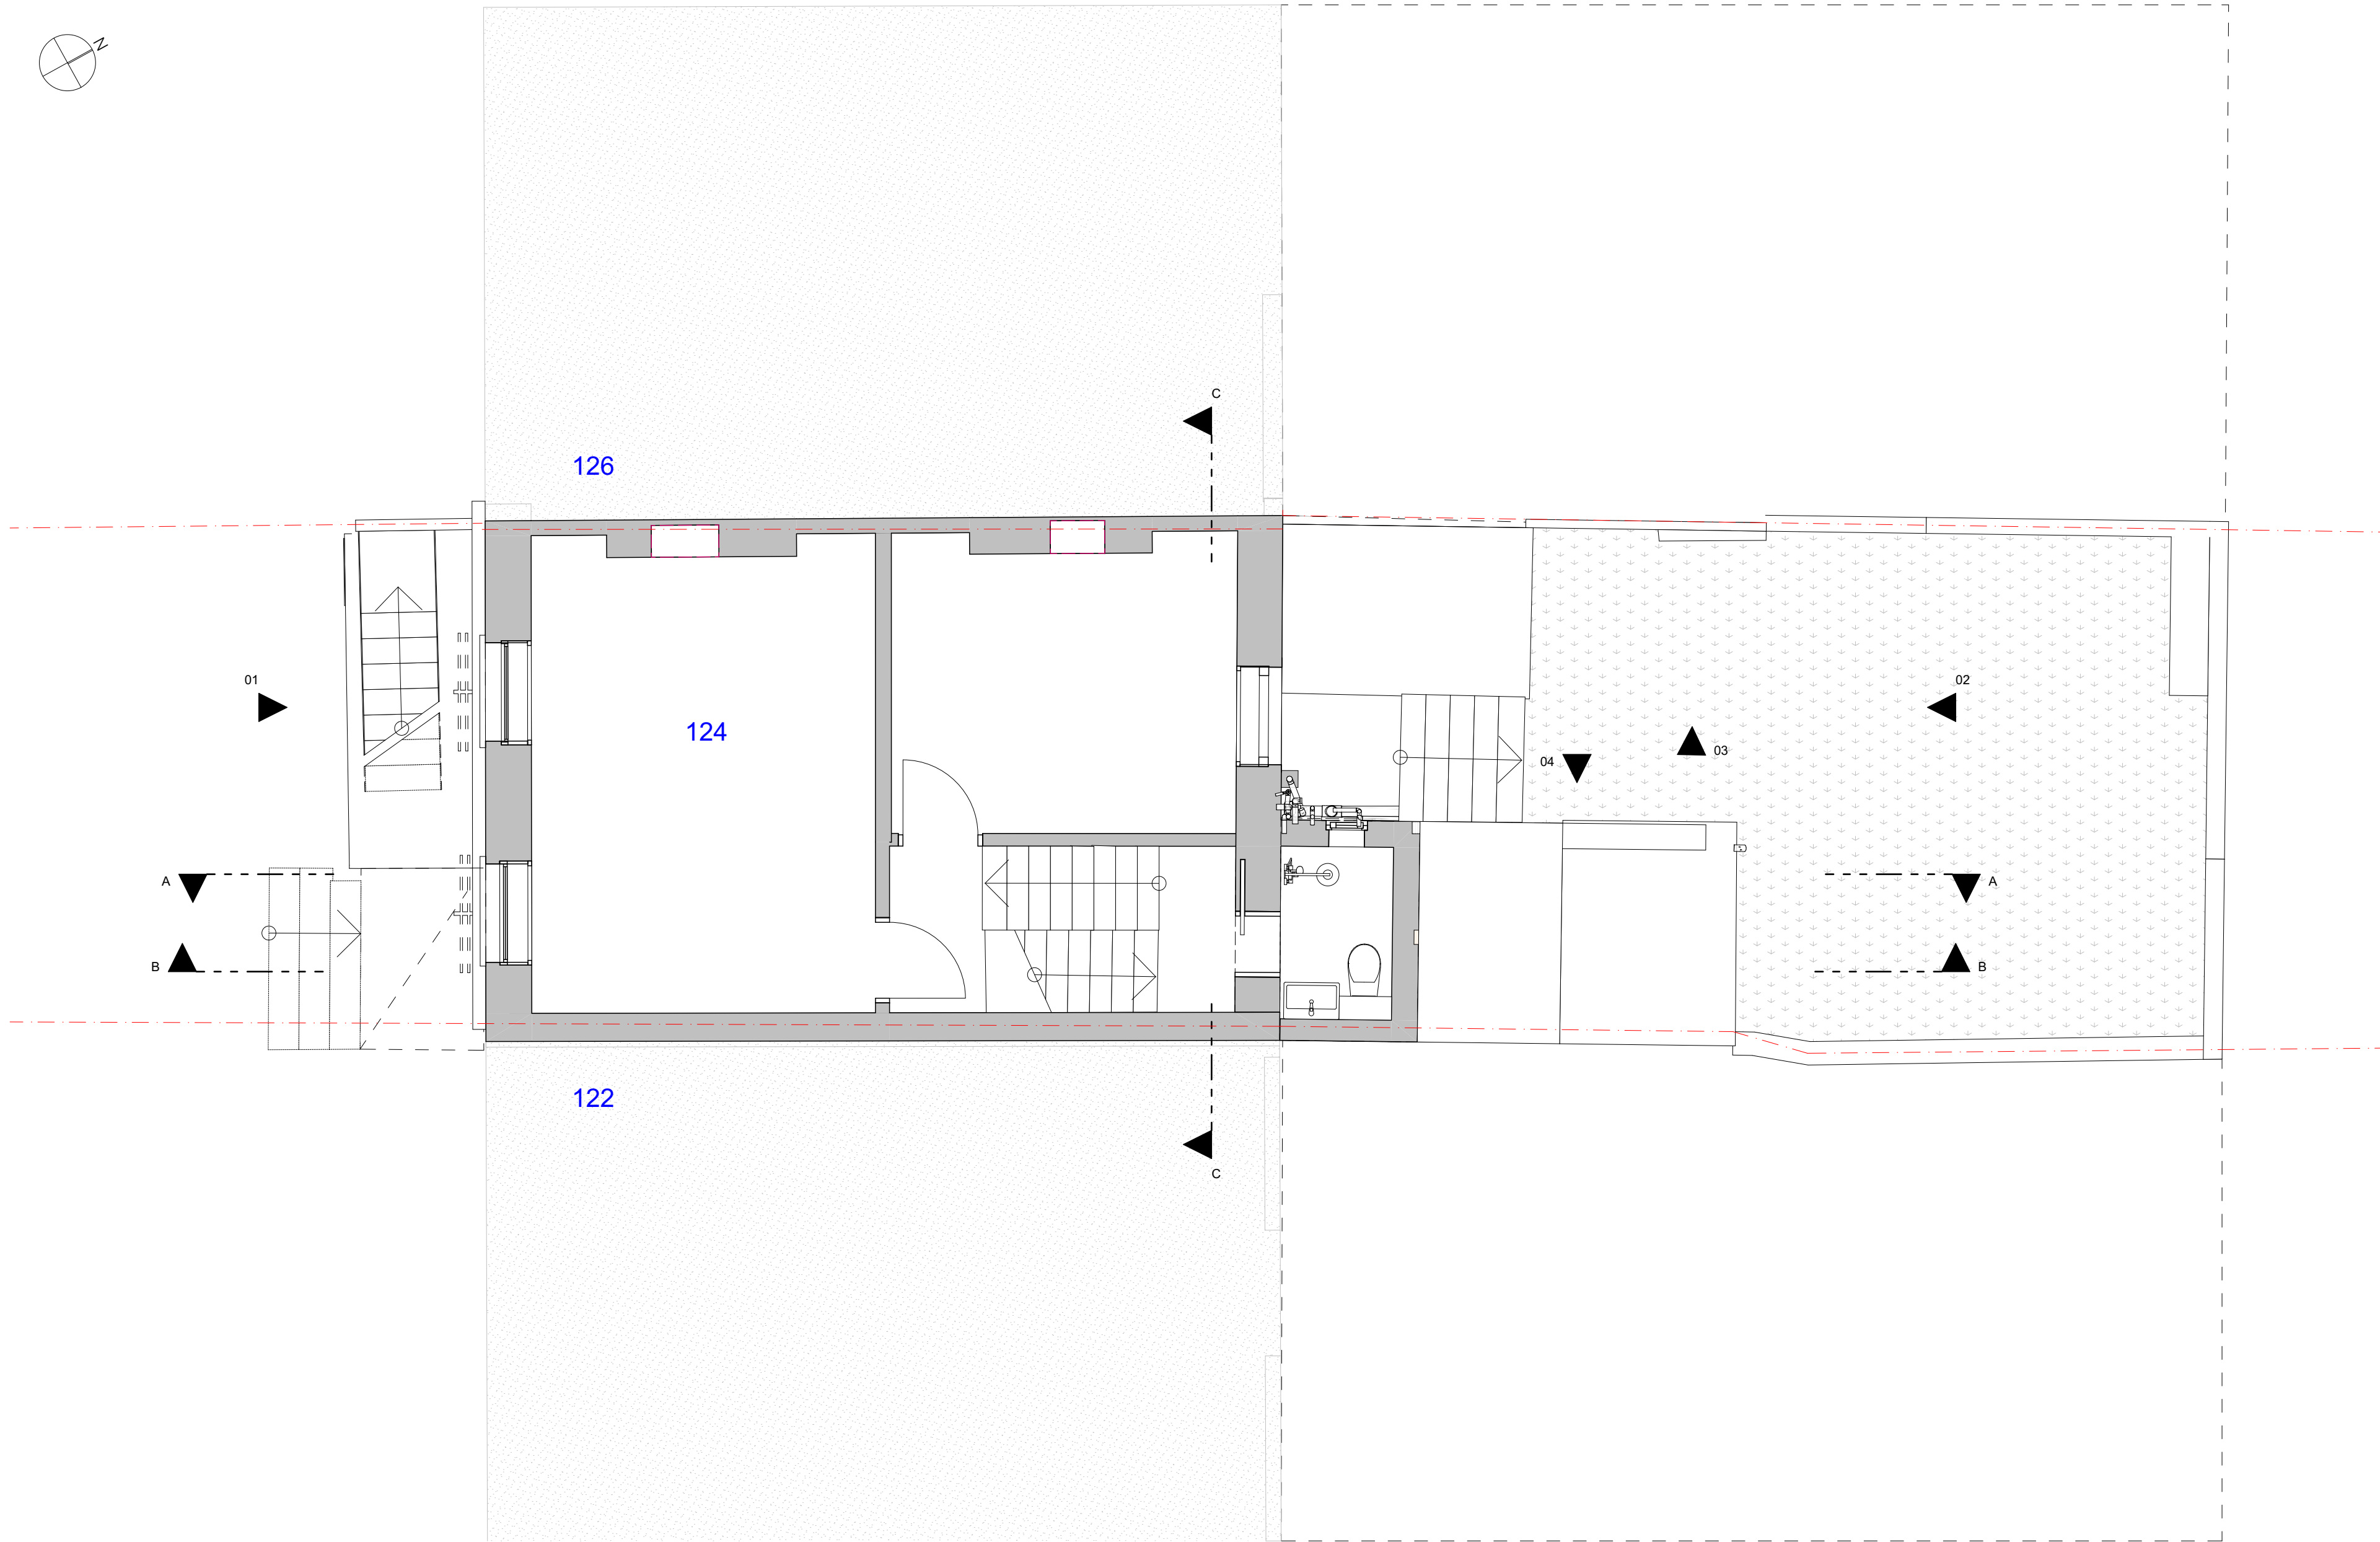

Second Floor Plan

1:50

S/A

10b Branch Place
London N1 5PH
p: 0207 686 3445
e: info@scenarioarchitecture.com
w: www.scenarioarchitecture.com

Project Name:
124&124A St Pancras Way

Client:
Anya Thomas

Site Location:
124&124A St Pancras Way
London NW1 9NB UK

Drawing not to be used other than the purpose for which it was prepared. It's supplied without liability for errors or omissions. All dimensions are to be checked on site. This drawing is to be read in conjunction with all other drawings. Notes on this drawing will apply to all other drawings where a similar position exists.

Scale @ A2
1:50



Project No.
146

Drawing Name
Existing Second Floor Plan

Drawing Number Rev

EX-A1.04

SCALE 1:50
0 1000 2000mm

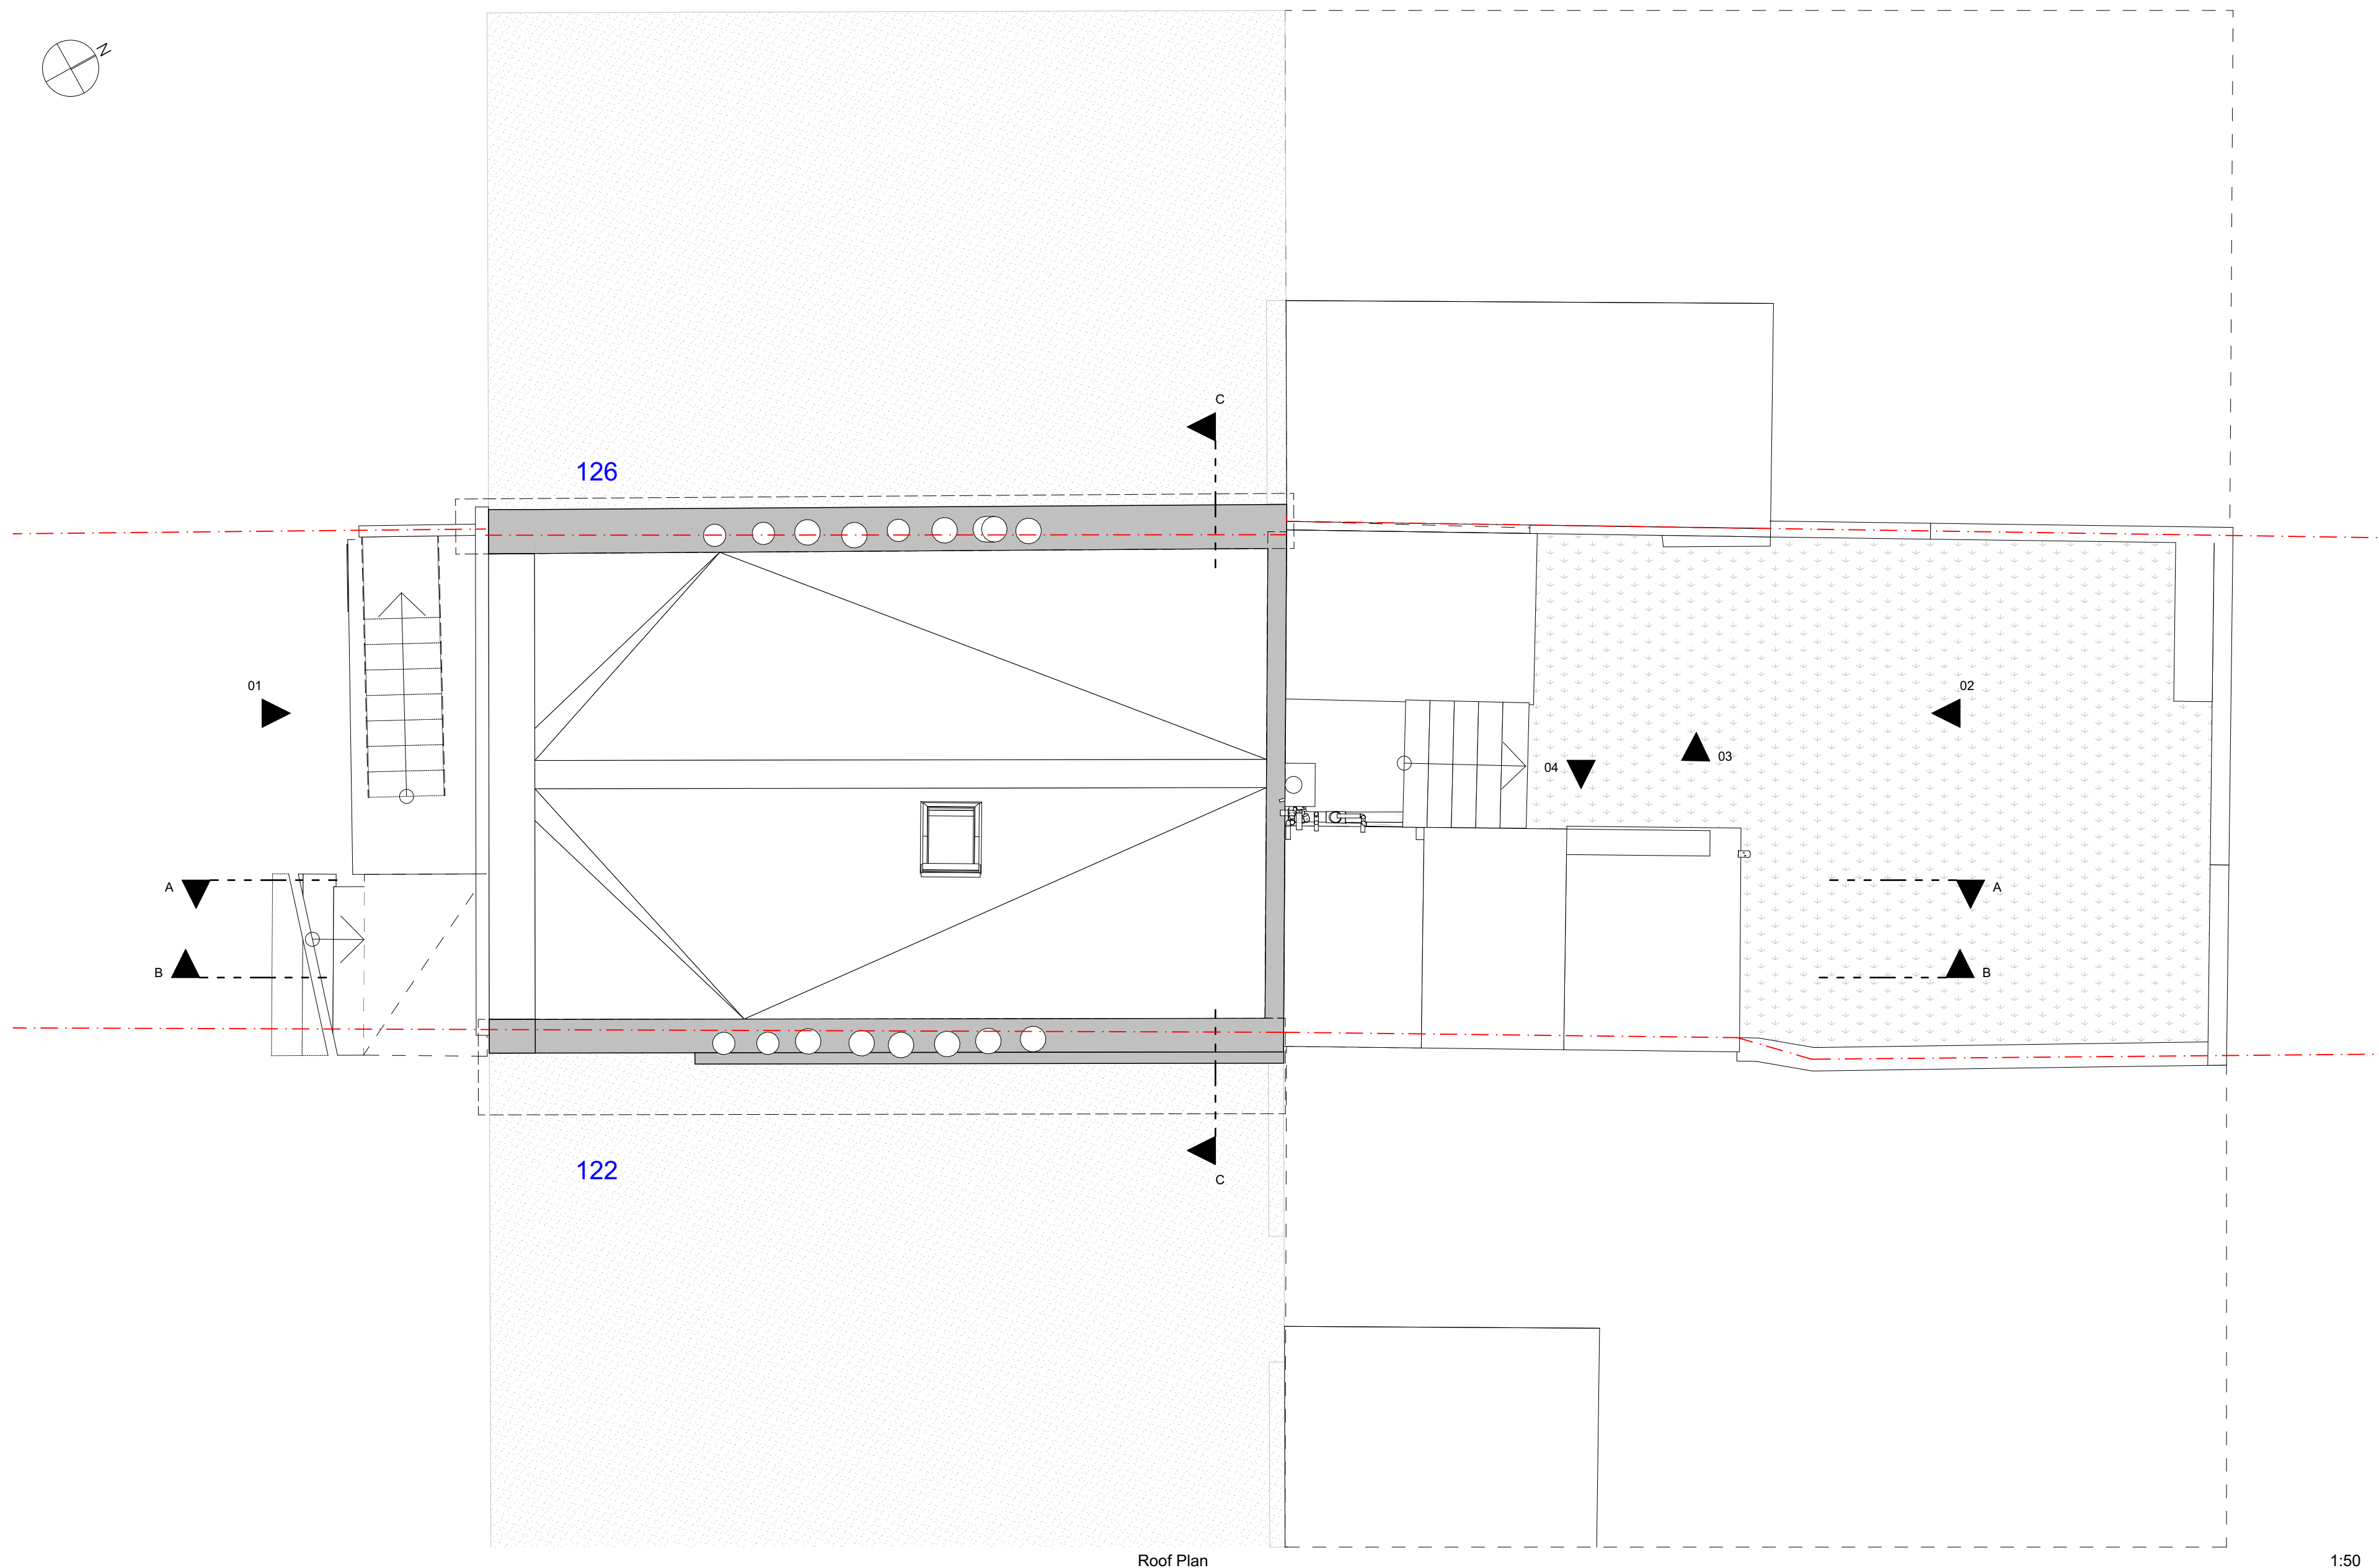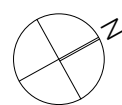

Roof Plan

1:50

SCALE 1:50

0 1000 2000mm

S/A

10b Branch Place
London N1 5PH
p: 0207 686 3445
e: info@scenarioarchitecture.com
w: www.scenarioarchitecture.com

Project Name:
124&124A St Pancras Way

Client:
Anya Thomas

Site Location:
**124&124A St Pancras Way
London NW1 9NB UK**

Drawing not to be used other than the purpose for which it was prepared. It's supplied without liability for errors or omissions. All dimensions are to be checked on site. This drawing is to be read in conjunction with all other drawings. Notes on this drawing will apply to all other drawings where a similar position exists.


Scale @ A2
1:50

Project No.
146

Drawing Name
Existing Roof Plan


Drawing Number	Rev
----------------	-----

EX-A1.05

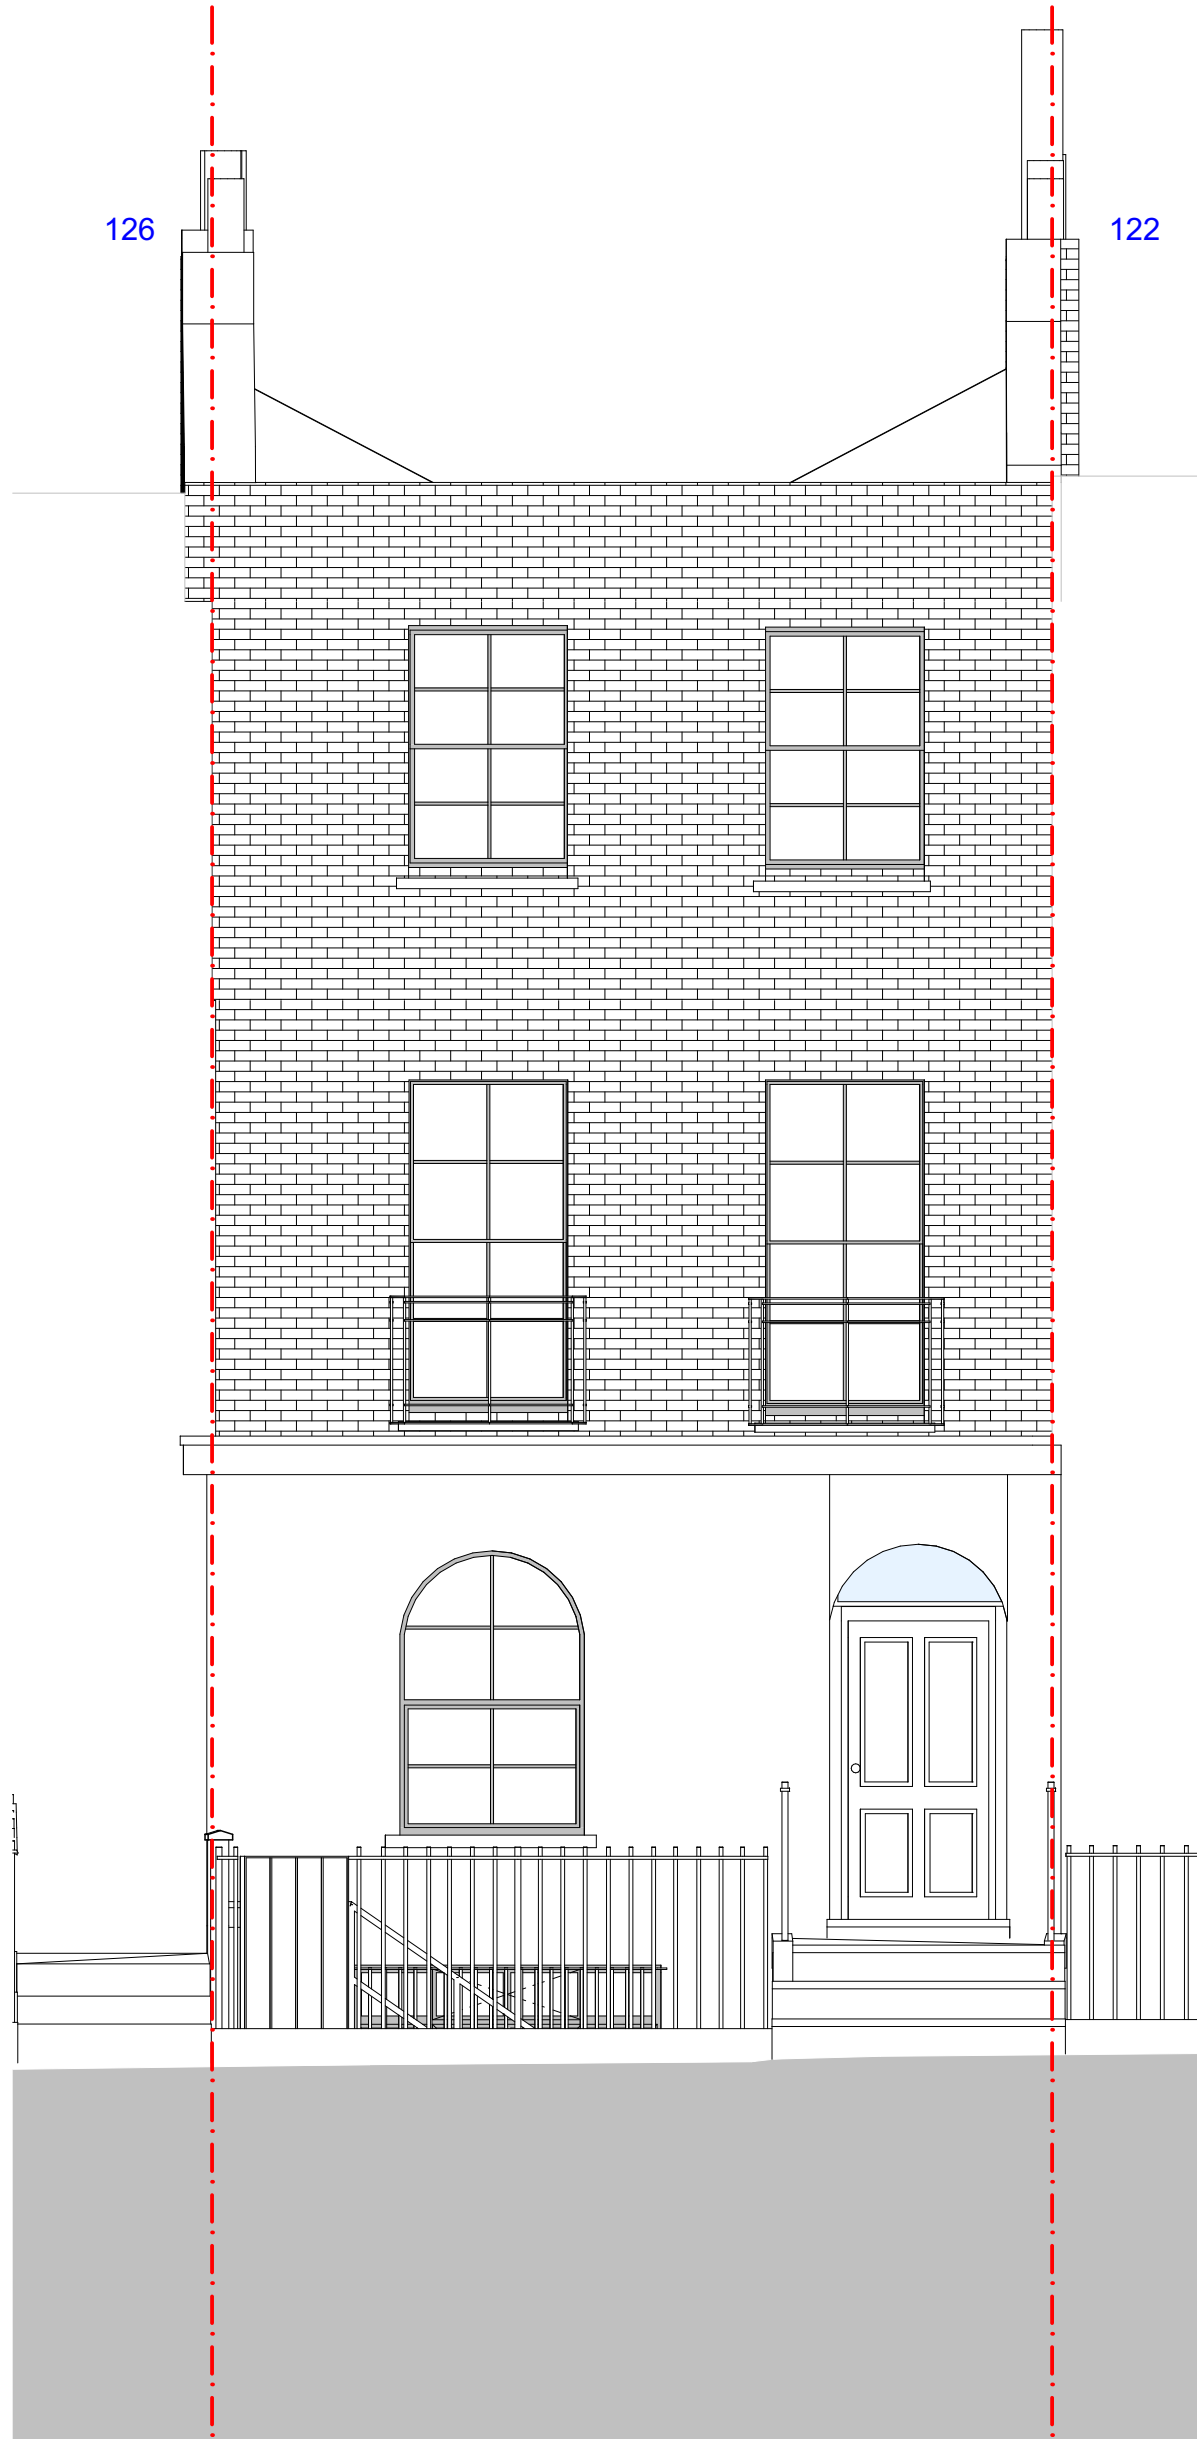

Elevation 1

1:50

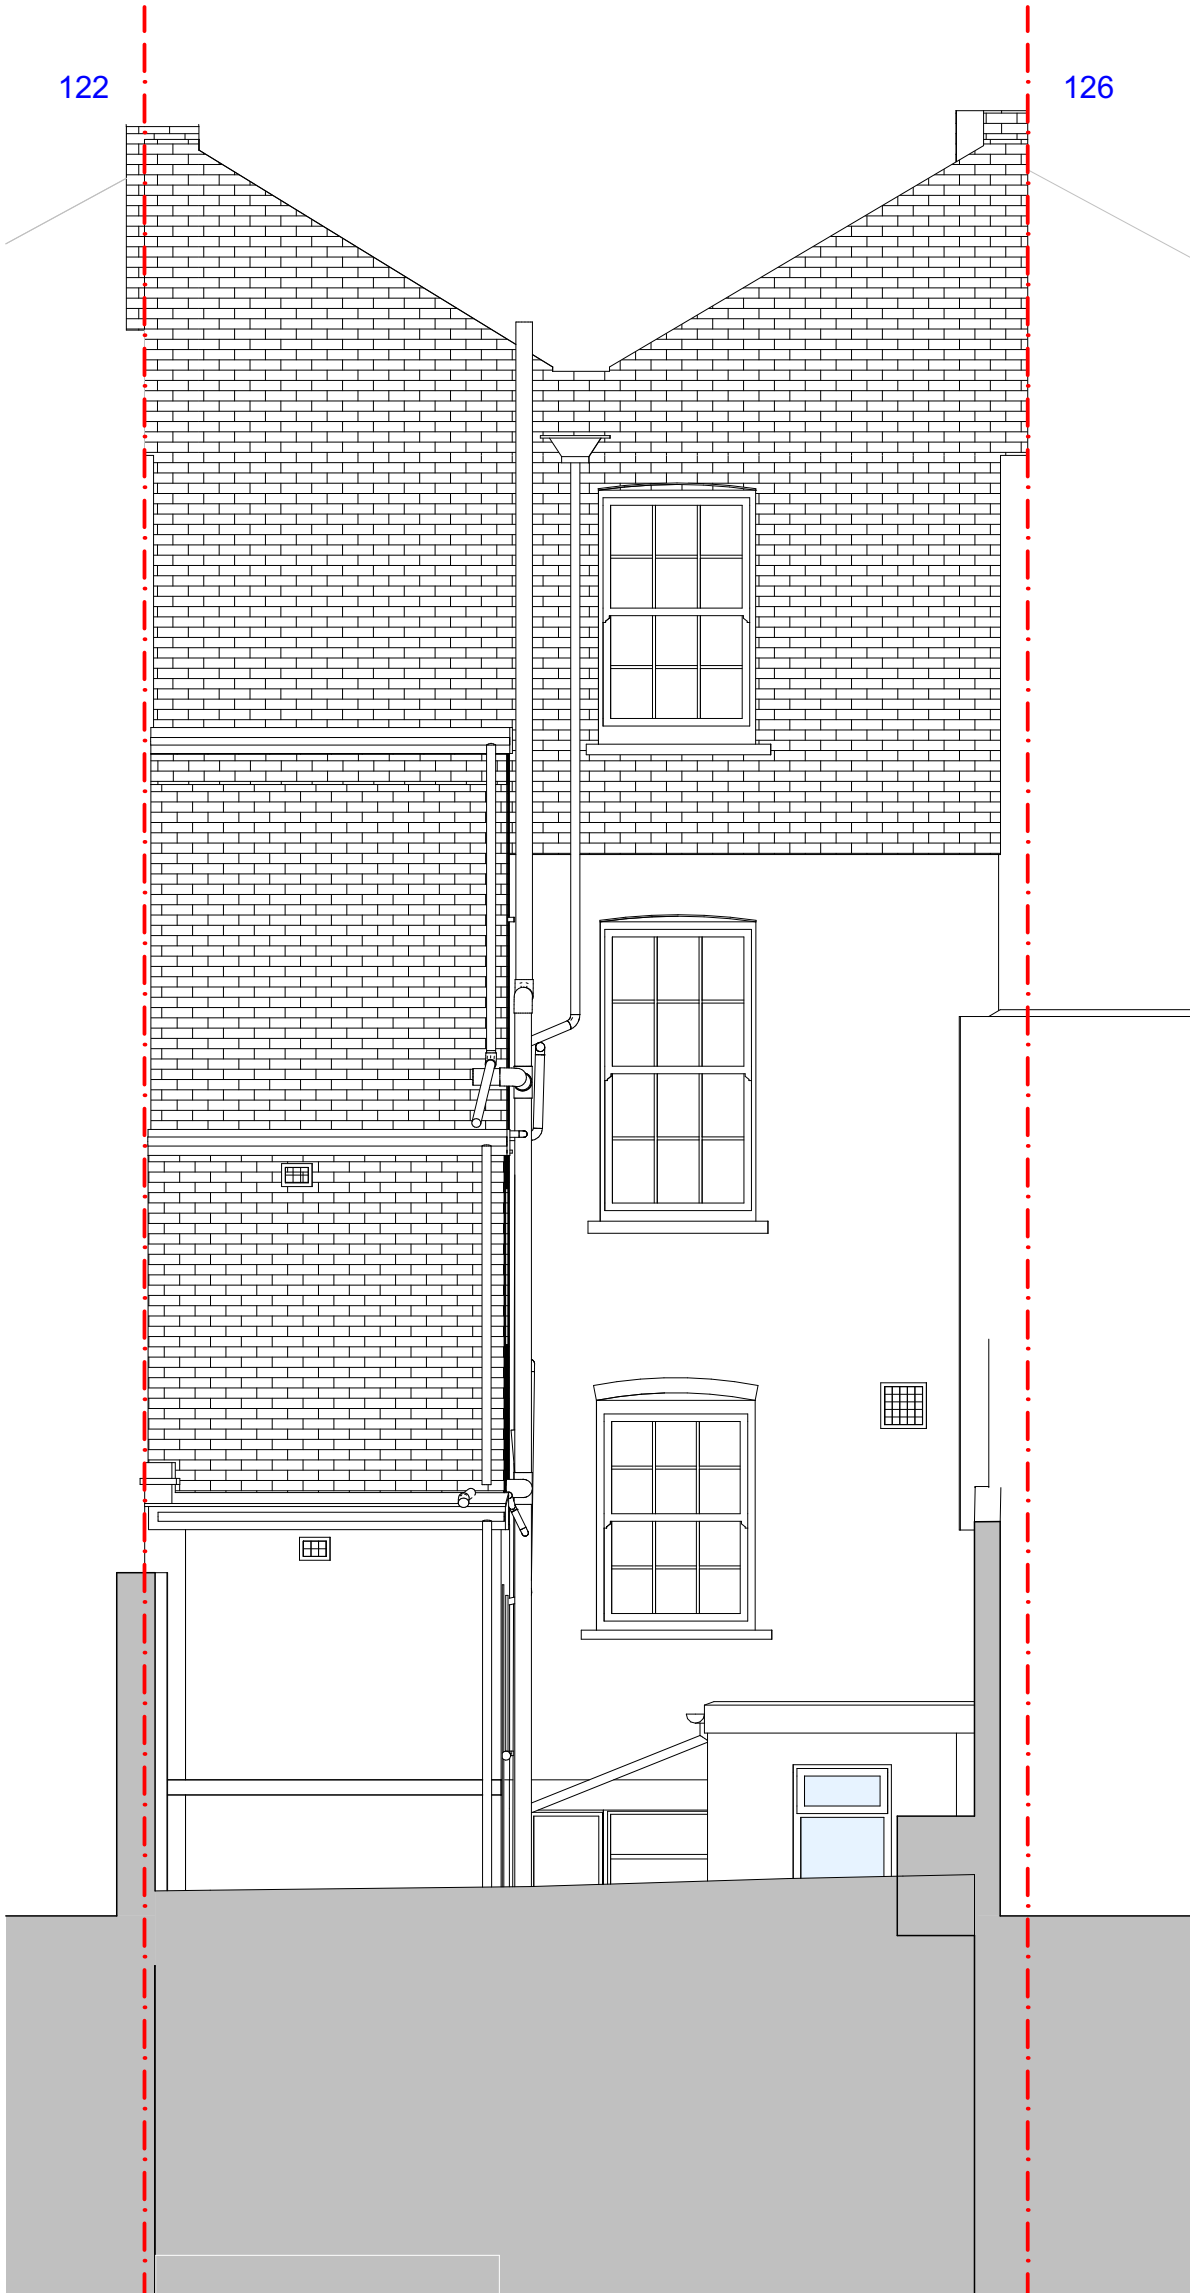

Elevation 2

1:50

SCALE 1:50
0 1000 2000mm

S/A
10b Branch Place
London N1 5PH
p: 0207 686 3445
e: info@scenarioarchitecture.com
w: www.scenarioarchitecture.com

Project Name:
124&124A St Pancras Way

Client:
Anya Thomas

Site Location:
**124&124A St Pancras Way
London NW1 9NB UK**

Drawing not to be used other than the purpose for which it was prepared. It's supplied without liability for errors or omissions. All dimensions are to be checked on site. This drawing is to be read in conjunction with all other drawings. Notes on this drawing will apply to all other drawings where a similar position exists.

Scale @ A2
1:50


Project No.
146

Drawing Name
Existing Elevations

Drawing Number Rev

EX-A2.01

Rev	Date

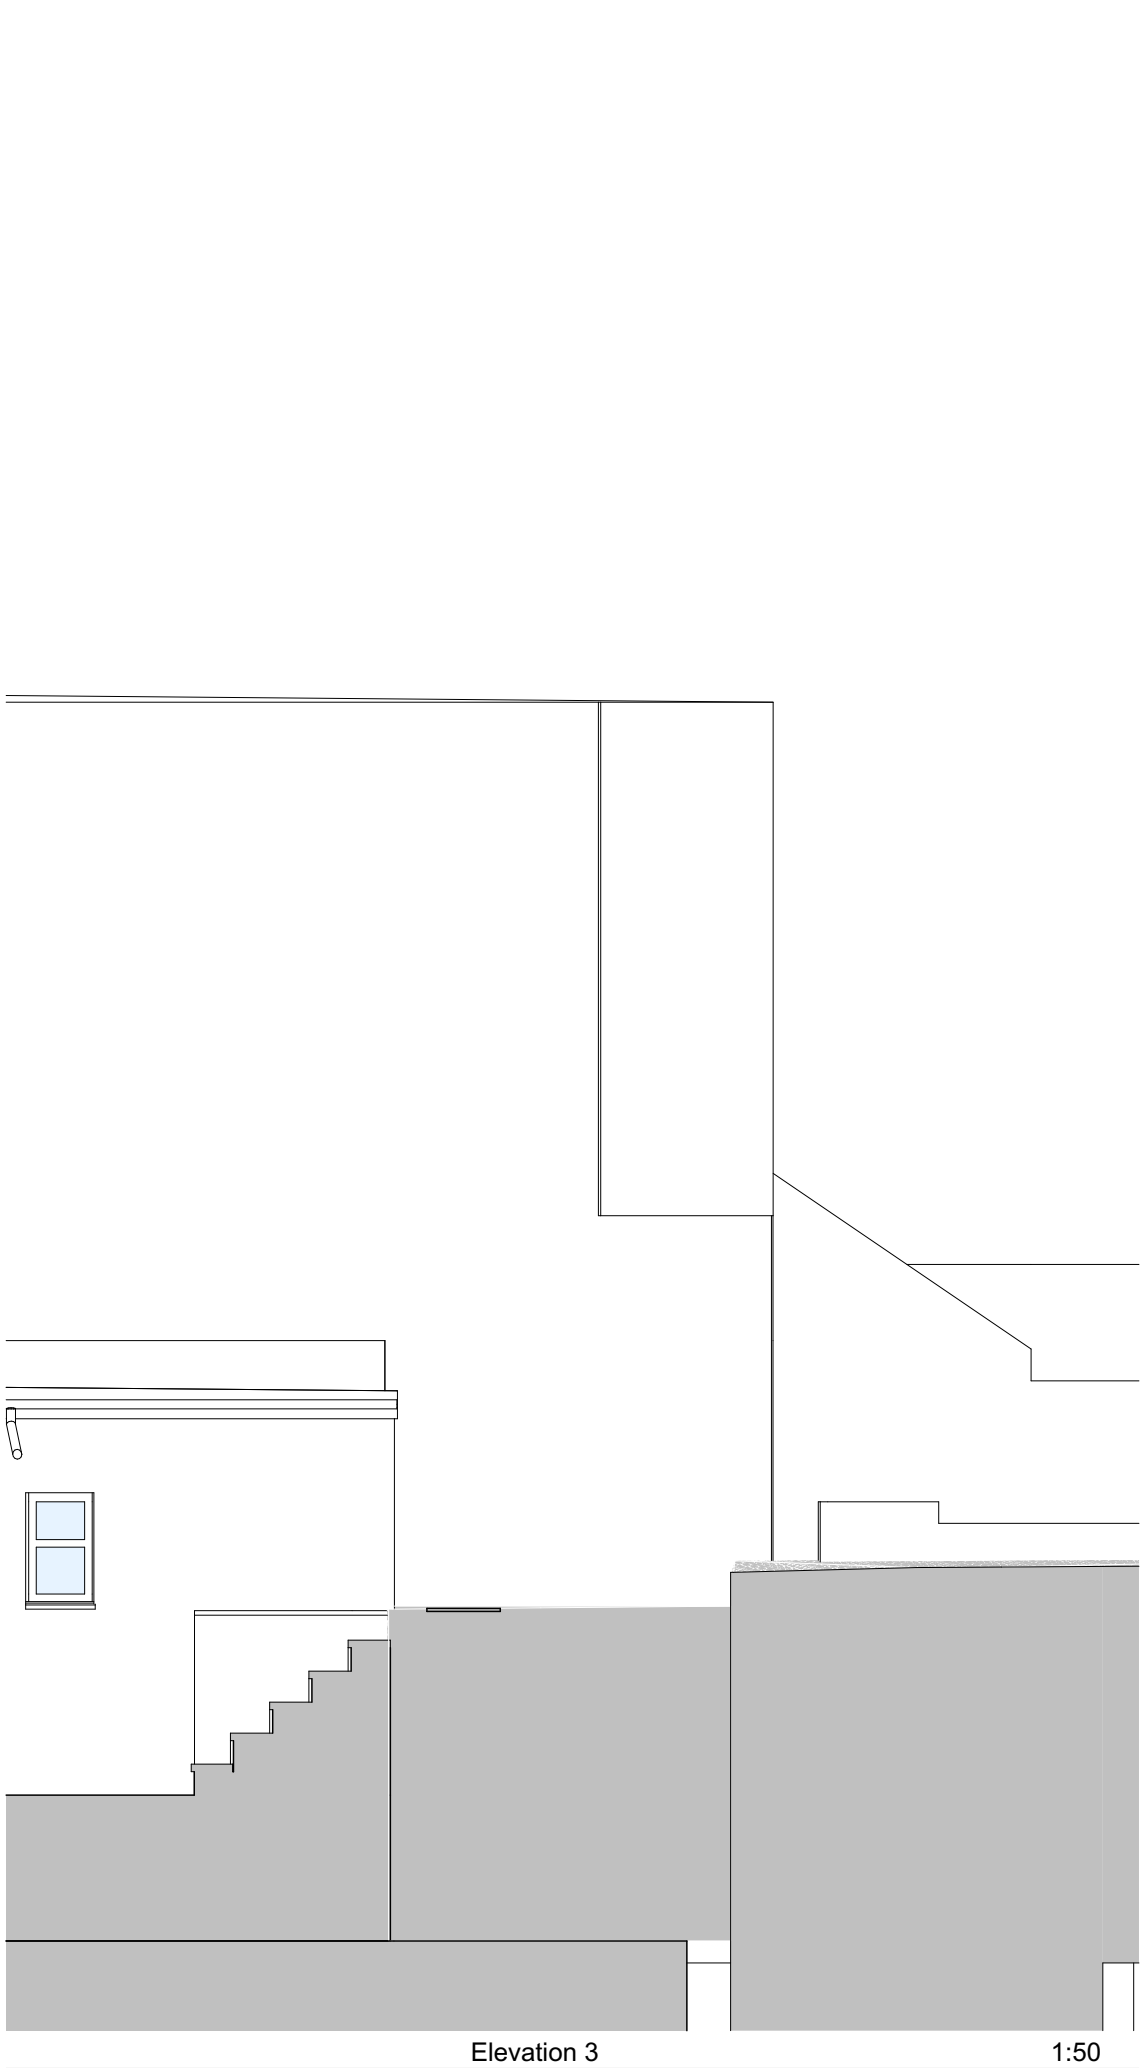

SCALE 1:50
0 1000 2000mm

S/A
10b Branch Place
London N1 5PH
p: 0207 686 3445
e: info@scenarioarchitecture.com
w: www.scenarioarchitecture.com

Project Name:
124&124A St Pancras Way

Client:
Anya Thomas

Site Location:
**124&124A St Pancras Way
London NW1 9NB UK**

Drawing not to be used other than the purpose for which it was prepared. It's supplied without liability for errors or omissions. All dimensions are to be checked on site. This drawing is to be read in conjunction with all other drawings. Notes on this drawing will apply to all other drawings where a similar position exists.

Scale @ A2
1:50


Project No.
146

Drawing Name
Existing Elevations

Drawing Number
EX-A2.02

Rev

Rev	Date

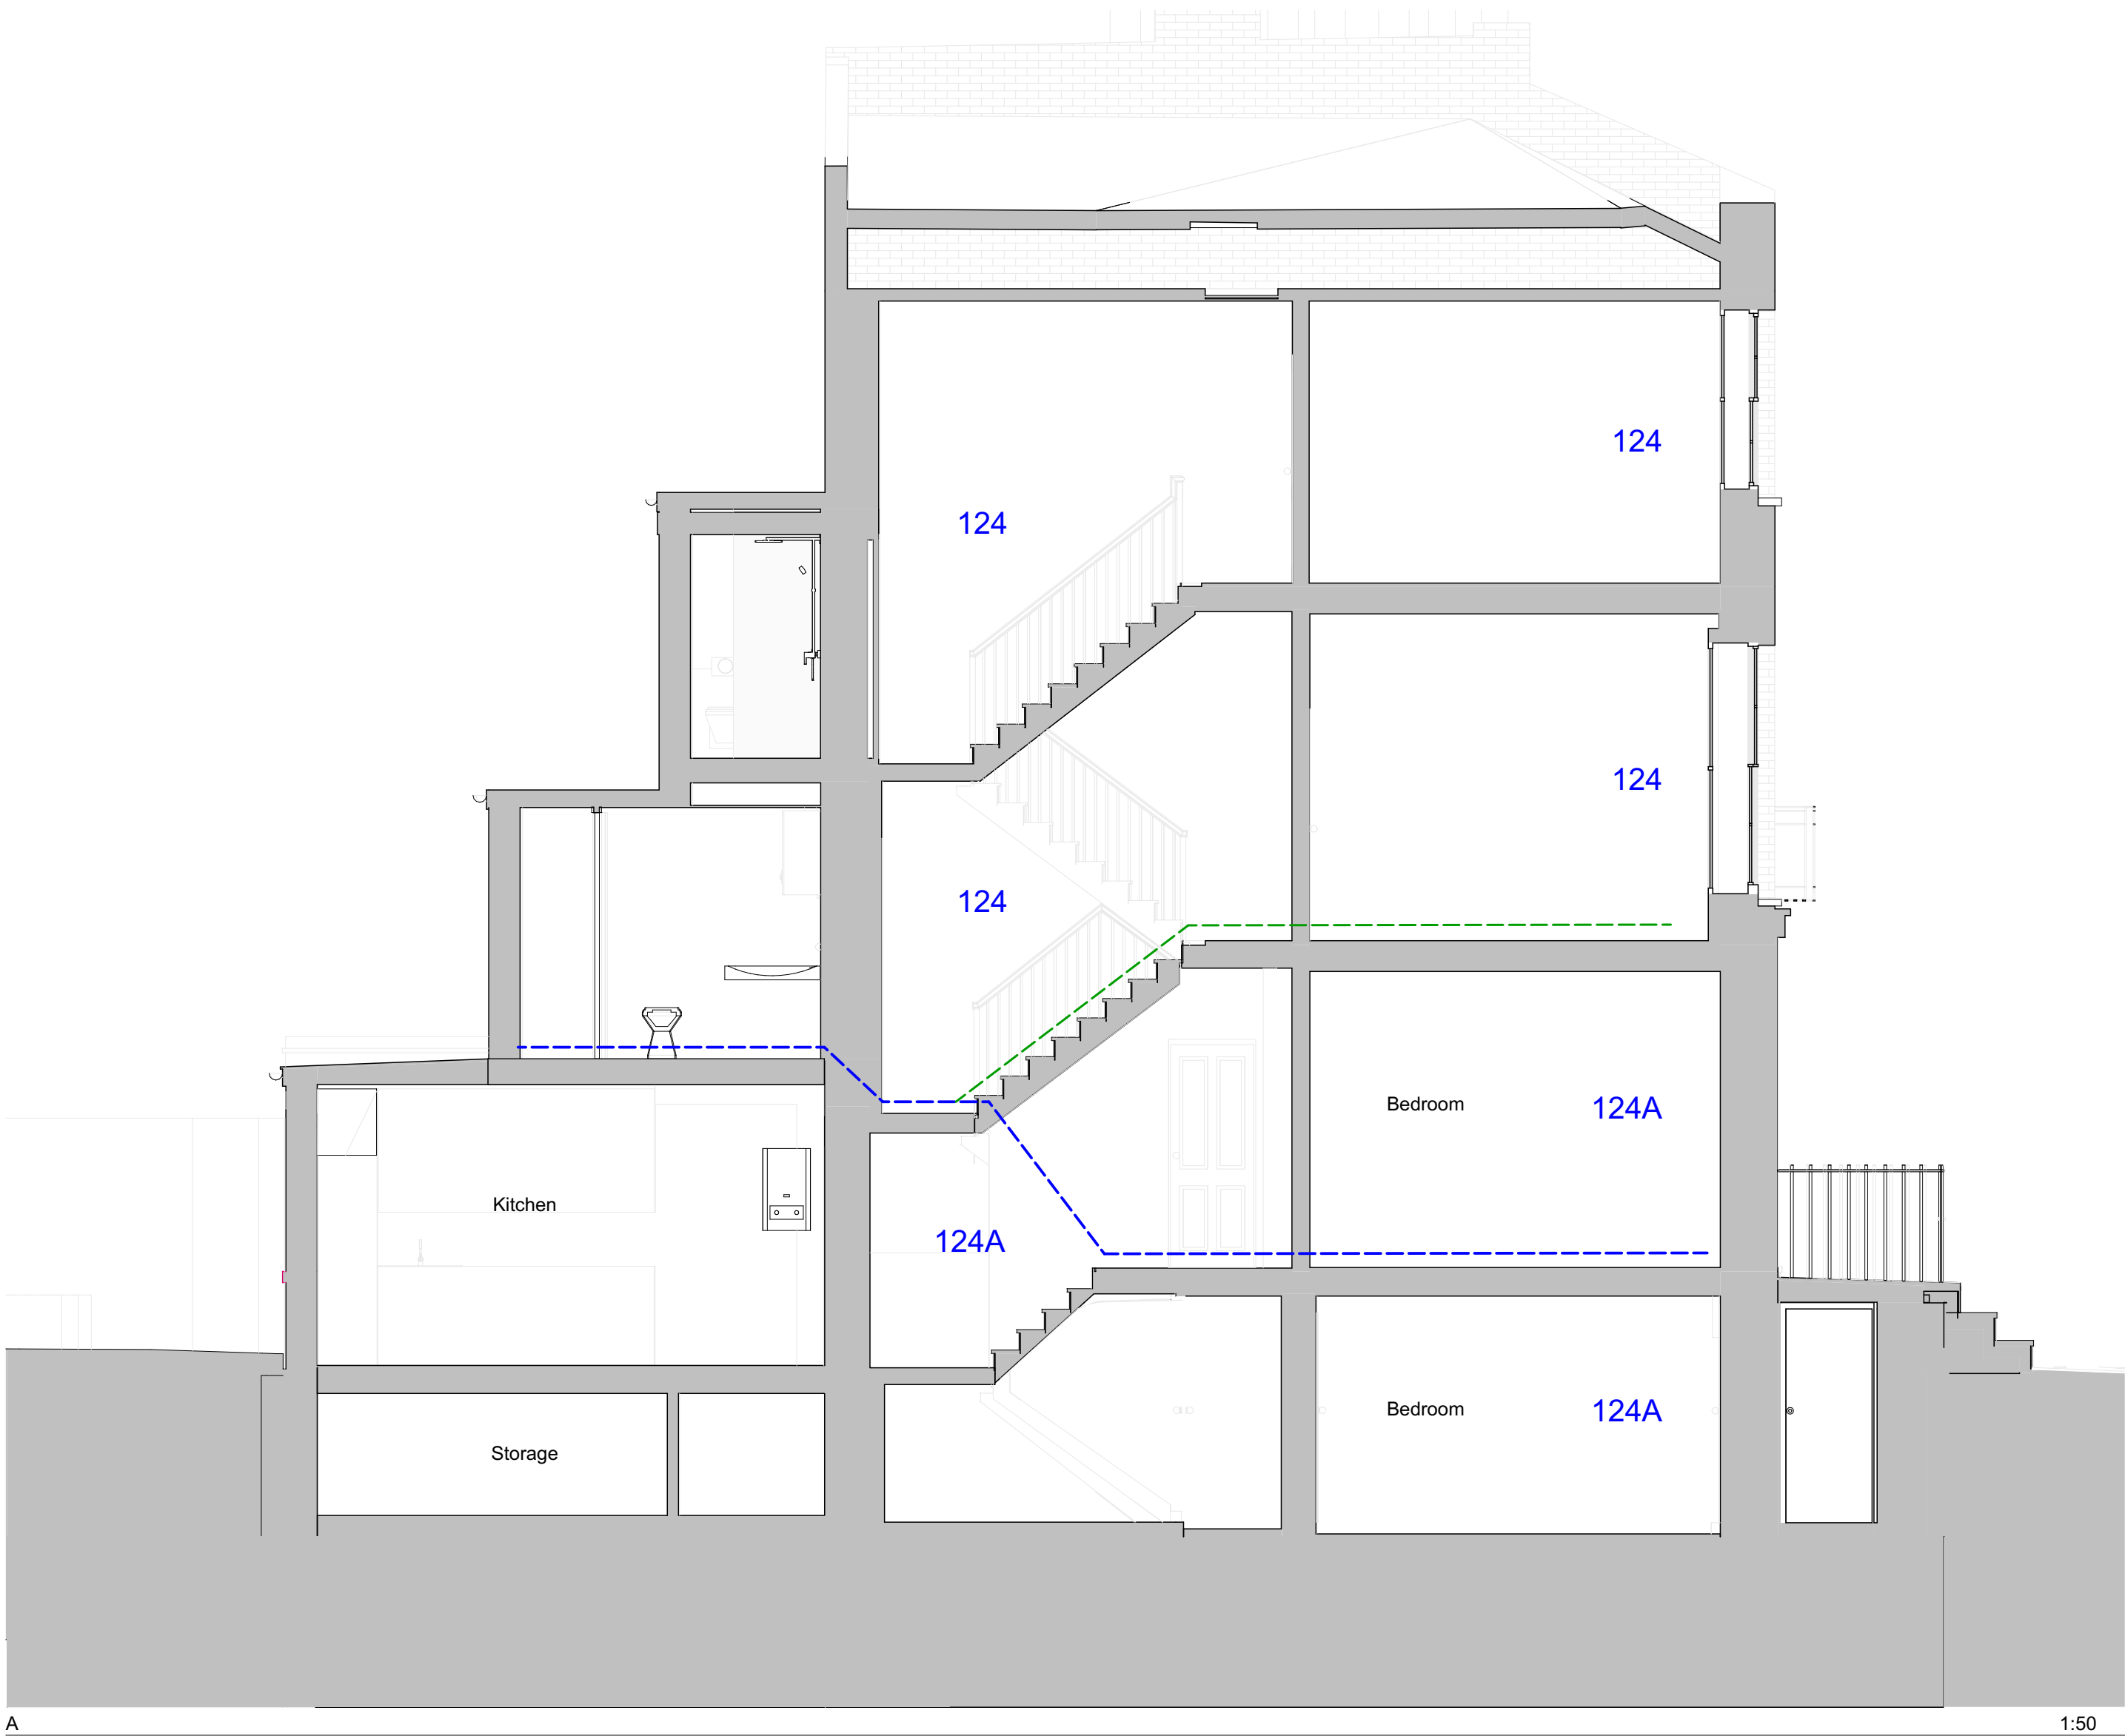

A

1:50

LEGEND:

--- AS APPROVED

--- AS BUILT

SCALE 1:50

0 1000 2000mm

S/A

10b Branch Place
London N1 5PH
p: 0207 686 3445
e: info@scenarioarchitecture.com
w: www.scenarioarchitecture.com

Project Name:
124&124A St Pancras Way

Client:
Anya Thomas

Site Location:
124&124A St Pancras Way
London NW1 9NB UK

Drawing not to be used other than the purpose for which it was prepared. It's supplied without liability for errors or omissions. All dimensions are to be checked on site. This drawing is to be read in conjunction with all other drawings. Notes on this drawing will apply to all other drawings where a similar position exists.


Scale @ A2 Project No.
1:50 146

Drawing Name
Existing Sections

Drawing Number Rev

EX-A3.01

Rev	Date

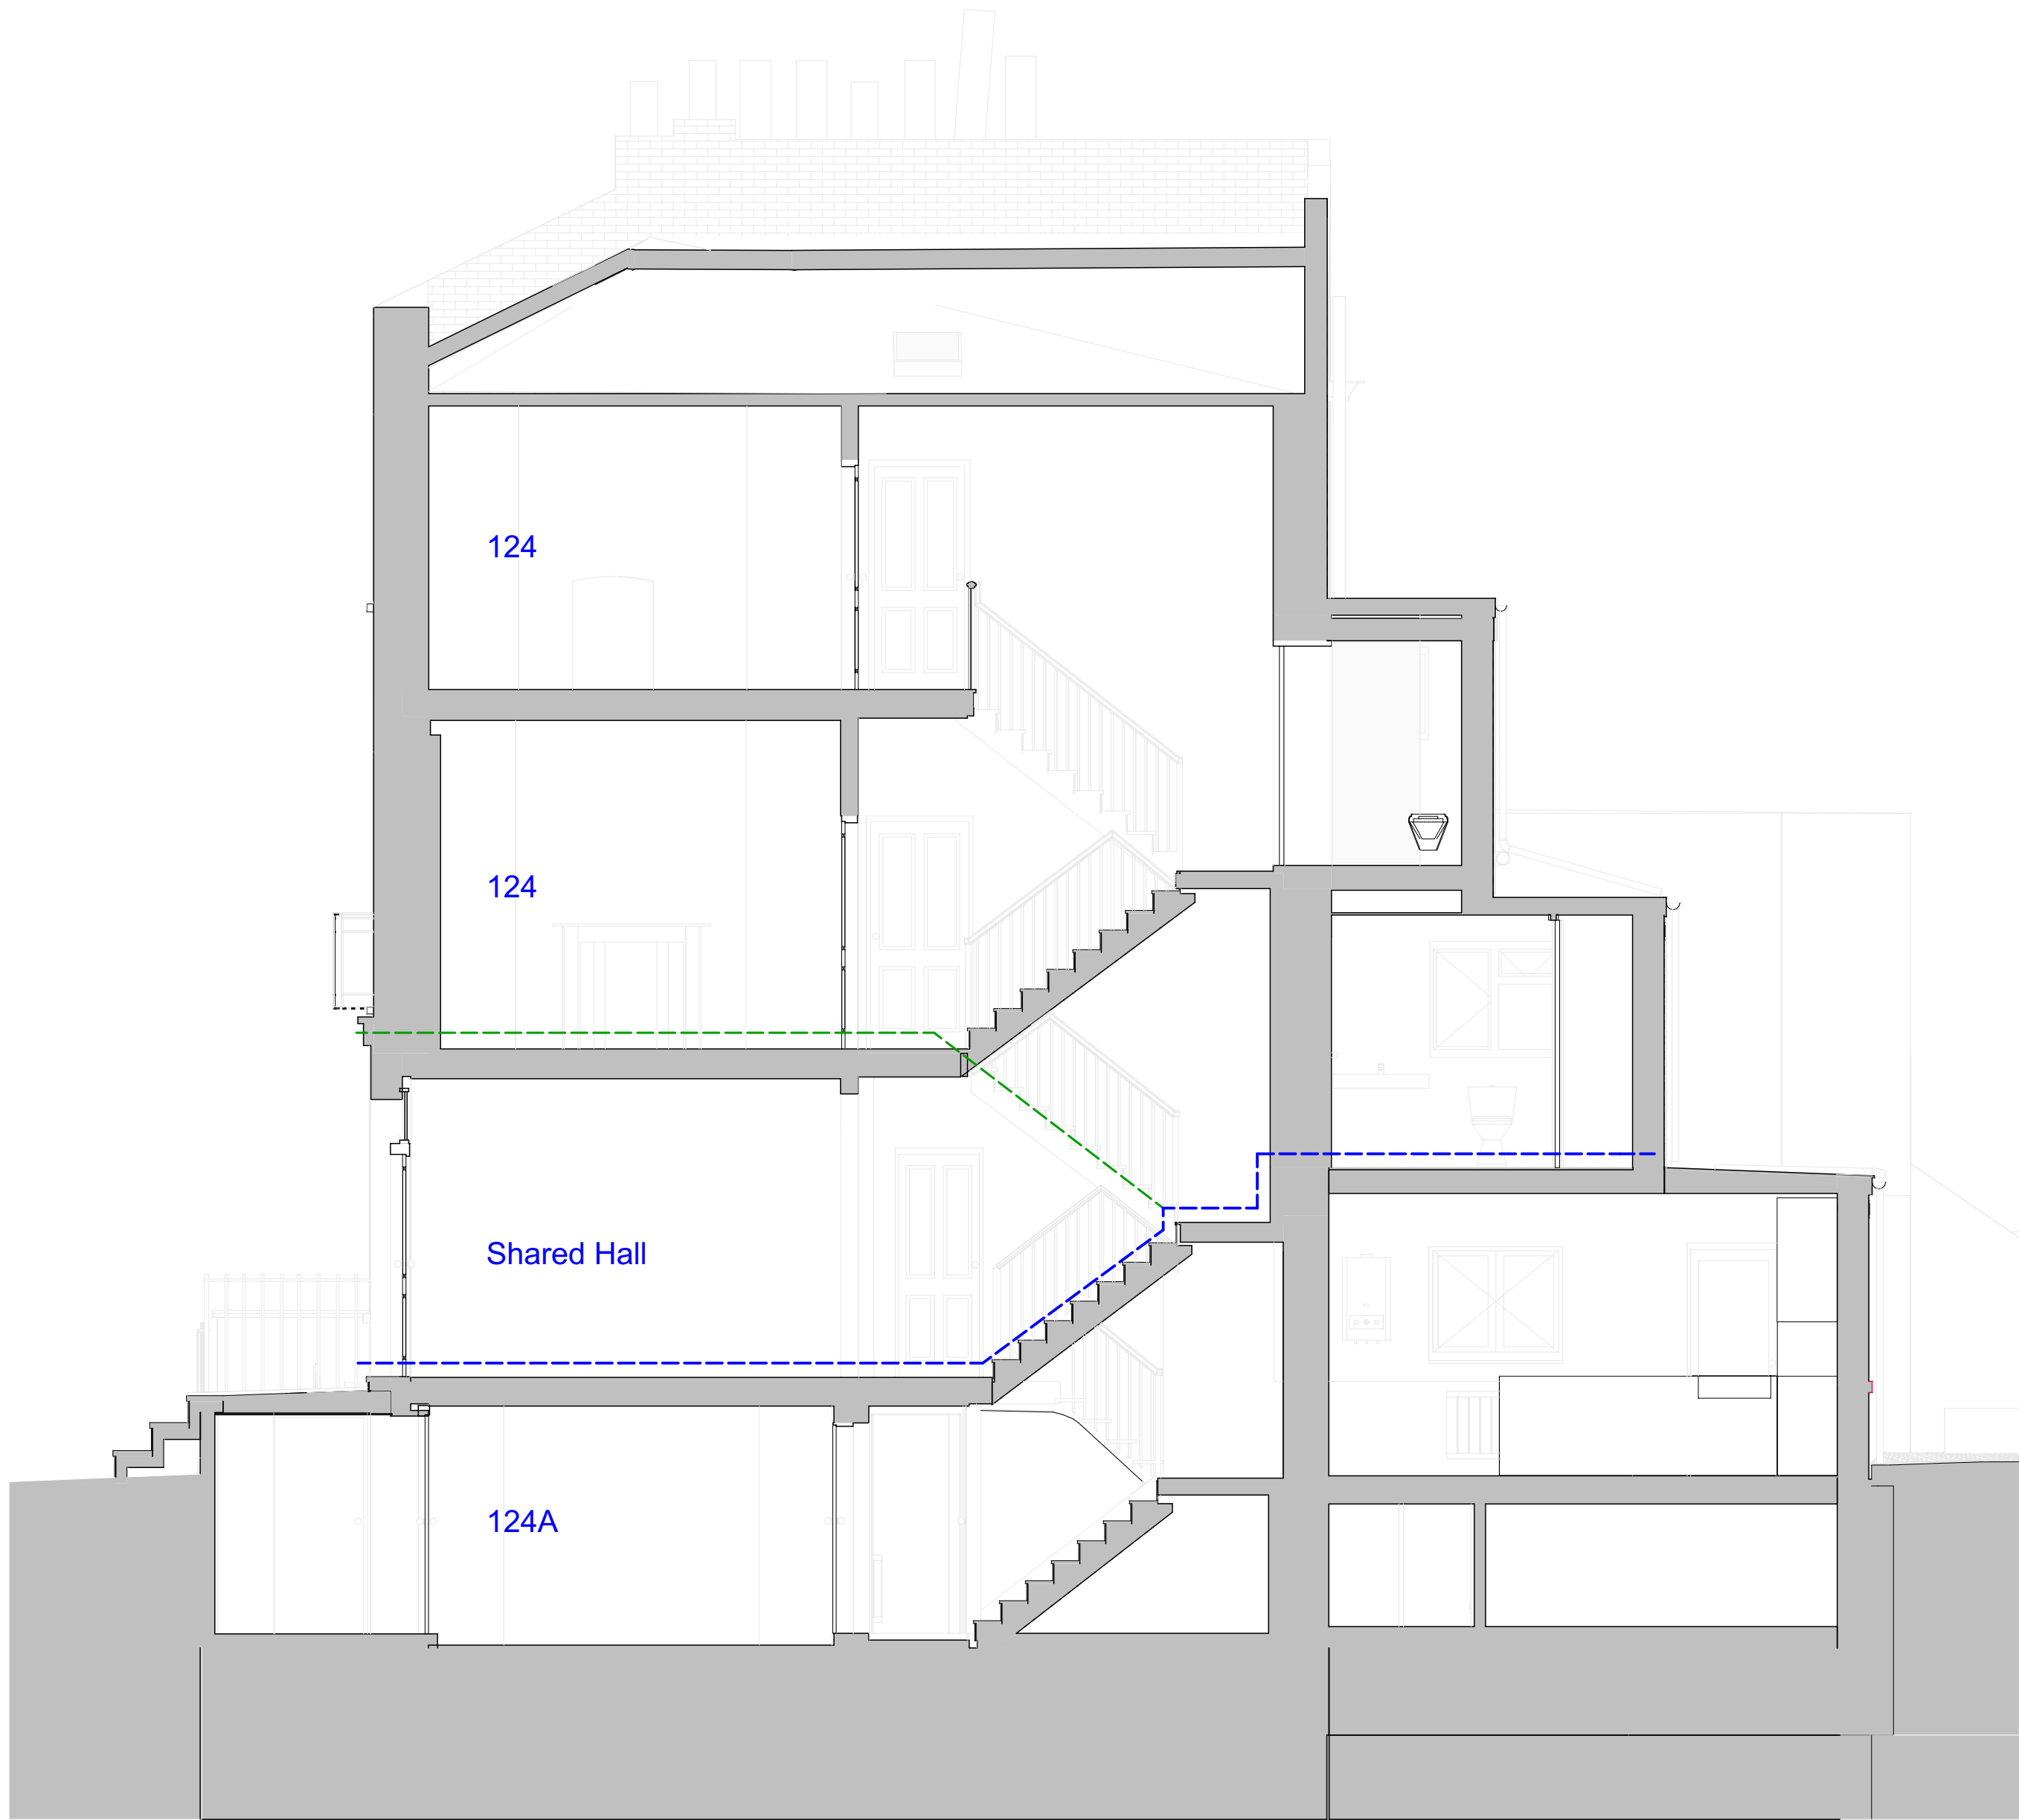


B

LEGEND:

--- AS APPROVED

--- AS BUILT

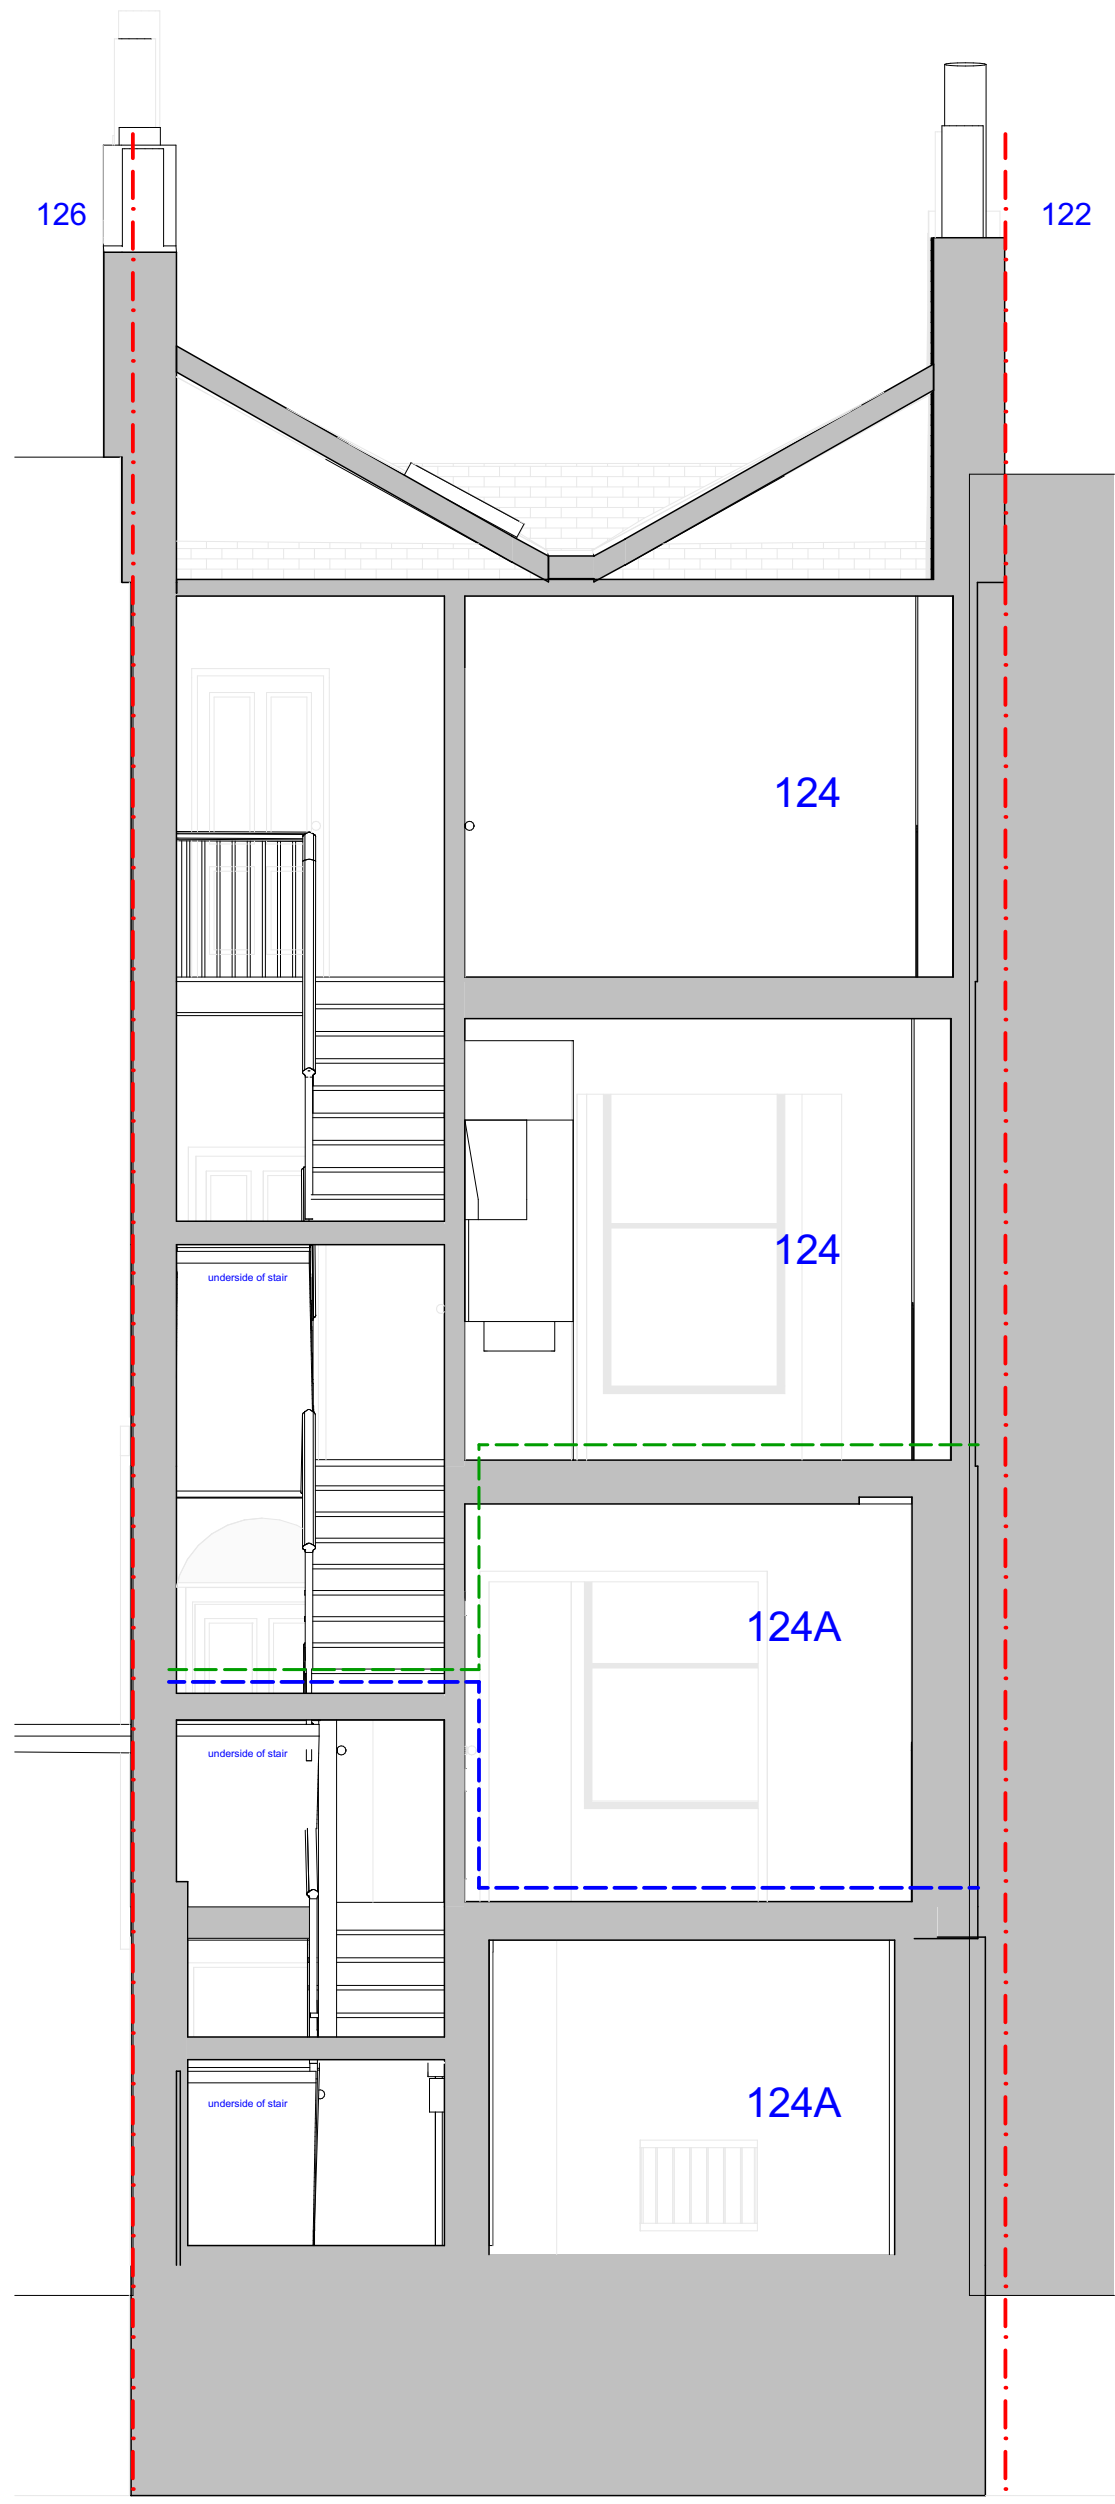

C

SCALE 1:50

0 1000 2000mm

S/A

10b Branch Place
London N1 5PH
p: 0207 686 3445
e: info@scenarioarchitecture.com
w: www.scenarioarchitecture.com

Project Name:
124&124A St Pancras Way

Client:
Anya Thomas

Site Location:
**124&124A St Pancras Way
London NW1 9NB UK**

Drawing not to be used other than the purpose for which it was prepared. It's supplied without liability for errors or omissions. All dimensions are to be checked on site. This drawing is to be read in conjunction with all other drawings. Notes on this drawing will apply to all other drawings where a similar position exists.

Scale @ A2 Project No.
1:50 146

Drawing Name
Existing Sections

Drawing Number Rev

EX-A3.02