



2022/2177/P

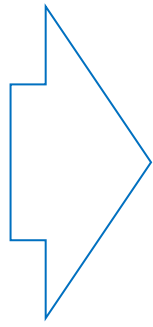

2023/0920/P

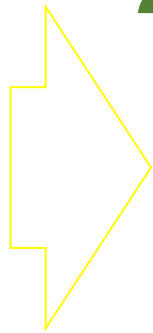

2022/1872/P

The previous:

2 Hillfield Road

"Tradition"

Blue line

The previous:

2 Hillfield Road

"Modern"


Red line

The current:

2 Hillfield Road

"RECESSED"

Fresh Loft

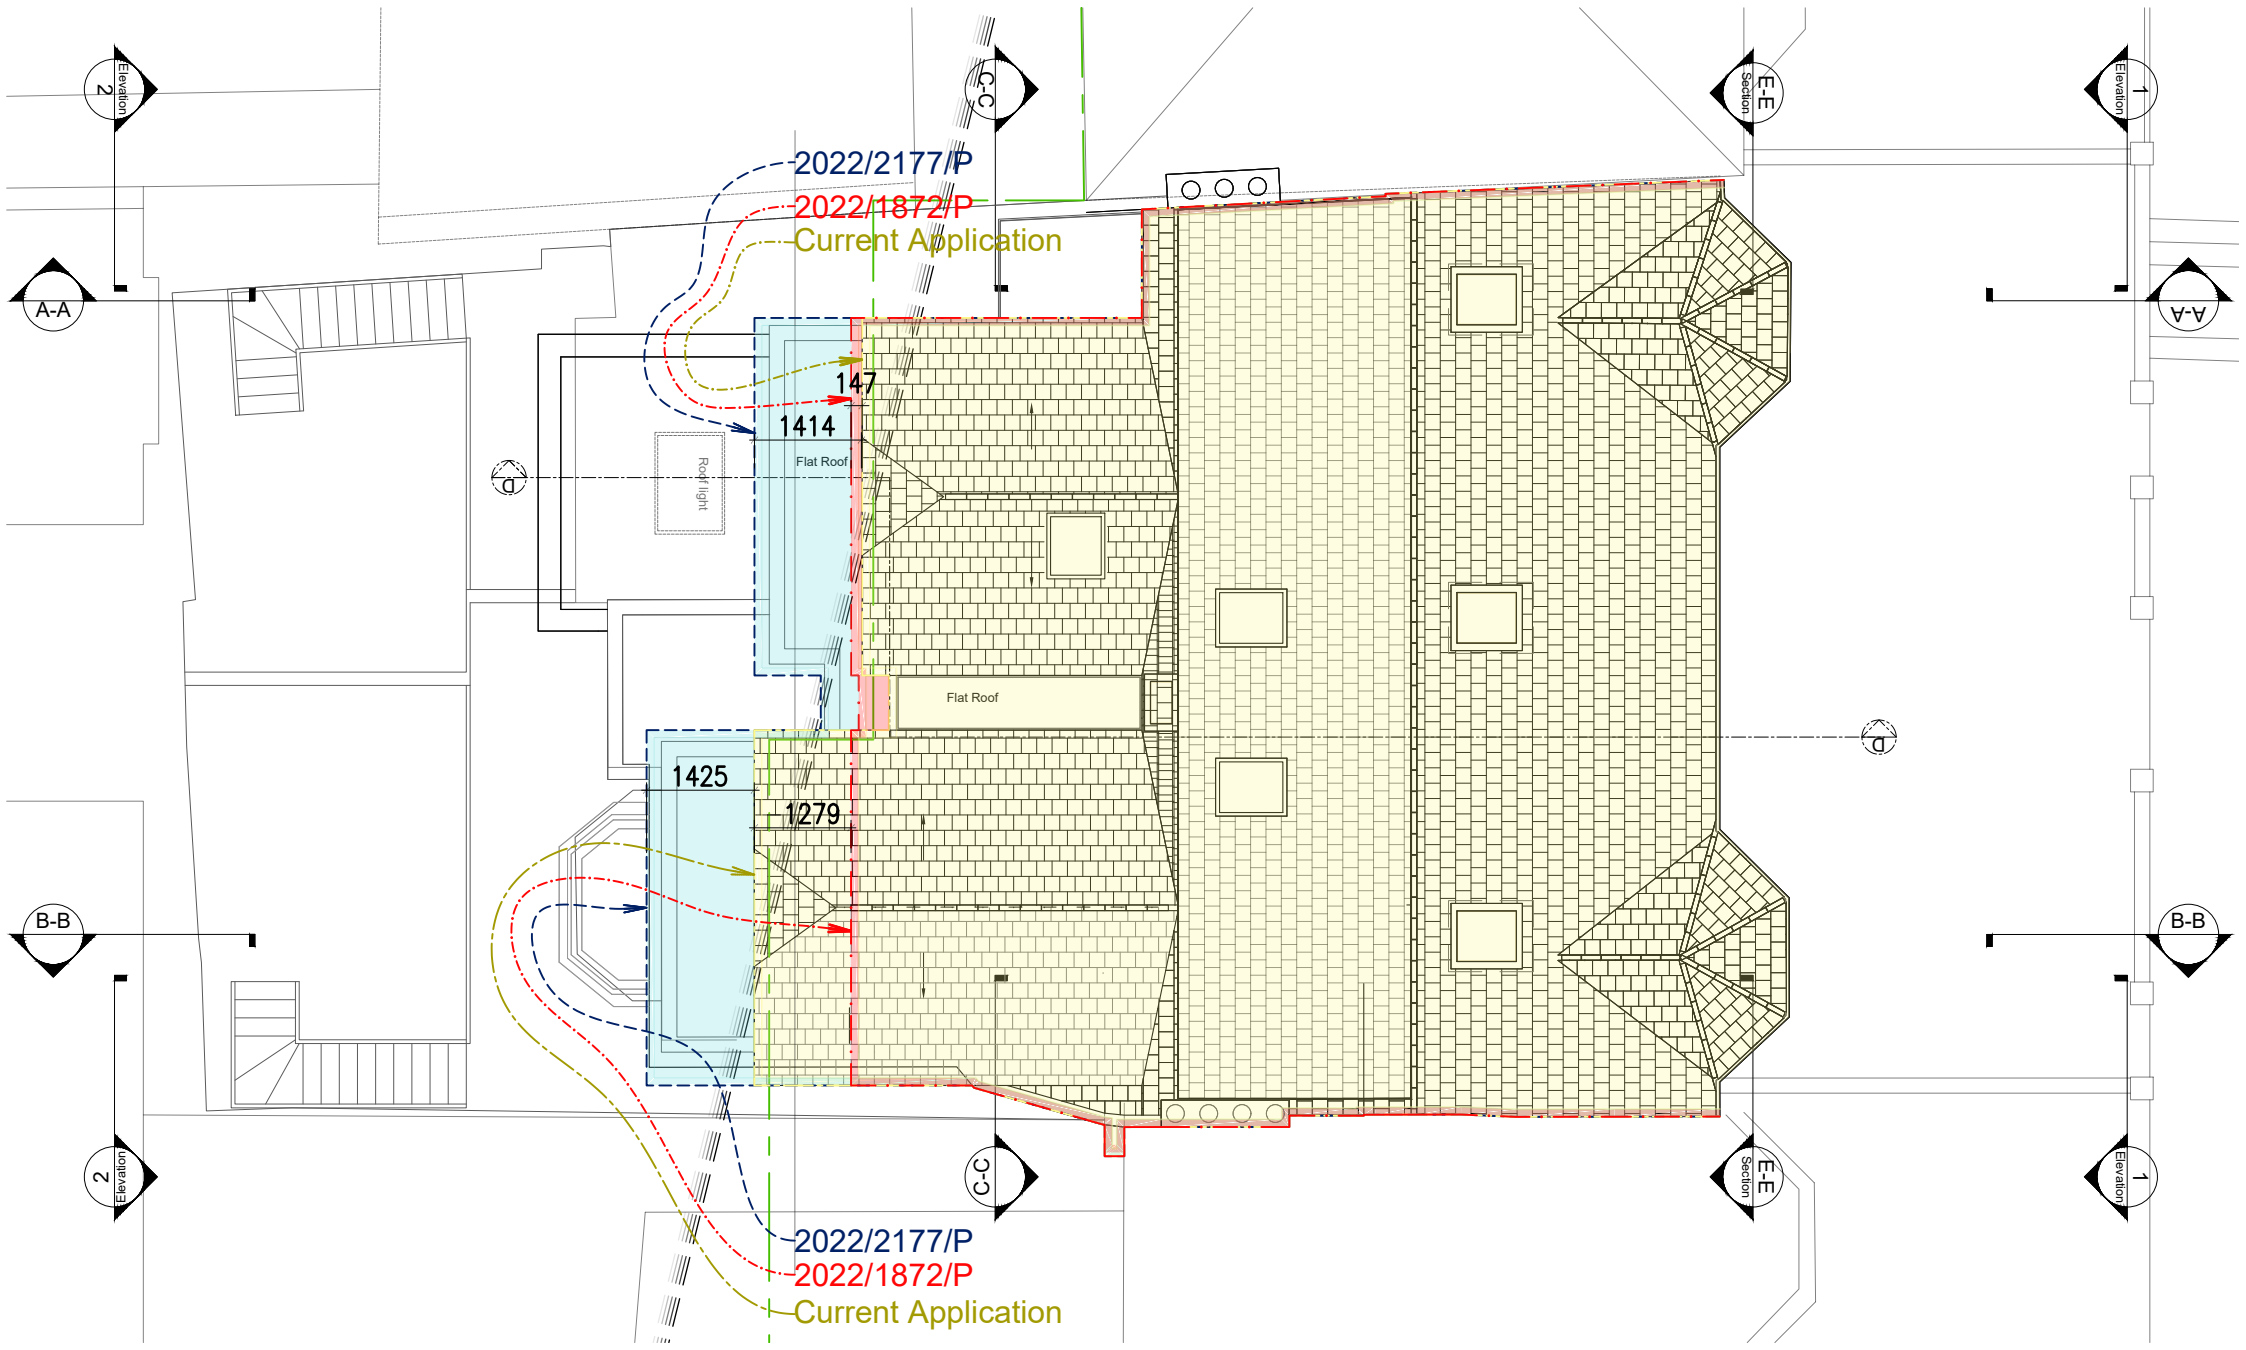



2022/2177/P

The previous:
2 Hillfield Road
"Tradition"
Blue line




2022/1872/P

The previous:
2 Hillfield Road
"Modern"
Red line

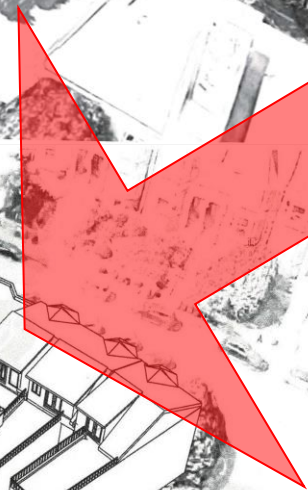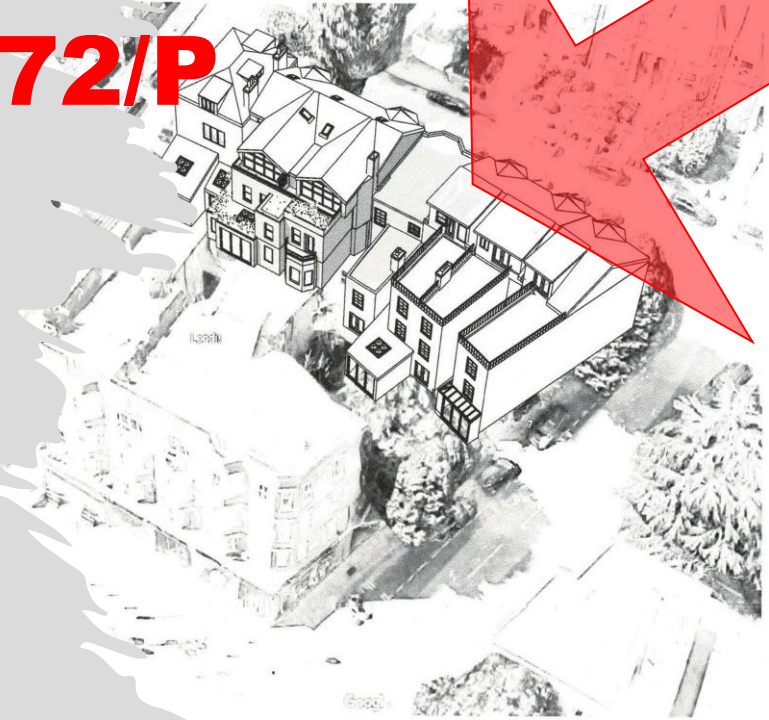

2023/0920/P

The current:
2 Hillfield Road
"RECESSED"
Fresh Loft

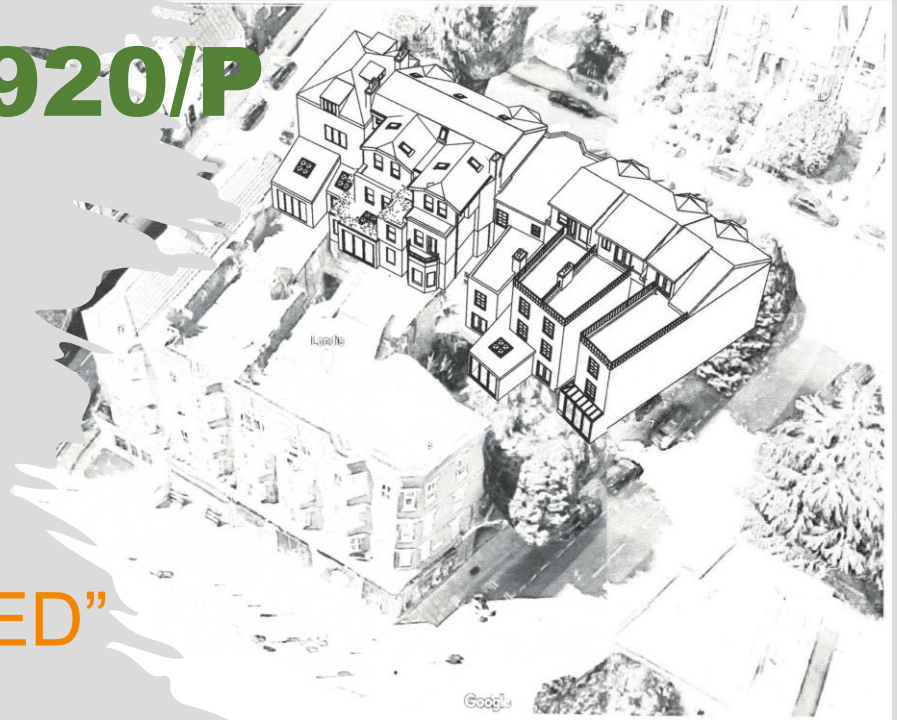

2022/2177/P

2022/1872/P


The previous:
2 Hillfield Road
"Tradition"
Blue line



The previous:
2 Hillfield Road
"Modern"
Red line



The current:
2 Hillfield Road
"RECESSED"
Fresh Loft

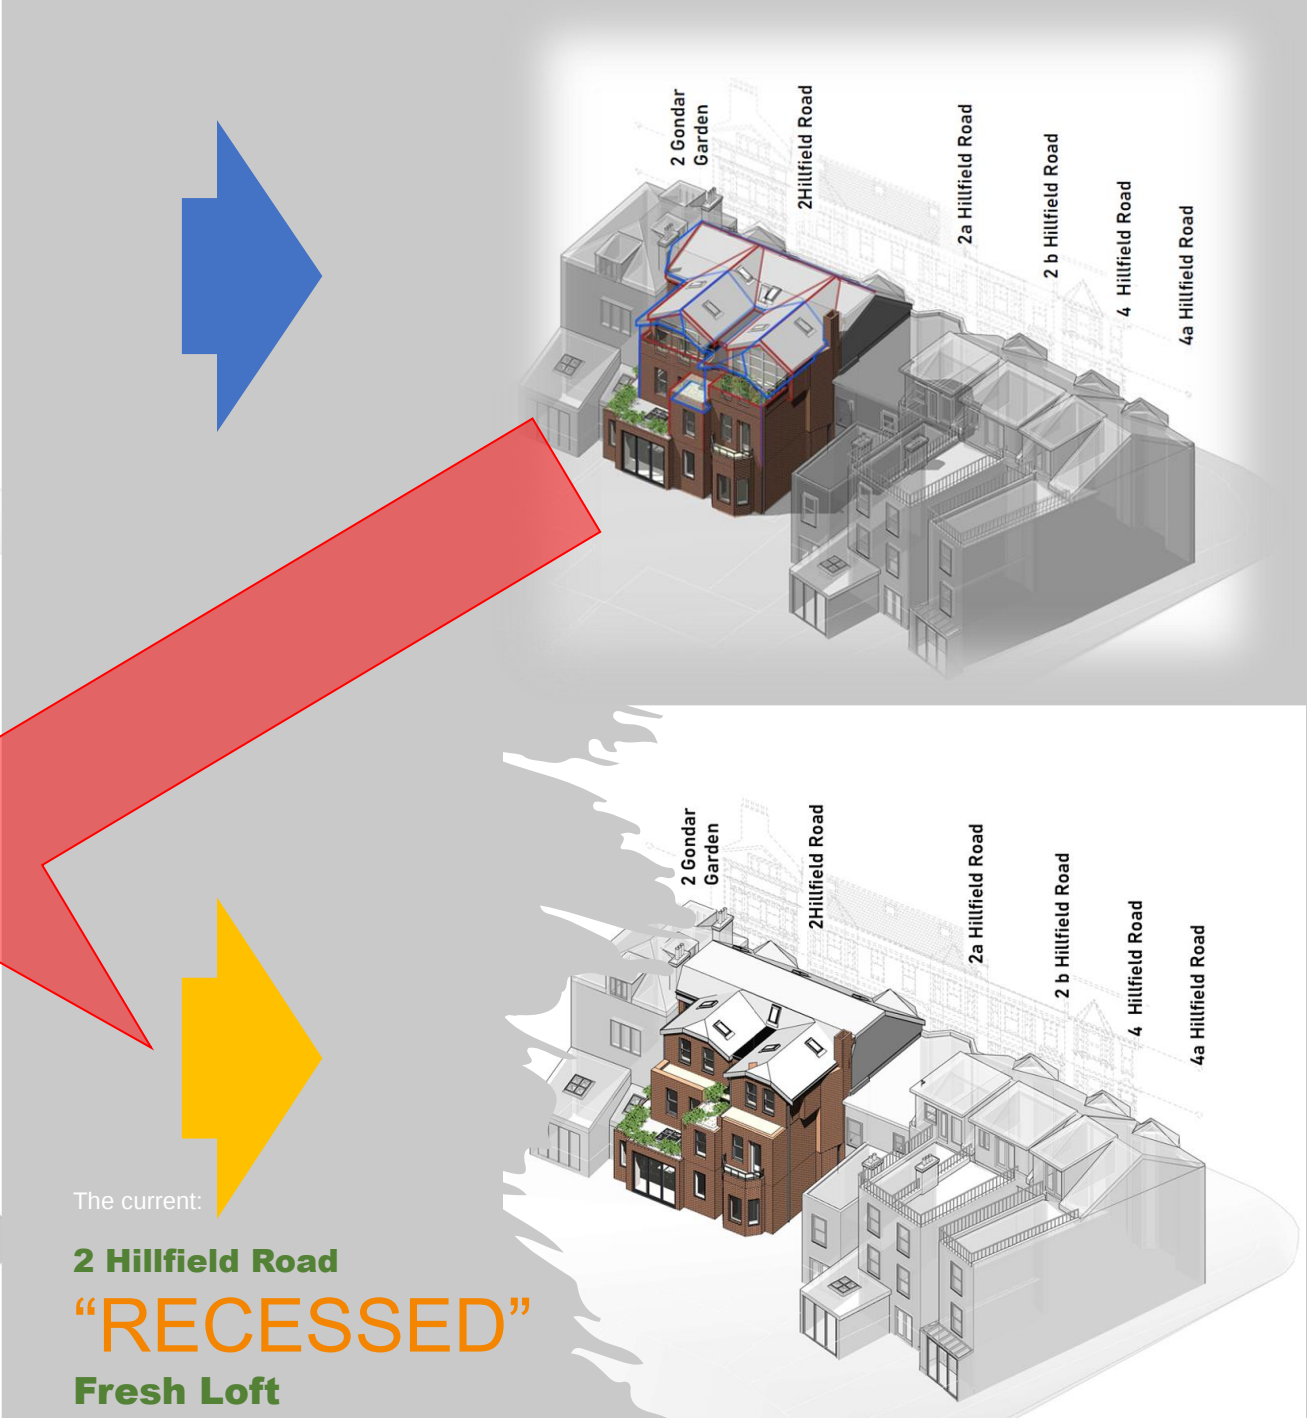

2023/0920/P