



1 Typical WT5 Details  
1 : 10

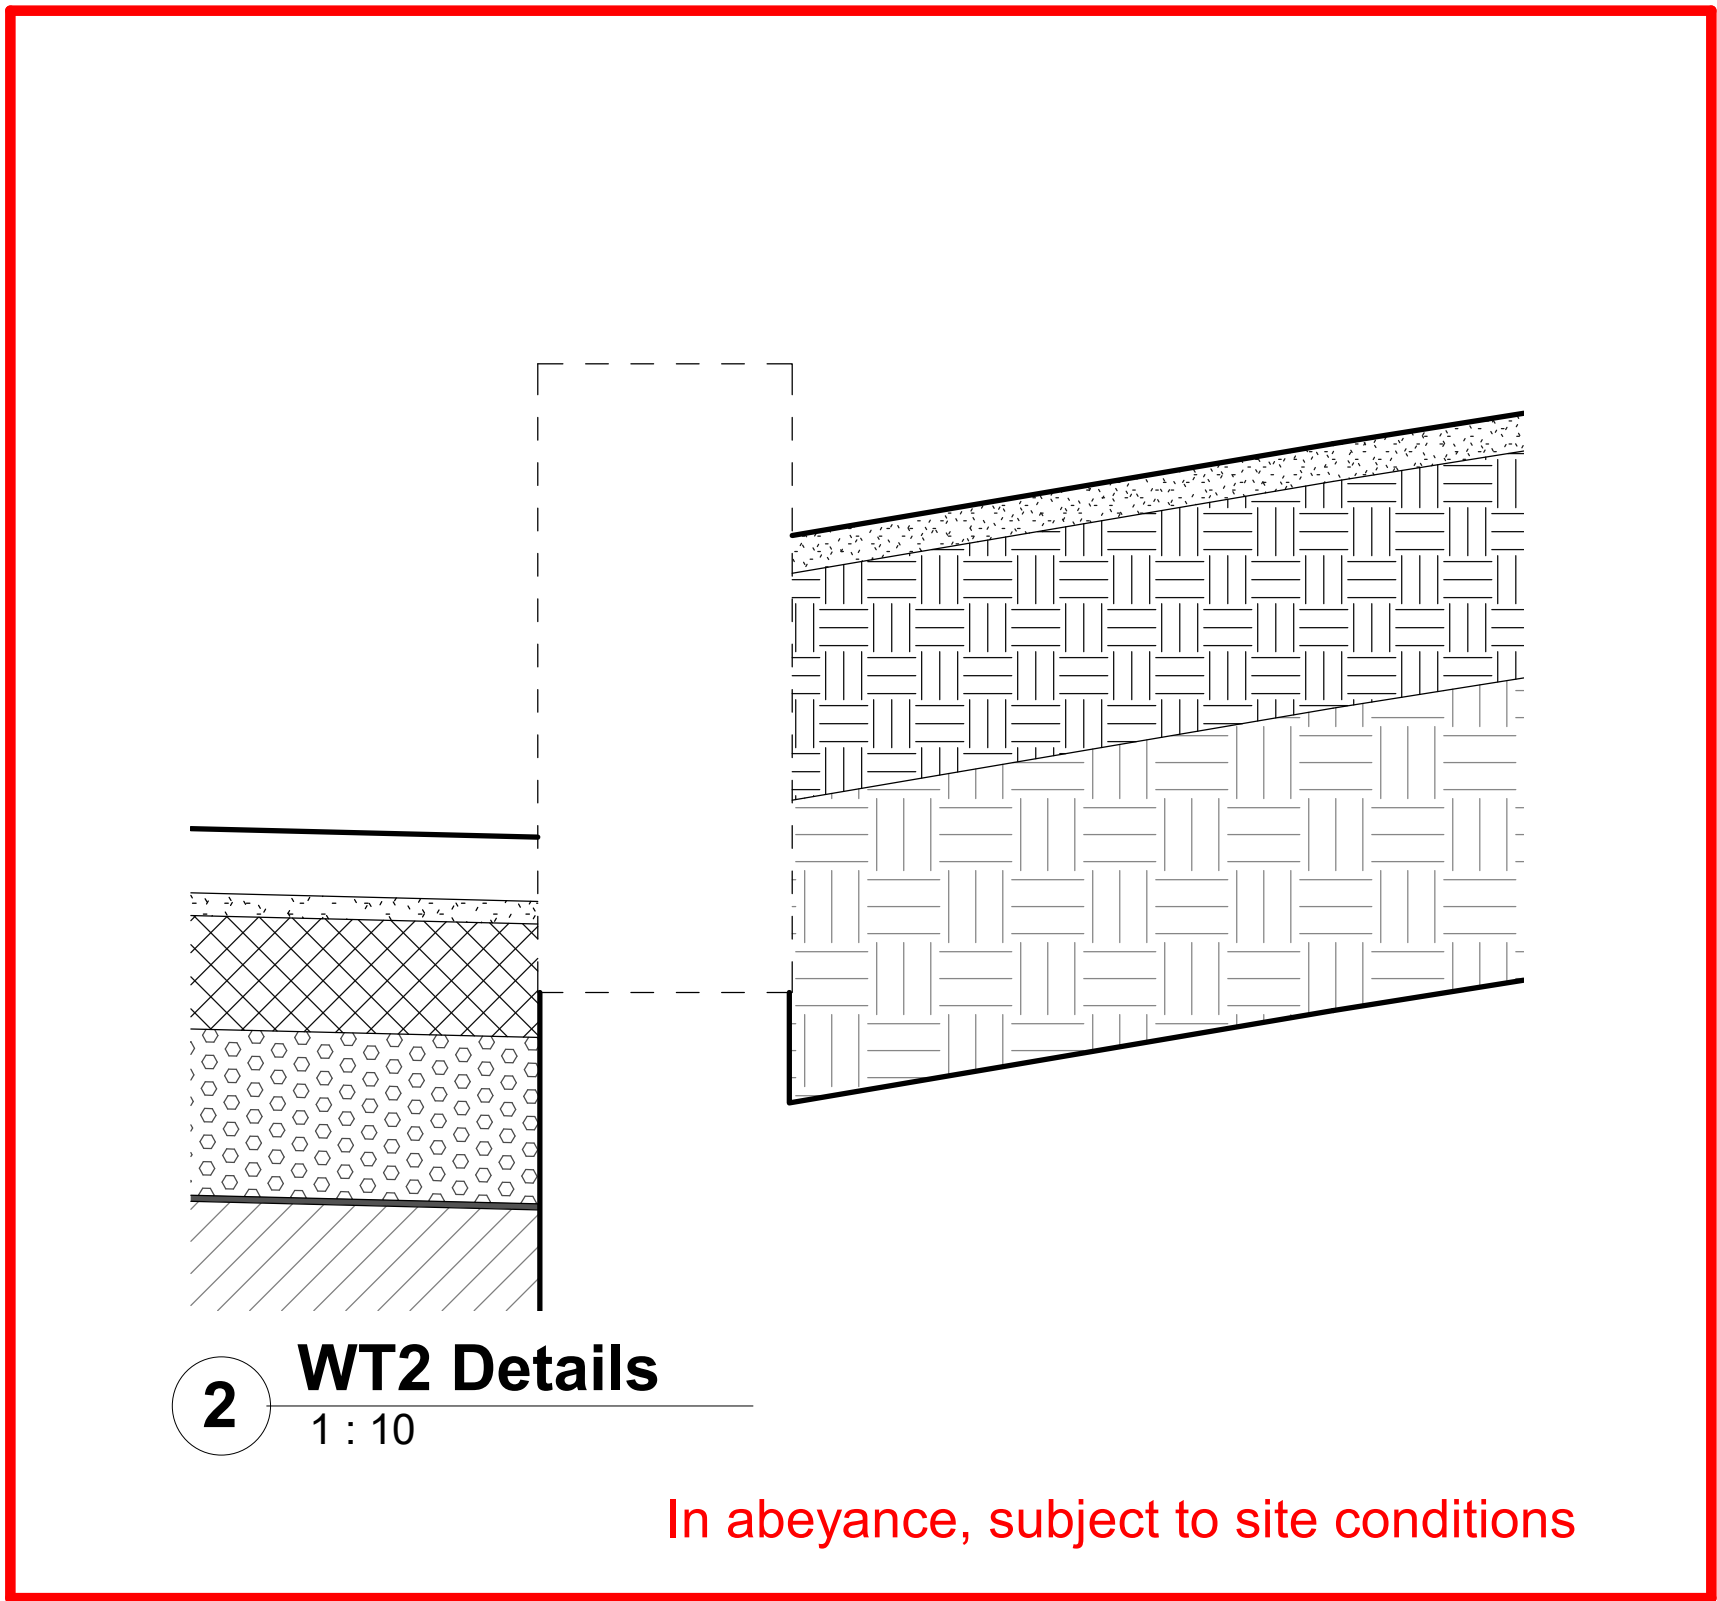

3 WT5 Wall 3D View

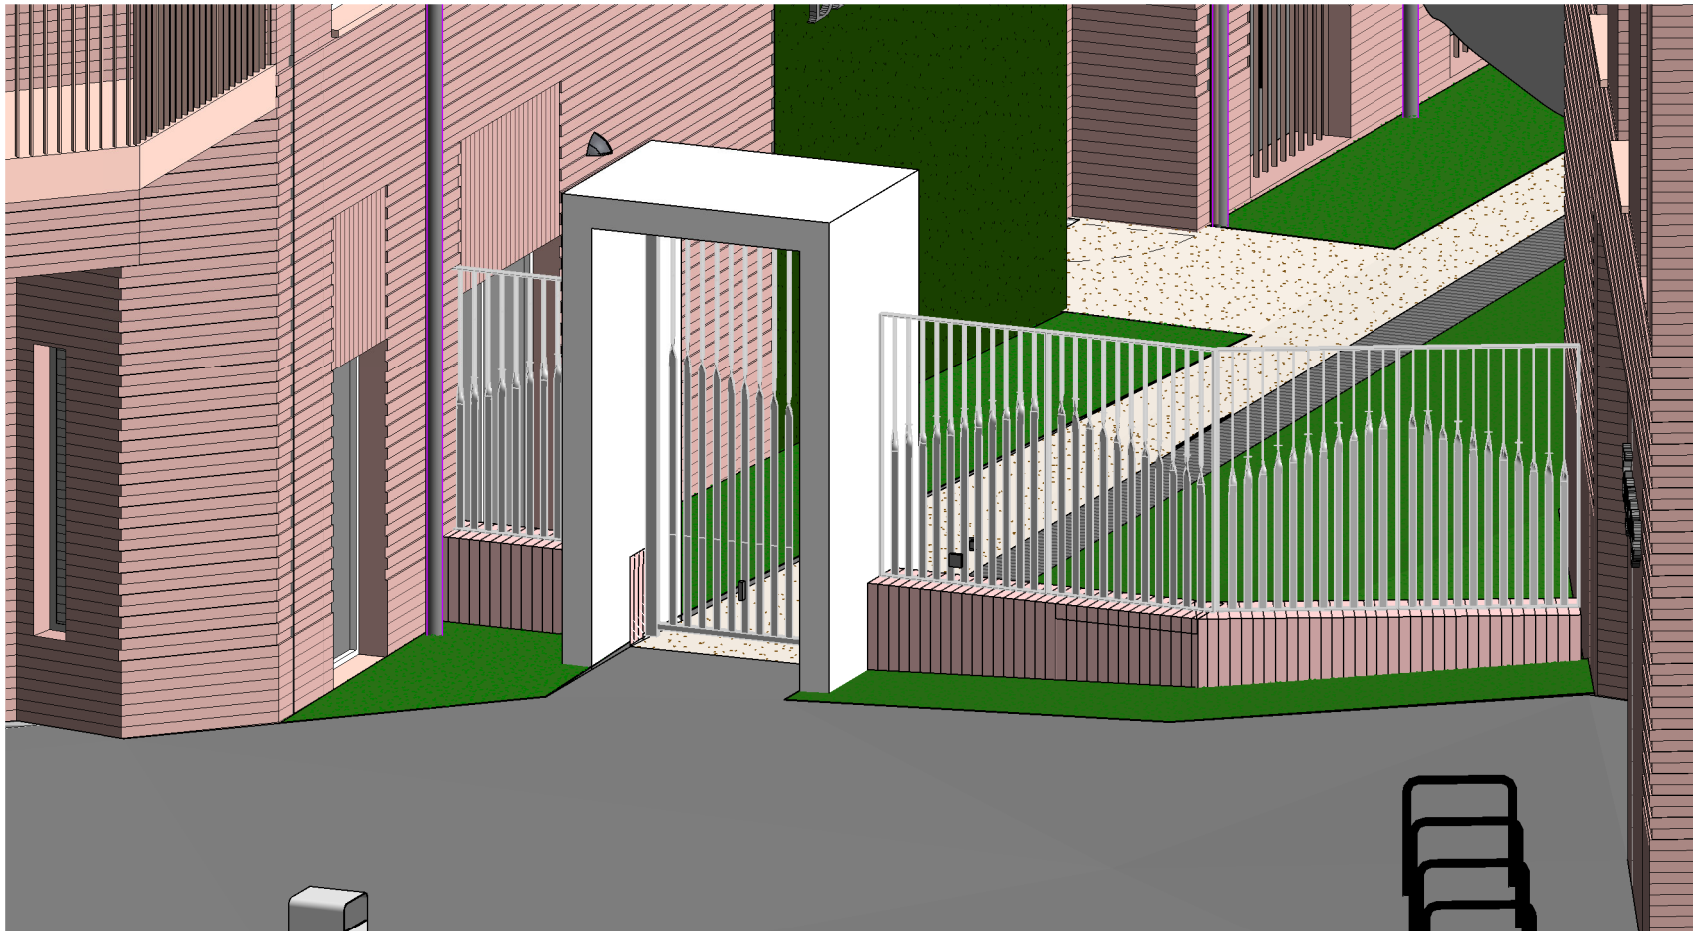

- KEY:
- PT1 Paving Type 1: Clay brick paver  
PT2 Paving Type 2: Resin bound gravel  
PT3 Paving Type 3: Adoptable highway paving to Highway Engineer's design and specification  
PT4 Paving Type 4: Salvaged site-won paving features  
PT5 Paving Type 5: Cedec self binding gravel to tree pits  
PT6 Paving Type 6: Granite setts to Highway Engineer's design and specification  
PT7 Paving Type 7: Brick steps  
PT8 Paving Type 8: 300mm gravel strip to building facade
- WT1 Wall Type 1: Existing brick wall retained  
WT2 Wall Type 2: Existing brick wall to be made good or replaced  
WT3 Wall Type 3: Brick wall to match Architectural brickwork proposals, 215mm width  
WT4 Wall Type 4: Brick wall to match Architectural brickwork proposals, 440mm width  
WT5 Wall Type 5: Concrete wall to courtyard entrance
- BT1 Boundary Type 1: Ornamental railings above brick wall  
BT2 Boundary Type 2: Handrail to steps  
BT3 Boundary Type 3: Indicative railings to Architect's design and specification  
BT4 Boundary Type 4: Ornamental railings
- G1 Gate Type 1: Ornamental metal gate to courtyard entrance and planting area  
G2 Gate Type 2: Ornamental metal gate to private garden

- NOTES
- All detail drawings to be read in conjunction with Landscape GA Plans, NBS Specification and Soft landscape schedules.
  - All products to be installed to manufacturer's recommendations
  - For all buildups to landscape finishes to Civil Engineer's detail and specification.
  - All masonry to be F2 S2 as per Structural Engineer's recommendations.
  - All coping bricks to be F2 S2 as per Structural Engineer's recommendations.
  - All mortar to be M12 as per Structural Engineer's recommendations.
  - Use bucket handle or weather-struck mortar jointing.
  - All foundations to landscape retaining walls to Structural Engineer's detail and specification, and to Contractor's proposals.
  - All footings and foundations to landscape furniture, play equipment to manufacturer's recommendations and to Contractor's proposals.
  - All fixing method to fences, railings, handrails, furniture, play equipment to manufacturer's recommendations.

- Notes
- This drawing is the property of fabrik ltd. It must not be copied or reproduced without written consent.
  - Only figured dimensions are to be taken from this drawing. All contractors must visit site and be responsible for taking and checking all dimensions related to the works shown on the drawing.
  - The original of this drawing has coloured lines. Do not rely on the monochrome copy.

No.	Date	Reason	Name
P2	24/02/2023	Stage 4A Issue - Comments Incorporated	XL
P1	31/01/2023	Stage 4a Issue	XL
Revisions			

fabrik

First Floor  
4-8 Emerson Street  
London  
SE1 9DU

T : 0207 620 1453  
F : 0207 261 9126  
E : london@fabrikuk.com  
W : www.fabrikuk.com

Project

ABBEY AREA PHASE 3 for  
WATES

Drawing

Landscape Wall Details Sheet 2

Scale	Date	Approved	Checked	Drawn
1 : 10	@A1	31/01/23	MB	DY

Project No.	Drawing No.	Revision
D2857, ARP3	ARP3-FAB-ZZ-00-DE-L-908301	P2

<input checked="" type="checkbox"/> Preliminary	<input type="checkbox"/> Issued for Design/Information
<input type="checkbox"/> Issued for Planning Approval	<input type="checkbox"/> Issued for Tender
<input type="checkbox"/> Issued for Construction	<input type="checkbox"/> As Built

Drawing sheet size - A1

Copyright Reserved (C)