


## Existing Plan

Adapted from Lease Plan

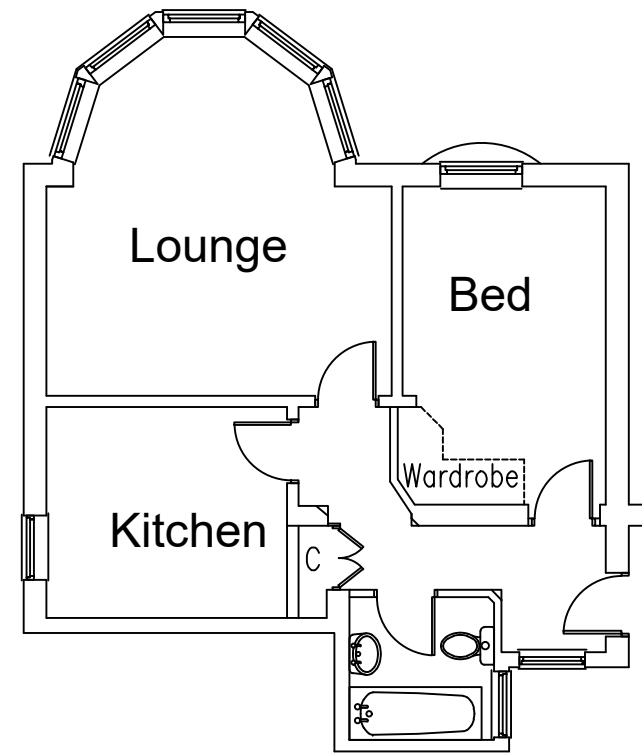

## Proposed Plan

Works as existing

CLIENT  
Steve Pell

PROJECT  
Flat 5a, 28 Arkwright Road  
London NW3 6BH

TITLE  
Regularization of Internal  
alterations

DRAWING  
Existing and proposed (as built)  
floor plans

DRAWING NO  
2212.1184.EF.PF

DATE  
Apr 23

REVISIONS AND ISSUE  
RevDate

DRAWN BY: CB CHECKED BY: PC

### NOTES:

Not for construction. Please do not scale from this drawing unless for planning purposes. All contractors, sub-contractors and suppliers are advise to check relevant dimensions and levels on site prior to the commencement of work.

This drawing is copyright and may not be reproduced in any part of form without written consent of Heritage Unlimited.

SCALE 1:100@A3

