




REVISIONS
REV DATE REVISION NOTES

KEY

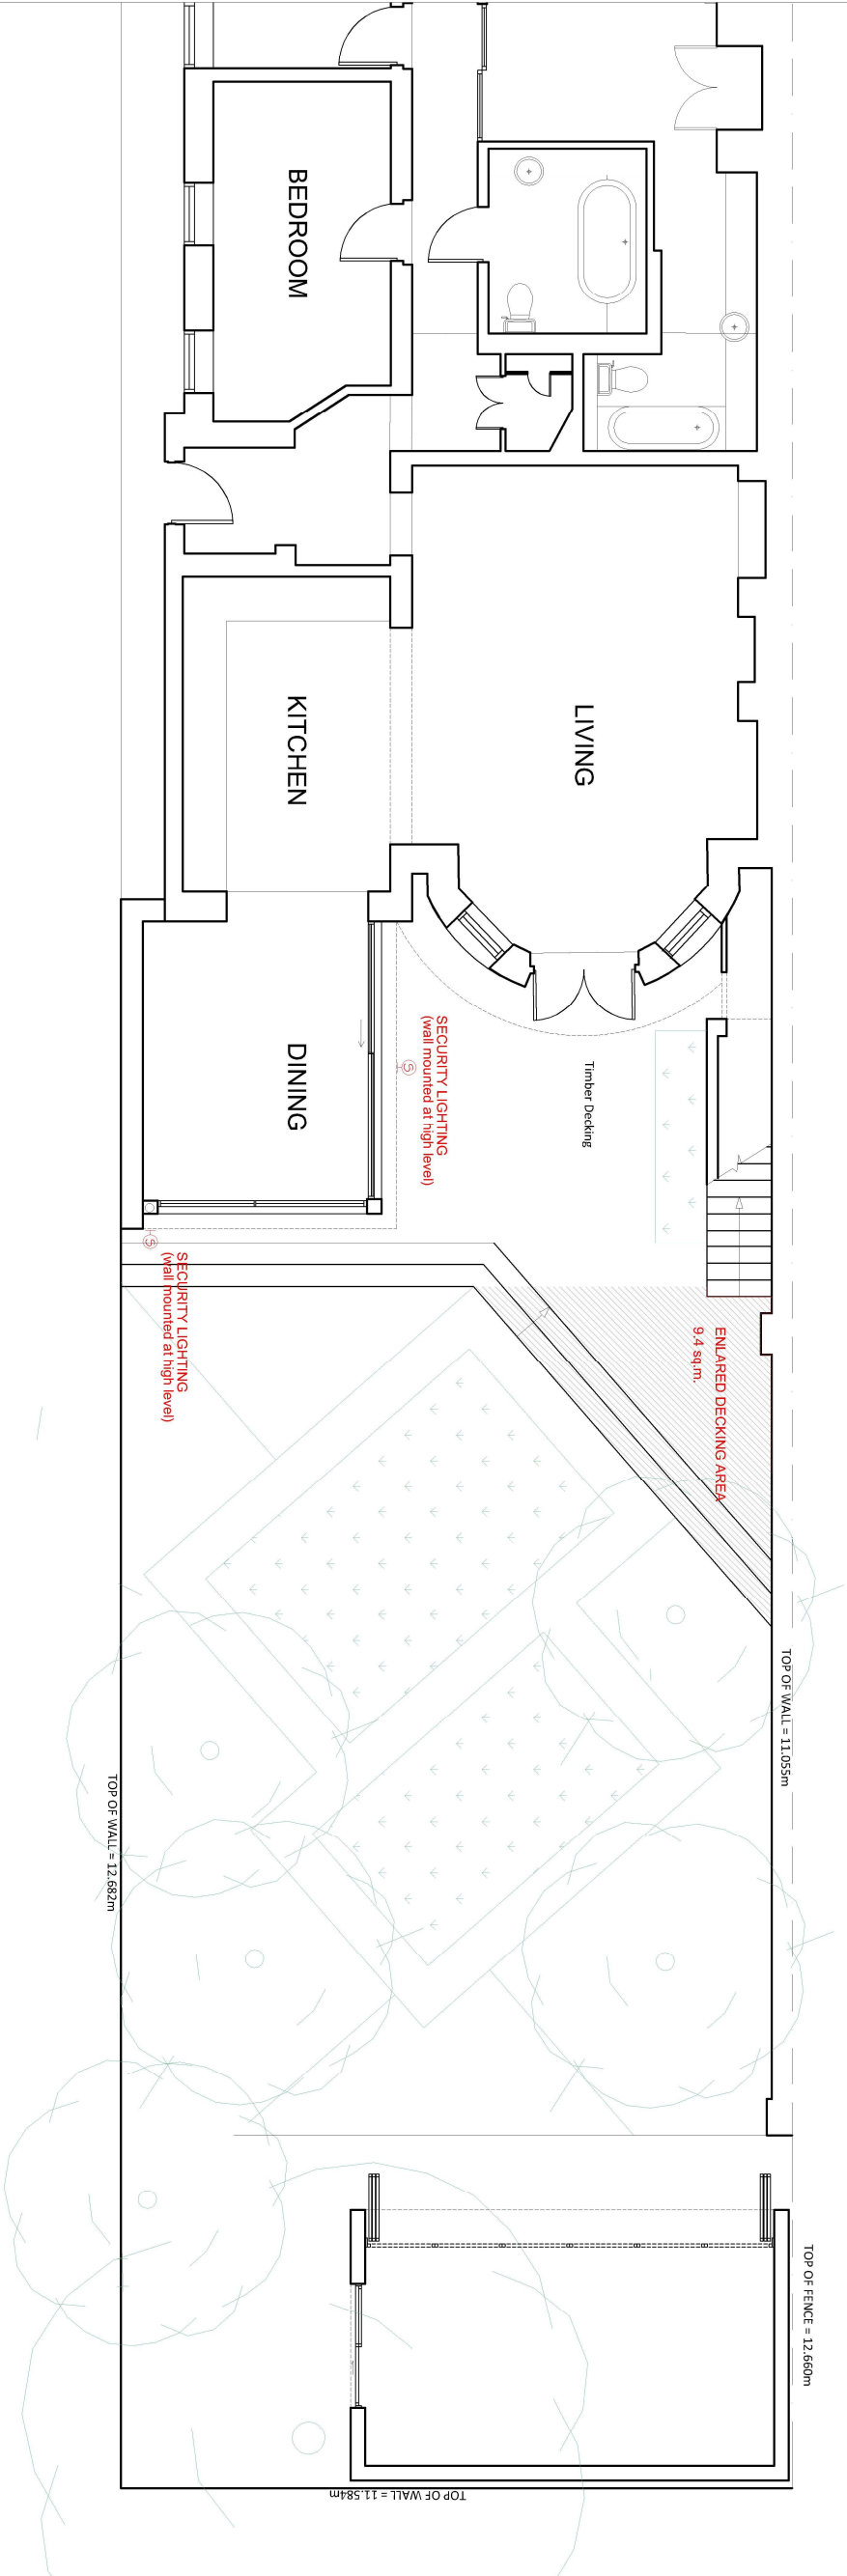

NOTES

1. Do not scale from this drawing.
2. All dimensions are given in millimetres unless otherwise stated.
3. Report all drawing errors, omissions and discrepancies to the architect/designer.

KASIA WHITFIELD DESIGN

KASIA WHITFIELD
11020 7746652
M: 07885035333

JOB

9A BELSIZE SQUARE
LONDON NW3 4HT

FLOOR PLAN AS CONSTRUCTED

DATE	SCALE	STATUS
2023.06.06	1:100@A3	AS CONSTRUCTED
PROJECT NO.	DRAWING NO.	REVISION

BS9/3 PP01-100

0m 5m