

EXISTING SITE PLAN  
SCALE 1:1250 @ A1




EXISTING SITE PLAN SHOWING SURVEY DATA AND EXISTING TREES  
GREEN LINE SHOWS EXTENT OF FENCE ADDITION  
BLUE LINE SHOWS EXTENT OF GATE REPLACEMENT  
SCALE 1:200 @ A1




PHOTO 1: EXISTING TIMBER GATE  
NOT TO SCALE

LINTEL AND HOUSE  
NUMBERS TO BE  
RETAINED

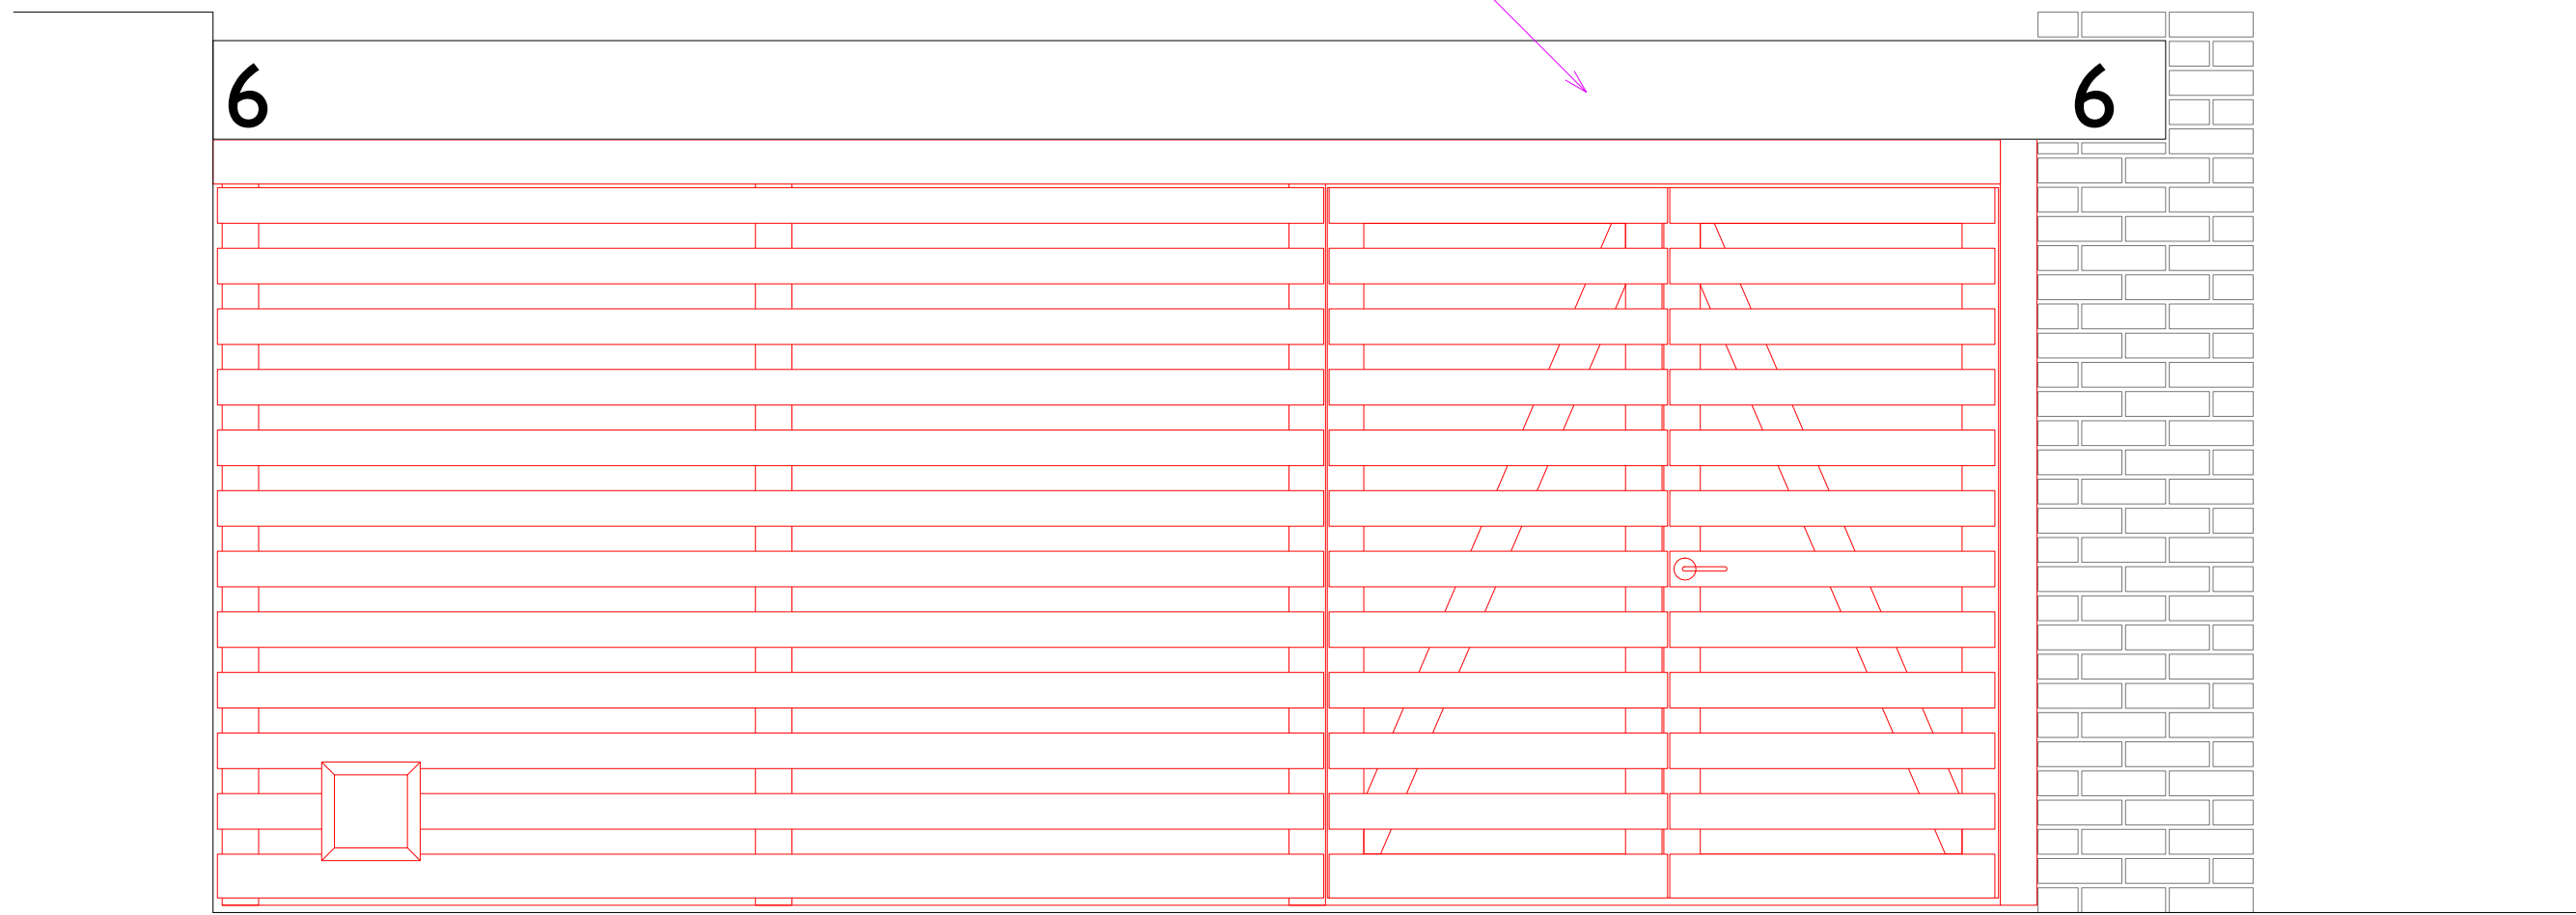

EXISTING GATE ELEVATION FROM BACON'S LANE WITH REMOVAL SHOWN IN RED  
SCALE 1:20 @ A1

LEDGED AND BRACED  
STRUCTURE TO GATE  
TO MATCH EXISTING

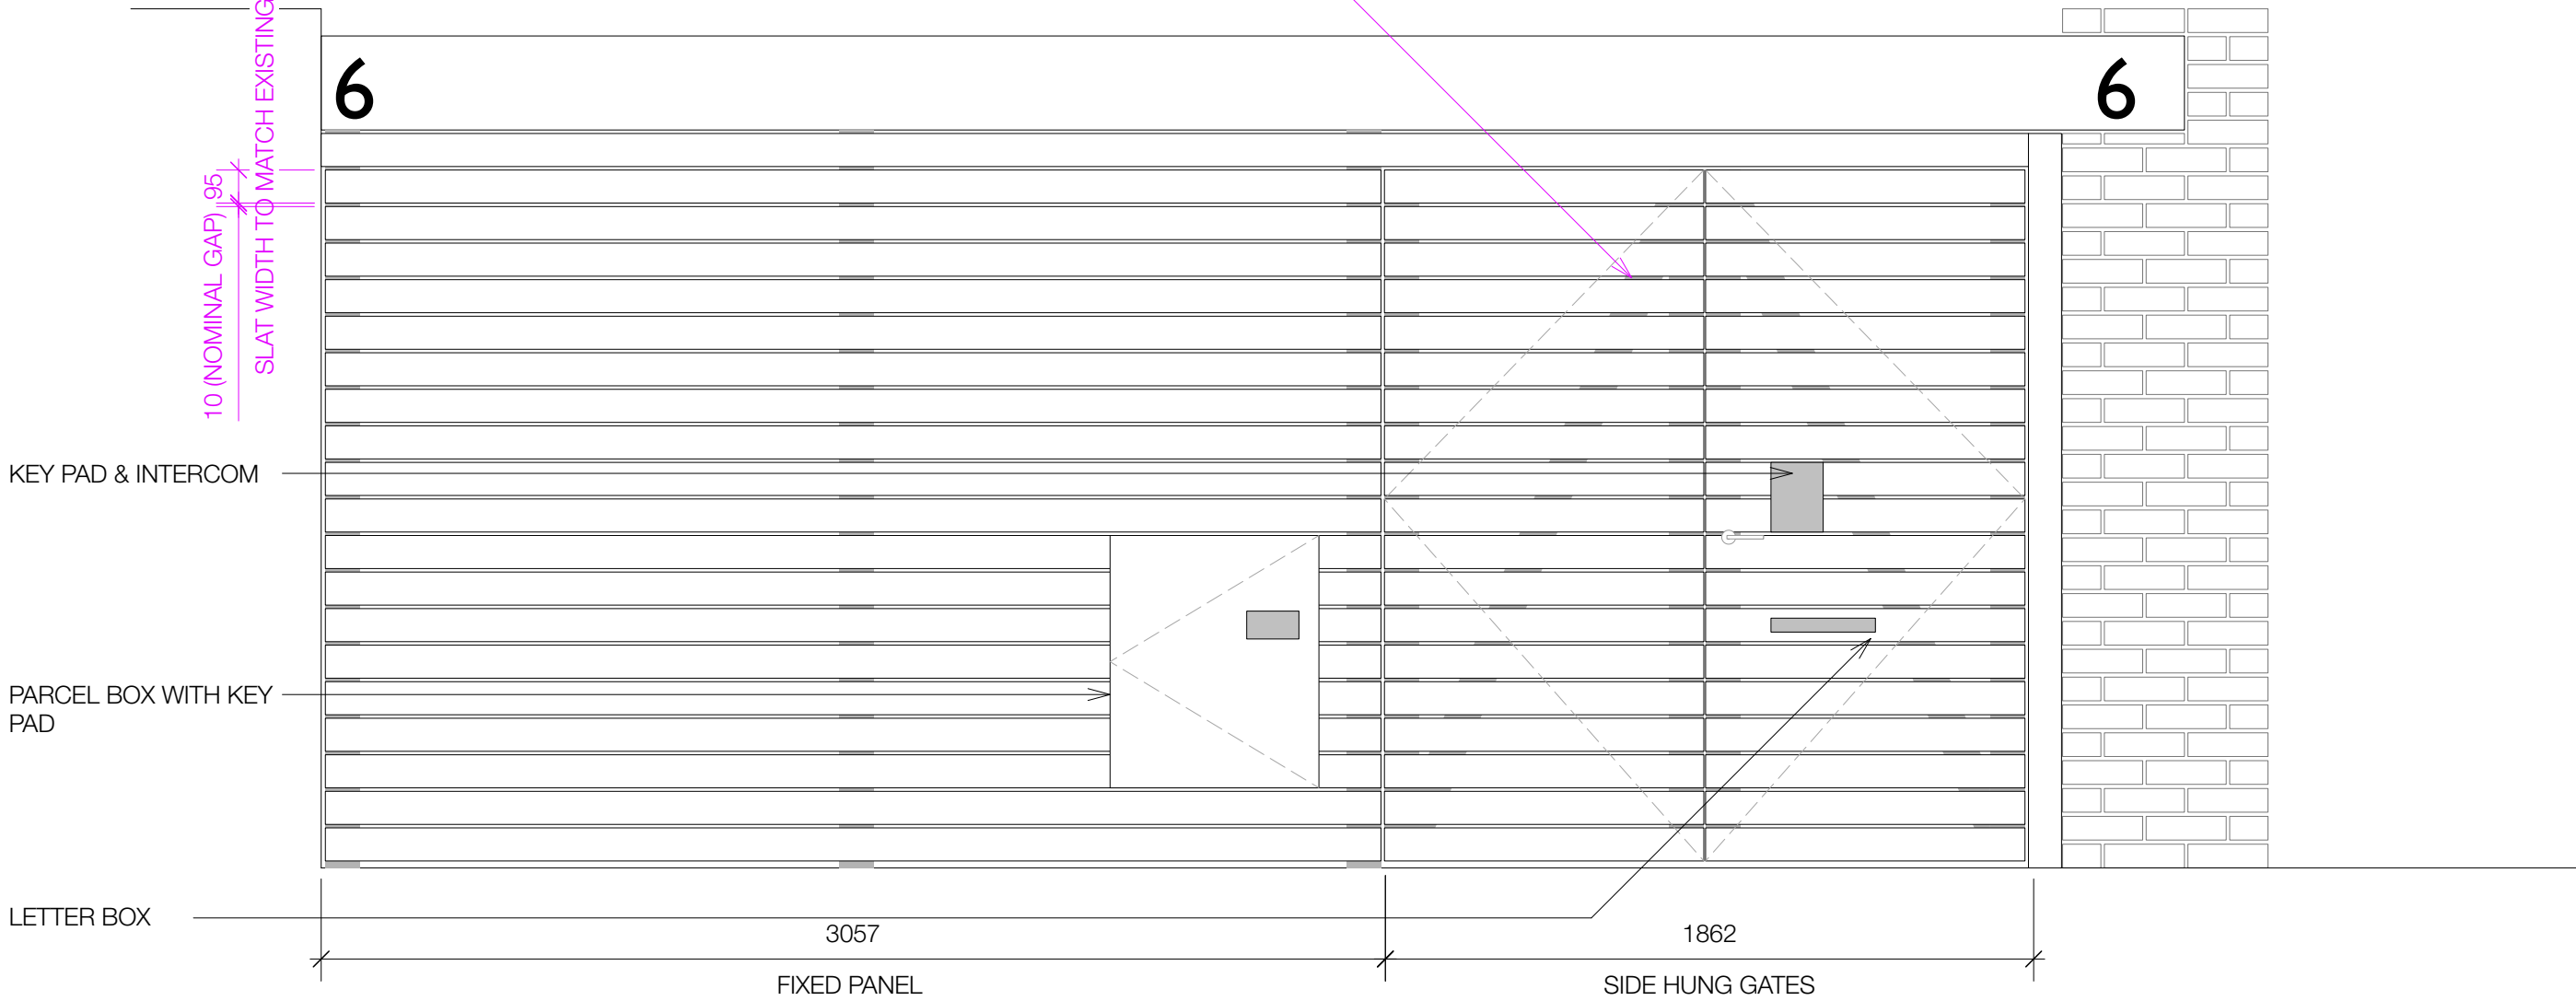

PROPOSED GATE ELEVATION FROM BACON'S LANE  
MADE OF TIMBER HORIZONTAL SLATS PAINTED WHITE TO MATCH EXISTING  
SCALE 1:20 @ A1




PHOTO 2: REAR WALL TO HIGHGATE  
CEMETERY LOOKING SOUTH EAST  
FROM FIRST FLOOR OF HOUSE  
NOT TO SCALE




PHOTO 3: REAR WALL TO HIGHGATE CEMETERY ABOUTING NEIGHBOURING WALL, LOOKING  
SOUTH EAST TO 103 SWAIN'S LANE  
NOT TO SCALE



PHOTO 5: REAR WALL TO HIGHGATE CEMETERY ABOUTING NEIGHBOURING WALL LOOKING  
SOUTH EAST TO 103 SWAIN'S LANE  
NOT TO SCALE

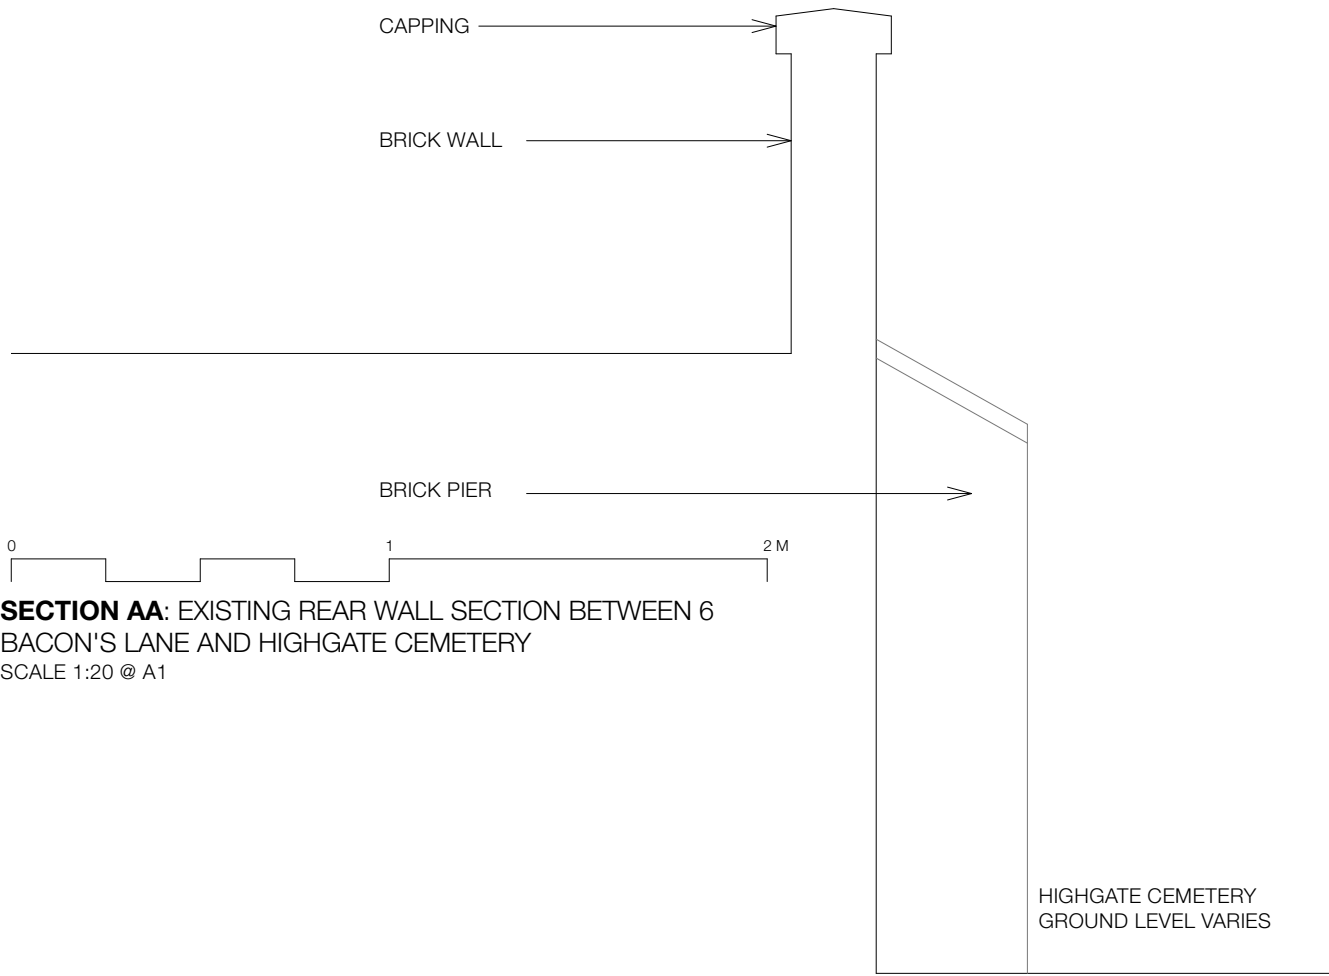

SECTION AA: EXISTING REAR WALL SECTION BETWEEN 6  
BACON'S LANE AND HIGHGATE CEMETERY  
SCALE 1:20 @ A1

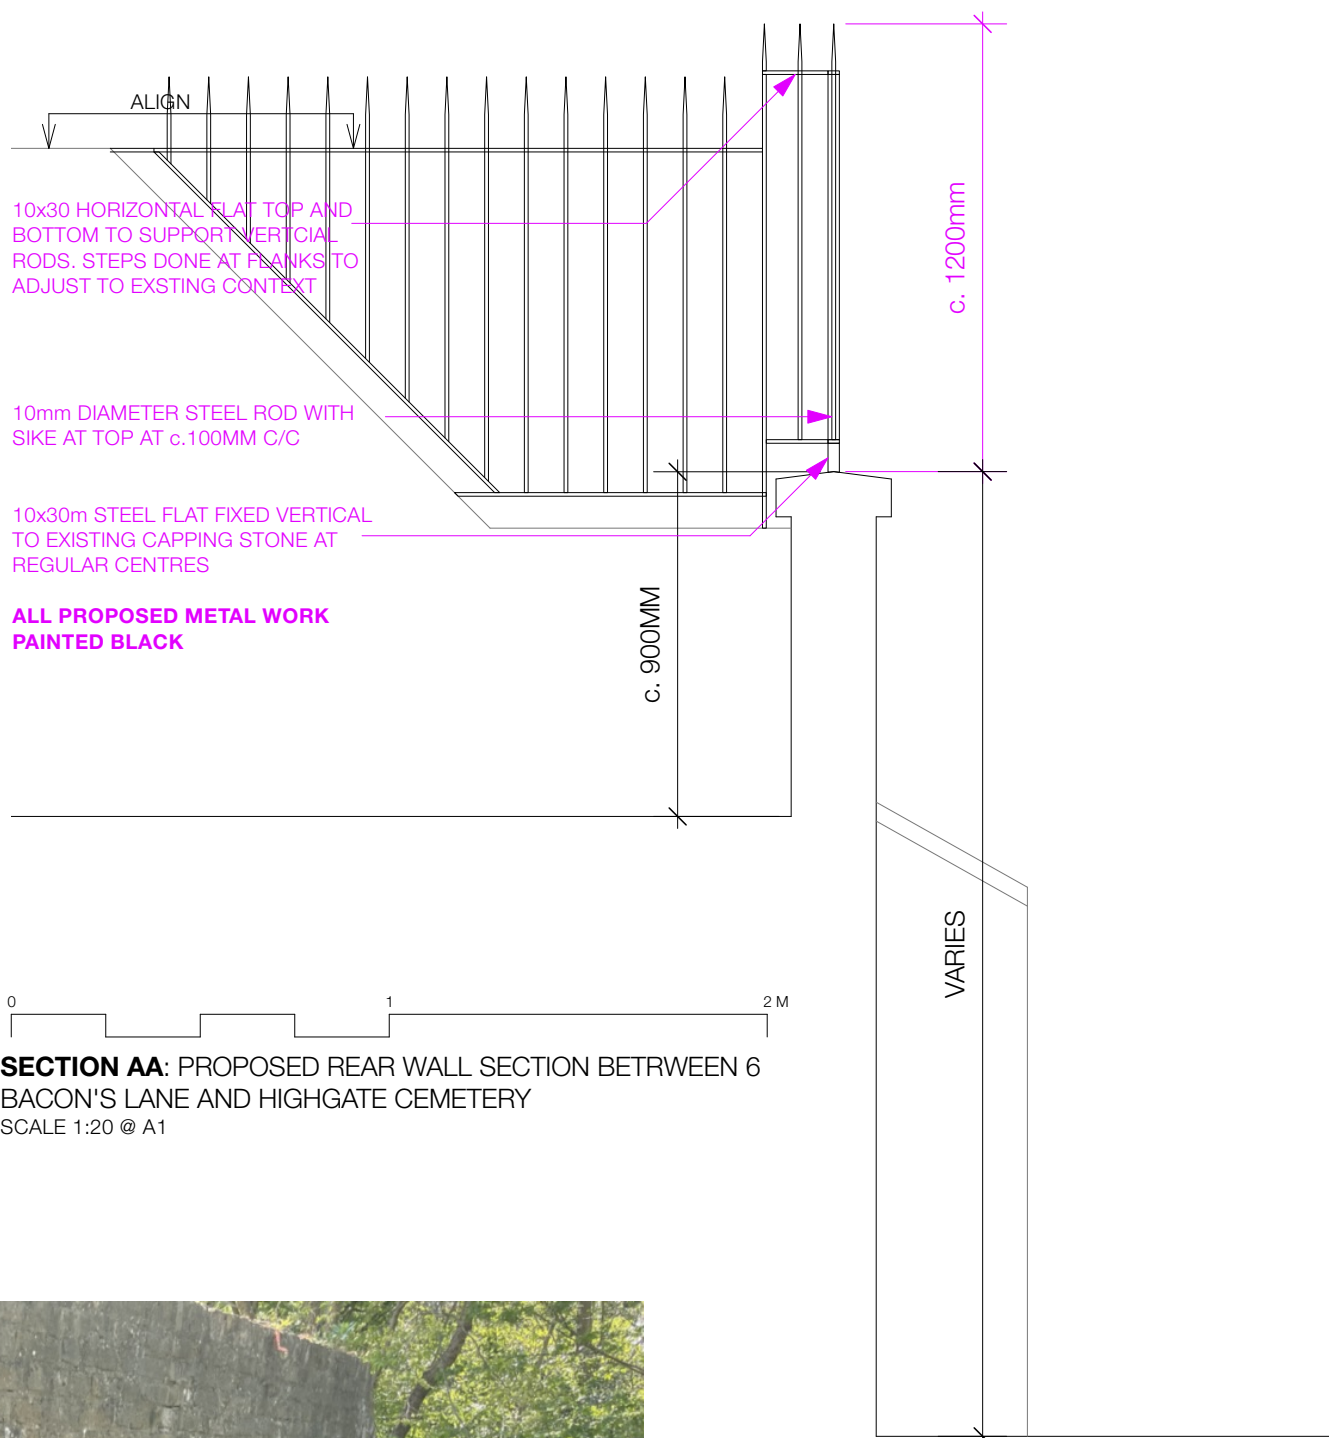

SECTION AA: PROPOSED REAR WALL SECTION BETWEEN 6  
BACON'S LANE AND HIGHGATE CEMETERY  
SCALE 1:20 @ A1

GENERAL NOTE:

PLEASE REFER TO THE  
LISTED BUILDING STATEMENT  
THAT SUPPORTS THIS  
APPLICATION

STATUS: PLANNING  
SCALE: VARIES  
DATE: JUNE 2023

DRAWING NO: 2216-600-Rev B  
TITLE: PROPOSED FRONT GATE & REAR FENCE  
PROJECT: 6 BACON'S LANE