


NOTESORIGINAL A3

DO NOT SCALE FROM THIS DRAWING.
(DRAWING MAY BE SCALED FOR LOCAL AUTHORITY
& PLANNING PURPOSES ONLY)
ALL DIMENSIONS TO BE CHECKED ON SITE .
COPYRIGHT PROTECTED.

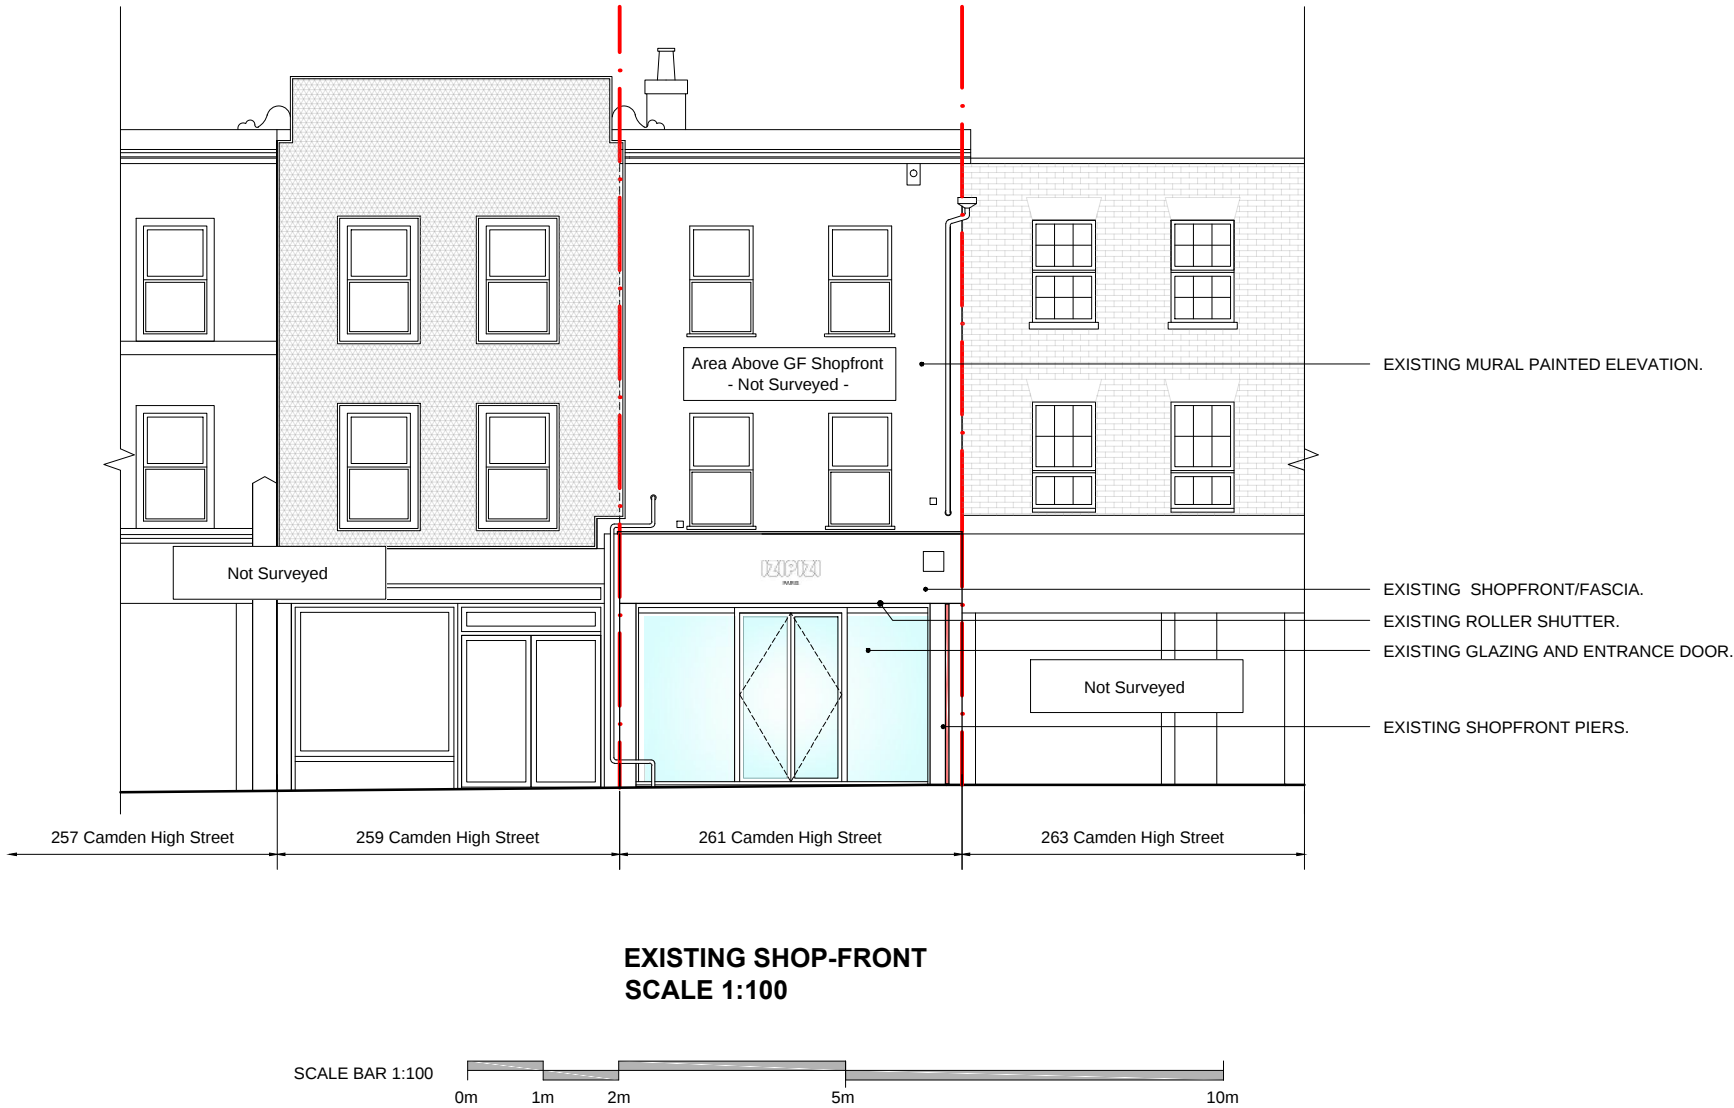

03	12.06.23	New existing set (as-built)	FR
02	12.12.22	External light fittings added	FR
01	07.12.22	Shopfront sill updated	FR
IZIPIZI Paris			
IZIPIZI[®] PARIS			
IDL: Architects LONDON 17 Blackfriars Lane St Paul's, London EC4V 6ER +44 (0)20 7248 1234 PRAGUE The Forum, Fifth Floor, Wenceslas Square 19 Prague, 110 00 +42 (0) 72 0279 588 idl.group Registered in England No.7111665 RIBA Accreditation No.20014346			
Project			
IZIPIZI - 261 Camden High St, NW1 7BU			
Drawing Title			
Existing Front Elevation			
Project No			
22-2531			
Scale @A3		Drawn / Checked	
1:100		FR AP	
File Identifier		[Status-Revision]	
2531-IDL-NA-ZZ-DR-A-06001		[1-03]	
Purpose of Issue			
FEASIBILITY			