


PROPOSED
BASEMENT
FLOOR PLAN - NO CHANGE
1:100

Existing 2nos garages demolished and replaced with new store and garage
- Approved under application 2023/0110/P
Metal framed glazing to new openings within existing.
Ground floor interior layout updated to re-use more of the existing.

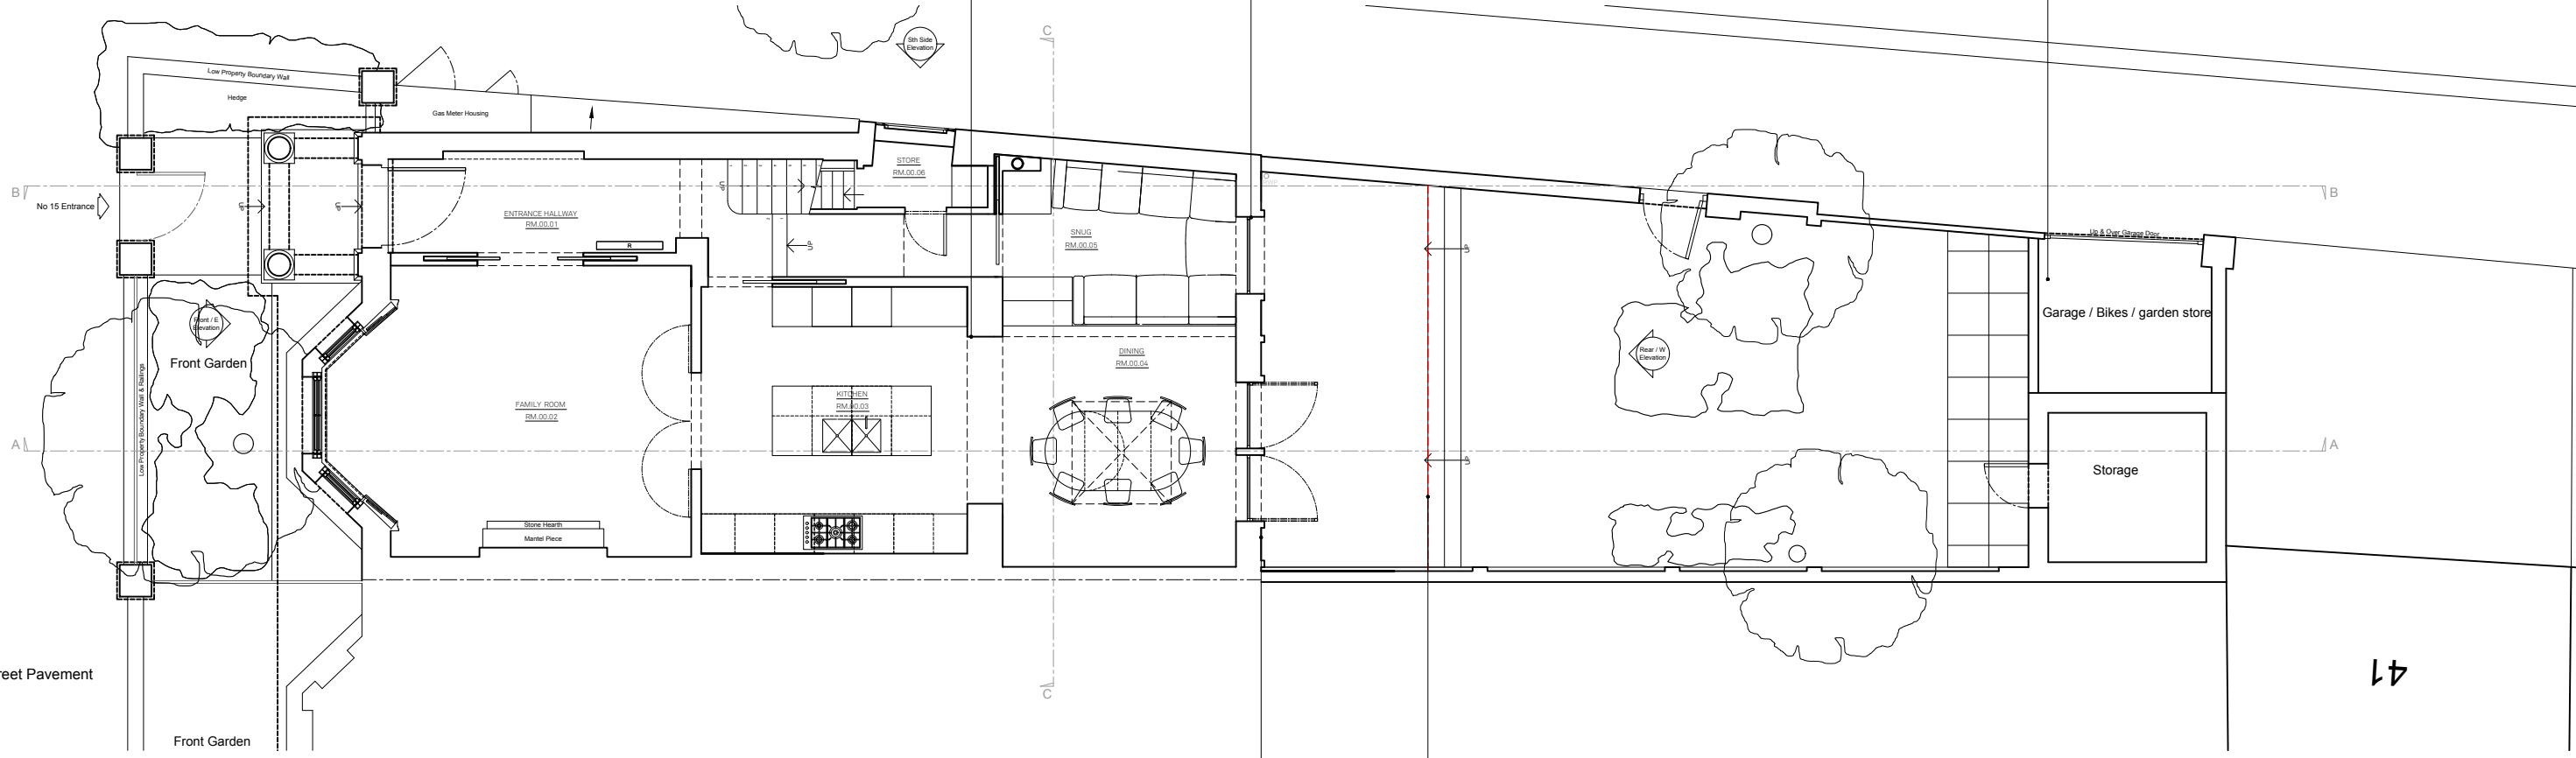

Existing extension to be demolished. Red line to indicate profile of existing. Works covered under application 2023/0110/P
New facade created by adjusting existing walls forming new openings with metal framed glazing
New facade in brick and stone.

PROPOSED
GROUND
FLOOR PLAN
1:100

28/06/23 SC/AM PLANNING
REV DATE DRAWN/CHK DESCRIPTION

LADY MARGARET ROAD
PL100 rev- GROUND FLOOR PLAN

23041 _ PLANNING _ Published 28/06/23



Scale 1:100 @ A3



North

Do not scale for construction. Use figured dimensions only.
All discrepancies to be verified with architect prior to ordering or construction/execution. Confirm all setting out with architect prior to construction. Drawing to be read in conjunction with all other documents. Copyright Architecture for London.

Architecture for London
3-5 Bleeding Heart Yard
London EC1N 8SJ
020 3637 4236
architectureforlondon.com

**Architecture
for London.**