#### **GENERAL NOTES** - FULL DECORATIONS INSIDE & OUT. DULUX DIAMOND MATTE TO ALL WALLS & DULUX DIAMOND EGGSHELL SATINWOOD TO WOODWORK. INCLUDING CELLAR. DULUX SCUFF SHIELD MATTE PAINT TO HIGH IMPACT AREAS. ALLOW TO RETAIN EXISTING TIMBER FLOORING WHERE INDICATED, STRIP AND -RE-STAIN ALLOW FOR NEW FLOORING WHERE INDICATED -ALLOW TO RETAIN EXISTING TIMBER CEILING & BEAMS STRIP WHERE REQUIRED -AND RE-STAIN / PAINT ALLOW FOR 2 NEW INTERNAL WAITER STATIONS AND 1 NEW EXTERNAL WAITER -STATION. ALLOW FOR ADEQUATE POWER AND DATA FOR ALL WAITER STATIONS. ALLOW FOR 1 NEW MEET & GREET STATION -ALLOW FOR NEW IRON MONGERY TO ALL FOH FEATURE DOORS -REMOVE ALL REDUNDANT FANS/GRILLS, BLOCK UP INTERNALLY & EXTERNALLY, INSULATE & MAKE GOOD TO RECEIVE PAINT FINISH. REPLACE ALL CURRENT GRILLS REPLACED & POWDERCOATED TO MATCH CEILING/WALLS - NEW ELECTRICAL BRUSHED BRASS FACE PLATES TO EXISTING SOCKETS THROUGHOUT OMIT ALL SUSPENDED AR11 LIGHT FITTINGS & REPLACE FOR RECESSED. -ALLOW FOR 90% NEW FURNITURE AND 10% RETAINED FURNITURE with 10% -SPECIAL PIECES NEW OVERHEAD HEATERS TO ALL ALL FOH EXTERNAL DOORS -WALL FINISHES NEW FULLY LINED FULL LENGTH WORKING ROMAN BLINDS - FABRIC TO DESIGNERS APPROVAL NEW FULLY LINED FULL LENGTH WORKING PENCIL PLEAT PUDDLE CURTAINS - FABRIC

## TO DESIGNERS' APPROVAL NEW DOUBLE SIDED FULL LENGTH WORKING PENCIL PLEAT PUDDLE CURTAINS - FABRIC TO DESIGNER' APPROVAL

NEW FEATURE WALLPAPER. NOTE HISTORIC FEATURE SUCH AS PANELING & DEORATIVE CORNICE WILL NOT BE COVERED.

NEW FEATURE CEILING WALLPAPER. NOTE HISTORIC FEATURE SUCH AS PANELING & DEORATIVE CORNICE WILL NOT BE COVERED.

**—————** 3/4 HEIGHT FEATURE TILING

FULL HEIGHT FEATURE TILING

# WHITE/GREY ROCK

ALLOW 70% EXISTING POSITIONS WITH 30 % NEW POSITIONS.

FULL NEW DECORATIVE LIGHTING SCHEME

ALLOW FOR 1NO. OVER DOOR HEATER TO MAIN ENTRANCE EXTERNAL DOOR

## MINIMUM SECURITY REQUIREMENTS

M&B LEGAL NOTICES AND CAR PARK/GARDEN NOTICES REQUIRED AS PART OF NEW SIGNAGE PACKAGE;

CARPARK FOLIAGE TO BE TRIMMED

## THE HALL

- MAINTAIN EXISTING TIMBER FLOORING WHERE INDICATED. TO BE SANDED & STAINED TO MATCH NEW TIMBER FLOORING.

- ALLOW FOR NEW FEATURE CEILING WALLPAPER WHERE INDICATED.
- ALLOW FOR NEW FEATURE WALLPAPER WHERE INDICATED.

1 - NEW LOGO ENTRANCE MATTING SET WITHIN BRASS THRESHOLD WITH FEATURE TILED SURROUND

1A - COIR MATTING TO THIS AREA, <u>LOGO MATTING</u> WITH BRASS THRESHOLD 2 - MAINTAIN EXISTING ENTRANCE DOORS, PAINT/STAIN FINISH . ALLOW FOR NEW OVERSIZED IRONMONGERY.

3 - MAINTAIN EXISTING INTERNAL LOBBY DOORS (PAINT/STAIN FINISH) & ALLOW FOR NEW OVERSIZED IRONMONGERY

4 - ALLOW FOR MANDARIN FEATURE IRONMONGERY & DOOR KNOCKERS TO MAIN ENTRANCE INTERNAL LOBBY DOORS ONLY.

5 - ALLOW FOR NEW VINYL LOGO MANIFESTATIONS TO ALL OUTER AND INNER LOBBY DOORS BY SIGNAGE COMPANY

6 - NEW MEET & GREET UNIT.

## 7 - NEW WAITER STATION.

8 - ALLOW FOR NEW GREASEPROOF MATTING TO KITCHEN EXIT.

9 - ALLOW FOR NEW STAINED SOLID TIMBER IN/OUT KITCHEN DOOR.10 - ALLOW FOR NEW STAINED SOLID TIMBER DOORS TO LADIES POWDER AND DISABLED TOILET.

#### THE GREAT ROOM

- RETAIN EXISTING FLOORING WHERE POSSIBLE, TO BE SANDED AND STAIN - ALLOW FOR FEATURE WALLPAPER WHERE INDICATED

13 - FLOOR IN BAY WINDOW AREA TO BE RAISED TO CREATE A LEVEL FLOOD THROUGHOUT. NEW TIMBER TO BE ALLOWED FOR TO MATCH EXISTING IN T AREA. TRY TO REUSE EXISTING WHERE POSSIBLE.

18 - ALLOW FOR LARGE FREESTANDING SECTION OF FIXED SEATING OPPOS FIRE, TO BE PROVIDED BY FIXED FURNITURE SUPPLIER.

#### THE CURATOR SPACE IN THE GREAT ROOM

20 - FLOOR TO THIS AREA TO BE LOWERED TO CREATE A LEVEL FLOOR THROUGHOUT. NEW TIMBER TO BE ALLOWED FOR TO MATCH EXISTING IN T AREA. TRY TO REUSE EXISTING WHERE POSSIBLE.

21 - ALLOW TO BLOCK UP/ BOARD OVER EXISTING DOOR.

22 - REMOVE STUD WALLS TO THIS AREA.

23 - ALLOW FOR NEW MANDARIN STANDARD SHELVING DISPLAY/ BOOKCASI ENSURE THIS IS LIT.

### THE CONNOISSEUR CLUB

- ALLOW FOR NEW WALLPAPER WHERE INDICATED

25 - NEW TIMBER FLOORING WHERE INDICATED (PART OF FMR)

27 - NEW FEATURE TILED FIREPLACE HEARTHS

28- MOVE FIREPLACE SURROUND FROM THE GALLERY (BEHIND NEW BOOTH TO FIREPLACE TO LHS OF BAR

29 - NEW FEATURE WAITER STATION IN PAINTED TIMBER FINISH

30 - REMOVE EXISTING TILES AND REPLACE WITH NEW FEATURE TILE AS INDICATED.

31 - REMOVE ALL EXISTING FIXED SEATING FROM THIS ROOM

34 - ALLOW TO REMOVE EXISTING DRINKS SHELF AND BOXING AROUND THI WALL

35 - ALLOW FOR NEW SECTION OF GREASEPROOF MATTING TO KITCHEN IN DOORS.

36 - ALLOW FOR NEW SOLID TIMBER STAINED IN/OUT KITCHEN DOOR.

### BAR SERVERY

37 - NEW ALTRO FLOORING TO BACK BAR (PART OF FMR)

42 - NEW VERSITAL TOP WITH CHUNKY TIMBER FEATURE EDGING AND LED STRIP LIGHTING TO FRONT BAR

43 - RETURN EXISTING FRONT BAR TO ALLOW SPACE TO RELOCATE GLASS WASH. REPLICATE BAR FRONT ACROSS THIS NEW SECTION.

44 - MAINTAIN FRONT BAR FRONTAGE AND ALLOW TO PAINT OR STAIN AS APPROPRIATE. REPLICATE THIS FRONTAGE ACROSS NEW SECTION OF BAR


NOTED ABOVE. 46 - ADD OVER BAR GLASS RACKING IN BRUSHED BRASS FINISH TO DISPEN BAR.

47 - ADD BRASS MESH SCREEN TO SCREEN OFF GLASS WASH AREA

47a - REMOVE SECTION OF BAR AND ADD HATCH TO COUNTER TOP TO ALLO ACCESS OUT TO KITCHEN


49 - ALLOW FOR NEW UPPER BACK BAR DESIGN, REMOVING CHAMFERED
CORNER DESIGN AND SQUARING OFF THIS AREA AS SHOWN. INCLUDE FOR
CONCEALED LED LIGHTING. INCLUDE FOR NEW ILLUMINATED BOTTLE STEPS
53 - RETAIN, STRIP AND RESTAIN BACK BAR TOP. ALLOW FOR NEW SECTION OF
BACK BAR TOP WHERE LAYOUT IS RECONFIGURED.

R

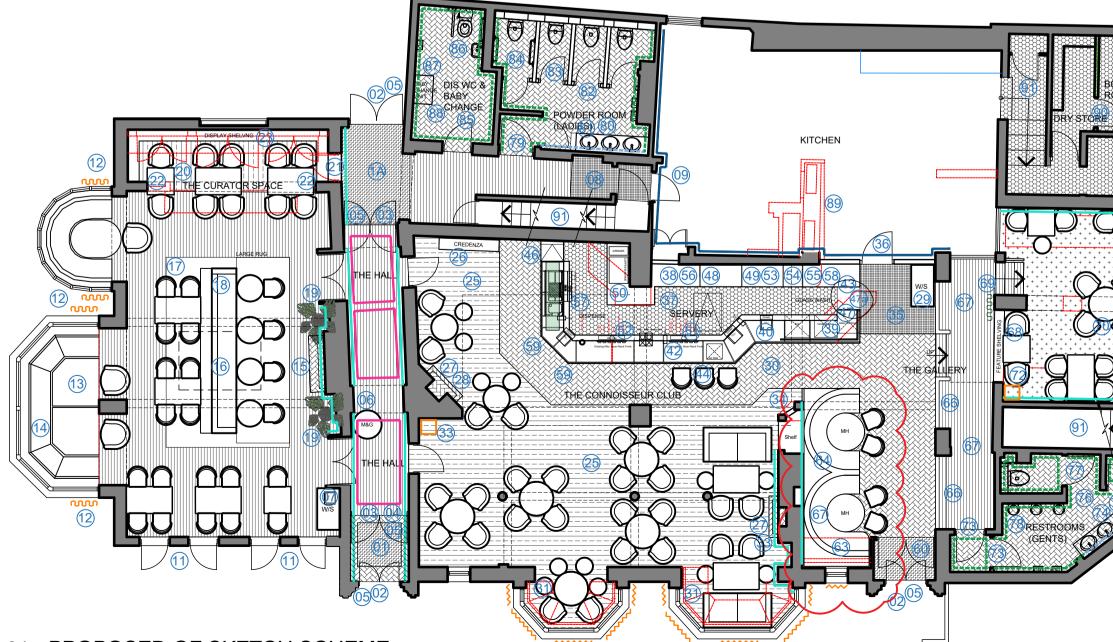

01 - PROPOSED GF SKETCH SCHEME Scale: 1:100 @ A1

	INE GALLERT
	- RETAIN EXISTING TIMBER FLOORING WHERE INDICATED
	60 - COIR MATTING TO THIS AREA, LOGO MATTING
ROOM	61 - ALLOW FOR TWO NEW MID HEIGHT FREESTANDING BOOTH SEATS NOTE: THESE ARE NOT TO ALTER THE EXISTING FABRIC OF THE BUILDING. FIREPLACE TO REMAIN IN SITU
	63 - ALLOW FOR FEATURE PANELING WALLPAPER WHERE INDICATED
	66 - ALLOW TO RE-DEC EXISTING BALLUSTRADE
NED.	
	THE NICHE
)R THIS	- ALLOW FOR FEATURE WALLPAPER WHERE INDICATED
	- ALLOW FOR NEW CARPET IN THIS AREA
SITE	68 - ADD <del>MANDARIN</del> MINERVA STANDARD FEATURE 2 SIDED BOOKCASE. ENSURE THIS IS LIT
	<del>70 - ALLOW FOR NEW FIXED SEATING</del>
	71 - REMOVE BEAMS FROM THE CENTRE OF THE ROOM AND ADD A STEEL BEAM IN THEIR PLACE AT HIGH LEVEL TO OPEN UP THE ROOM
THIS	GENTS RESTROOM
	- ALLOW FOR NEW TILING WHERE INDICATED
-	73 - ALLOW FOR NEW SOLID TIMBER STAINED DOOR TO GENTS ENTRANCE AND NEW IRONMONGERY TO ALL TOILET DOORS
SE.	76 - NEW FEATURE TILED FLOORING THOUGHOUT TO MANDARIN STANDARD
	77 - ALLOW FOR NEW CUBICLE DOORS AND NEW ASSOCIATED IRONMONGERY
	LADIES POWDER ROOM
	- ALLOW FOR NEW TILING WHERE INDICATED
	79 - ALLOW FOR NEW SOLID TIMBER STAINED DOOR TO LADIES ENTRANCE AND NEW IRONMONGERY TO ALL TOILET DOORS
HS)	82 - NEW FEATURE TILED FLOORING THOUGHOUT TO MANDARIN STANDARD
	83 - ALLOW FOR NEW CUBICLE DOORS AND NEW ASSOCIATED IRONMONGERY
	84 - ALLOW FOR NEW TIMBER VENEER CUBICLES WITH MOLDING DETAILS
	DISABLED W/C
IS	- ALLOW FOR NEW TILING WHERE INDICATED
	- NEW FEATURE TILED FLOORING THOUGHOUT TO MANDARIN STANDARD
NOUT	85 - ALLOW FOR NEW SOLID TIMBER STAINED DOOR TO LADIES ENTRANCE AND NEW IRONMONGERY TO ALL TOILET DOORS
	KITCHEN & BOH
	- EXISTING KITCHEN FLOOR TO BE MAINTAINED AND CLEANED
	89 - REMOVE WALLS TO KITCHEN IF POSSIBLE - CONSULT STRUCTURAL
	ENGINEER. NOTED - SERVICES LOCATED IN BOXING, MC TO INVESTIGATE WHETHER THESE CAN BE RELOCATED/ REMOVED. ALLOW FOR ALTRO
6	FLOORING TO PATCH IN WHERE NECESSARY.
	90 - ALLOW FOR NEW FLOORING AND SHELVING TO WALK INS. SKIRT TO BE REPAIRED IN HERE.
RAS	
	HIMO ACCOMMODATION (FIRST FLOOR)
NSE	- REDEC CORRIDORS & MAKE GOOD WALLPAPERED AREAS
	- LOCK REQUIRED TO INTERNAL DOOR FOR SEPARATE ACCESS
-OW	
2	
R 28	
0	

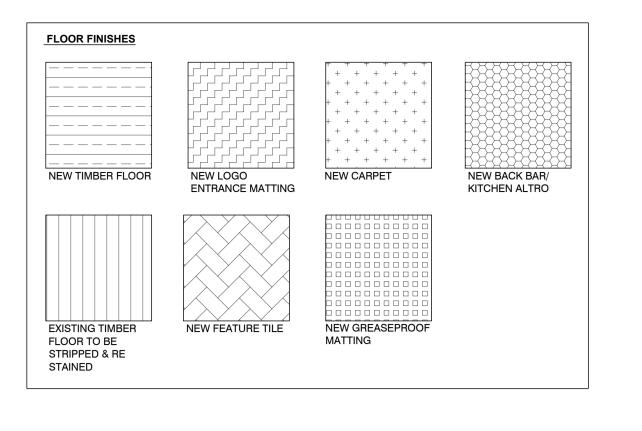

	EXISTING	PROPOSED
EDA INT	231	234
COVERS INT	117	122
COVERS EXT	84	116
TOTAL	201	238
PARKING	41	41
DIS PARKING	3	3
TOTAL	44	44

R3 R2 R1 /	AMENED NOTES IN RED. OMITTED WORKS TO BAY WINDOWS AMENDMENTS IN RED FIRST ISSUE	04.08.23 14.04.23 03.04.23 22.12.22	AM AM MT ERB				
DIME	DO NOT SCALE. WRITTEN DIMENSIONS TO BE USED IN PREFERENCE TO SCALED DIMENSIONS. ALL DIMENSIONS TO BE CHECKED ON SITE BY CONTRACTOR & ALL DISCREPANCIES TO BE REPORTED TO JMDA						
JOB -	JOB TITLE						
ТН	MITCHELLS & BUTLERS THE OLD BULL & BUSH HAMPSTEAD, LONDON, NW3 7HE						
DRAV	DRAWING TITLE						
INT	INTERNAL WORKS - PLANNING						
DRAV	DRAWING NUMBER						
JM	JMDA_1652_PL_004_R3						
	scale 1:100 @ A1						
	DATE 22.12.2022						
	DRAWN BY ERB						
	JMDA LTD 2 The Holmes Skipwith, York, YO8 5SL T: 01757 288 399 info@jmdaltd.co.uk www.jmdaltd.co.uk						