

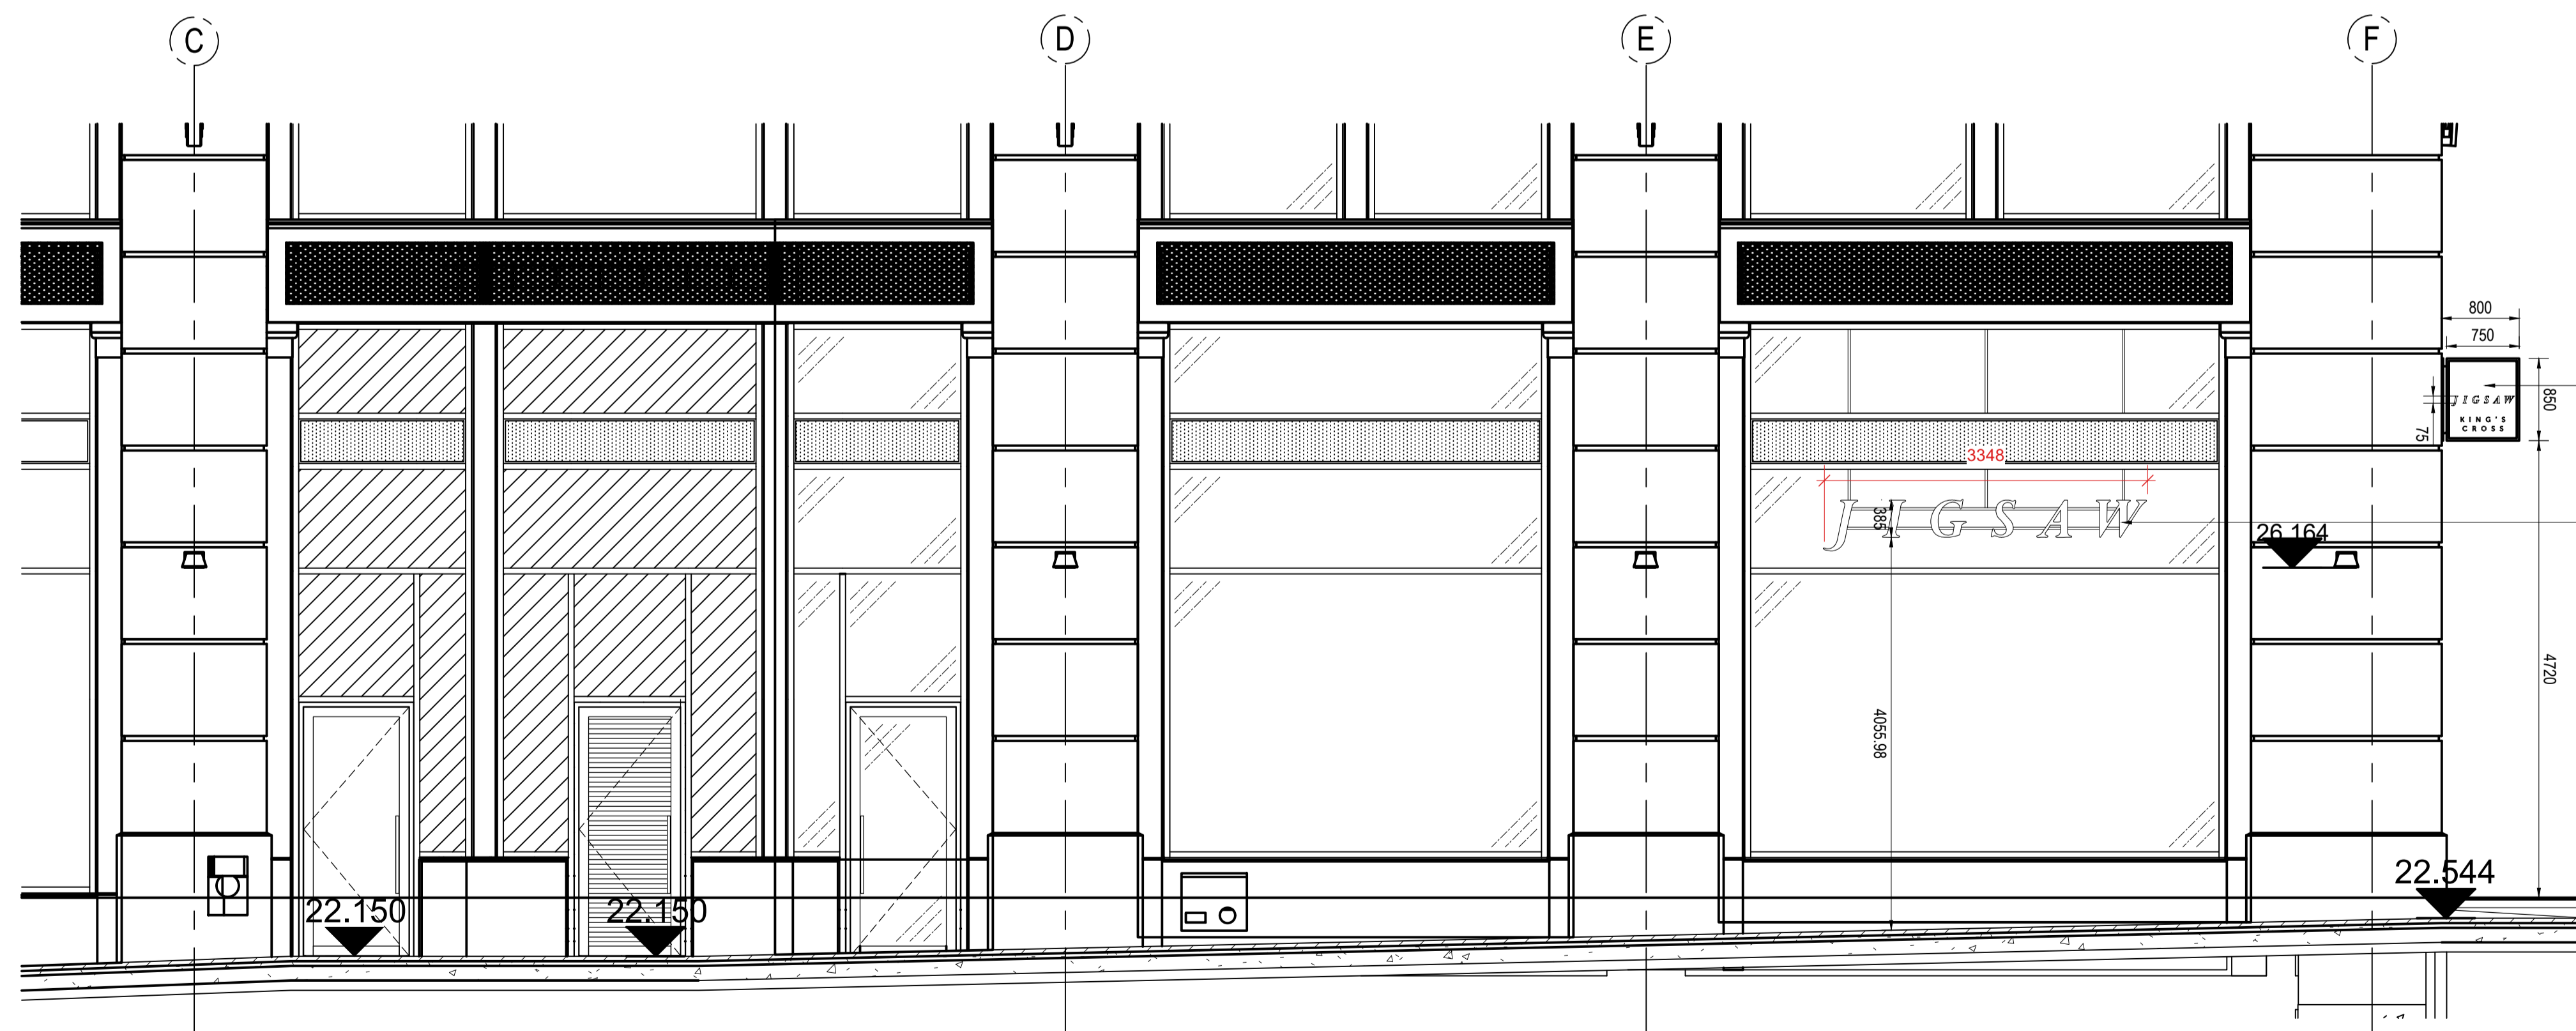


AS-BUILT FRONT ELEVATION - VIEW A
SCALE 1:50

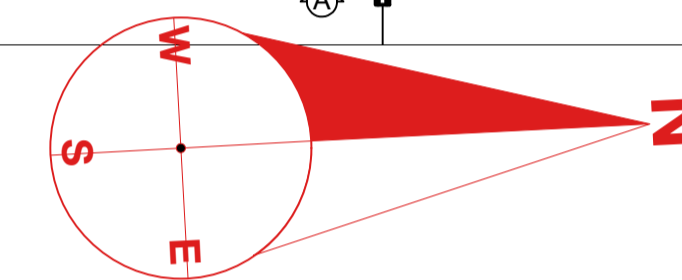

AS-BUILT FRONT ELEVATION - VIEW B
SCALE 1:50

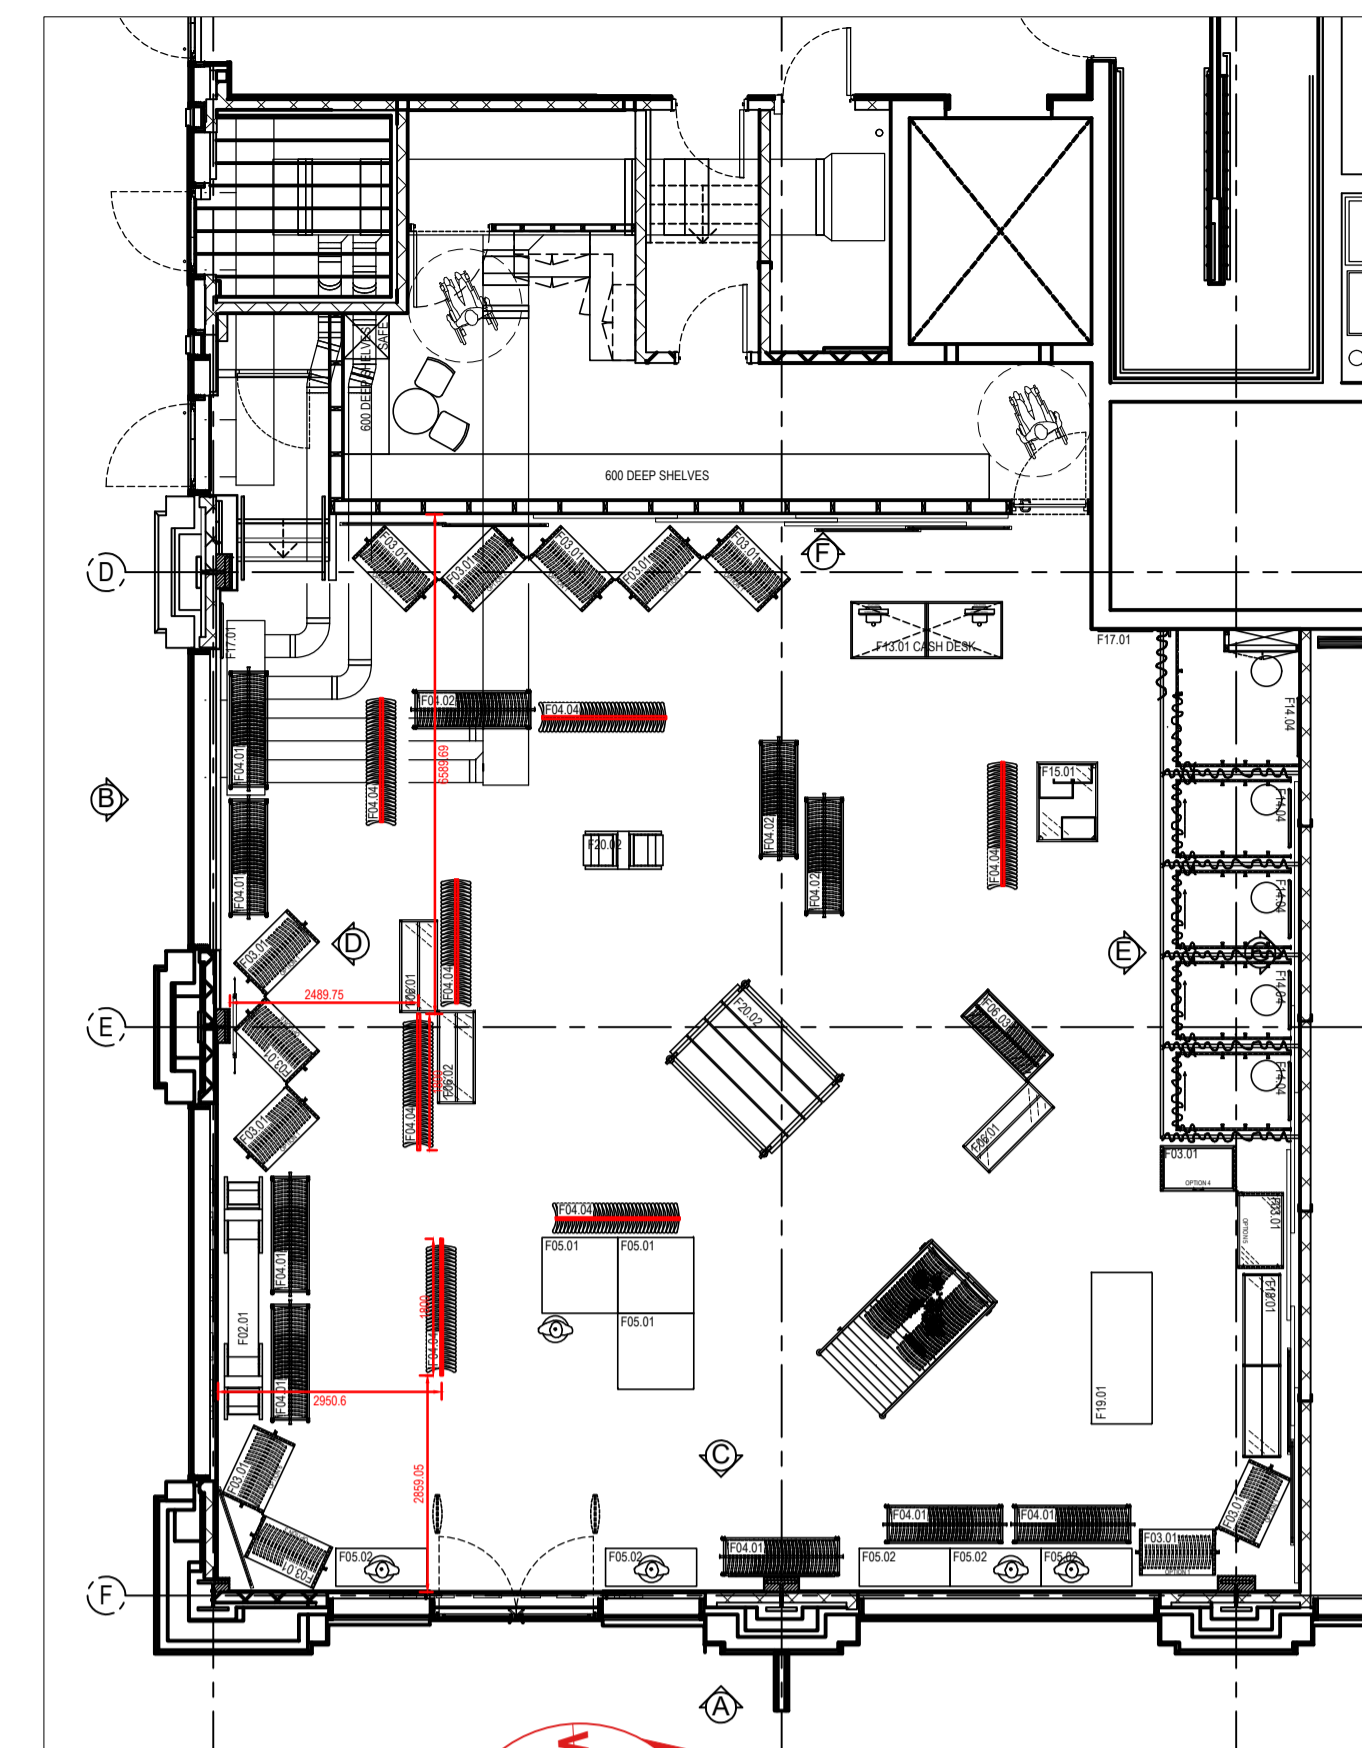

ALL DIMENSIONS IN MILLIMETRES.
ONLY ANNOTATED DIMENSIONS SHOULD BE FOLLOWED. DO NOT SCALE FROM THIS DRAWING.
ALL DIMENSIONS ARE FINISHED SIZES.
MANUFACTURERS/CONTRACTOR SHOULD ENSURE THAT ALL MATERIALS & CONSTRUCTION METHODS SHOWN ARE COMPLIANT WITH BUILDING REGULATIONS, LANDLORDS, OR LOCAL REGULATIONS IN FORCE AT THE TIME. ANY DISCREPANCIES OR CONCERNS SHOULD BE REPORTED TO CHECKLAND KINDLEYSIDES.
CONTRACTORS SHOULD MANAGE & MONITOR THE MANUFACTURE OR CONSTRUCTION WORKS DESCRIBED IN THESE DRAWINGS TO ENSURE IT IS CARRIED OUT WITHOUT RISKS TO HEALTH & SAFETY.

THIS DRAWING IS THE COPYRIGHT OF CHECKLAND KINDLEYSIDES LTD.
THIS DRAWING CANNOT BE COPIED, REPRODUCED OR DISCLOSED TO ANY UNAUTHORISED PERSON.

F.O.H AREA	B.O.H AREA	TOTAL AREA
196m ²	36.8m ²	232.8m ²

GENERAL NOTES:

SAFETY, HEALTH & ENVIRONMENTAL INFORMATION

In addition to the risks normally associated with the types of works detailed on this drawing note the following risks & information

ENVIRONMENT

WORKING AT HEIGHT

- Ensure that works at height are properly planned & carried out by people with skills, knowledge & experience to carry out the job. Use the right type of equipment for working at height.

FIXTURES & FITTINGS

MATERIAL SPECIFICATION

- Materials selected to be fit for purpose - weather proof and sealed from water ingress

FIXING

- Fixing method & materials to be secure & suitable for substrate

ITEMS FALLING FROM HEIGHT

- Ensure that the pavement area is fully cordoned off during installation

It is assumed that all works will be carried out by a competent contractor, maintained & operated by competent experienced staff, used only for the purpose it is designed for.

REV.	DESCRIPTION	INT.	DATE

checkland kindleysides

Leicester Studio
Charnwood Edge
Cossington
Leicester LE7 4JZ
+44 (0)16 2644 700

London Studio
2 Compton Courtyard
40 Compton Street
London EC1V 0BD
+44 (0)16 2644 700

www.checklandkindleysides.com

CLIENT

JIGSAW

PROJECT

KINGS CROSS NEW STORE

SITE ADDRESS

UNIT 2
ZONE B
3 PANCRAS SQUARE

CK PROJECT No.	DWG No.	REV.	DATE
29402	A08.01	.	02.10.17

DWG TITLE
AS-BUILT SHOPFRONT ELEVATIONS 1:50
EXISTING FACADE PRE-OFFSPRING WORKS
SEABROOK STUDIO MARK UP - 2023_07_04

CK WORKSHOP No.	DRAWN BY	SCALE	A1
29403	SJL	1:50	A1

Drawings by Others - Scale Bar Added by Seabrook Studio Ltd



Scale: 1:50 @ A1
Note: Drawing scaled from PDF import - check all dims on site.