

Notes:

Existing Retail Units

Existing Ground Floor Retail Units NIA: 568sqm

New Void to Ground Floor slab

New Void NIA: 4.6sqm

As built plans provided by Lazari (Landlords)

A	20/06/2023	Notes added	EW
Rev.	Date	Details	By

Client  
Bauer Media

Project Name  
The Lantern (Main)


Drawing Title  
Proposed Ground Floor

Status  
Planning

Scale	Drawn by
As indicated@ A1	EW
Date	Checked by
20/06/2023	JN
Drawing Number	Revision
20122-PL-007	A

This drawing is copyright. Do not scale off dimensions.  
All dimensions are to be checked on site by contractor.  
Contractor to report any dimensional discrepancies, errors  
or omissions prior to commencing in site.

18 Wenlock Road, London N1 7TA | spacelab.co.uk

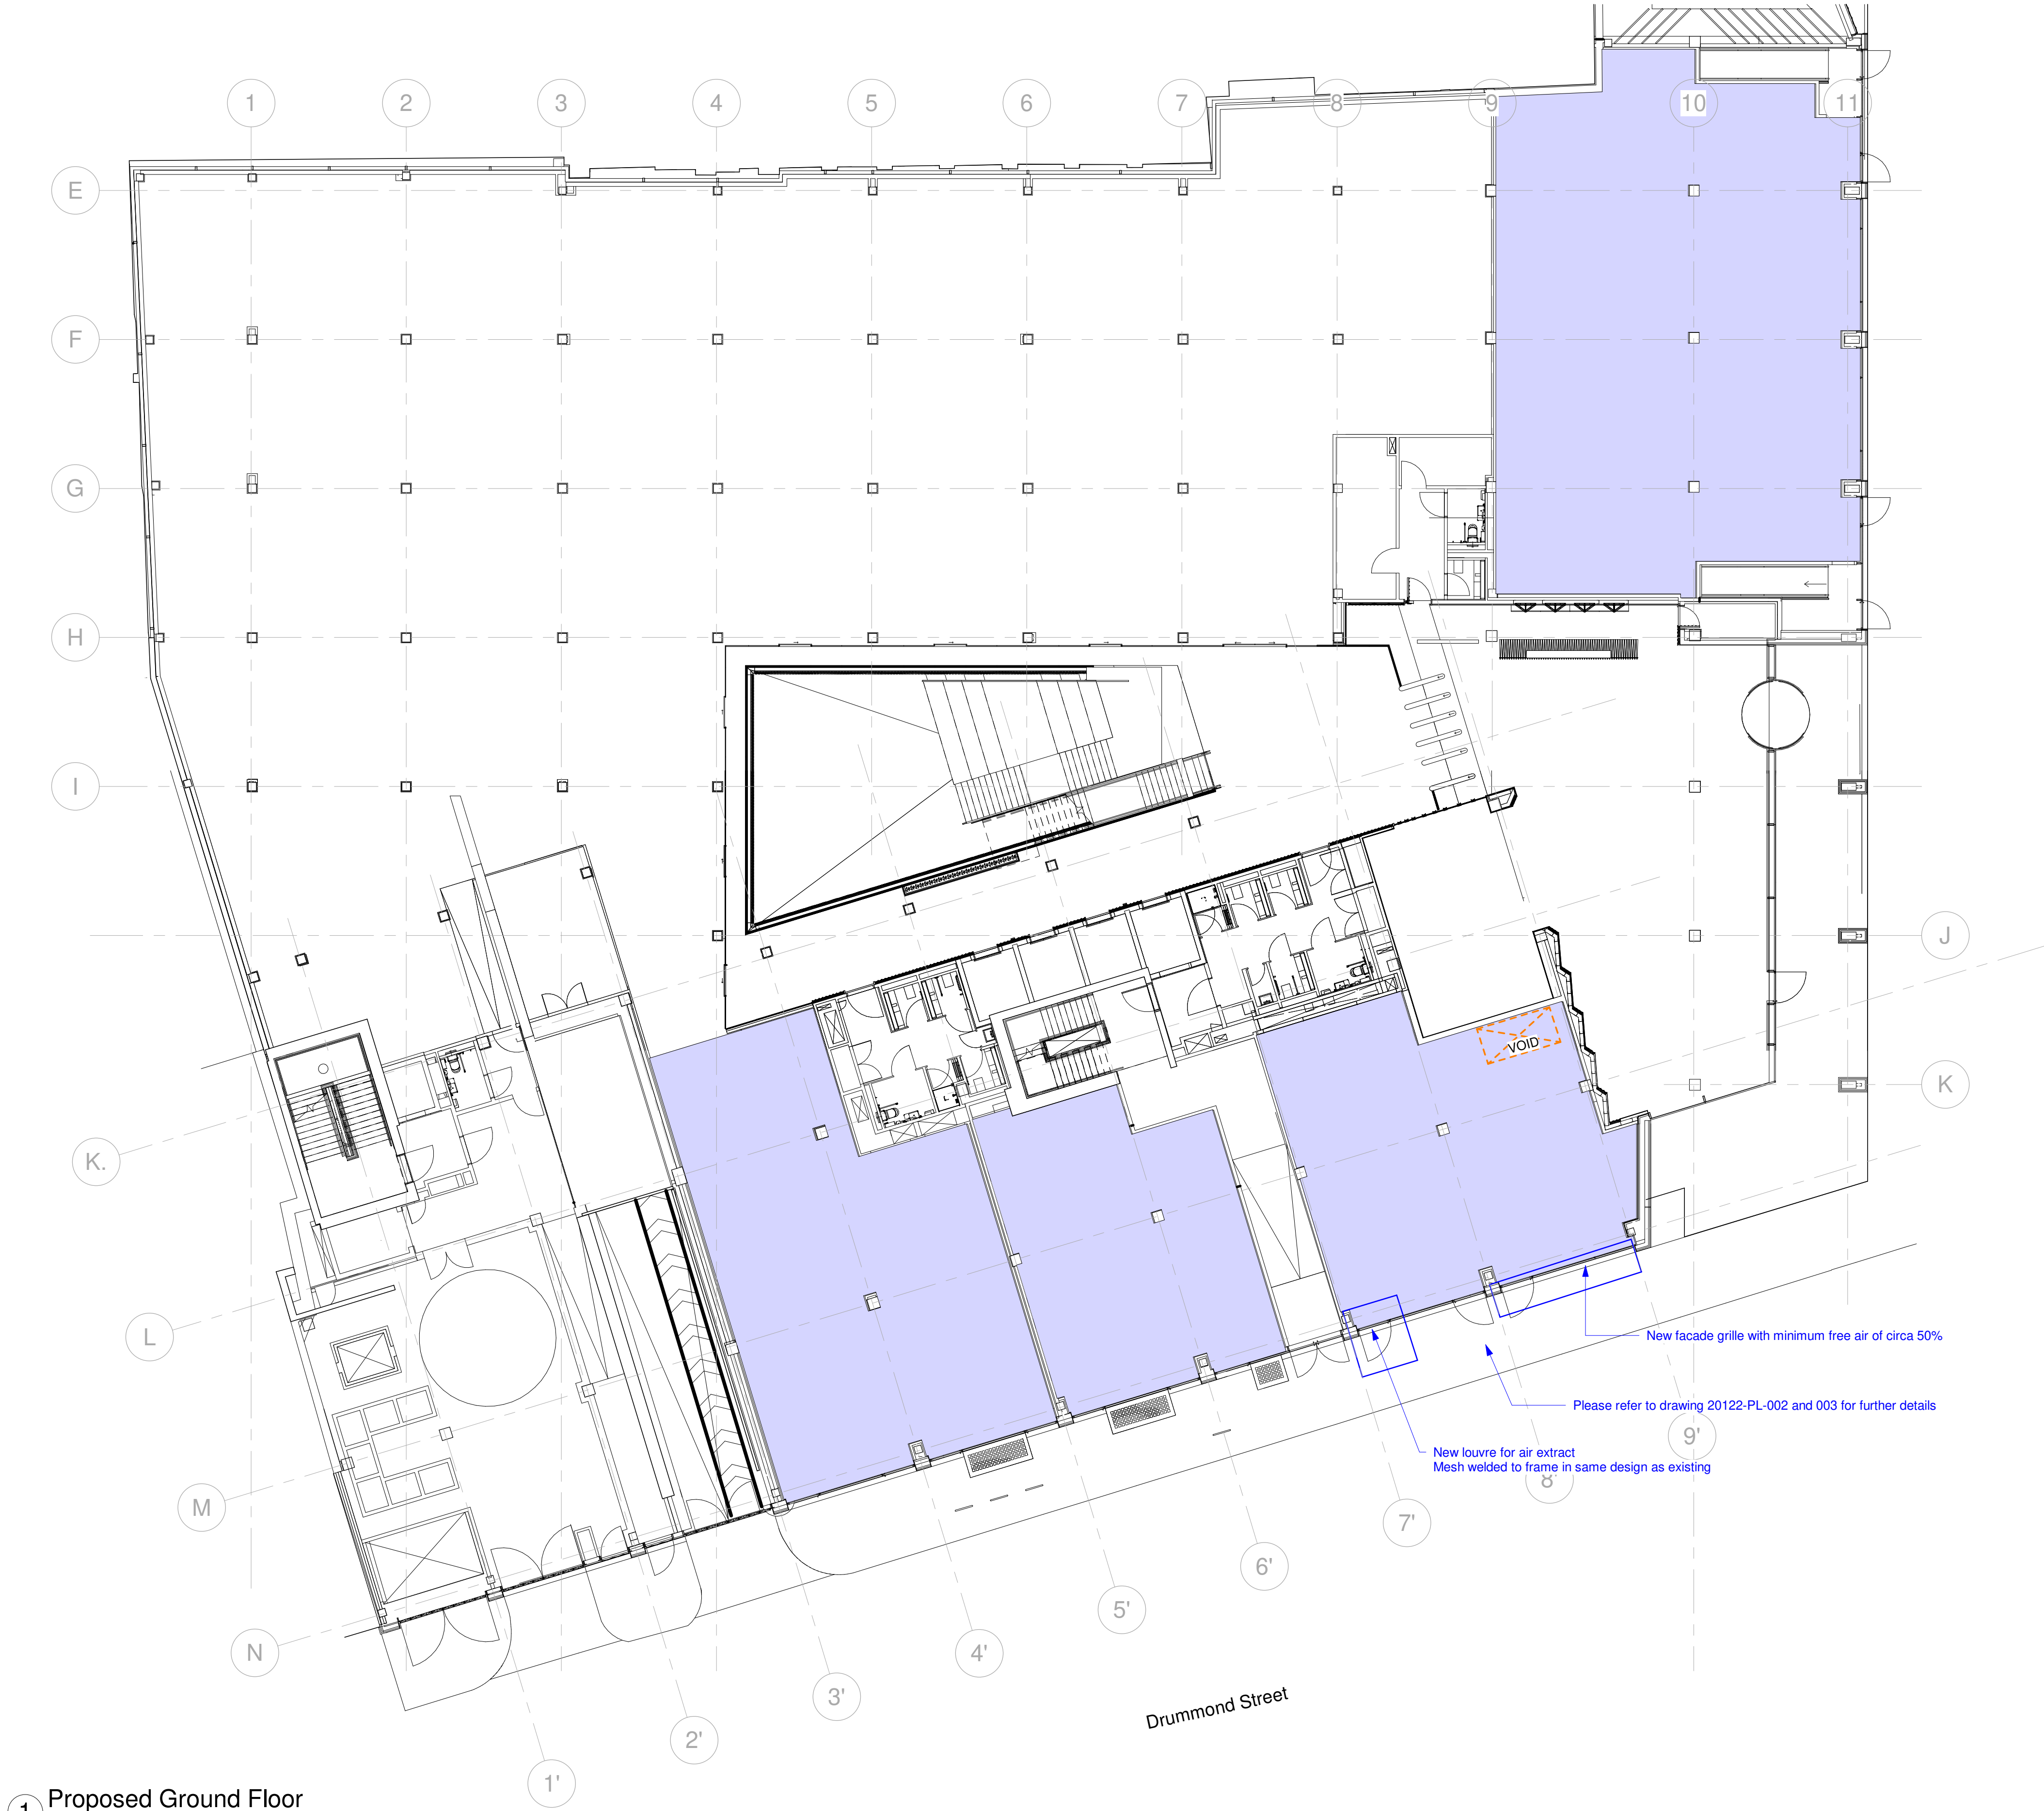

1 Proposed Ground Floor

Scale 1 : 150

