

Notes:

Existing Retail Units

Existing Lower Ground Floor Retail Unit NIA: 306sqm

New Void to Ground Floor slab

New Void NIA: 4.6sqm

As built plans provided by Lazari (Landlords)

A	11/08/2023	Room Names Added	EW
Rev.	Date	Details	By

Client

Bauer Media

Project Name

The Lantern (Main)

Drawing Title

Proposed Lower Ground Floor


Status

Planning

Scale	Drawn by
As indicated@ A1	EW
Date	Checked by
20/06/2023	JN
Drawing Number	Revision
20122-PL-006	A

This drawing is copyright. Do not scale off dimensions. All dimensions are to be checked on site by contractor. Contractor to report any dimensional discrepancies, errors or omissions prior to commencing in site.

18 Wenlock Road, London N1 7TA | spacelab.co.uk

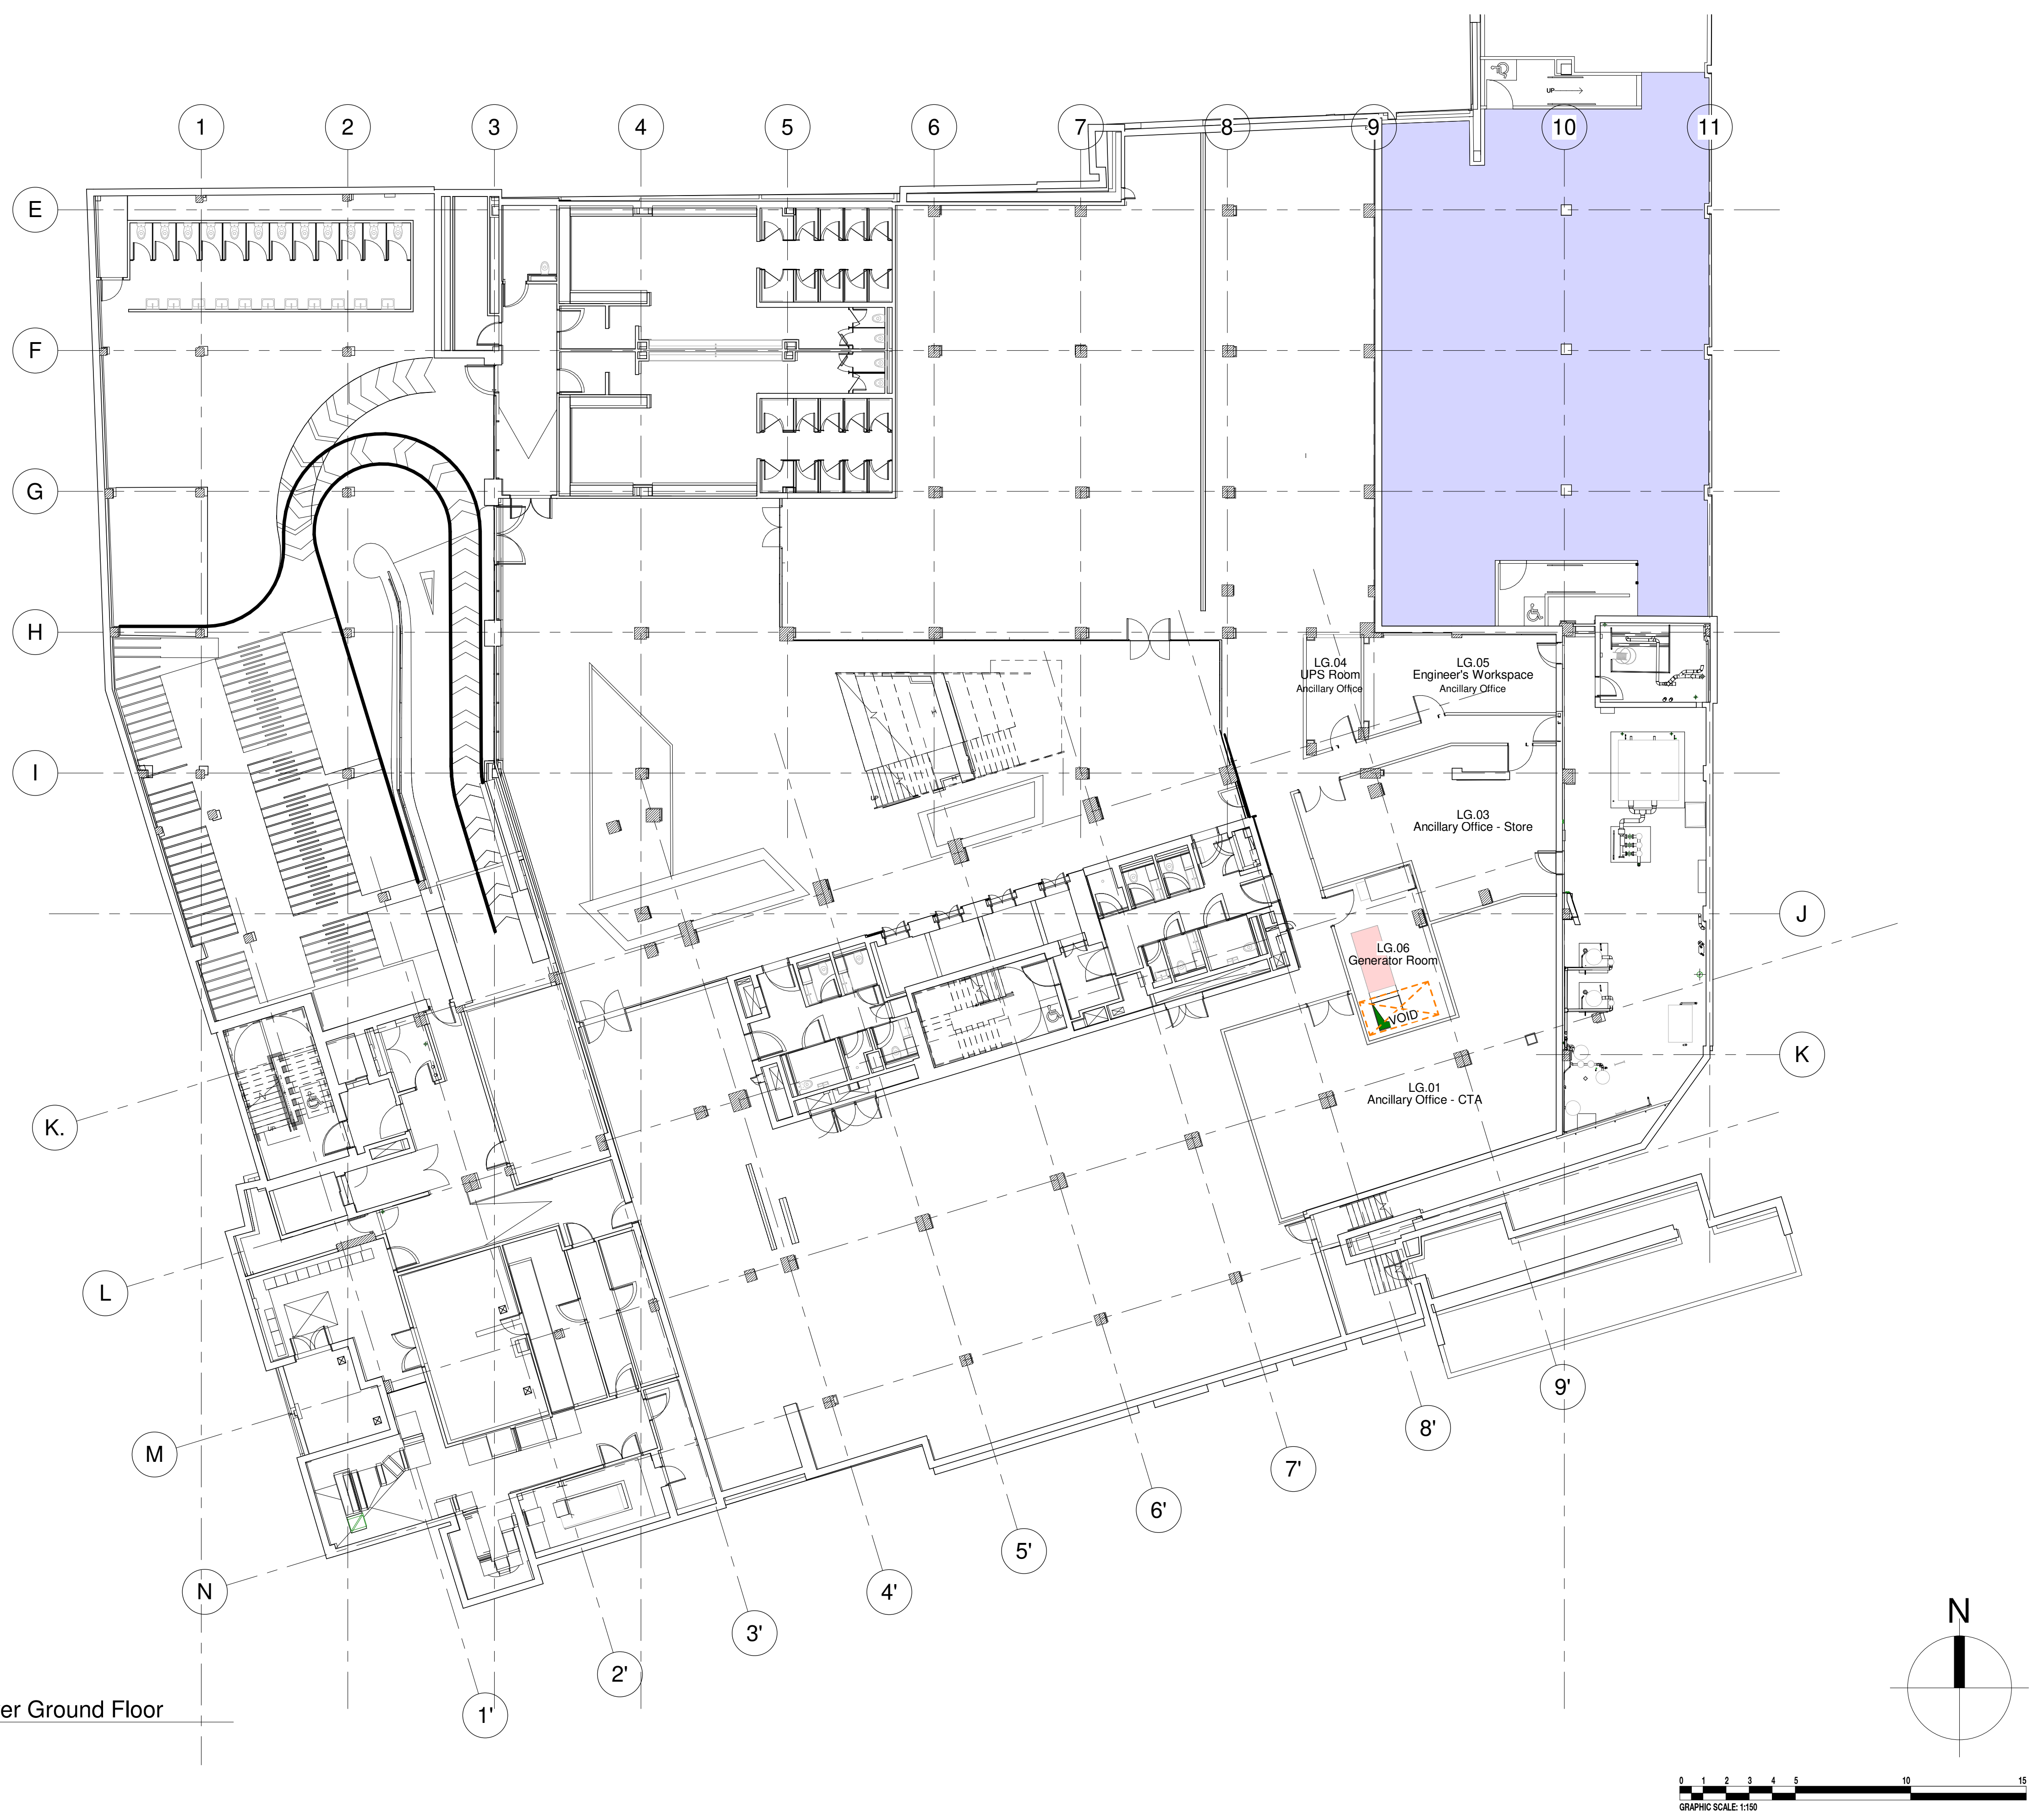

1 Proposed Lower Ground Floor

Scale 1 : 150