

Notes

Do not scale, use figured dimensions only.

All dimensions to be verified on site prior to the commencement of any work or the production of any shop drawing. All discrepancies to be reported to the Architect.


This drawing is to be read in conjunction with all related Architect's and Engineer's drawings and any other relevant information.

This drawing is copyright © of TDC Architects Ltd.


REV	DATE	REVISION	INITIALS	CHECK
A	18.08.23	PLANNING ISSUE Minor amendments in accordance with LPA: triangular entrance planter omitted, material of planters amended, as clouded	NS	SEL



**Floor Finish Type 1 - Entrance Paving**  
600 x 600mm Porcelain Outdoor Slab Tiles, non - slip.  
Colour - Anthracite

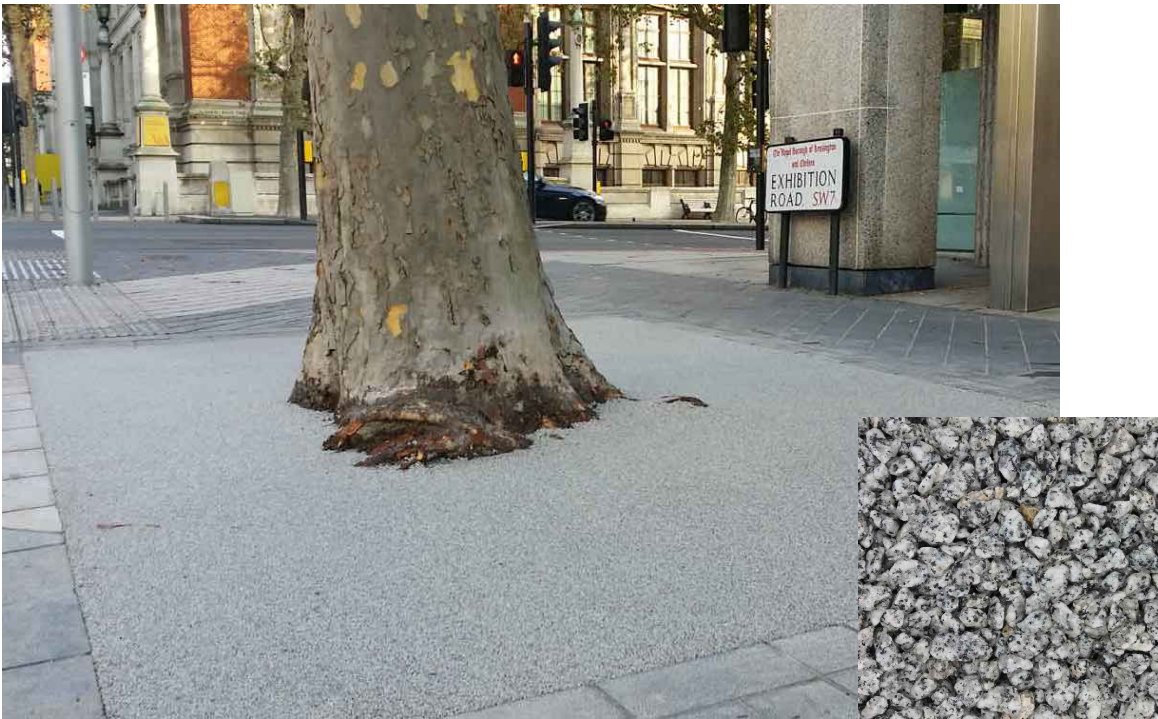

**Floor Finish Type 2 - Resin Bound Surface**  
Addastone TP Tree Pit surfacing, permeable  
Colour - Silver Grey

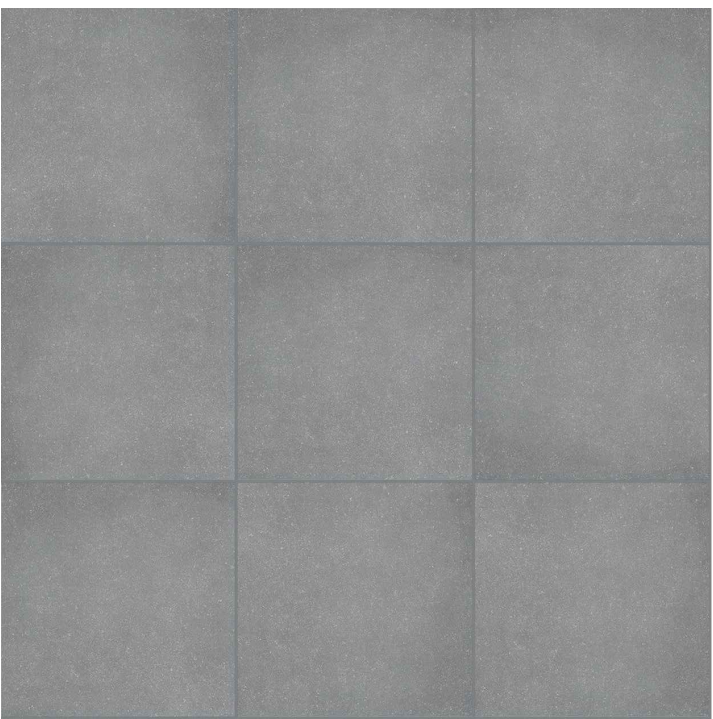

**Entrance Wall Finish**  
Large format porcelain wall tiles, 600 x 600mm - by Brick-Clad or similar approved  
Colour - Dark Stone / Slate



**Entrance Ramp Gravel Border**  
Slate chippings with LED uplighters embedded into channel at 1.8m intervals




**Entrance Wall Capping**  
Eurodec 50mm Flat Concrete Coping Stone  
Colour - Slate



**Corten Steel Box Planter**  
3 no. raised box planters to boundary, with herbaceous plants to Landscape design, by Yark Garden Style or similar approved.



**Lattice Wall Trellis**  
Agriframes geometric wall mounted trellis for Virginia Creeper Planting to front boundary

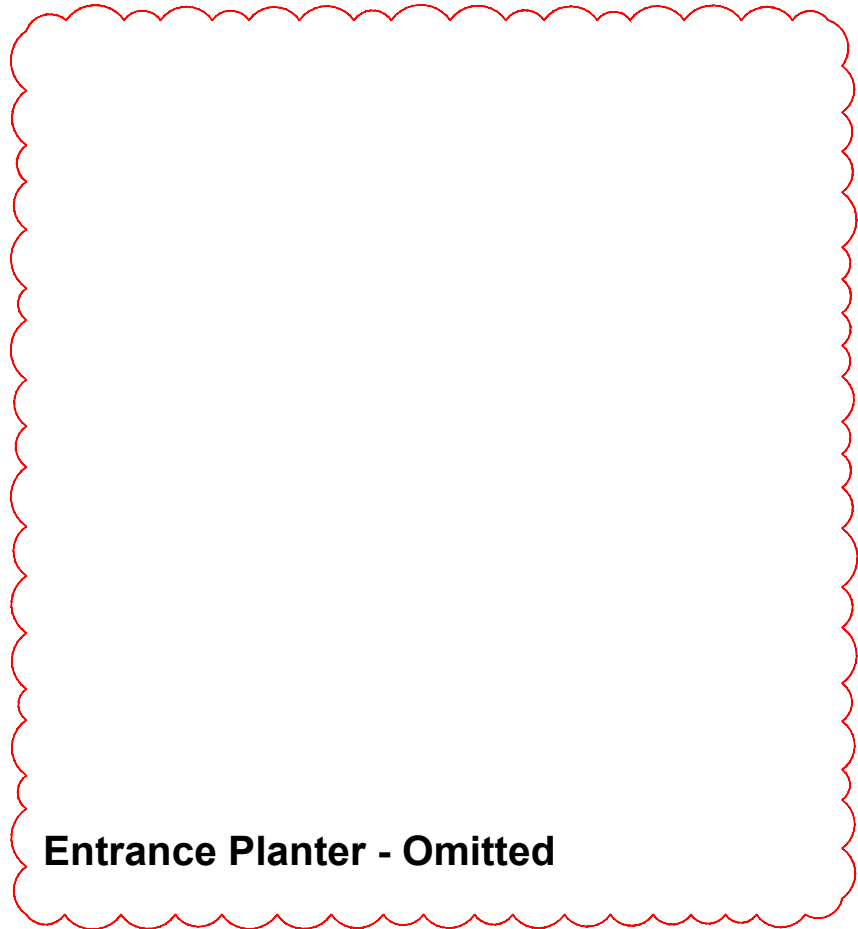

**Entrance Planter - Omitted**



**Front Boundary, Border between resin bound surface and pavement**  
Stone border edging, inset with square up-lighters at intermittent intervals

DRAWING STATUS

AS-RECORDED  
AS-BUILT  
FOR PLANNING  
FOR-CONSTRUCTION  
FOR DISCUSSION  
FOR COORDINATION  
FOR TENDER

☐  
☐  
☒  
☐  
☐  
☐  
☐

TDC  
ARCH  
DESIGN

The Design Collective Architects

2nd Fl. | 13 Museum St.  
York | YO1 7DT  
info@tdc-arch.design



Project  
**Proposed External Works Development  
Hampstead Court Care Home,  
St Johns Wood, NW8 0HJ**

Drawing Title  
**Proposed Materials**

Scale  
NTS @ A1

Date  
January 2023

Drawn by  
NS

Checked by  
SEL

Job No.  
A202038

Drawing No.  
AL(9)908

Rev.  
A