

Notes


Do not scale, use figured dimensions only.

All dimensions to be verified on site prior to the commencement of any work or the production of any shop drawing. All discrepancies to be reported to the Architect.

This drawing is to be read in conjunction with all related Architect's and Engineer's drawings and any other relevant information.

This drawing is copyright © of TDC Architects Ltd.

REV	DATE	REVISION	INITIALS	CHECK
A	04.07.23	PLANNING ISSUE Addition of tree information following Arboricultural Survey at request of LPA	NS	SEL
B	18.08.23	PLANNING ISSUE Minor amendments in accordance with LPA: triangular entrance planter omitted, material of planters amended, as clouded	NS	SEL

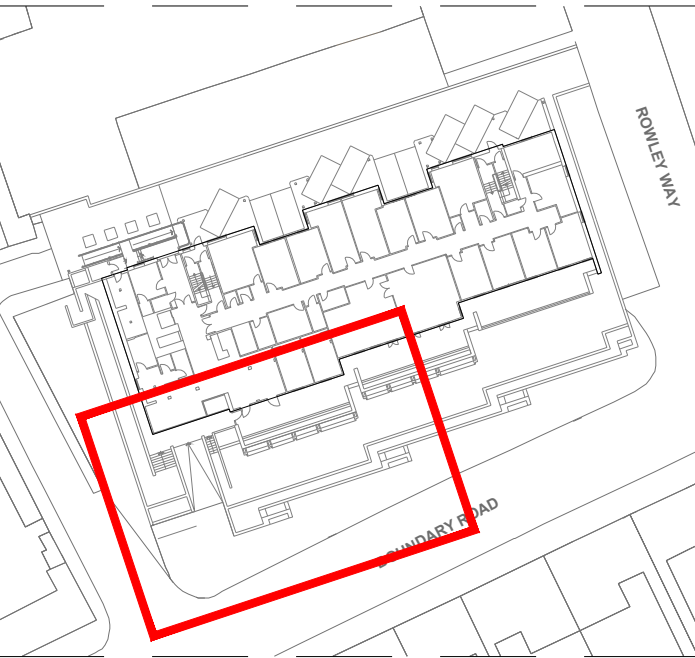

NE&S PLAN

TREE KEY

- ROOT PROTECTION AREA
- CROWN SPREAD
- CATEGORY A
- CATEGORY B
- CATEGORY C

DRAWING STATUS

AS-RECORDED  
AS-BUILT  
FOR PLANNING  
FOR CONSTRUCTION  
FOR DISCUSSION  
FOR COORDINATION  
FOR TENDER



2nd Fl. | 13 Museum St.  
York | YO1 7DT  
info@tdc-arch.design

Client



Project  
**Proposed External Works Development  
Hampstead Court Care Home,  
St Johns Wood, NW8 0HJ**

Drawing Title  
**Proposed Site Plan 1 of 3  
Ground Floor Level**

Scale  
1:50 @ A1

Date  
January 2023

Drawn by  
NS

Checked by  
SEL

Job No.  
A202038

Drawing No.  
AL(1)110\_1

Rev.  
B

Scale 1:50

