

EUSTON FS

RECORD DRAWING
No 84-18-5

No 26

ARCHITECT'S RECORDS
THIS DRAWING MUST BE RETURNED
TO THE ARCHITECT'S RECORDS OFFICE
UPON THE SUB-COMPLETION OF THE WORK


1710

RSU
4.2.5.0
4.2.5.0
4.2.5.0


LONDON COUNTY COUNCIL
ARCHITECTS RECORDS
PLAN ROOM
6, AVE 1955
SBS COUNTY
PLAN 702
Reg

LONDON COUNTY COUNCIL
ARCHITECTS LIBRARY
F 5 H 0 0 0 N 5 4
170 10 08 1
P O 10 1086
MADE BY GND EX BY

FIRE BRIGADE STATION EUSTON ROAD

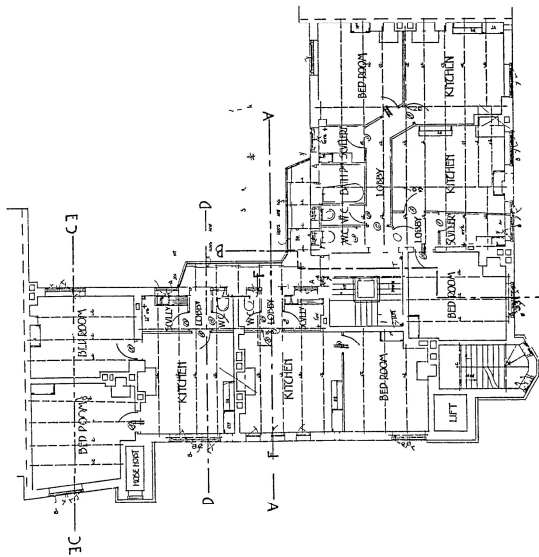

SECOND FLOOR PLAN

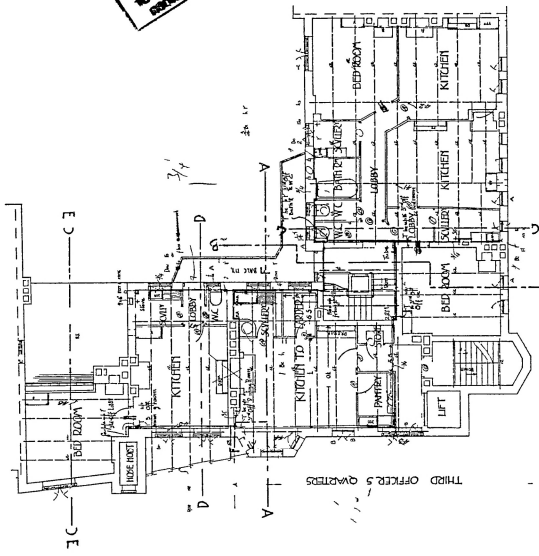

THIRD FLOOR PLAN

SCALE OF 1" = 10' 0"

84-18-5

W. S. Riley