

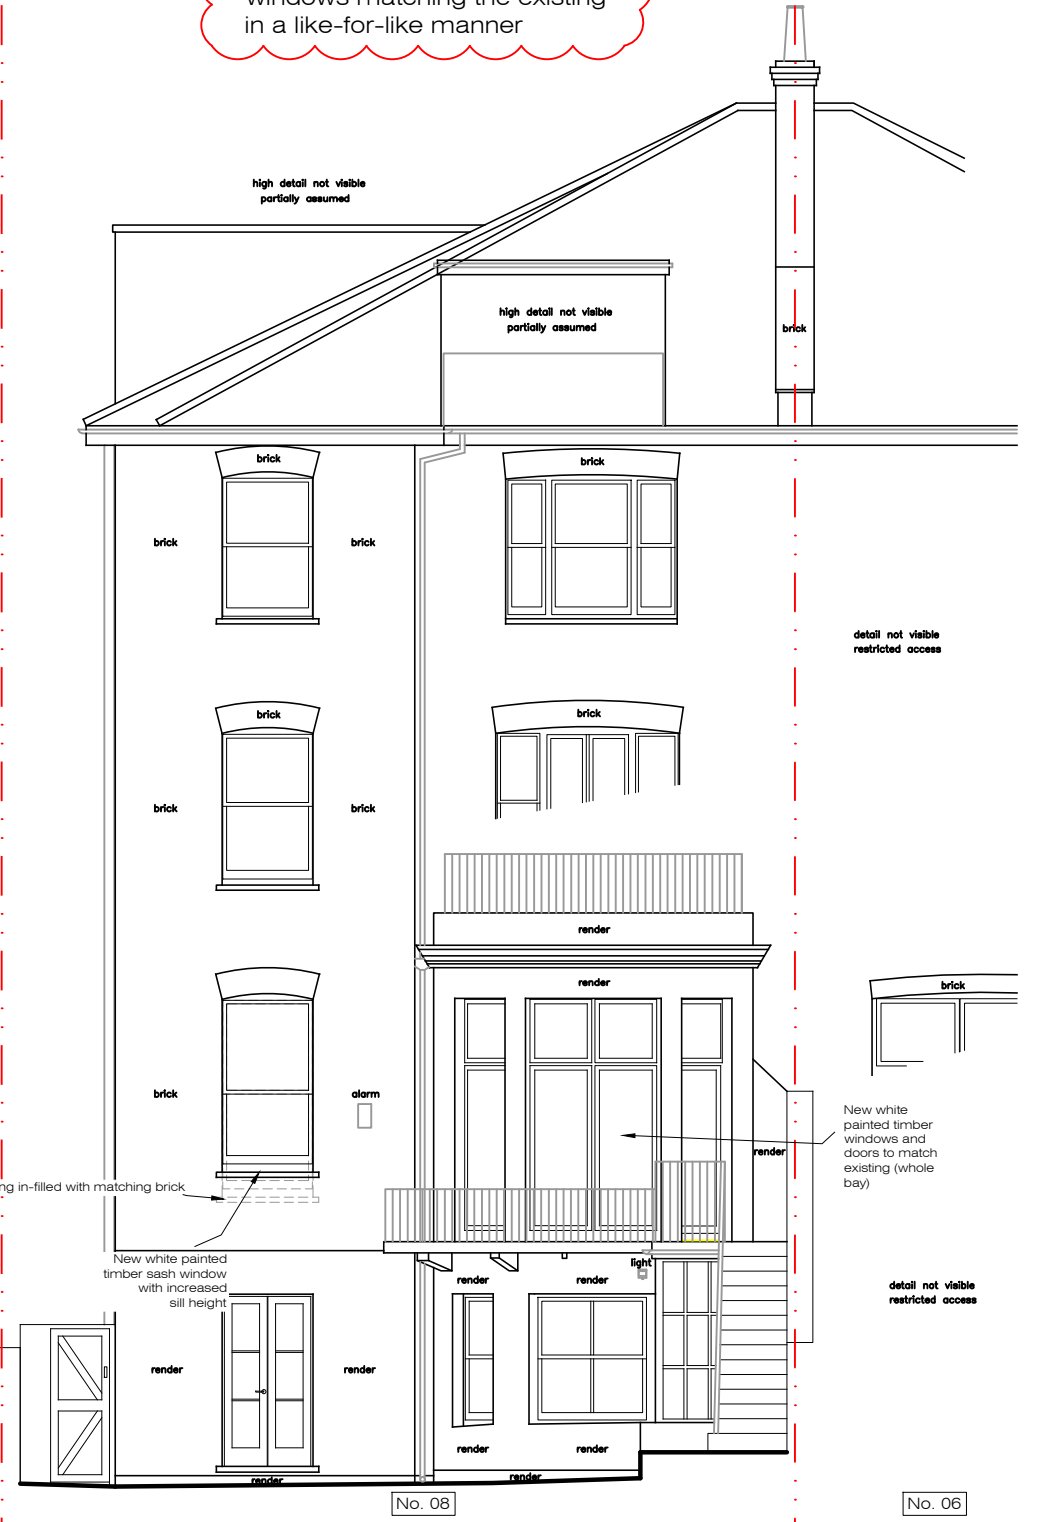
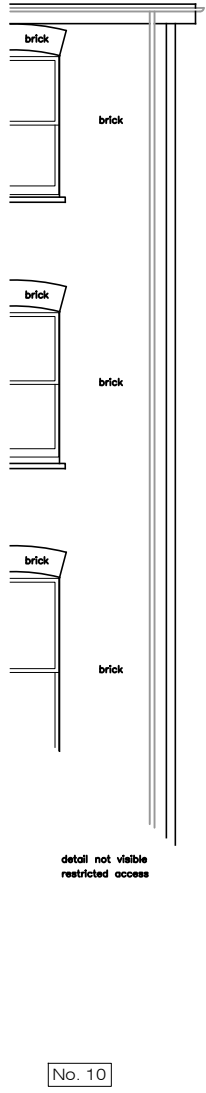
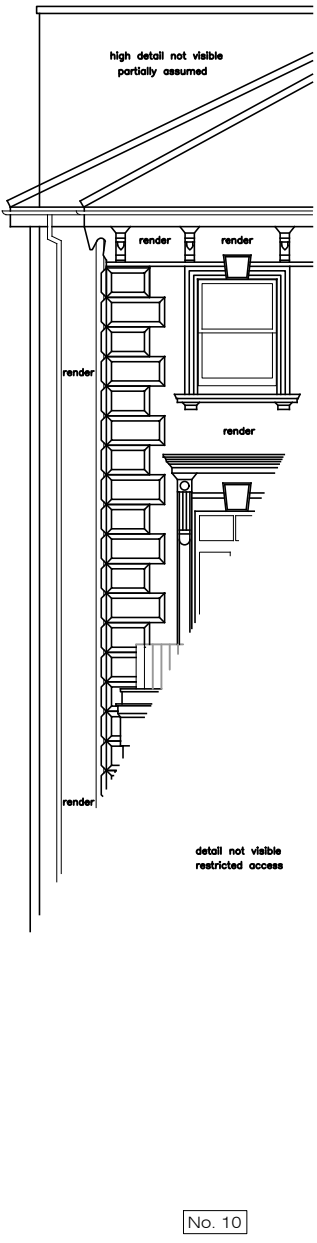


All Flat 1 (Upper Ground Floor Flat) windows to be replaced with double glazed conservation area style white painted timber windows matching the existing in a like-for-like manner

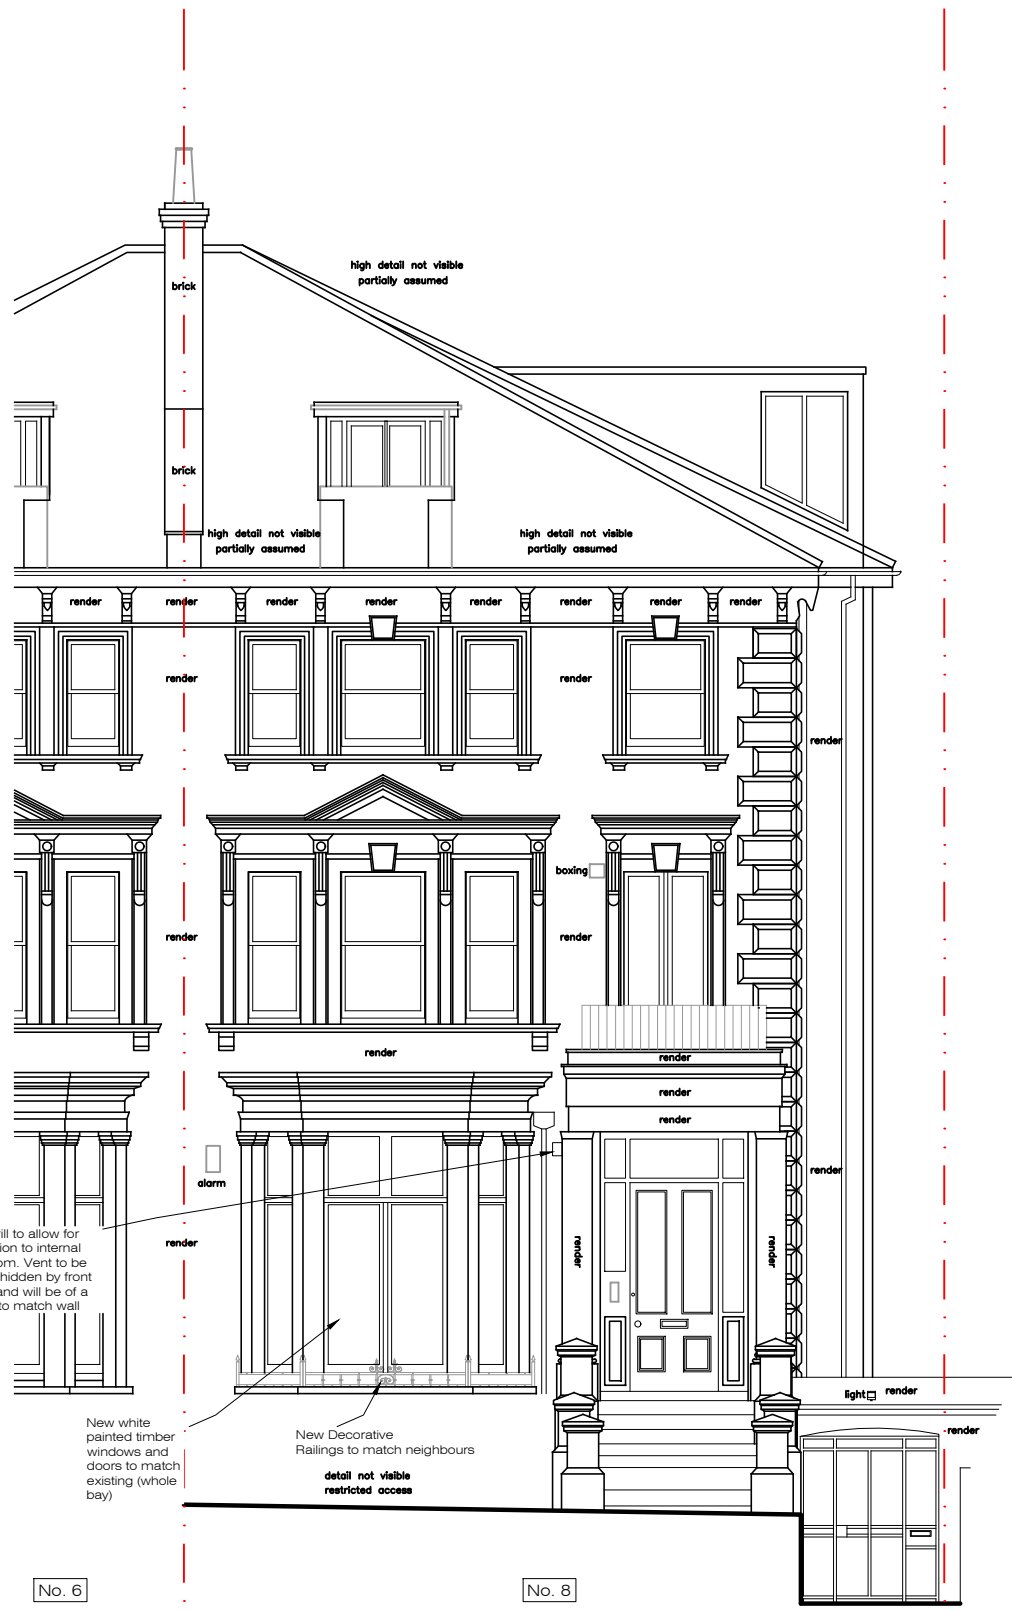

X Proposed Front Elevation 1:100@A3

X Proposed Rear Elevation 1:100@A3

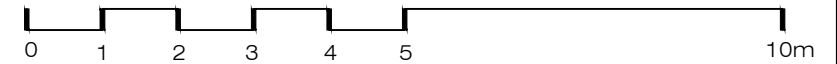

XUL ARCHITECTURE
 Ground Floor Office
 33 Belsize Lane
 London NW3 5AS
 Office: +44 (0) 207 431 9014
 info@xularchitecture.co.uk
 www.xularchitecture.co.uk

PLEASE NOTE:

- All dimensions to be checked on site before fabrication.
- Contractor to refer to engineers drawings before proceeding with works.
- All drawings and designs are covered by design right (intellectual property), and may not be distributed, copied or issued without written permission by the Architect.
- All design concepts are the sole property of the Architect and no adaptations, reproductions or copies may be made without written permission of the Architect.
- These drawings are subject to any variation required or recommendation by any statutory authority, or for the better carrying out of the works.
- Samples to be provided by contractor for XUL Architecture's approval.
- All finishes to XUL Architecture's satisfaction.
- All drawings to be approved by XUL Architecture prior to construction.

ADDITIONAL NOTE:

Issue key:	Information (I)	Project Address	Issue For:
Planning (P)	Tender (T)	Flat 1, 8 Belsize Park Gardens, NW3 4LD	PLANNING
Construction (C)	As Built (B)	Scale 1:100@A3	Proposed
		Rev. Date 10.07.23	Front & Rear Elevations
		Drawn HS	Dwg. No. PA-03 Rev. P-01
		Checked IW	Project Number 23053