



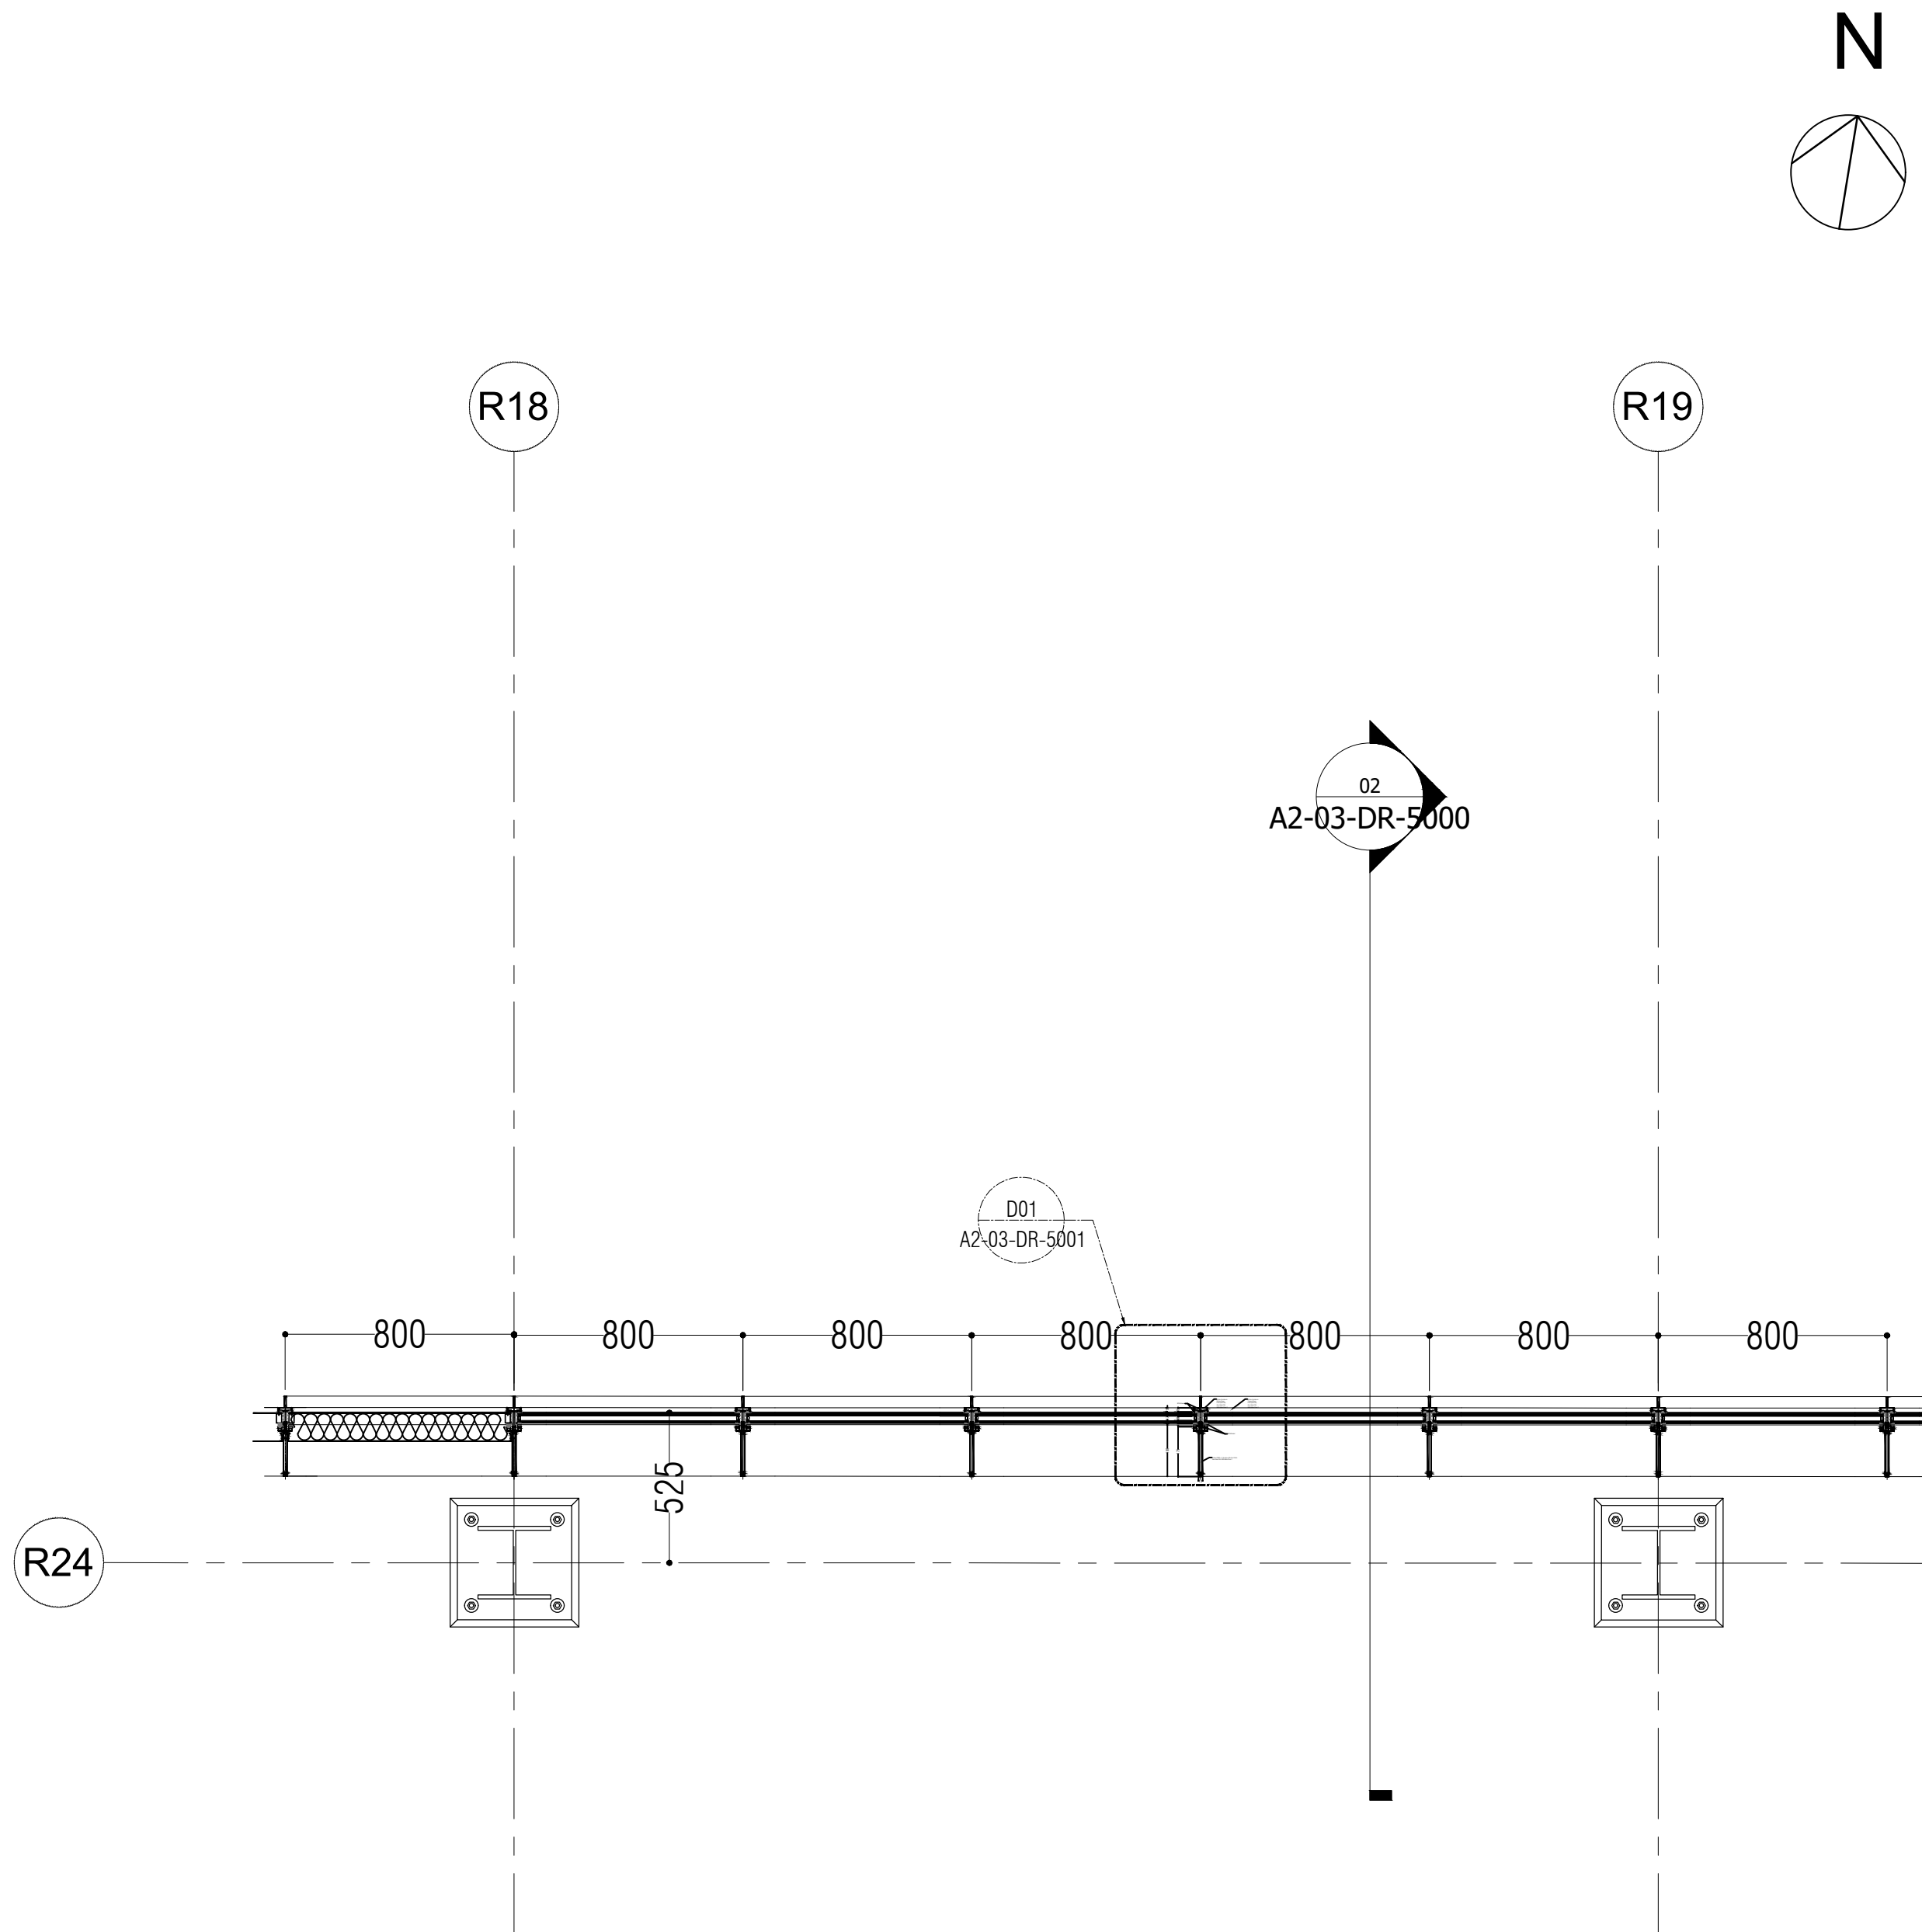

A2 BLOCK 3. FLOOR SYSTEM PLAN


Scale: 1:20

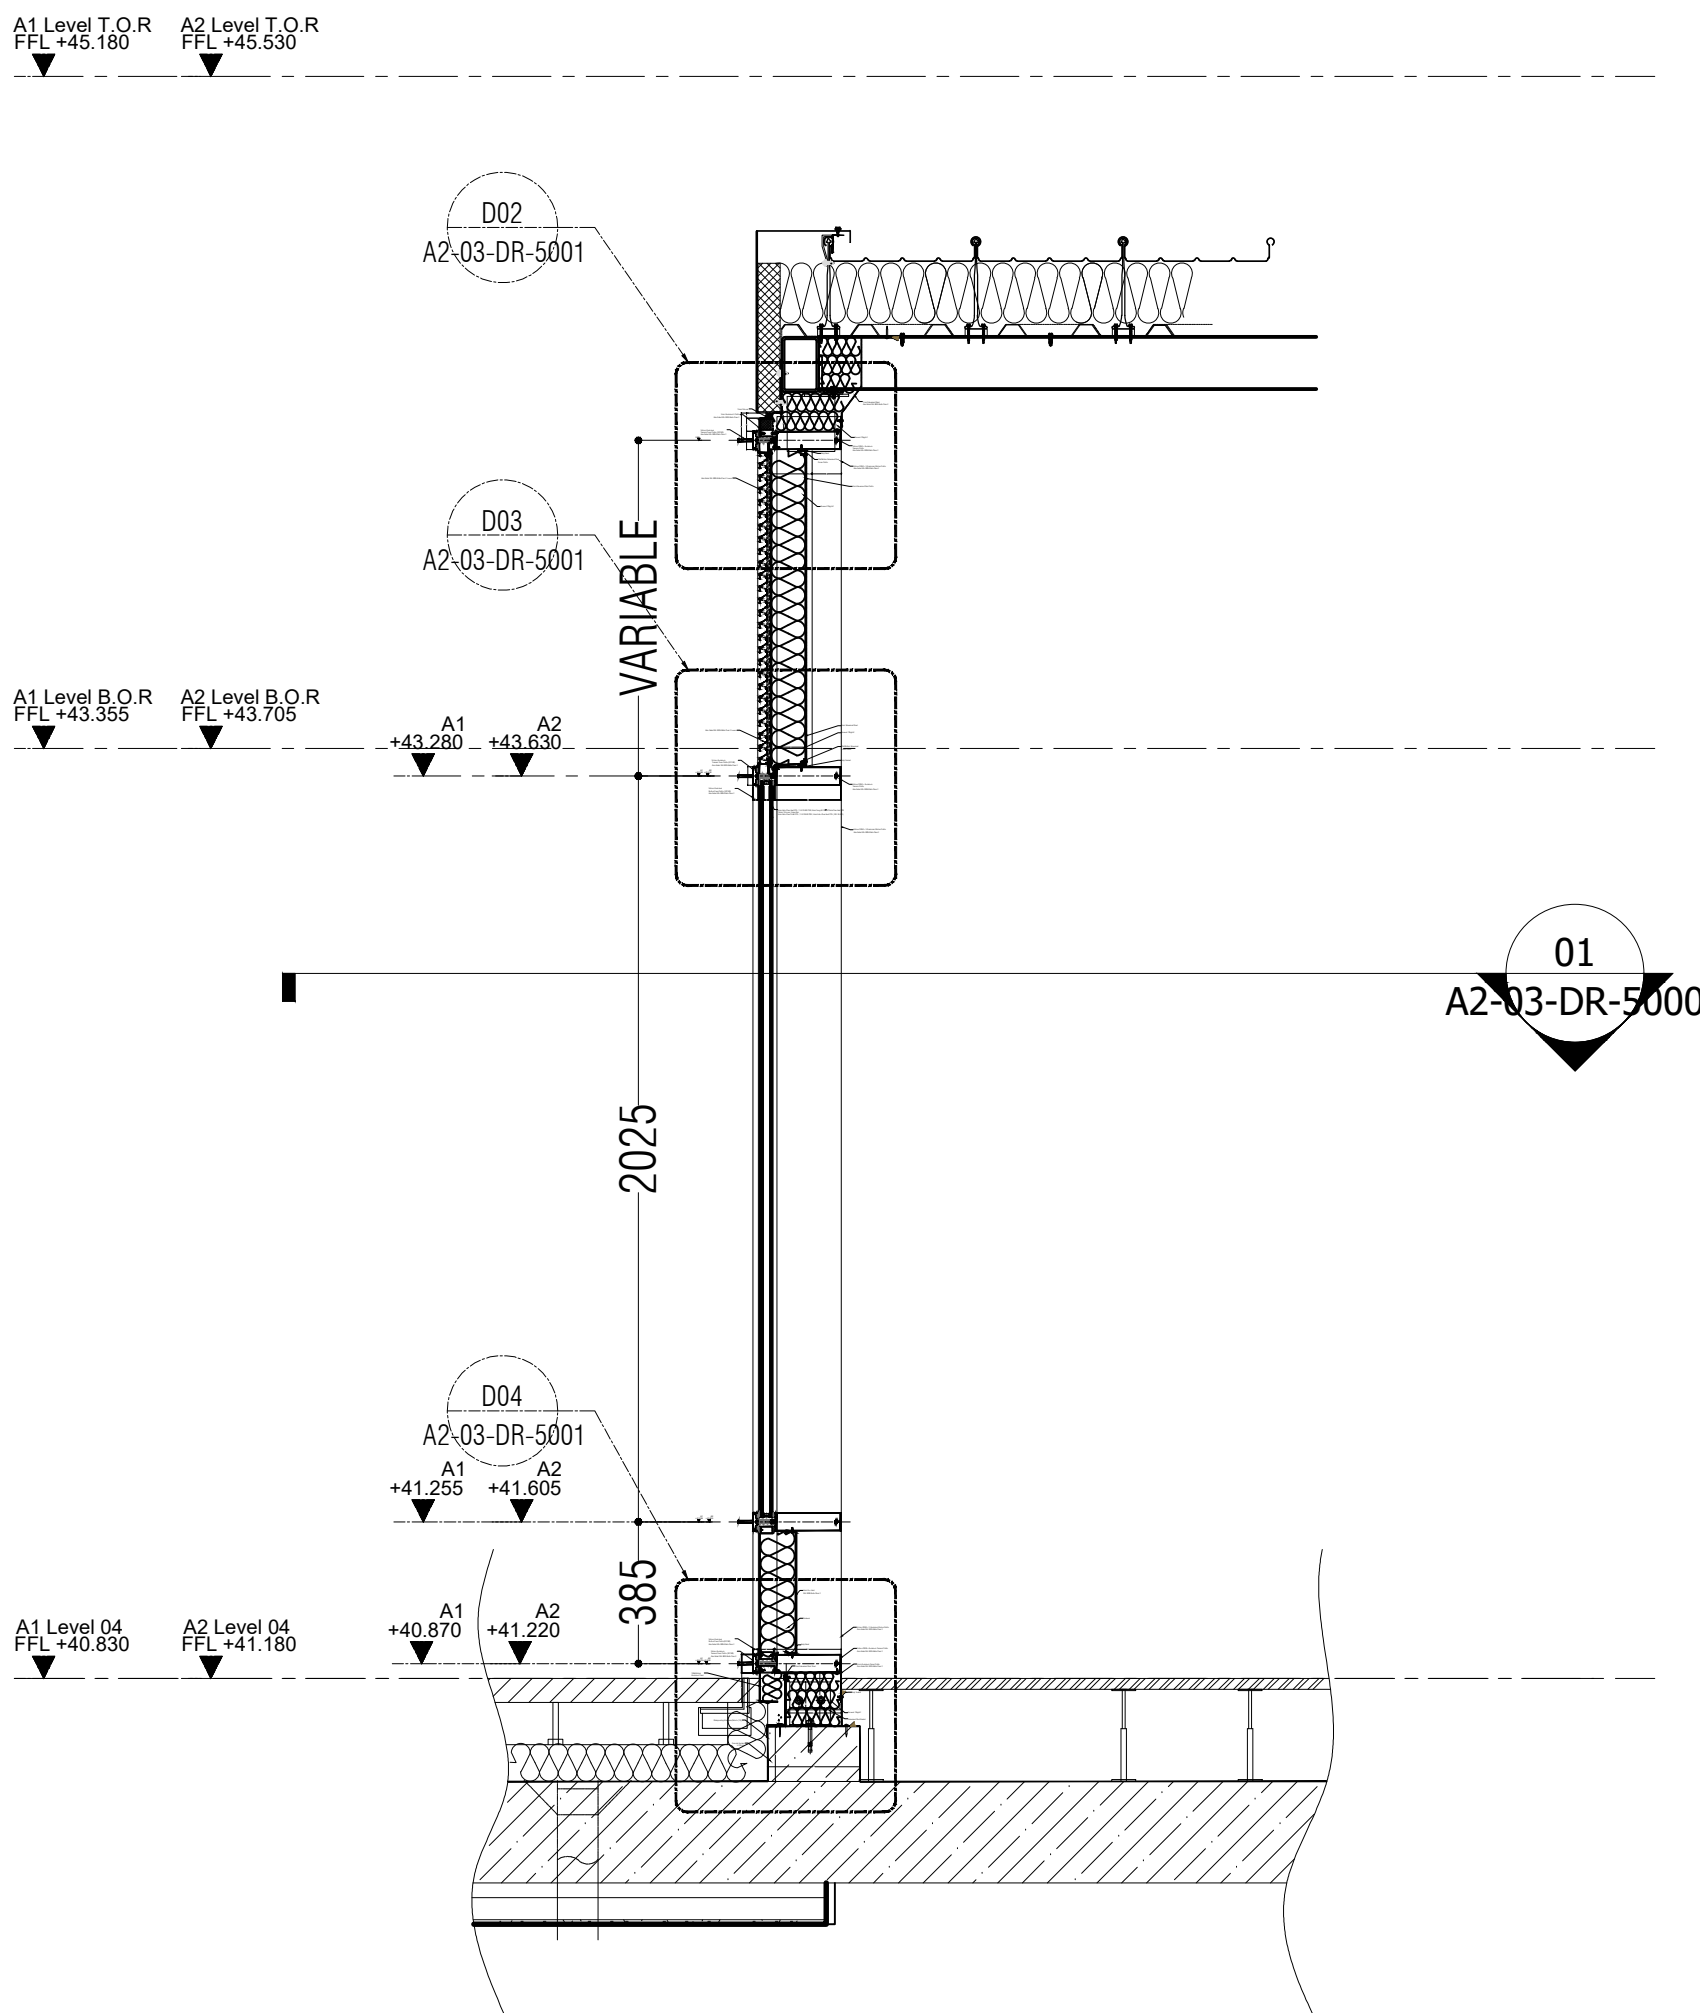

A2 BLOCK 3. FLOOR SYSTEM SECTION

Scale: 1:20

Notes:

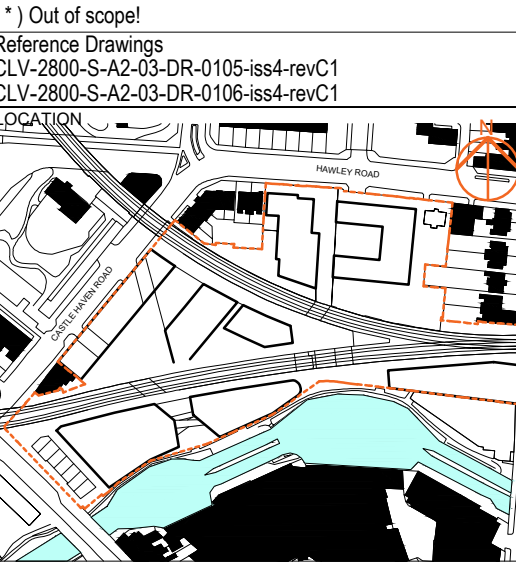

DO NOT SCALE DRAWINGS

HATCHES FOR DETAILS

AB01	AS BUILT	10.09.2018
C03	for CMT review	10.01.2018
C02	REVISED AS CLOUDED	05.10.2017
C01	FOR CONSTRUCTION	21.09.2017
05	FILE NAME REVISED	18.09.2017
04	REVISED AS COMMENTS	15.09.2017
03	REVISED AS COMMENTS	23.08.2017
02	FILE NAME REVISED	31.07.2017
01	REVISED AS CLOUDED	28.07.2017
00	FIRST HANDOVER	18.03.2017

Revisions		
Date	Drawn By	Project Number
10.09.2018	GC	...
Drawing Scale	Checked By	Revision Number
As noted	AC	AB01
CADD Plot Scale	Status	
1/1 (A1)	AS BUILT	

CAMDEN LOCK VILLAGE
A2 Block 3.Floor System Details

Date	Drawn By	Project Number
10.09.2018	GC	...
Drawing Scale	Checked By	Revision Number
As noted	AC	AB01
CADD Plot Scale	Status	
1/1 (A1)	AS BUILT	

Drawing Number
CLV-3200-X-A2-03-DR-5000