


Notes:

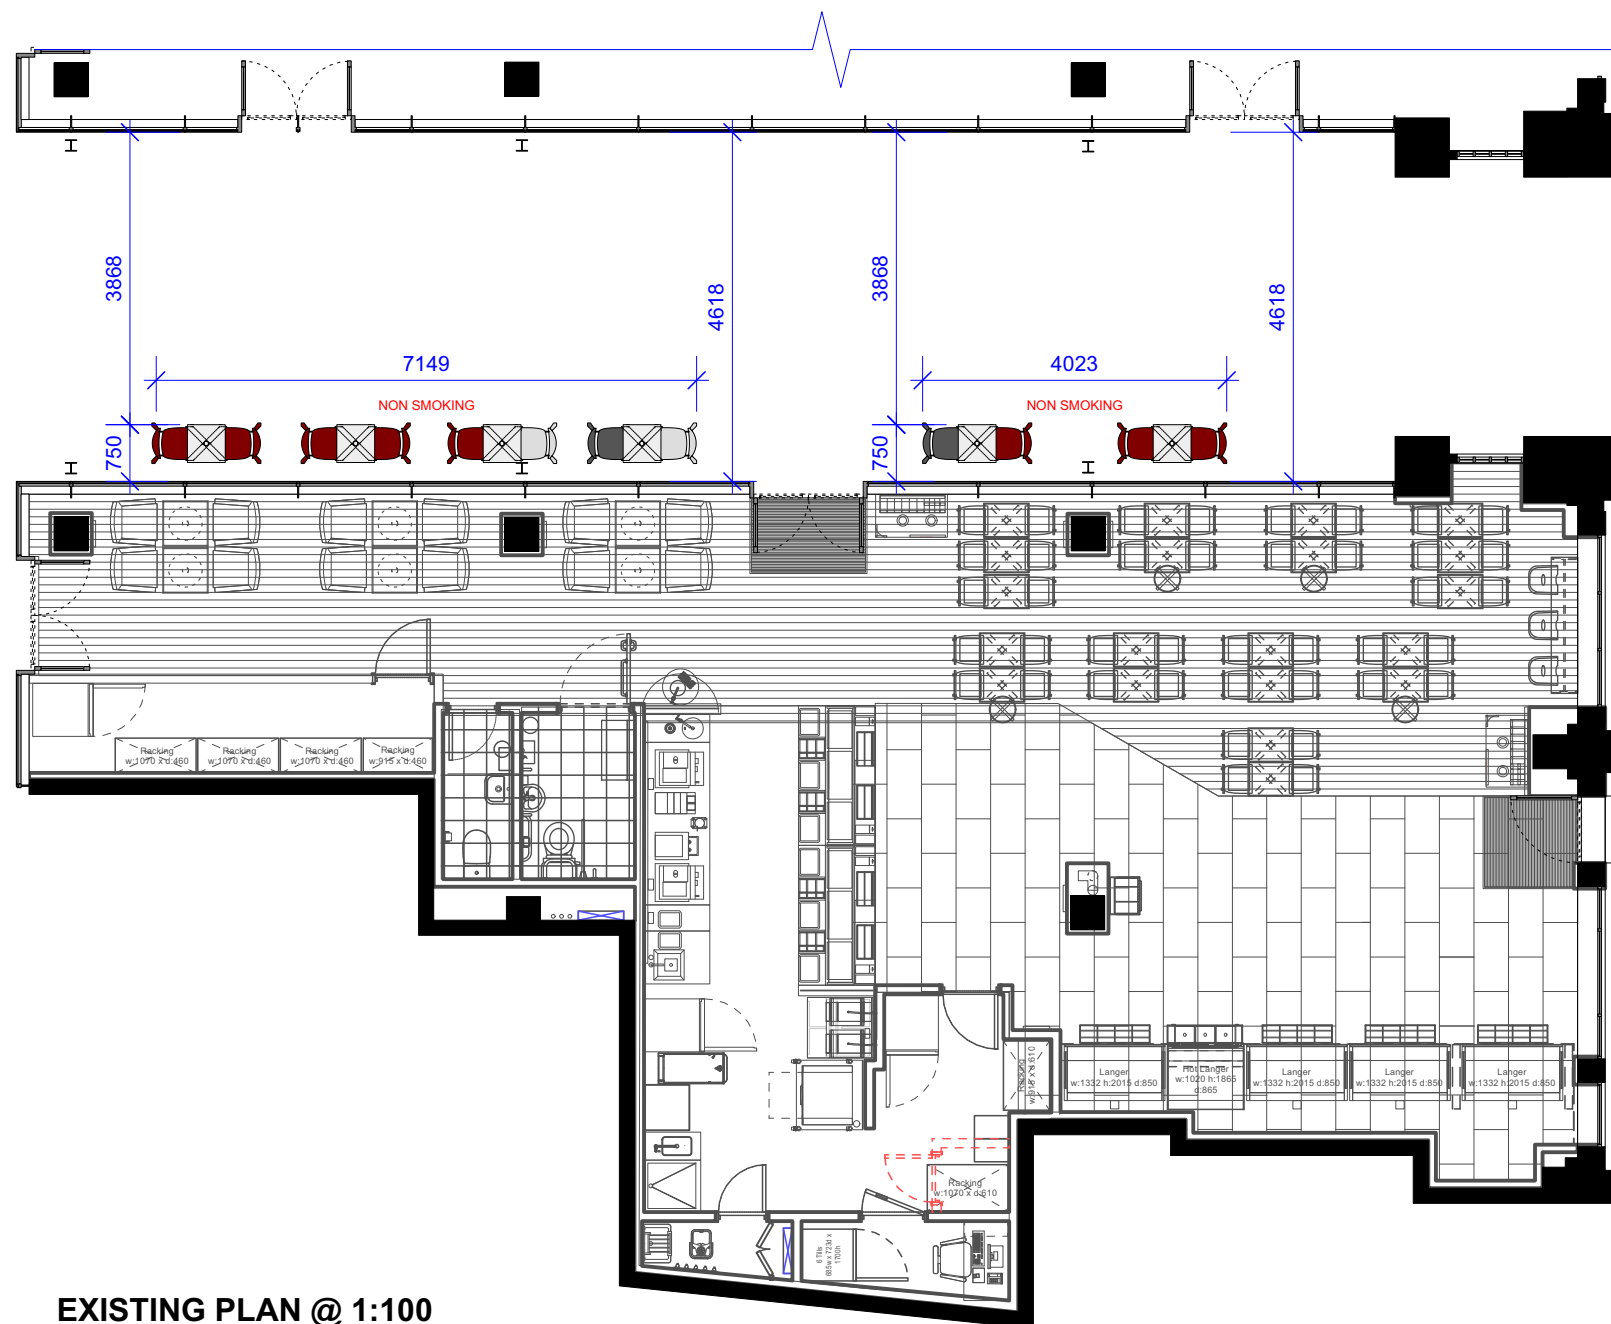

EXISTING PLAN @ 1:100

As Built

★ PRET A MANGER ★

1 Hudson Place, London, SW1V 1PZ

Site: Chancery Lane

Title: Seating Licence

Rev: Date: Drawn By:

Dwg No. CHANC-Pret-01-SL

Date: 21.09.23 Revision:

Scale: 1:100@ A3 Drawn By: GN

THIS DRAWING IS NOT TO BE SCALED
Figured dimensions only to be used. This drawing is subject to and protected by the provision of the copyrights acts. Any discrepancies or queries to be notified immediately. All dimensions to be verified on site.

© PRET A MANGER (EUROPE) LTD 2004