




Demolition & Alteration
Sectional Internal Elevation A as Existing

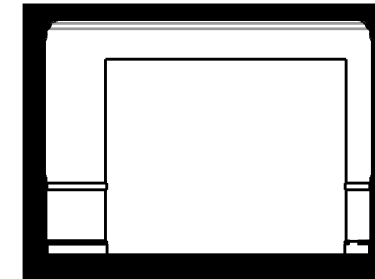


Demolition & Alteration
Sectional Internal Elevation C as Existing

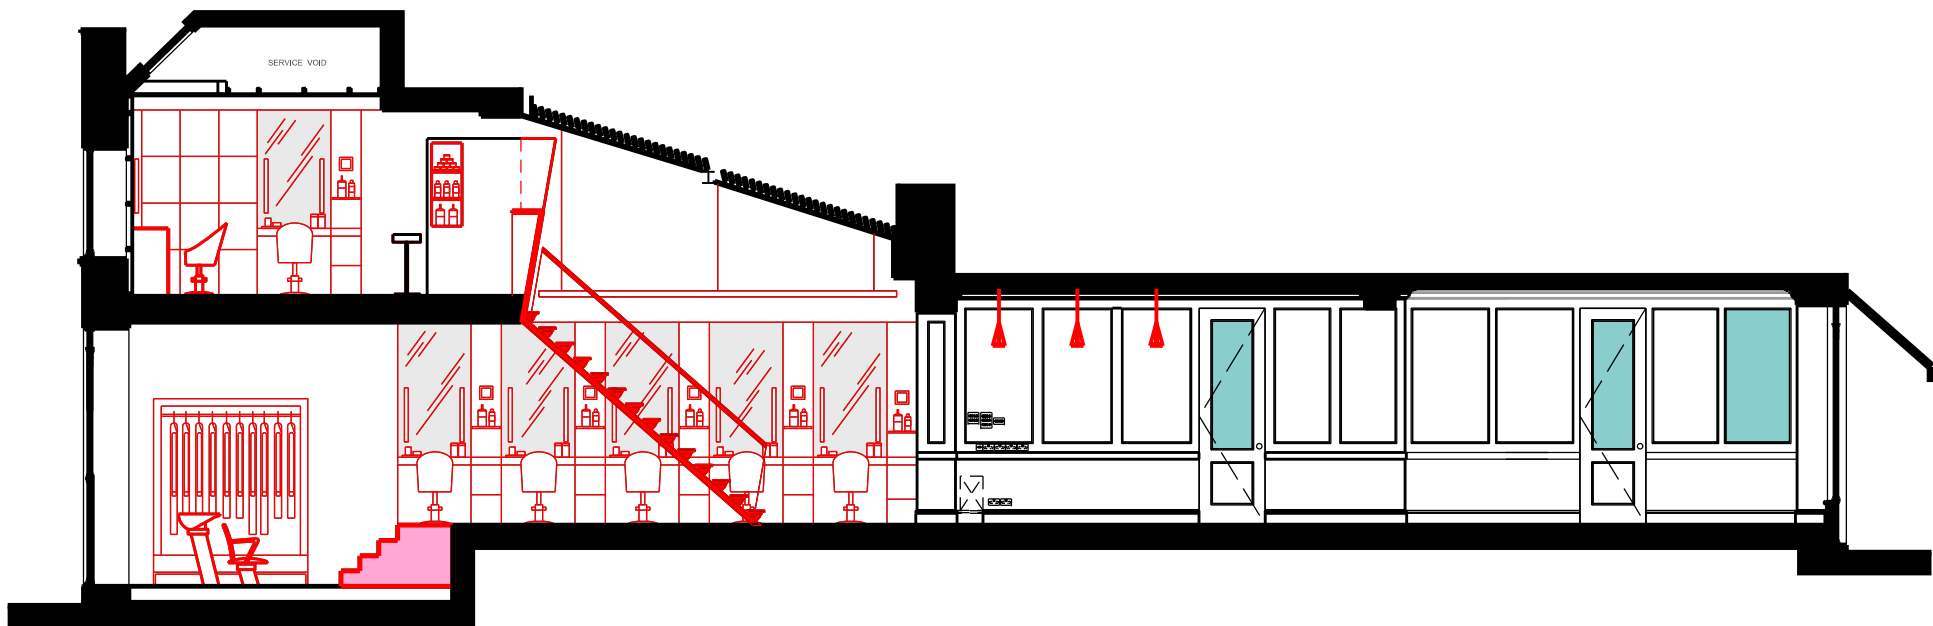


Demolition & Alteration
Sectional Internal Elevation B as Existing

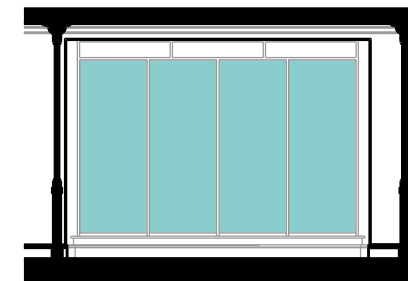

Demolition & Alteration
Sectional Internal Elevation D as Existing

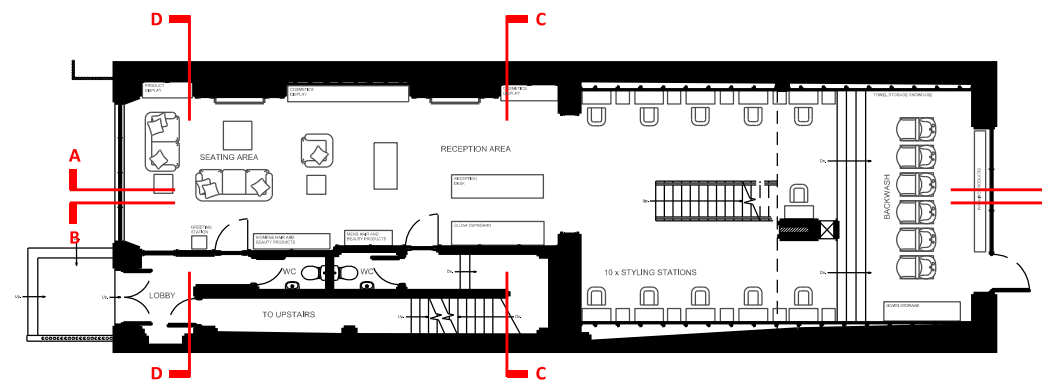

Notes:
The contractor must verify all dimensions on site before commencing any work or fabrication drawings. If this drawing exceeds the quantities taken in any way SDW Architectural Design are to be informed before the work is initiated. Only figured dimensions are to be taken from this drawing.
Do not scale from this drawing. All dimensions are in millimeters unless noted otherwise.
Drawings are based on Ordnance Survey and / or existing record drawings - design and drawing content is subject to detailed Site Survey, Structural Survey, Site Investigations, Planning and Statutory Requirements and Approvals.
Authorised reproduction from Ordnance Survey Map with permission of the Controller of Her Majesty's Stationery Office. Crown Copyright reserved.
SDW Architectural Design Copyright.

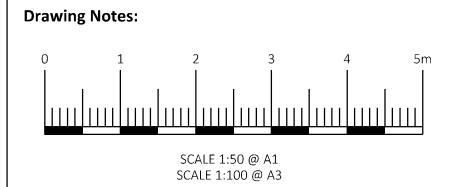

ISSUE	DATE	DRAWN	CHECKED	DESCRIPTION
B	16/09/2023	SDW		Issued for PLANNING
A	31/08/2023	SDW		Issued for PLANNING

CLIENT Seven Percy Street Limited
PROJECT Change of Use including Internal Alterations
7 Percy Street (inc. 6 Percy Street Basement)
Fitzrovia
London
W1T 1DH

DRAWING TITLE
Demolition & Alteration - Existing Ground Floor Internal Elevations

DRAWING NO. 065 (03) 202 **REVISION** B
DRAWN SDW **DATE** 18/08/2023 **SIZE & SCALE** 1:50 @ A1
1:100 @ A3

DRAWING STATUS PLANNING

34 Twisse Road, Bolton BL2 6NZ
M: 07519 190 770
s.d.wardle@gmail.com

