



1 LOWER GROUND FLOOR LAYOUT
1:100 @ A2

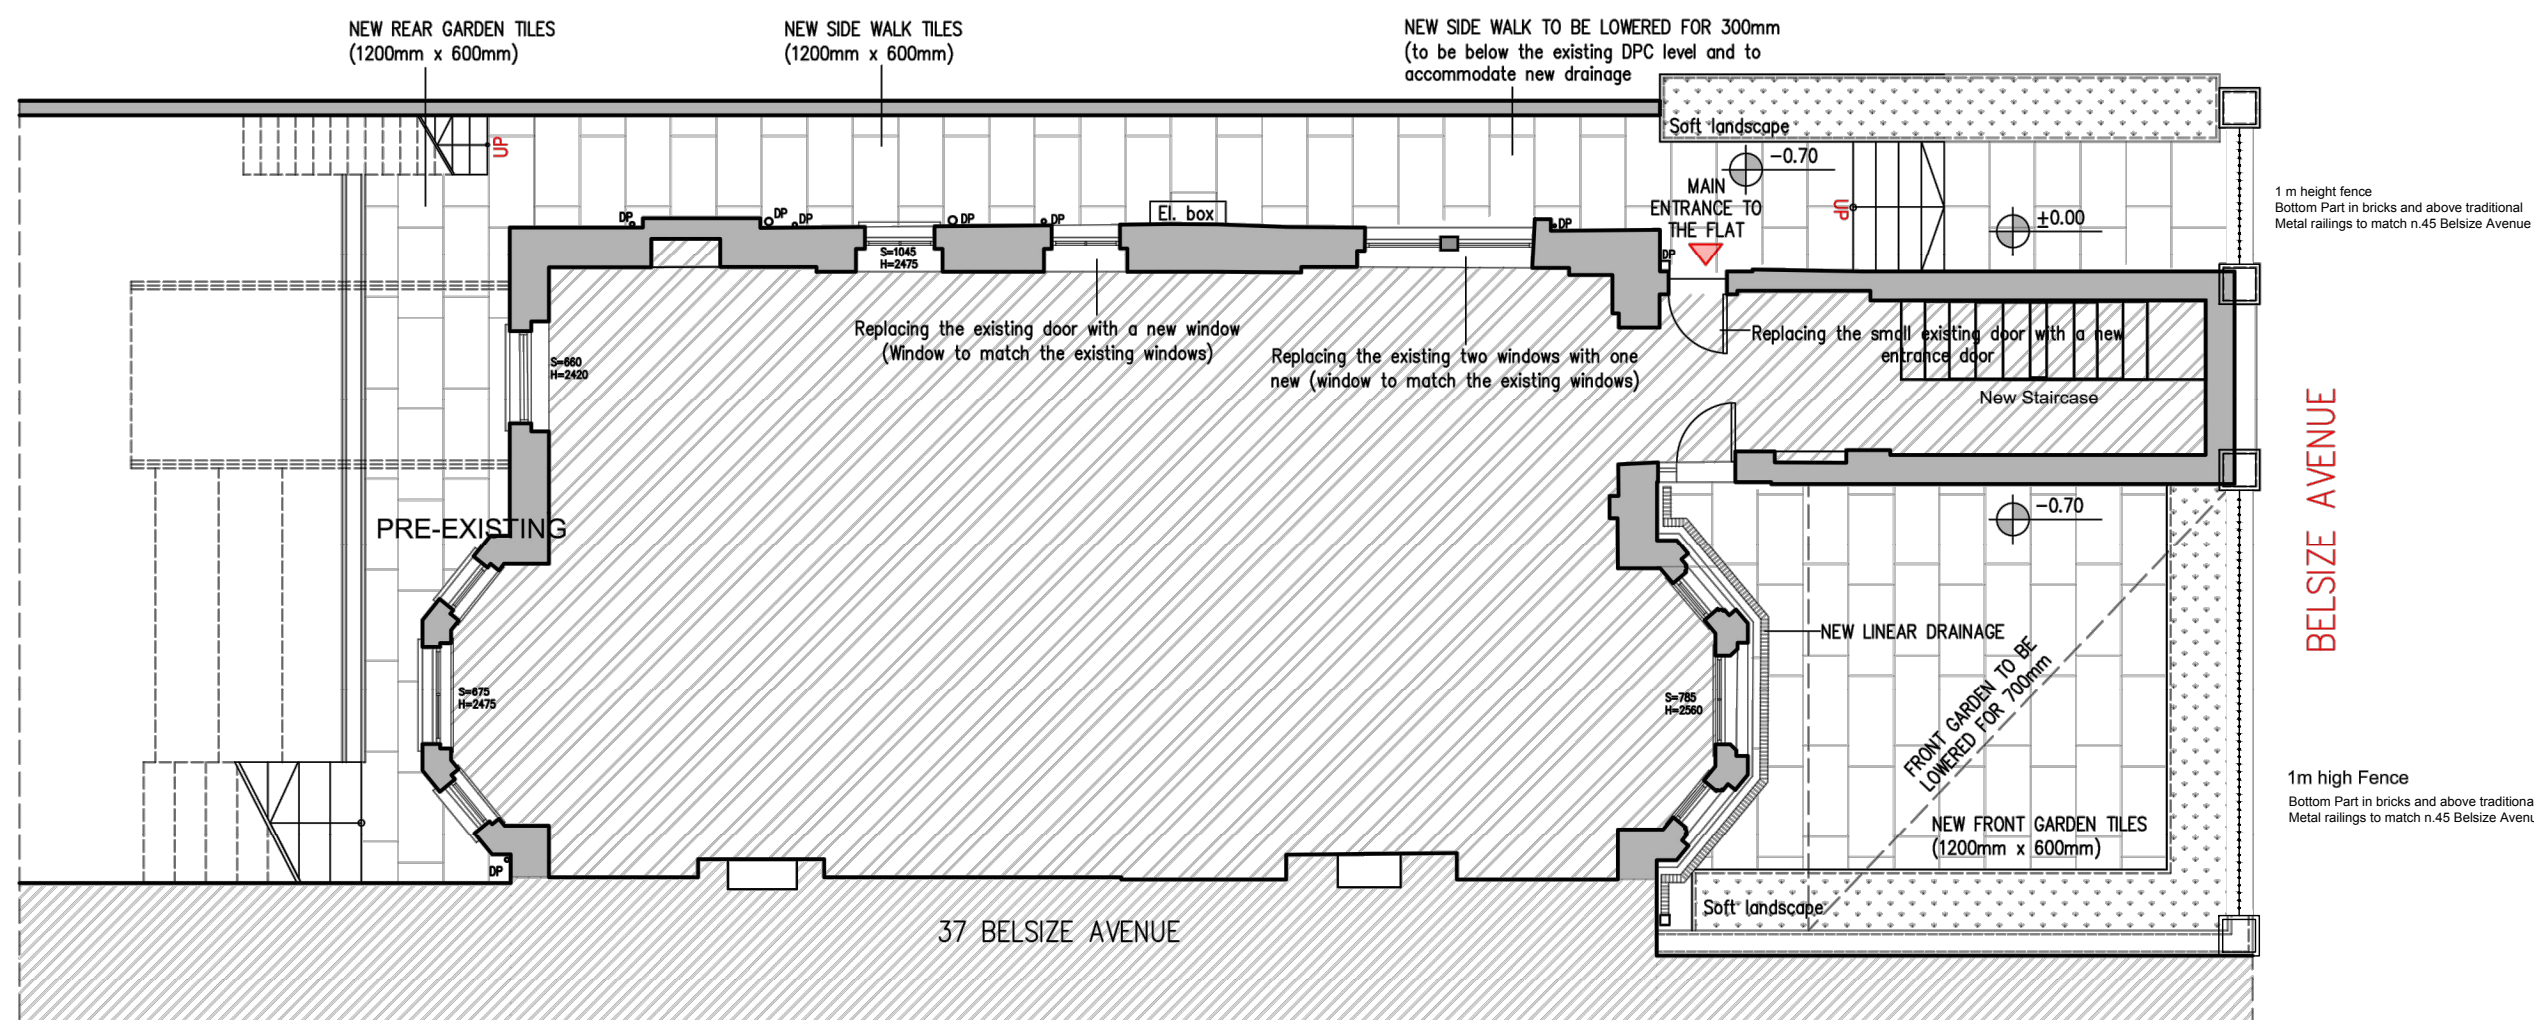

2 LOWER GROUND FLOOR LAYOUT
1:100 @ A2

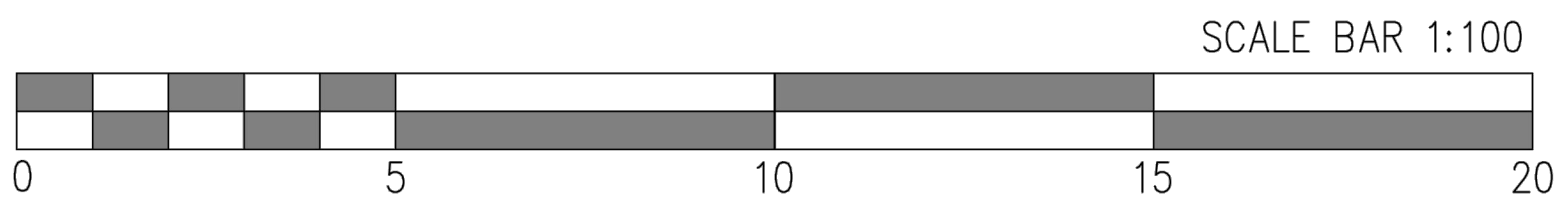

PROJECT: Belsize Avenue, NW3 5AS London	
DRAWING TITLE: Lower Ground Floor Layout Pre-Existing & As Built	
DATE CREATED: 20/09/2023	SCALE: 1:100; A2