



PROPOSED FRONT ELEVATION  
1:100

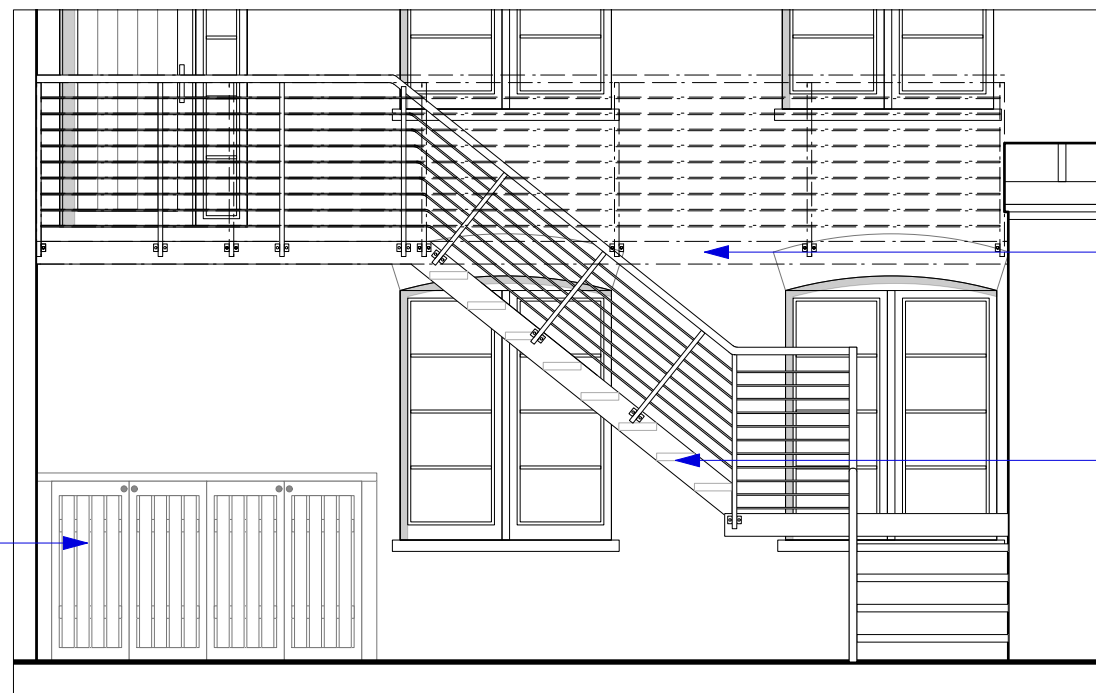

PARTIAL FRONT ELEVATION  
1:50

Drawing to regularise construction of the refuse housing in accordance with, and to implement, application ref: 2020/5542/P

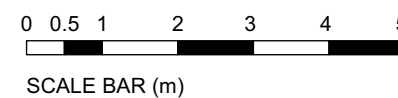

WRITTEN DIMENSIONS ONLY TO BE USED ALL DIMENSIONS ARE IN MILLIMETRES ALL DIMENSIONS TO BE VERIFIED ON SITE ANY INCONSISTENCIES TO BE REPORTED TO THE ARCHITECT IMMEDIATELY	<b>Job No: 7310</b>	<b>p-ad</b> 192D Campden Hill Road, Notting Hill Gate, London, W8 7TH t: 0208-4590172 e: ben@pelicanad.co.uk	<b>p-ad</b>
	<b>AS BUILT</b>	<b>Title: As Built Front Elevation</b>	
	5-6 Park End London NW3 2SE	Scale: 1:100 & 1:50 @ A3	Number: 7310/ PL-08 Rev: D