

1 As Constructed Block Plan  
Scale: 1:500 @ A3



2 Location Plan  
Scale: 1:1250 @ A3

# PLANNING APPLICATION

CLIENT  
OSN Developments

PROJECT  
Retrospective  
AC Installation



DATE  
28/10/23

PROJECT NO.  
2104369


DRAWN BY  
PAC

Punjab House  
33J Mill Lane  
London  
NW6 1NZ


**PA- 01**  
**rev**

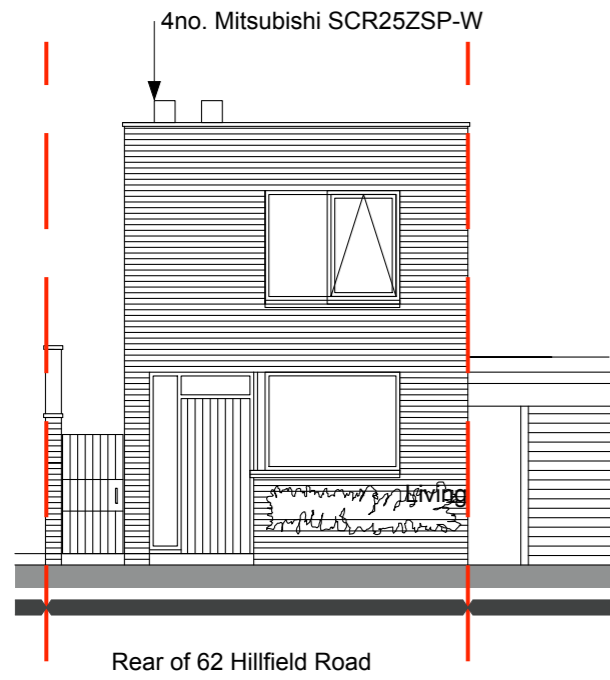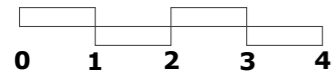


1 Front Elevation  
Scale: 1:100 @ A3

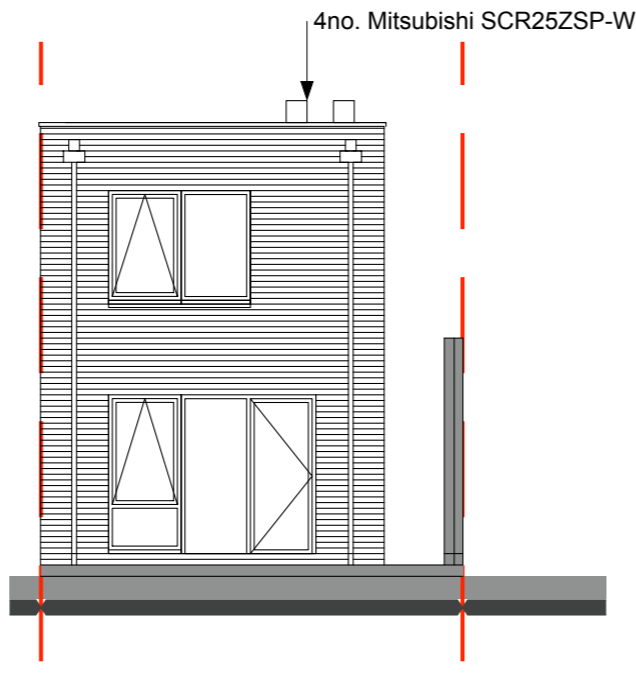


2 Rear Elevation  
Scale: 1:100 @ A3

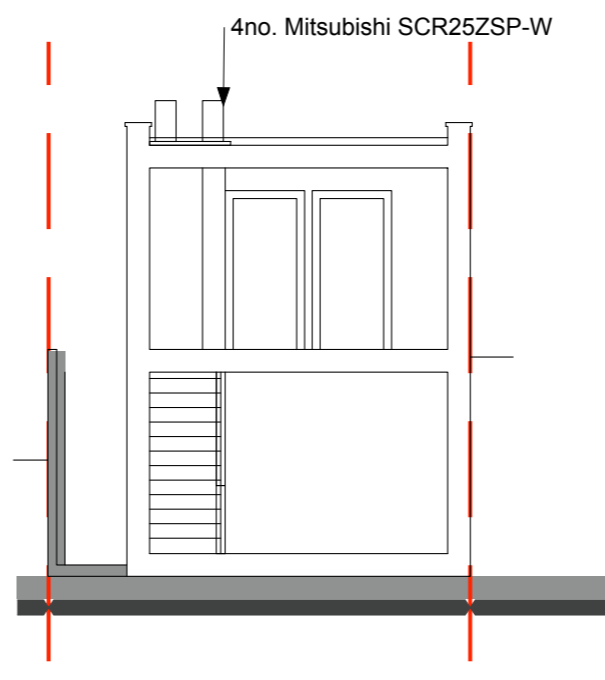


3 Section  
Scale: 1:100 @ A3

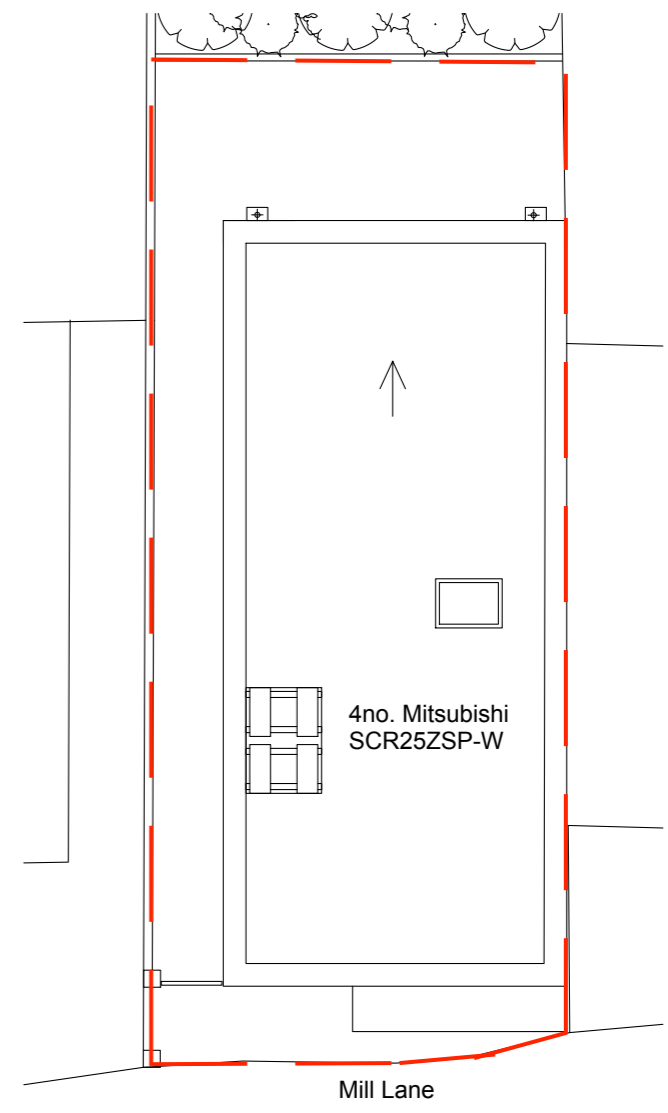

4 Roof Plan  
Scale: 1:100 @ A3

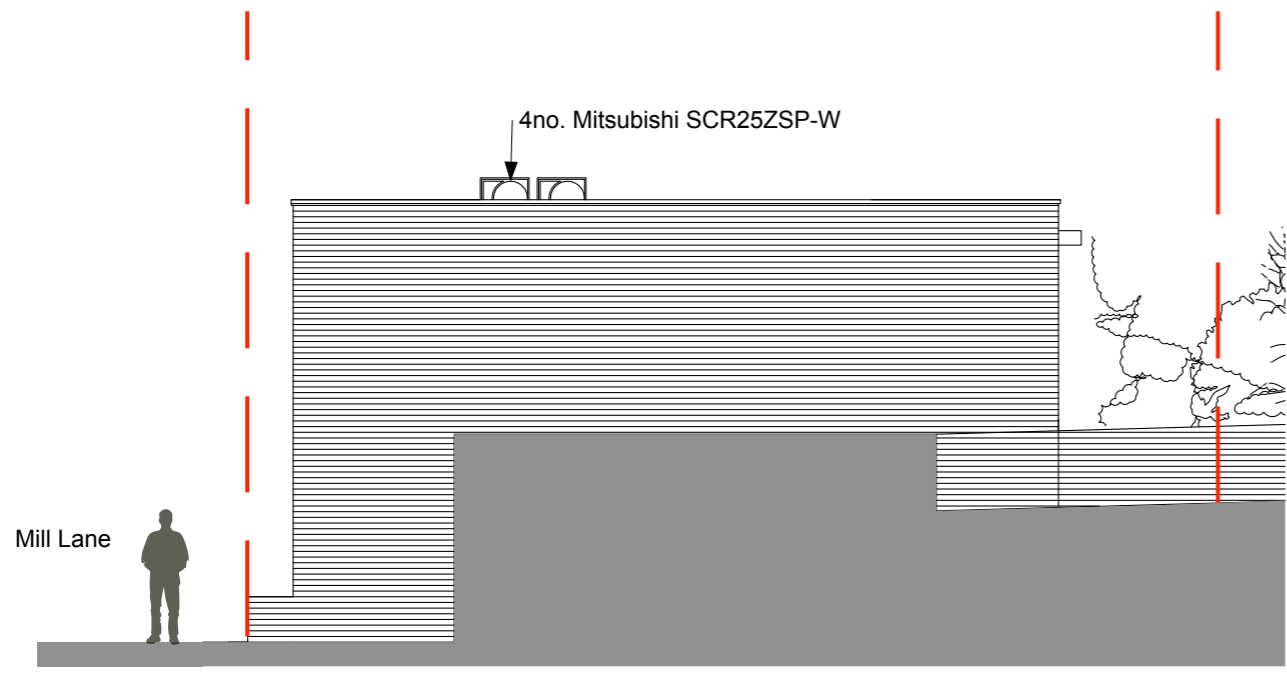

5 Side Elevation  
Scale: 1:100 @ A3

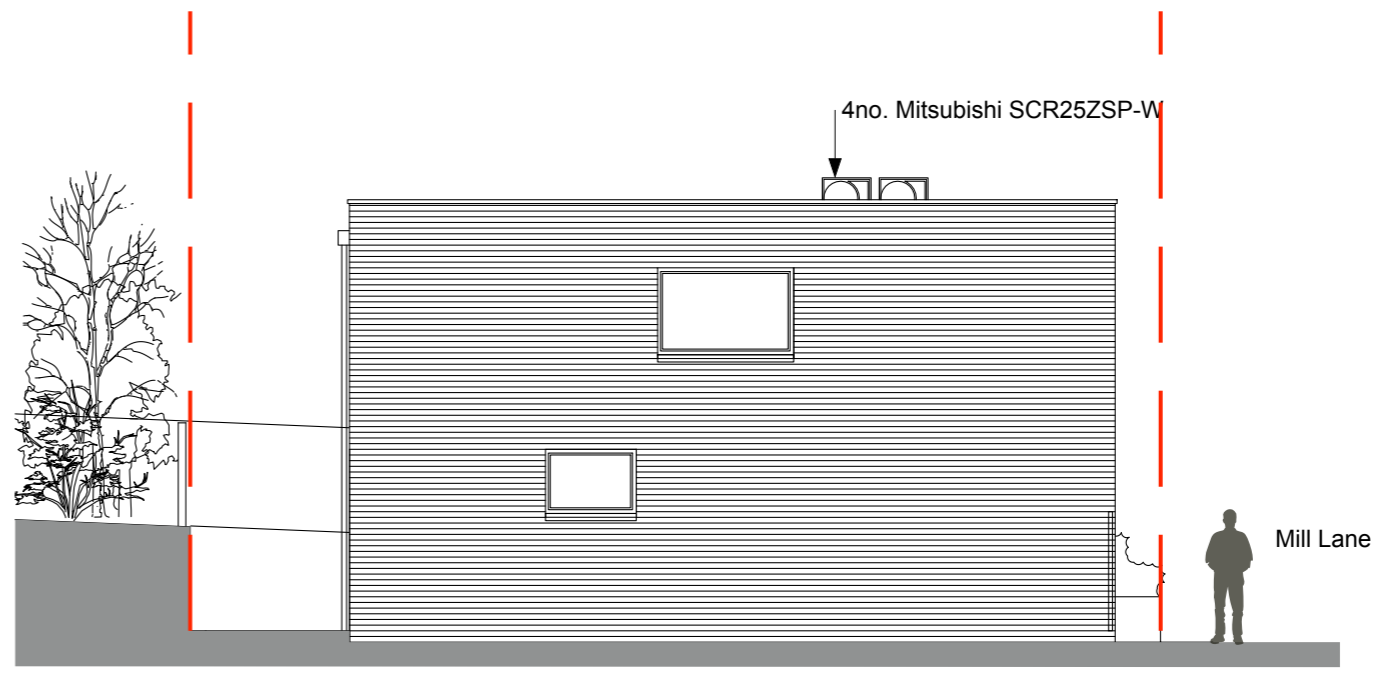

6 Side Elevation  
Scale: 1:100 @ A3

**PLANNING APPLICATION**

CLIENT  
OSN Developments

PROJECT  
Retrospective  
AC Installation

PROJECT NO.  
2104369

DATE  
28/10/23

DRAWN BY  
PAC

Punjab House  
33J Mill Lane  
London  
NW6 1NZ

**PA-02**  
**rev**