
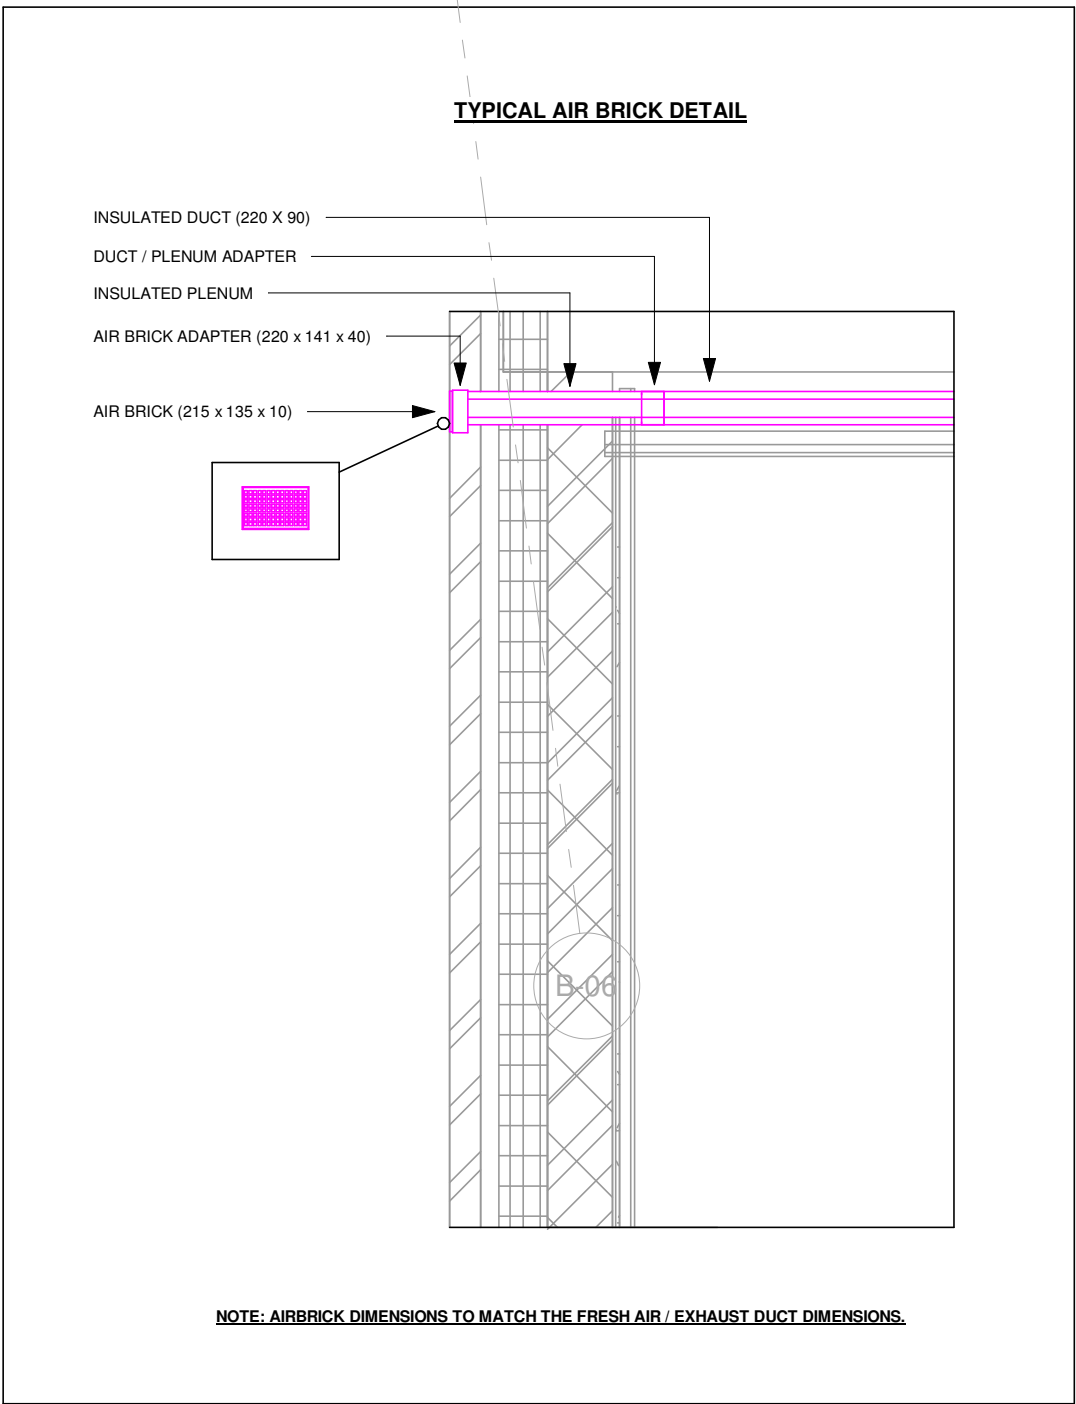
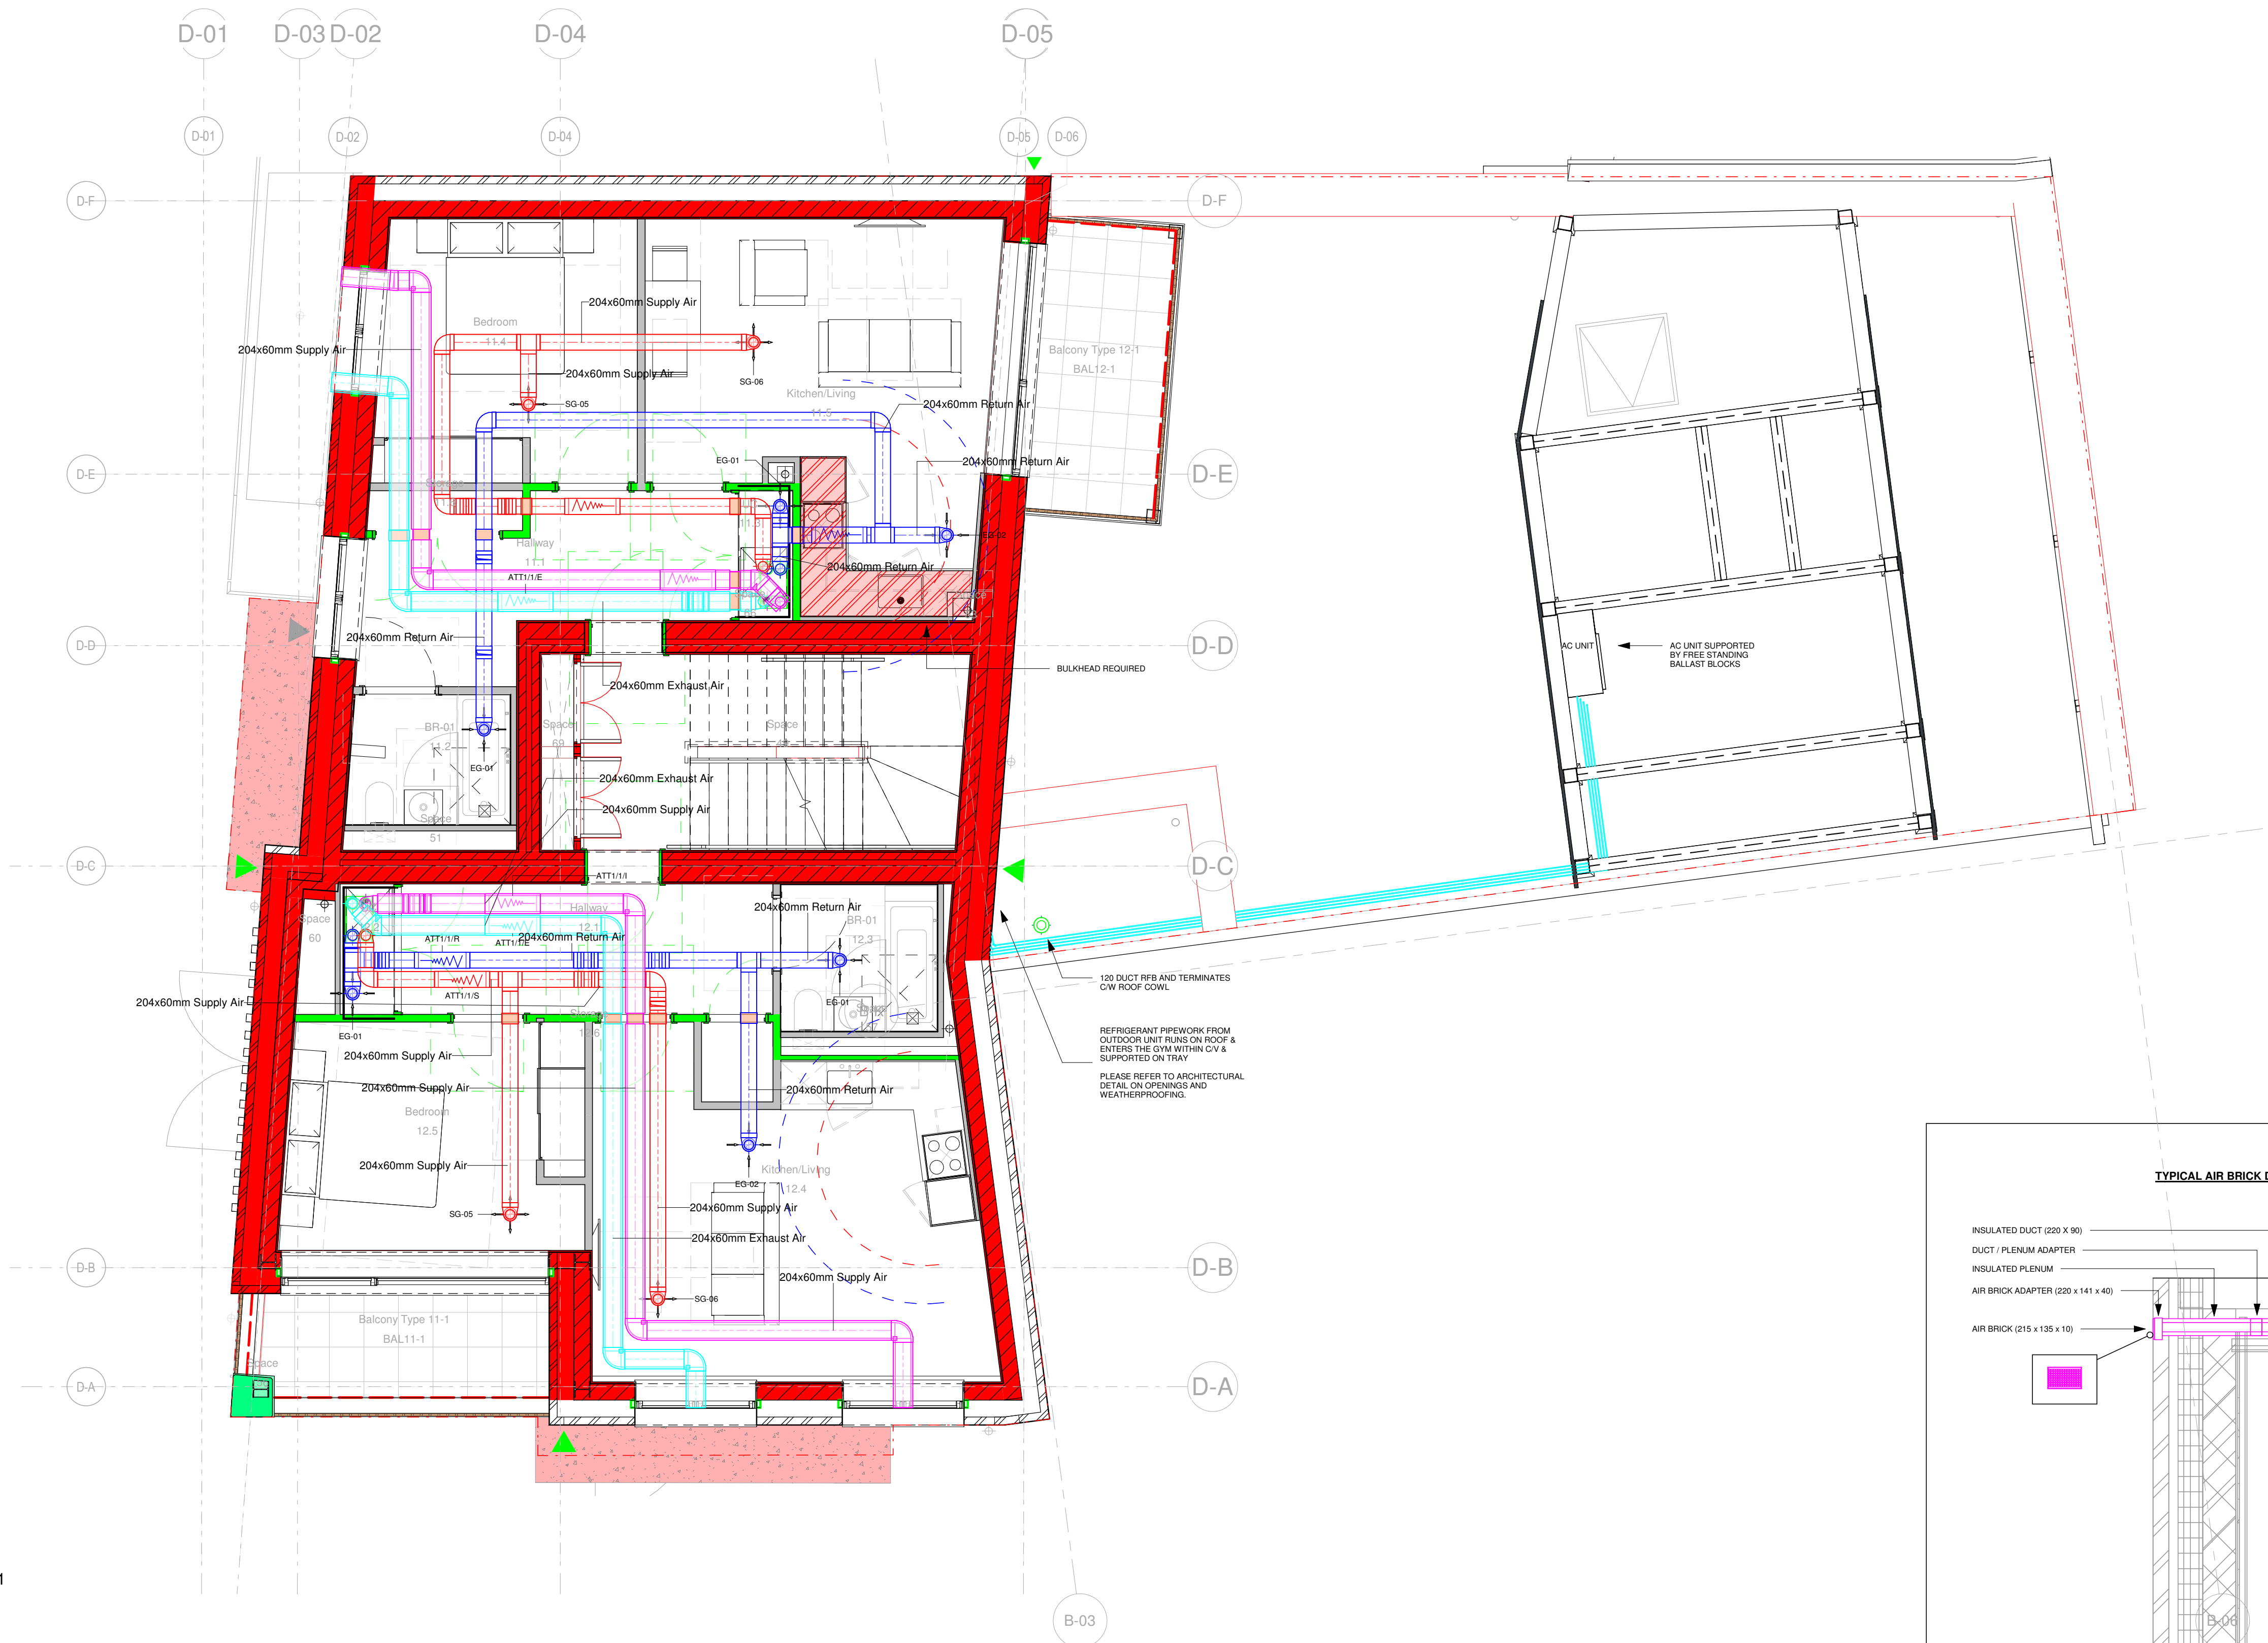


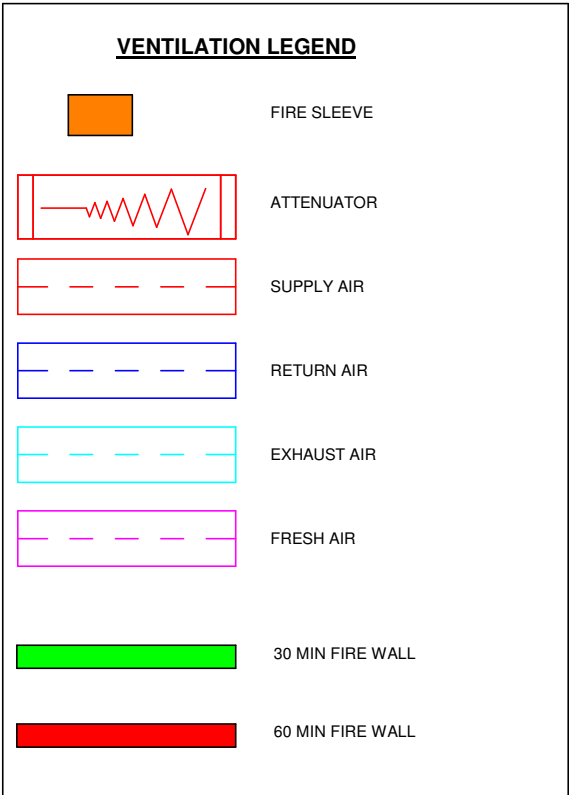

1 Vent Level 1
1:50

REV	DESCRIPTION	DRN	CKD	DATE
ISSUE	AS INSTALLED			STATUS A1

Harvey

FIRST CLASS SERVICES

NATURALLY INNOVATIVE CONSULTING ENGINEERS

ISO 9001
ISO 14001
OHSA 18001
Registered

Belfast +44 (0)28 90331700
Castleblayney +353 (0)42 9749570
www.semplemckillop.com
admin@semplemckillop.com

PROJECT TITLE
HIGHGATE NEWTOWN COMMUNITY CENTRE - BLOCK D

DRAWING TITLE
VENTILATION INSTALLATION
FIRST FLOOR

DRAWING REFERENCE
HNC-SMK-D-01-DR-M-5401

DRN
KB

SCALE
A1 As indicated