
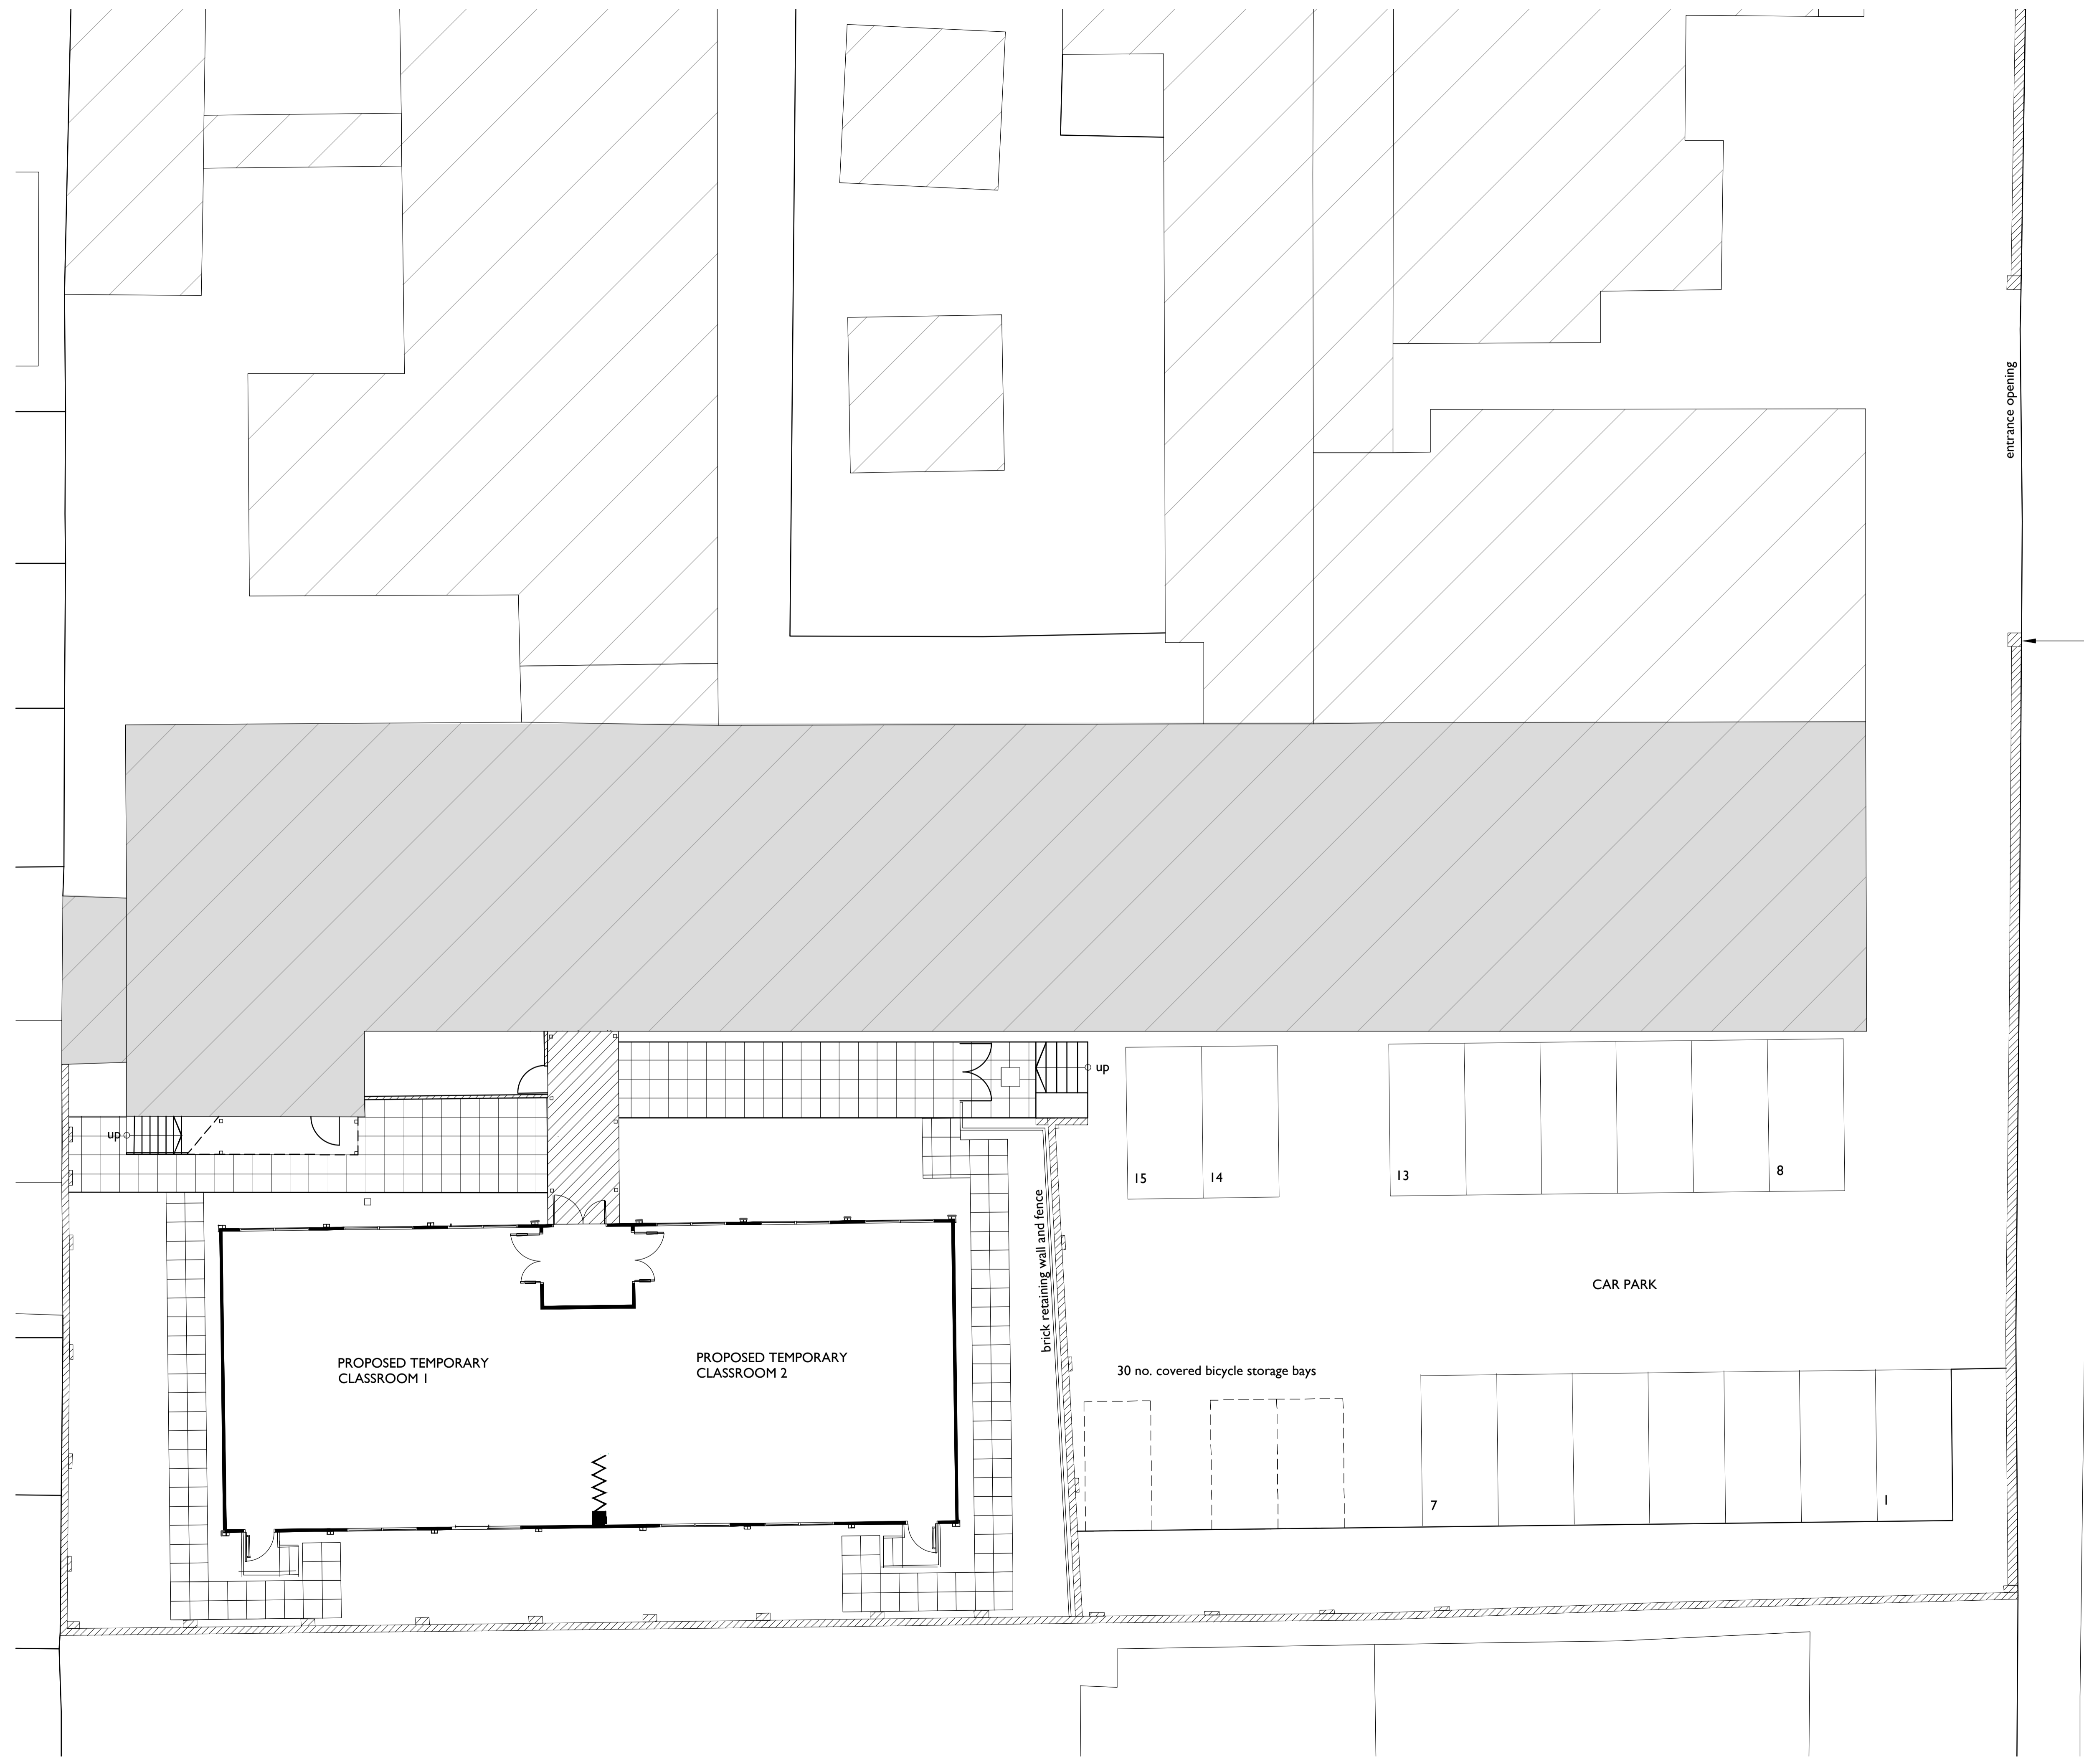


**THESE NOTES ARE IMPORTANT**  
 If you are in any doubt about something - ASK  
 This drawing must be read in conjunction with all necessary architectural, structural, services drawings and scope of works  
 This drawing is copyright protected and unless specifically agreed with Markwick Architects can only be used for the project noted in the title box below.

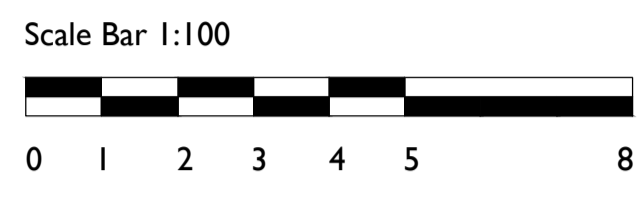

\* ISSUED FOR PLANNING 01.11.23 TC TM  
 REV. DESCRIPTION DATE DRN CHKD.

**MARKWICK ARCHITECTS**  
 THE OLD DAIRY  
 51a ST. PETERS STREET  
 SOUTH CROYDON SURREY CR2 7DG  
 TELEPHONE 020 8686 2955  
 E-MAIL ma@markwickarchitects.co.uk

CLIENT  
**ESCP European Business School**

PROJECT  
**527, Finchley Road  
 London NW**

DRAWING TITLE  
**As Built  
 Parsifal Road Entrance**

DATE August 2023	SCALE 1:100 @ AI
---------------------	---------------------

DRAWING NUMBER 2213 / P / 633	DRAWING REVISION *
----------------------------------	-----------------------

DRAWN BY TC	CHECKED BY TM
----------------	------------------