


PRE - EXISTING PARSIFAL ROAD ENTRANCE

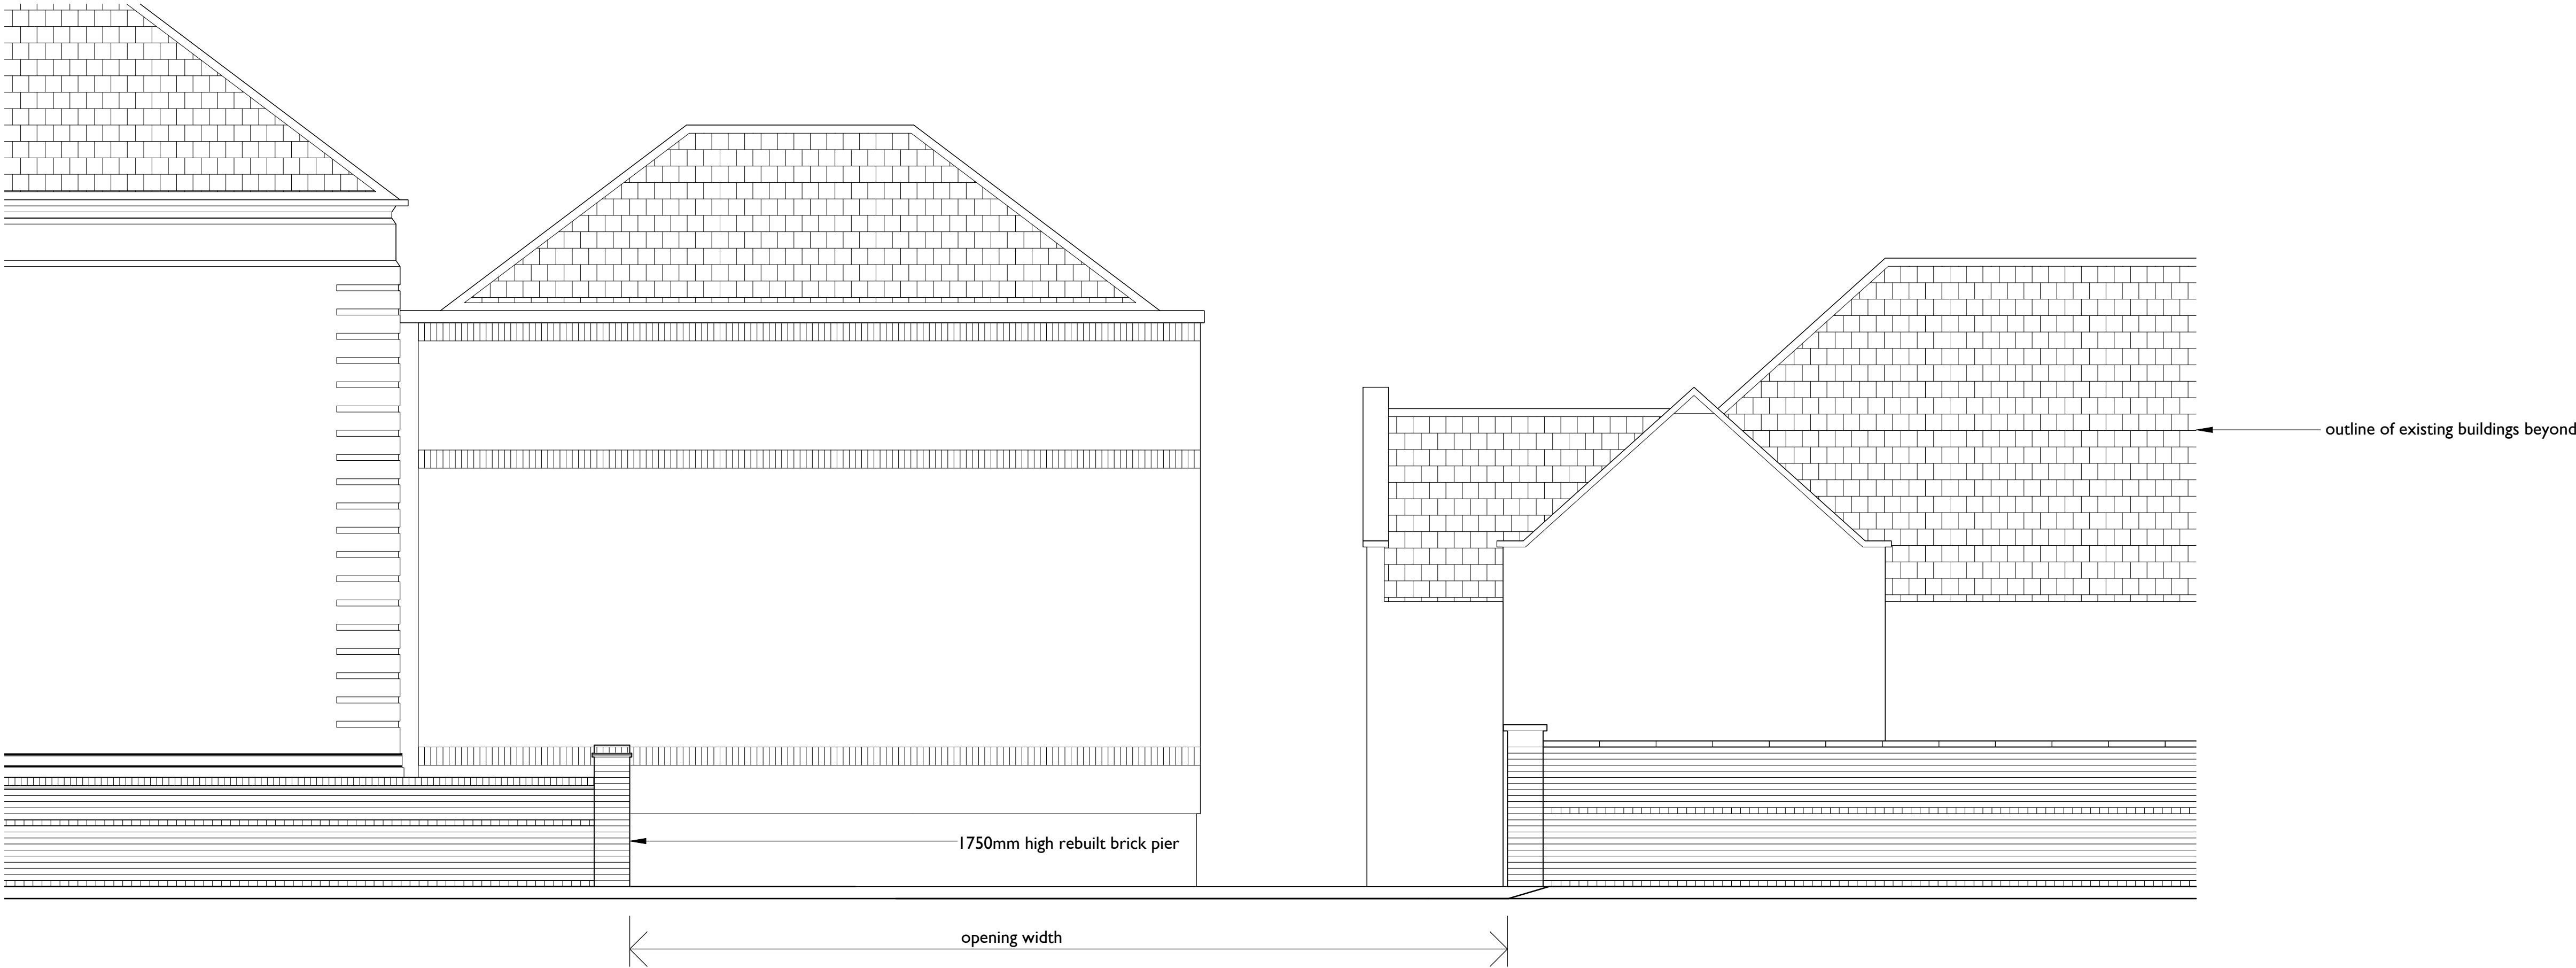


AS BUILT PARSIFAL ROAD ENTRANCE

THESE NOTES ARE IMPORTANT

If you are in any doubt about something - ASK

This drawing must be read in conjunction with all necessary architectural, structural, services drawings and scope of works

This drawing is copyright protected and unless specifically agreed with Markwick Architects can only be used for the project noted in the title box below.

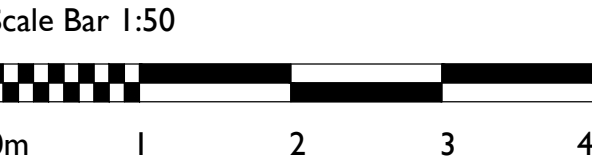

A	Height of brick pier indicated	24.11.23	TM	TM
*	ISSUED FOR PLANNING	01.11.23	OE	TM
REV.	DESCRIPTION	DATE	DRN	CHKD.

M A R K W I C K
A R C H I T E C T S

T H E O L D D A I R Y
5 1 a S T . P E T E R S S T R E E T
S O U T H C R O Y D O N S U R R E Y C R 2 7 D G
T E L E P H O N E 0 2 0 8 6 8 6 2 9 5 5
E - M A I L m a @ m a r k w i c k a r c h i t e c t s . c o . u k

CLIENT

ESCP Europe Busines School

PROJECT

527 Finchley Road
London, NW3 7BG

DRAWING TITLE

Pre Existing & As Built
Parsifal Road Entrance Elevation

DATE	SCALE
August 2023	1:50 @ A1
DRAWING NUMBER	DRAWING REVISION
2213 / P / 635	A
DRAWN BY	CHECKED BY
TC	TM