



Condition 25- Bird Boxes
Swift and Starling Boxes

2 3x Swift boxes Located on the north facade of Block B2. Swift box, stretcher bond brick fronted.

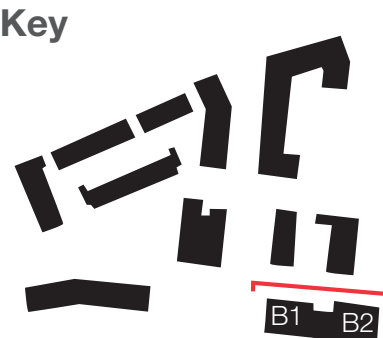


3 3x Starling boxes Located on the north facade of Block B1. Starling bird box, stretcher bond brick fronted.

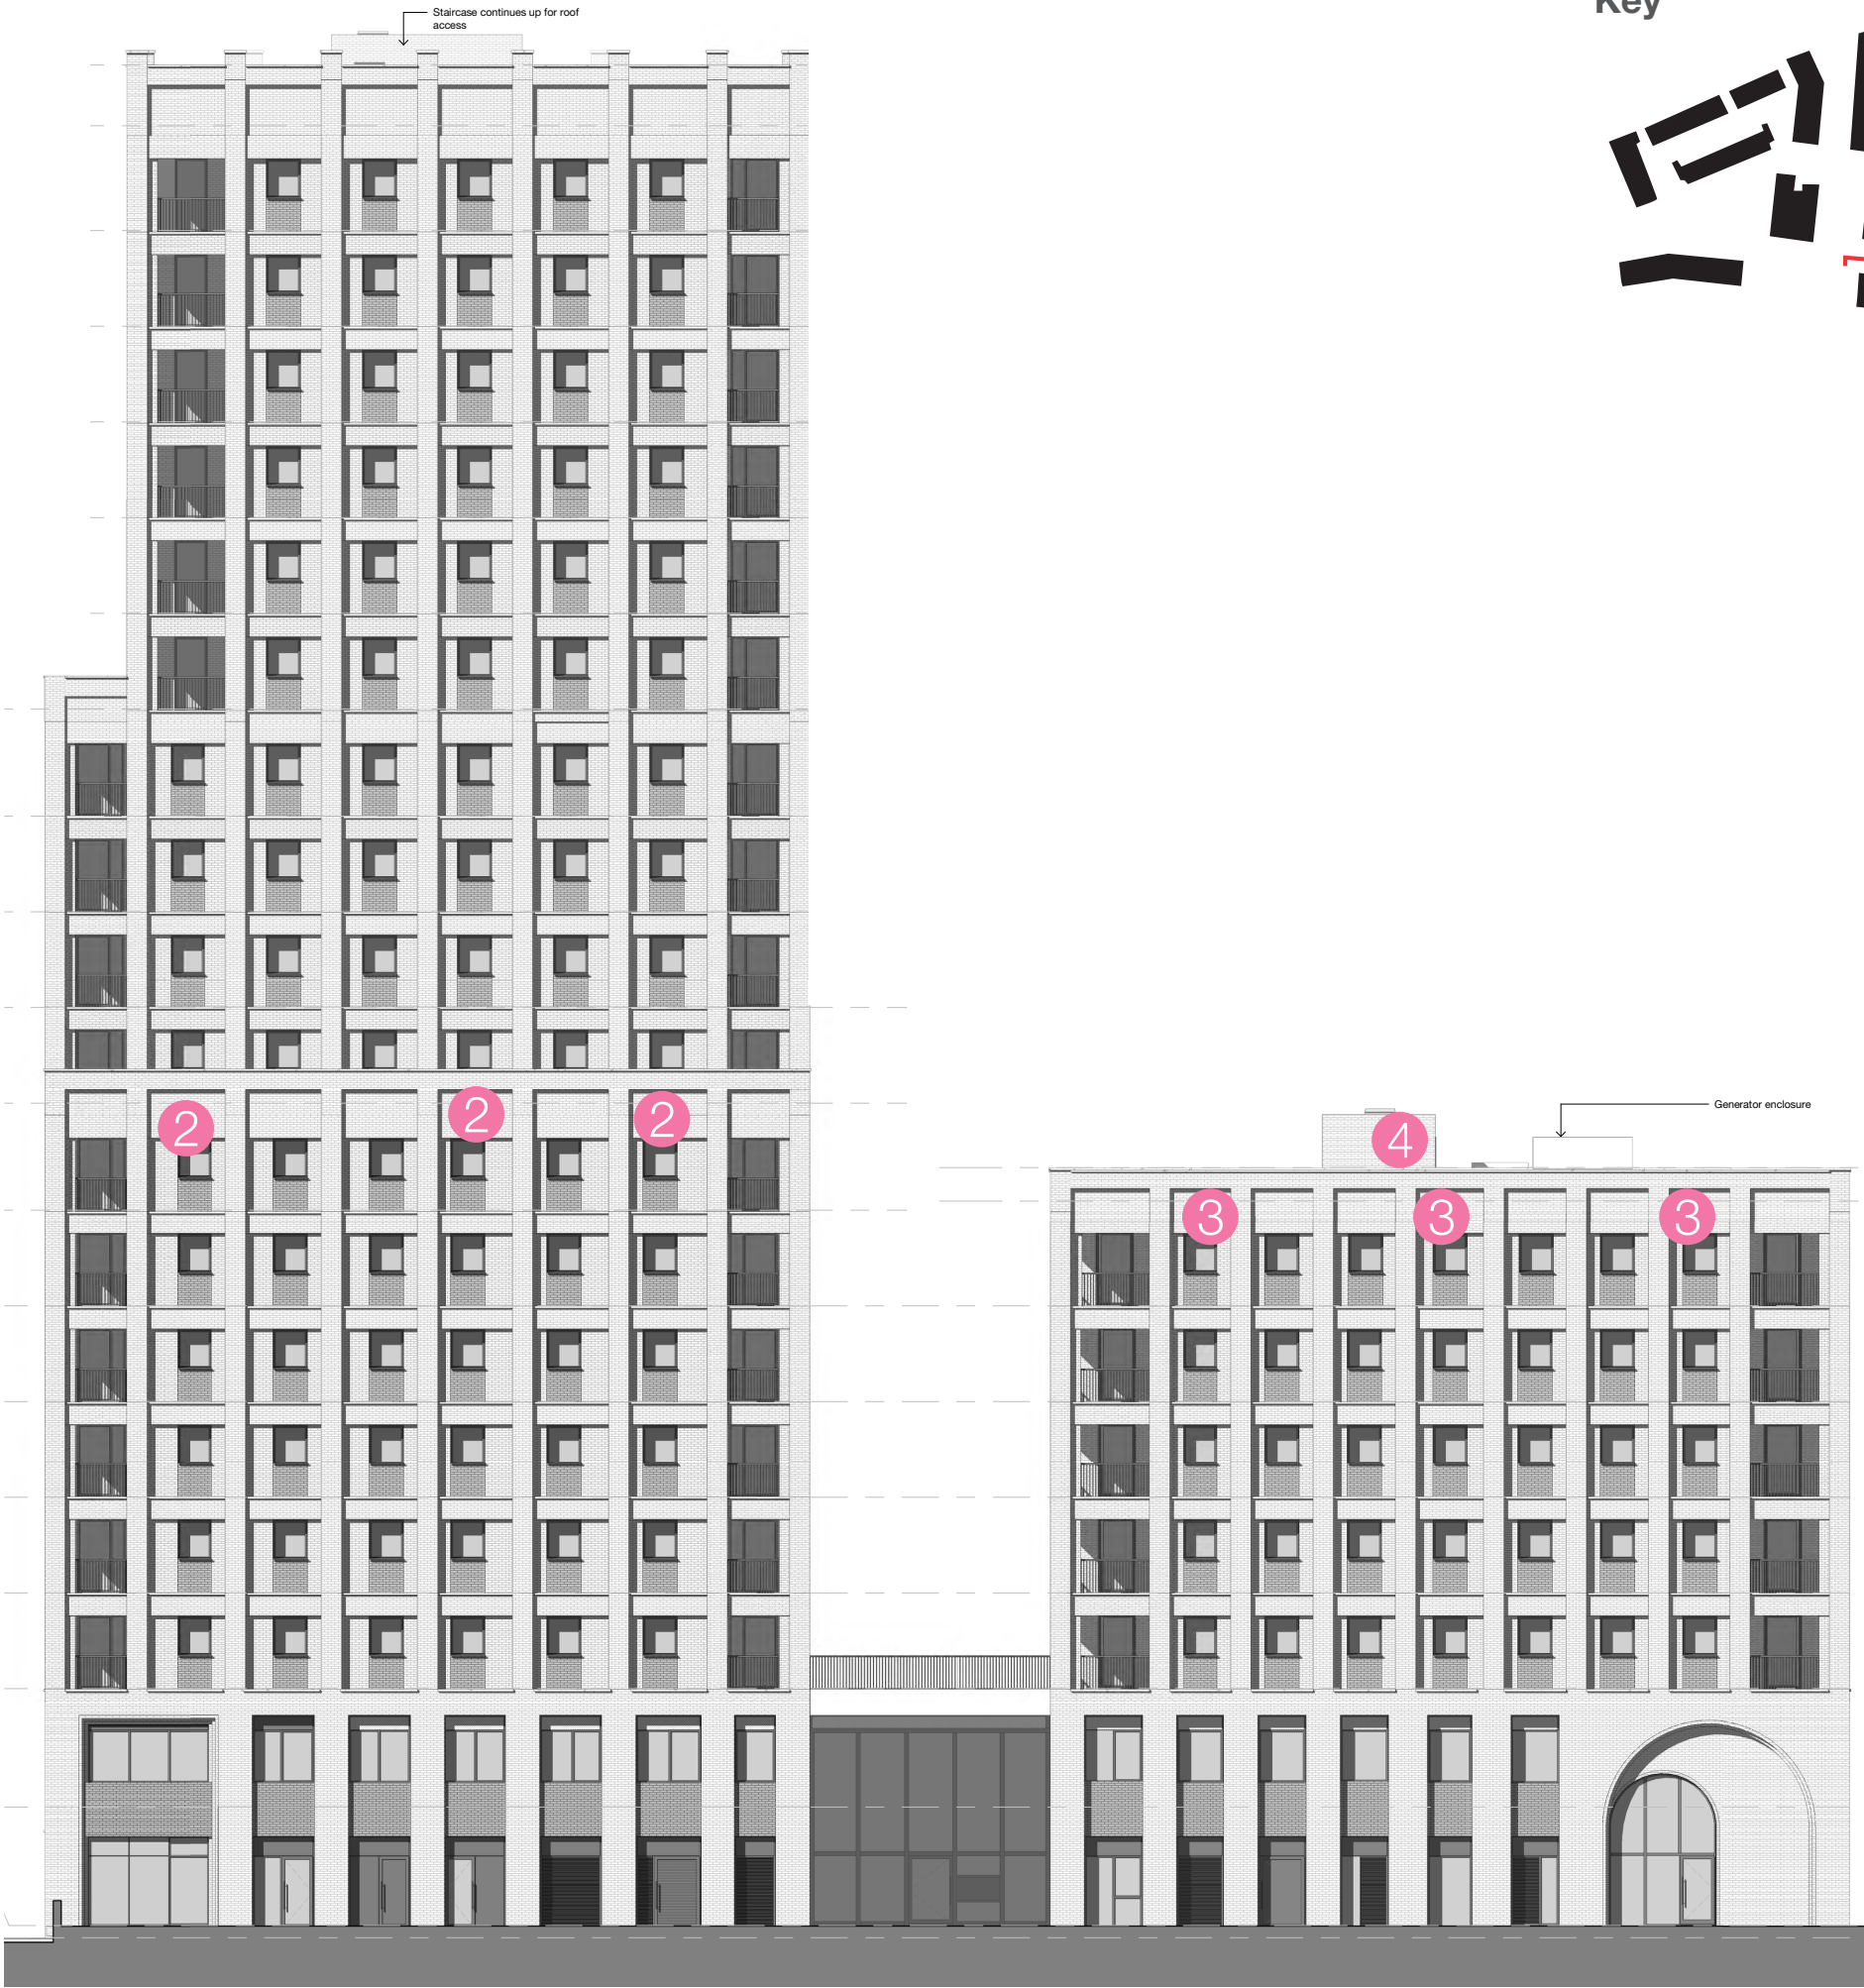

Condition 25- Bird Boxes
Black Redstart Boxes

- 4 3 x Black redstart boxes- Located on the roof of block B1. Laid into the side of the stair overrun brickwork.
- Bird Brick Houses - Sparrow terrace box stretcher bond brick fronted, suitable for black redstarts.

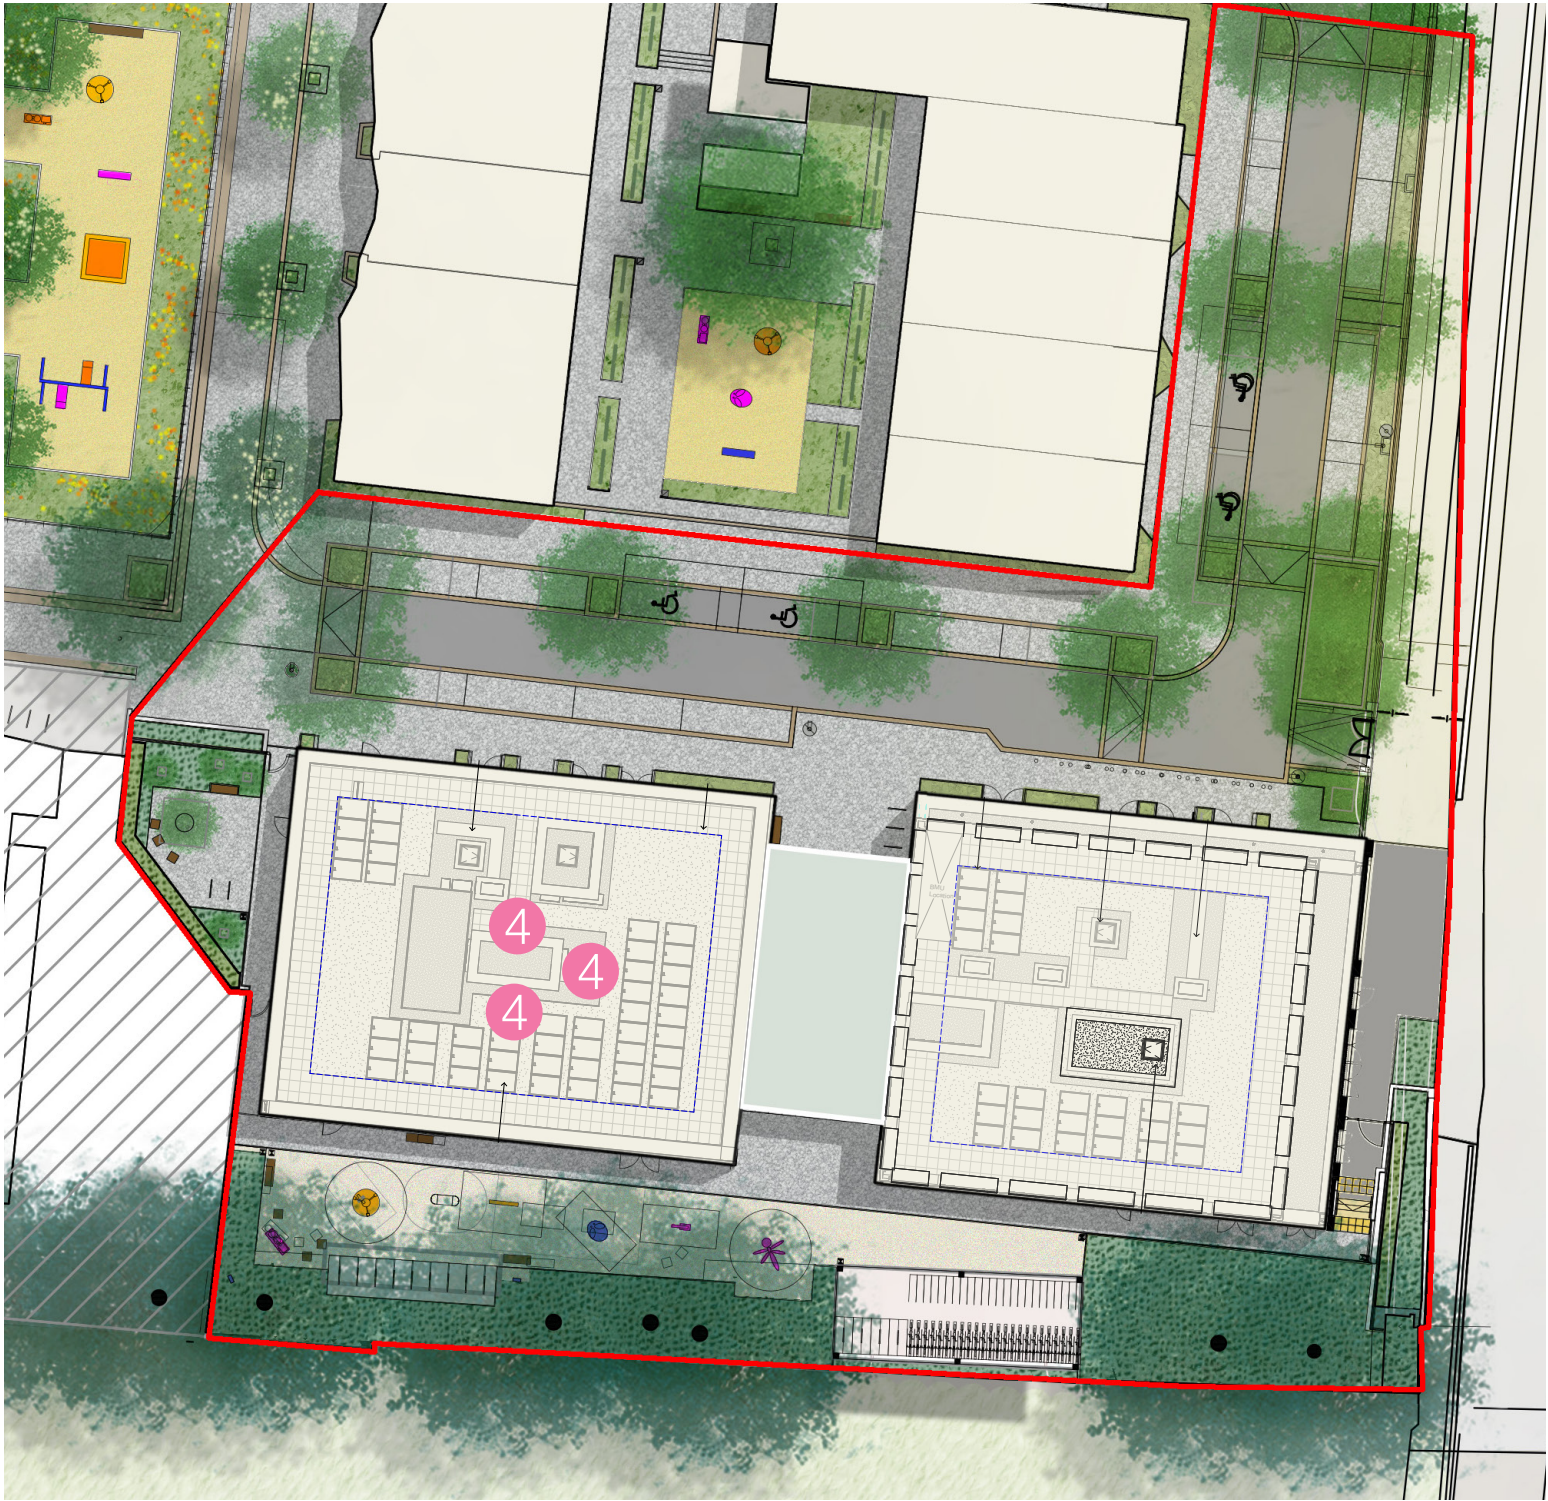

- Red Line Boundary
- X Location of black redstart nesting box