

- DO NOT SCALE. USE FIGURED DIMENSIONS ONLY - CONFIRM ALL DIMENSIONS AND LEVELS ON SITE

The London Tunnels
40 Furnival Street Structural Visit
WSP | 70087403 | DDNS 020.1 | JSP | 12.09.23

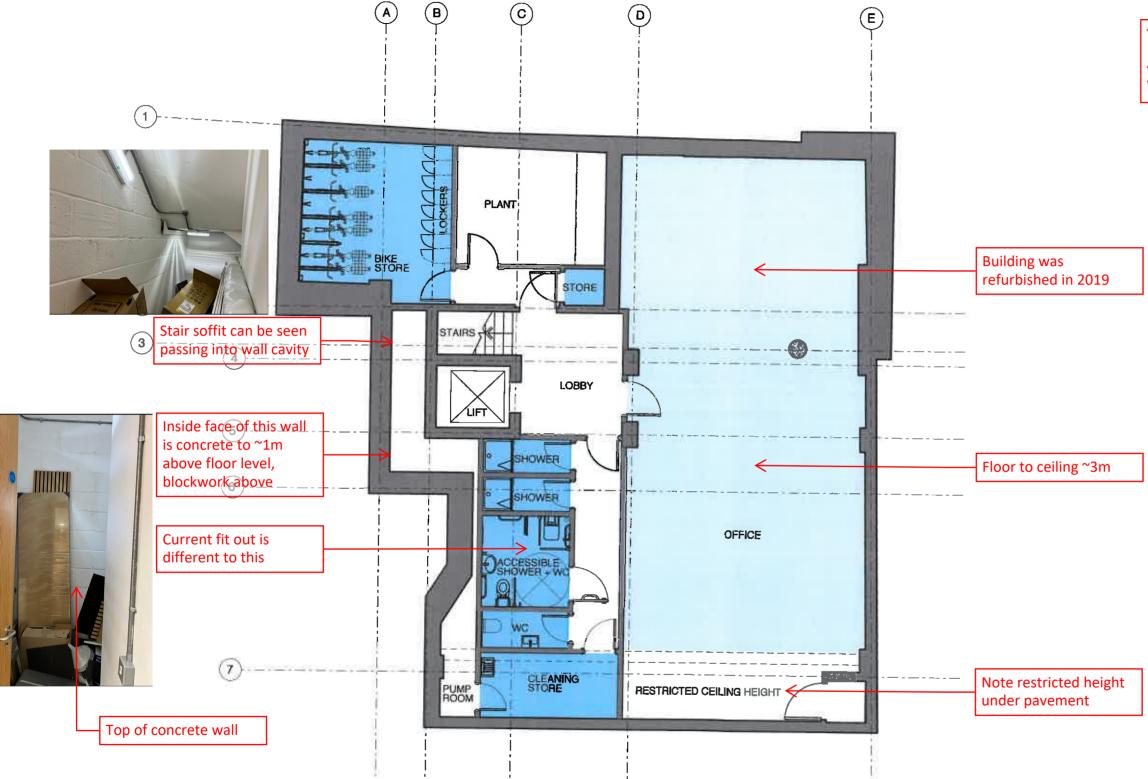


3 5 MUV 2013

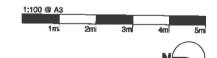



THE MANSER PRACTICE	
Bridge Studies Hammeramith Bridge London W6 BDA	Telephone +44 (9)20 8741 4361 Faceirolle +44 (0)20 8741 2773 Email marser @marser.co.uk Website www.ranneer.co.uk

W6 BDA			Watefly	manaer@manaer.co.uk		
	The second				_	
<u></u>					Т	
_					Т	
	1				Т	
<u> </u>	-	<u> </u>				
-	1	<u> </u>				
	—	<u> </u>				
<u> </u>	1	<del> </del>				
⊢—	<u> </u>	<del> </del>				
_	+	ļ			_	
E	23.11.16				_	
Ę-	-	PLANNING ISSU				
-	10.08,15 27.07,15	GENERAL UPDA		<del>_</del>		
-	24.07.15	GENERAL UPDA				
В	11.05.15	GENERAL UPDA			_	
_	09.06.15	GENERAL UPDA			_	
Revision		Notes	iic .		_	
	Date	THOUSE			4	
PLA	NNING	3				
Project 40-41	FURNIV	AL STREET			8	
PROP	OSED B	ASEMENT P	LAN		CAD (Te 1310/PLOTF), P. P. 9/1310, pas, PO	
Scale 1:50 @	A1		Date MAY 2	015	10/PLOTFIL	
Drawing m 1310_(			Revision F	-	CAD age 13	

- DO NOT SCALE. USE FIGURED DIMENSIONS ONLY - CONFIRM ALL DIMENSIONS AND LEVELS ON SITE

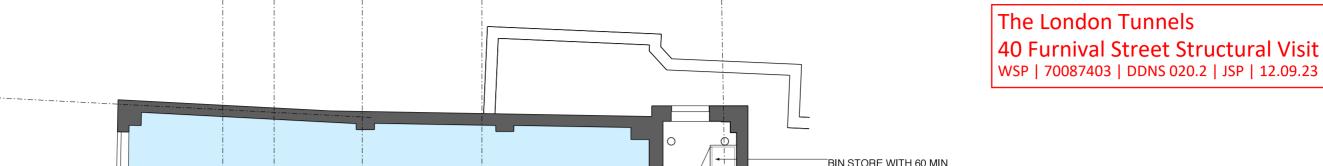

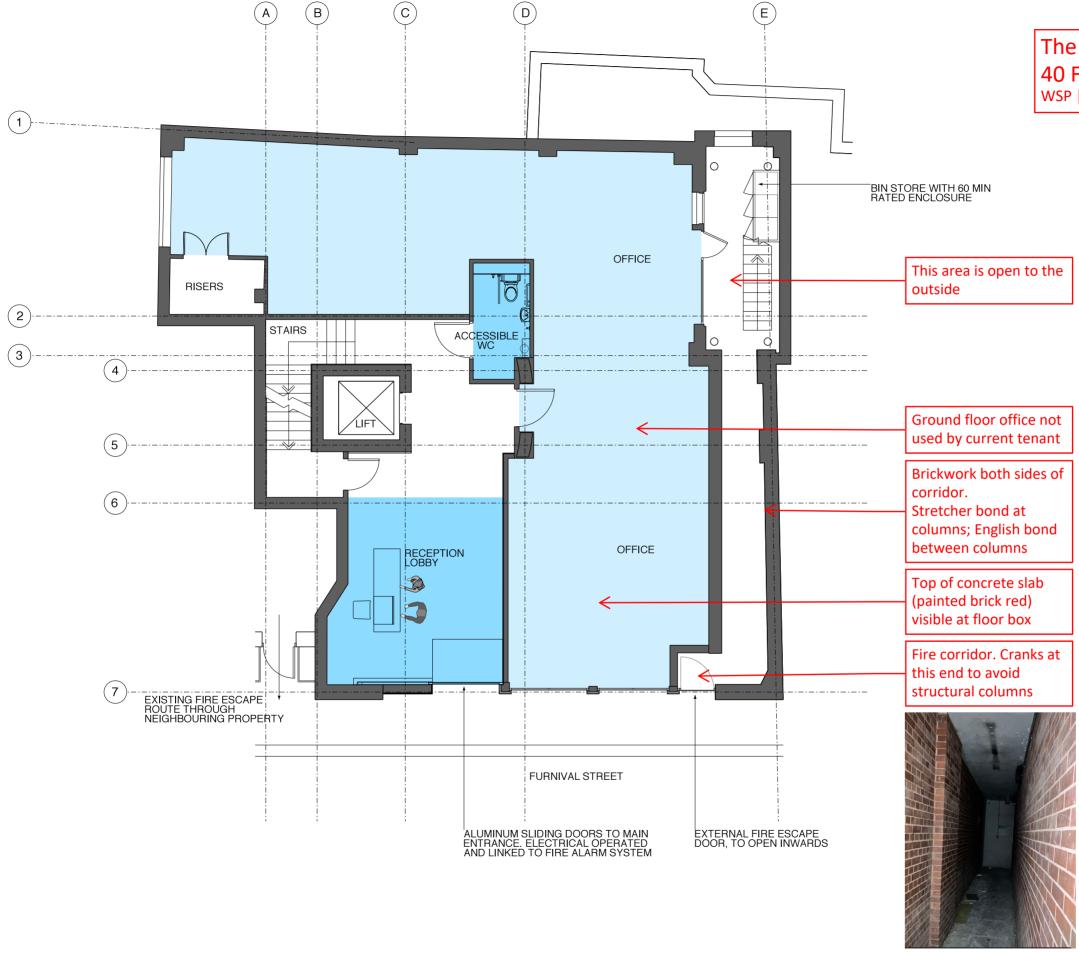

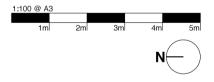

Telephone +44 (0)20 8741 4381 Hammersmith Bridge

L	15.01.16	AMENDMENT TO DOOR
K	23.11.15	PLANNING ISSUE
J	10.08.15	GENERAL UPDATE
Н	06.08.15	GENERAL UPDATE
G	24.07.15	GENERAL UPDATE
F	17.07.15	GENERAL UPDATE
E	07.07.15	GENERAL UPDATE
D	06.07.15	GENERAL UPDATE
С	03.07.15	GENERAL UPDATE
В	11.06.15	GENERAL UPDATE
А	09.06.15	GENERAL UPDATE
Revision	Date	Notes


Drawing number 1310\_030

40-41 FURNIVAL STREET	
Drawing PROPOSED GROUND FLO	OOR PLAN
Scale 1:50 @ A1	Date MAY 2015

- DO NOT SCALE, USE FIGURED DIMENSIONS ONLY - CONFIRM ALL DIMENSIONS AND LEVELS ON SITE




Ontwing number 1310\_031

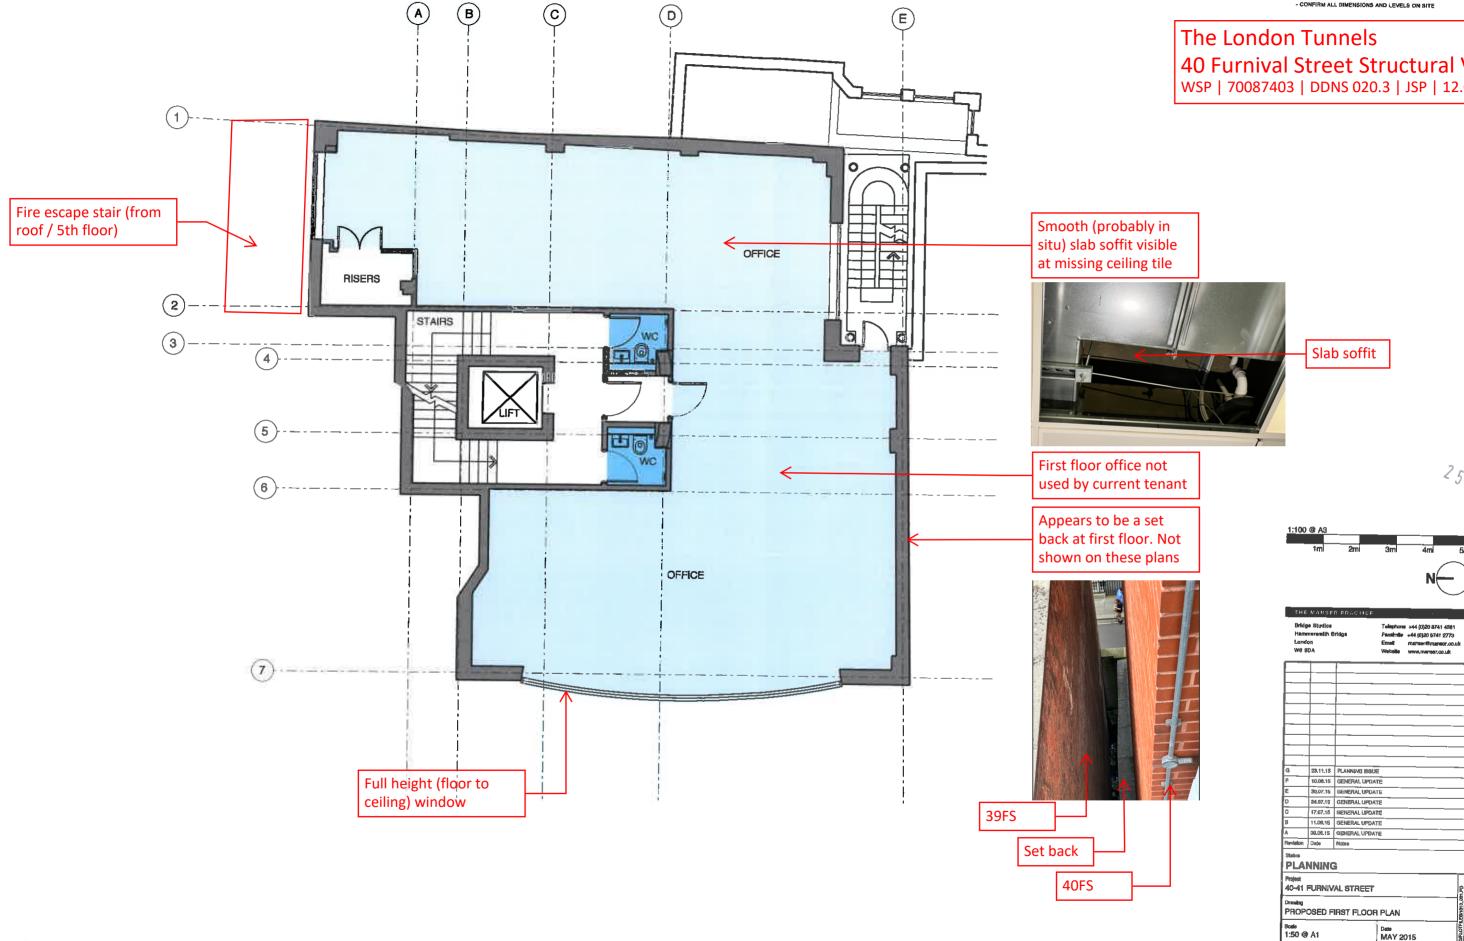


- DO NOT SCALE. USE FIGURED DIMENSIONS ONLY - CONFIRM ALL DIMENSIONS AND LEVELS ON SITE


40 Furnival Street Structural Visit WSP | 70087403 | DDNS 020.4 | JSP | 12.09.23

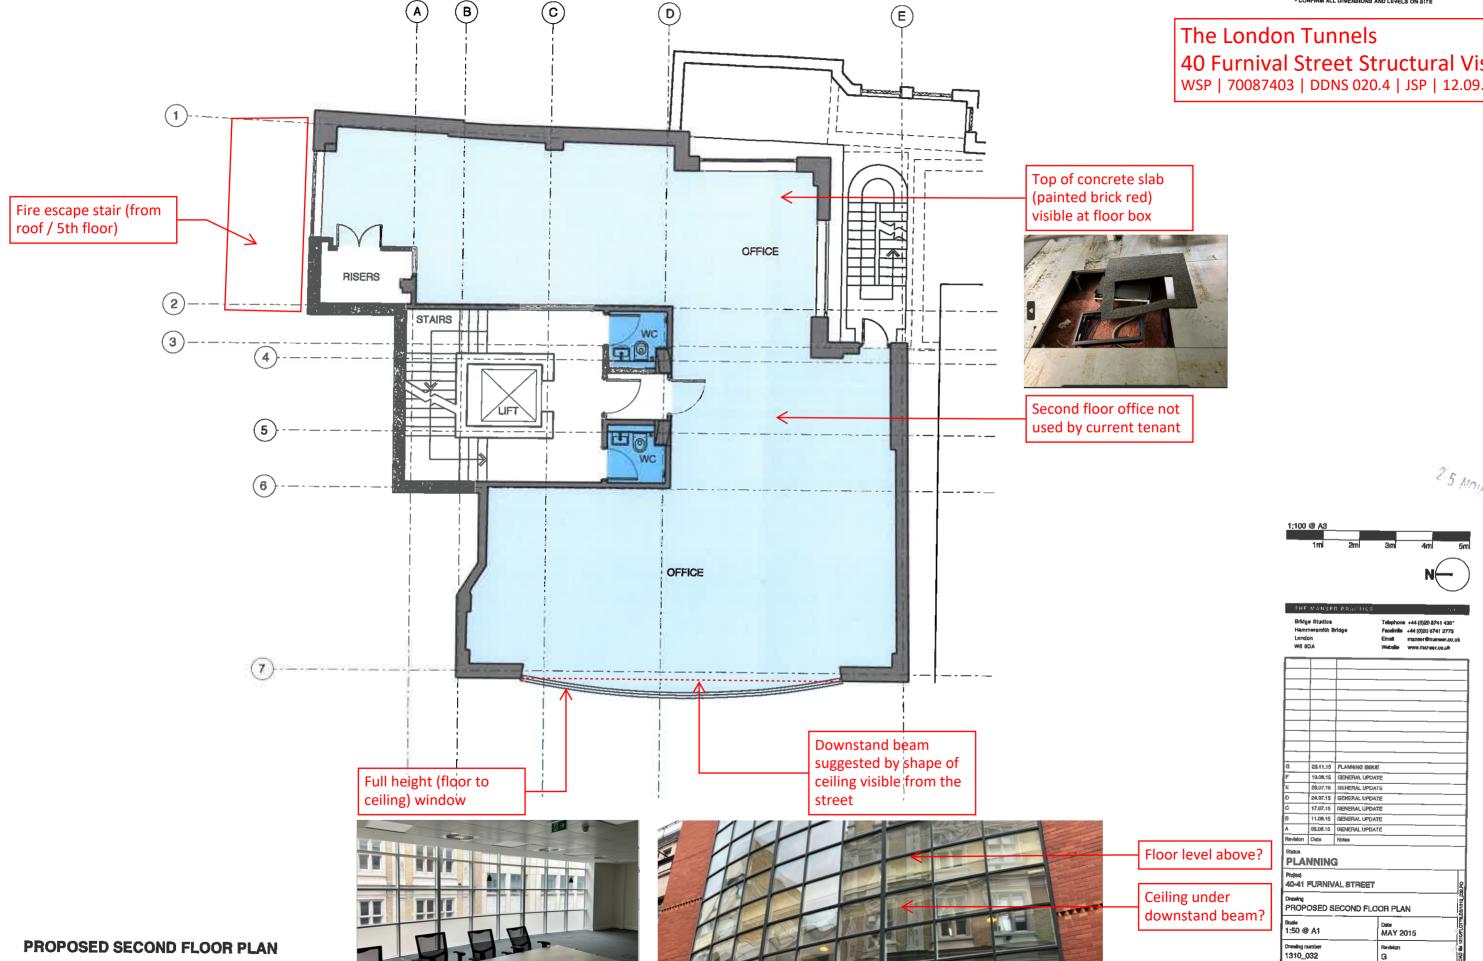

- DO NOT SCALE. USE FRUIRED DIMENSIONS ONLY - CONFIRM ALL DIMENSIONS AND LEVELS ON SITE

# The London Tunnels 40 Furnival Street Structural Visit WSP | 70087403 | DDNS 020.5 | JSP | 12.09.23

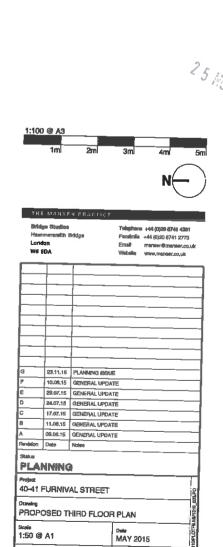


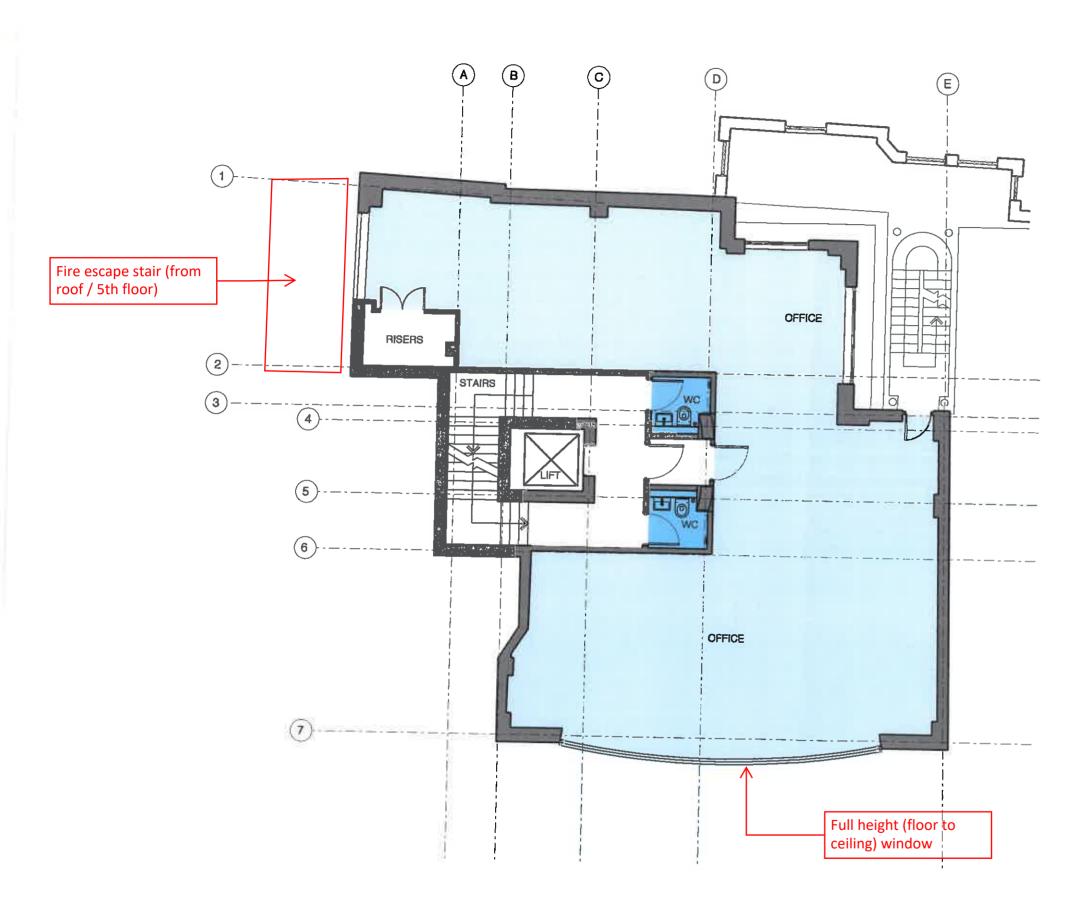


### PROPOSED THIRD FLOOR PLAN

- DO NOT SCALE. USE FIGURED DIMENSIONS ON

The London Tunnels
40 Furnival Street Structural Visit
WSP | 70087403 | DDNS 020.6 | JSP | 12.09.23

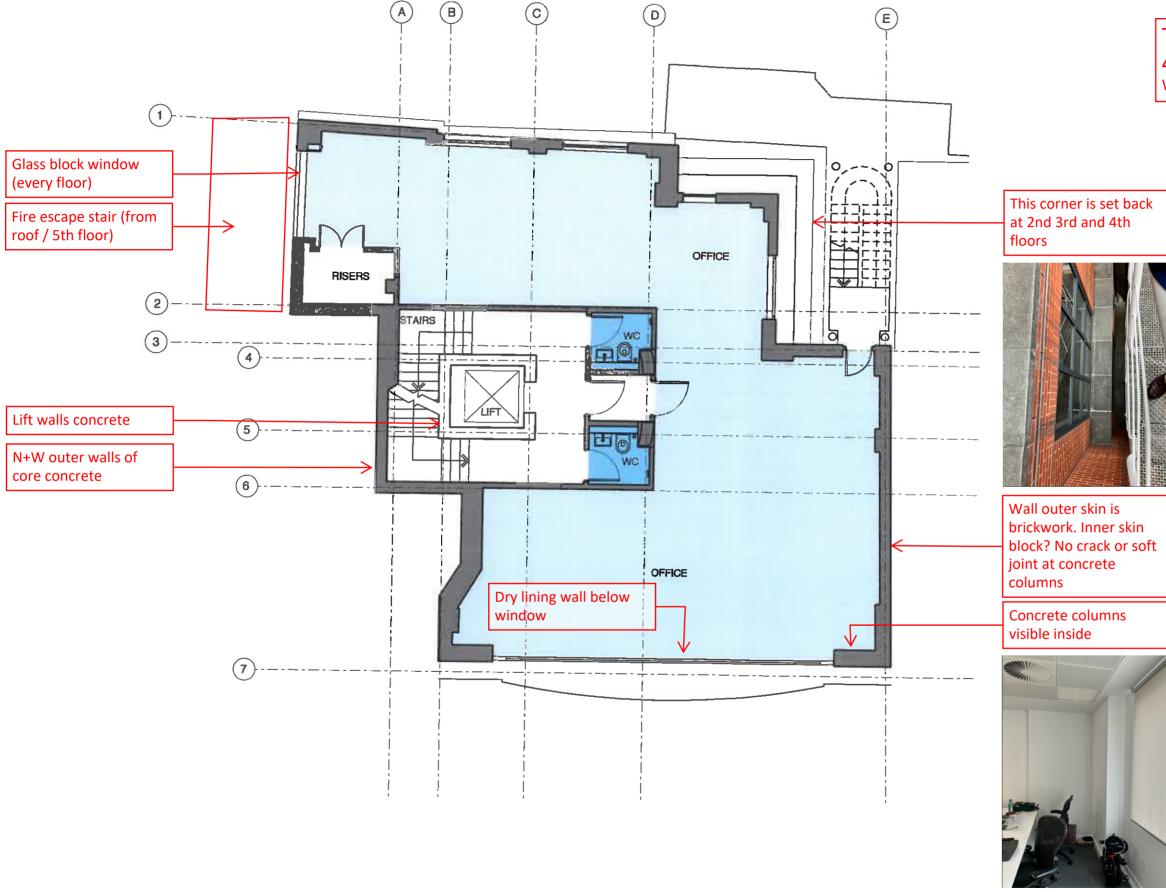

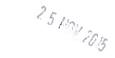






	<u> </u>	
	↓	
	<u> </u>	
	<u> </u>	
a	29,11,19	PLANNING ISSUE
F	10.08.15	GENERAL UPDATE
E	29,07,15	GENERAL UPDATE
0	24.07.15	GENERAL UPDATE
0	17,07.15	GENERAL UPDATE
в	11.05.15	GENERAL UPDATE
١ .	09.06.15	GENERALUPDATE
noletveF	Date	Notes
Stalus		
PLAI	NNING	ì

Project 40-41 FURNIVAL STREET


PROPOSED FOURTH FLOOR PLAN

- DO NOT SCALE. USE FIGURED DIMENSIONS ONLY - CONFIRM ALL DIMENSIONS AND LEVELS ON SITE

The London Tunnels
40 Furnival Street Structural Visit
WSP | 70087403 | DDNS 020.7 | JSP | 12.09.23

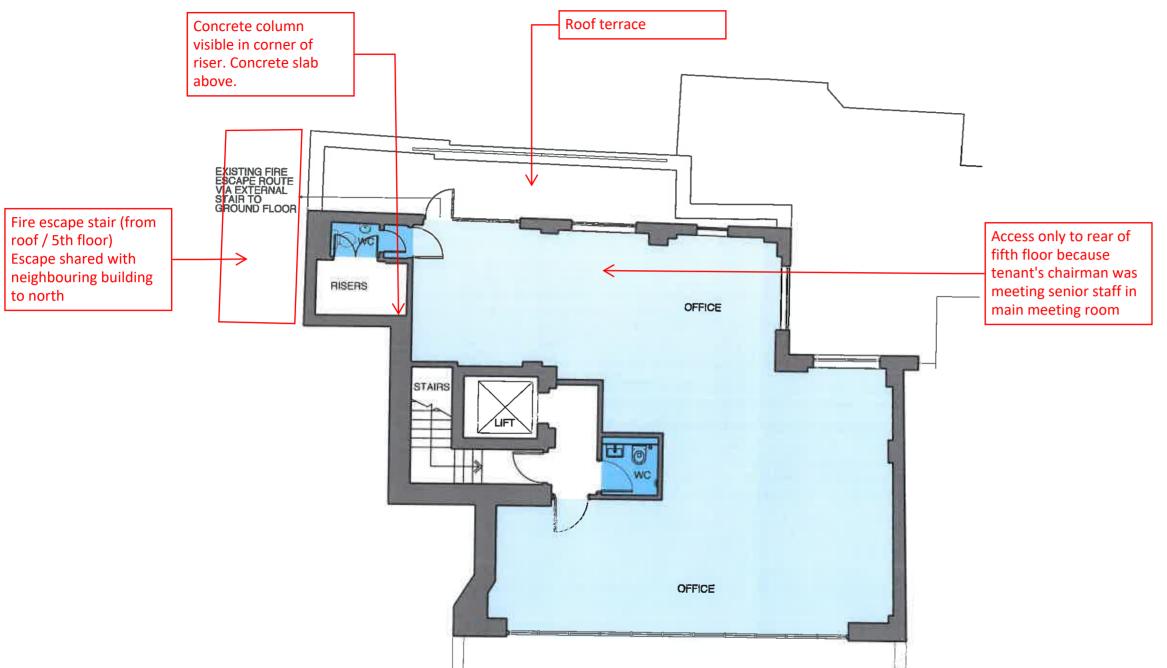

25 MOV 2015

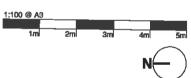

		Tulisphore +44 (0)20 8741 4361 Pridge Fechinile +44 (0)20 8741 2773 Emel mirmer@maner.co.uk Weballe www.maner.co.uk
$\vdash$	<b>├</b>	
<u> </u>	┼	
$\vdash$	-	
$\vdash$	├─-	
├	-	ļ
<u> </u>	<del>-</del>	
$\vdash$	-	
<u> </u>	<del>-</del>	
H	23.11.15	PLANNING ISSUE
g	10,08,15	GENERAL UPDATE
F	24,07,15	GENERAL UPDATE
E	17.07.15	GENERAL UPDATE
D	05.07,15	GENERAL UPDATE
C	12.06.16	GENERAL UPDATE
В	11.06,15	GENERAL UPDATE
A	09.06.15	GENERAL UPDATE
Revision	Date	Notes
9kba PLAI	NNINC	
Project 40-41	FURNIV	AL STREET &

MAY 2015


PROPOSED FIFTH FLOOR PLAN


Scale 1:50 @ A1

Drawing number 1310\_035

- DO NOT SCALE. USE FIGURED DIMENSIONS ONLY - CONFIRM ALL DIMENSIONS AND LEVELS ON SITE

The London Tunnels
40 Furnival Street Structural Visit
WSP | 70087403 | DDNS 020.8 | JSP | 12.09.23

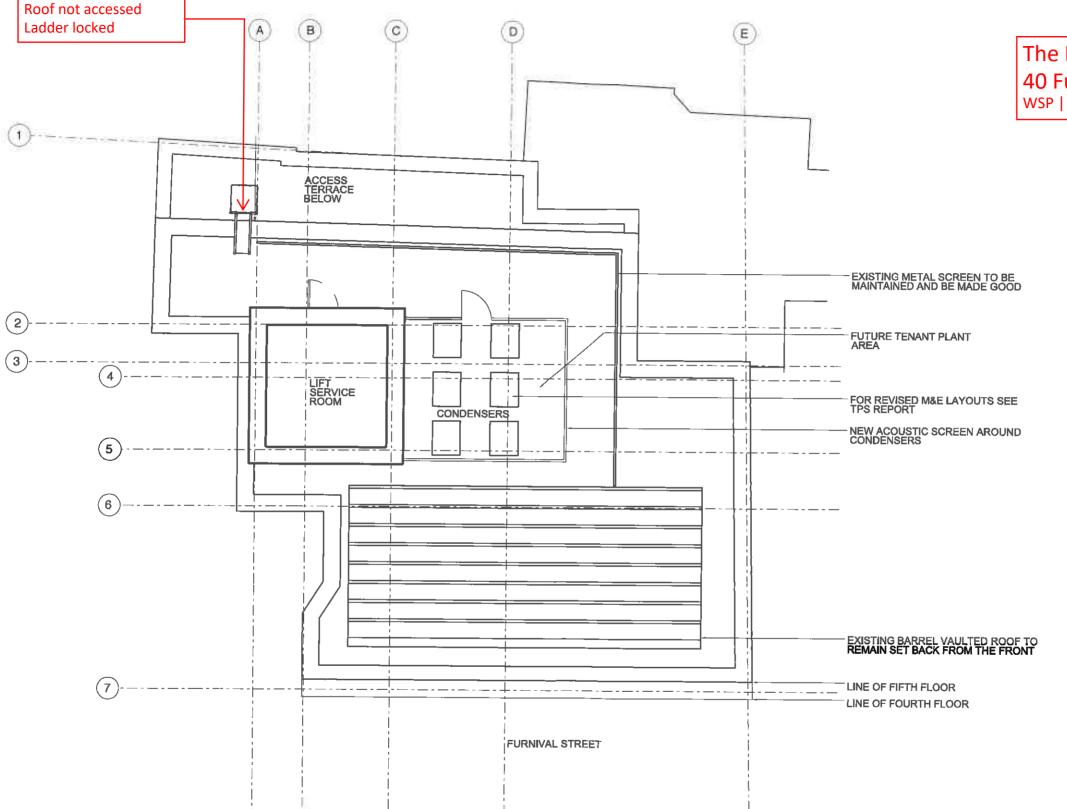

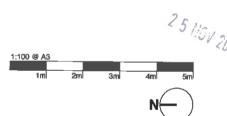



Hamir	Bridge Studios Hammeramith Bridge London W6 9DA			Telephone +44 (0)20 8741 4 Faceimile +44 (0)20 8741 2 Email marser@manser.co.: Website www.manser.co.:	
	₩.				
<b>-</b>	-				
_	<del> </del>				
	<del>                                     </del>	<del>                                      </del>		_	
_	<del></del>	-			
	_	<del>                                     </del>			
1	23.11.15	PLANNING (SSU)			
н	13.06.15	GENERAL UPDA	re		
G	10.06.15	GENERAL UPDA	ΓE		
F	07.07,15	GENERAL UPDA	ľE		
E	06.07.15	GENERAL UPDA	ΓE		
D	17.08.15	GENERAL UPDAT	re .		
C	16.06.15	GENERAL UPDAT	E		
В	11.06.15	GRID UPDATED			
A	09.06.15	GENERAL UPDAT	TE T		
Revision	Date	Notes			
Status PLA	NNING	3			
Project	FURNIV	'AL STREET			

MAY 2015

9cale 1:50 @ A1

Drawing number 1310\_036 The London Tunnels
Fulwood Place ground floor
Findings from site visit 27.06.23
70087403 | DDNS 005.1 | JSP | 28.06.23

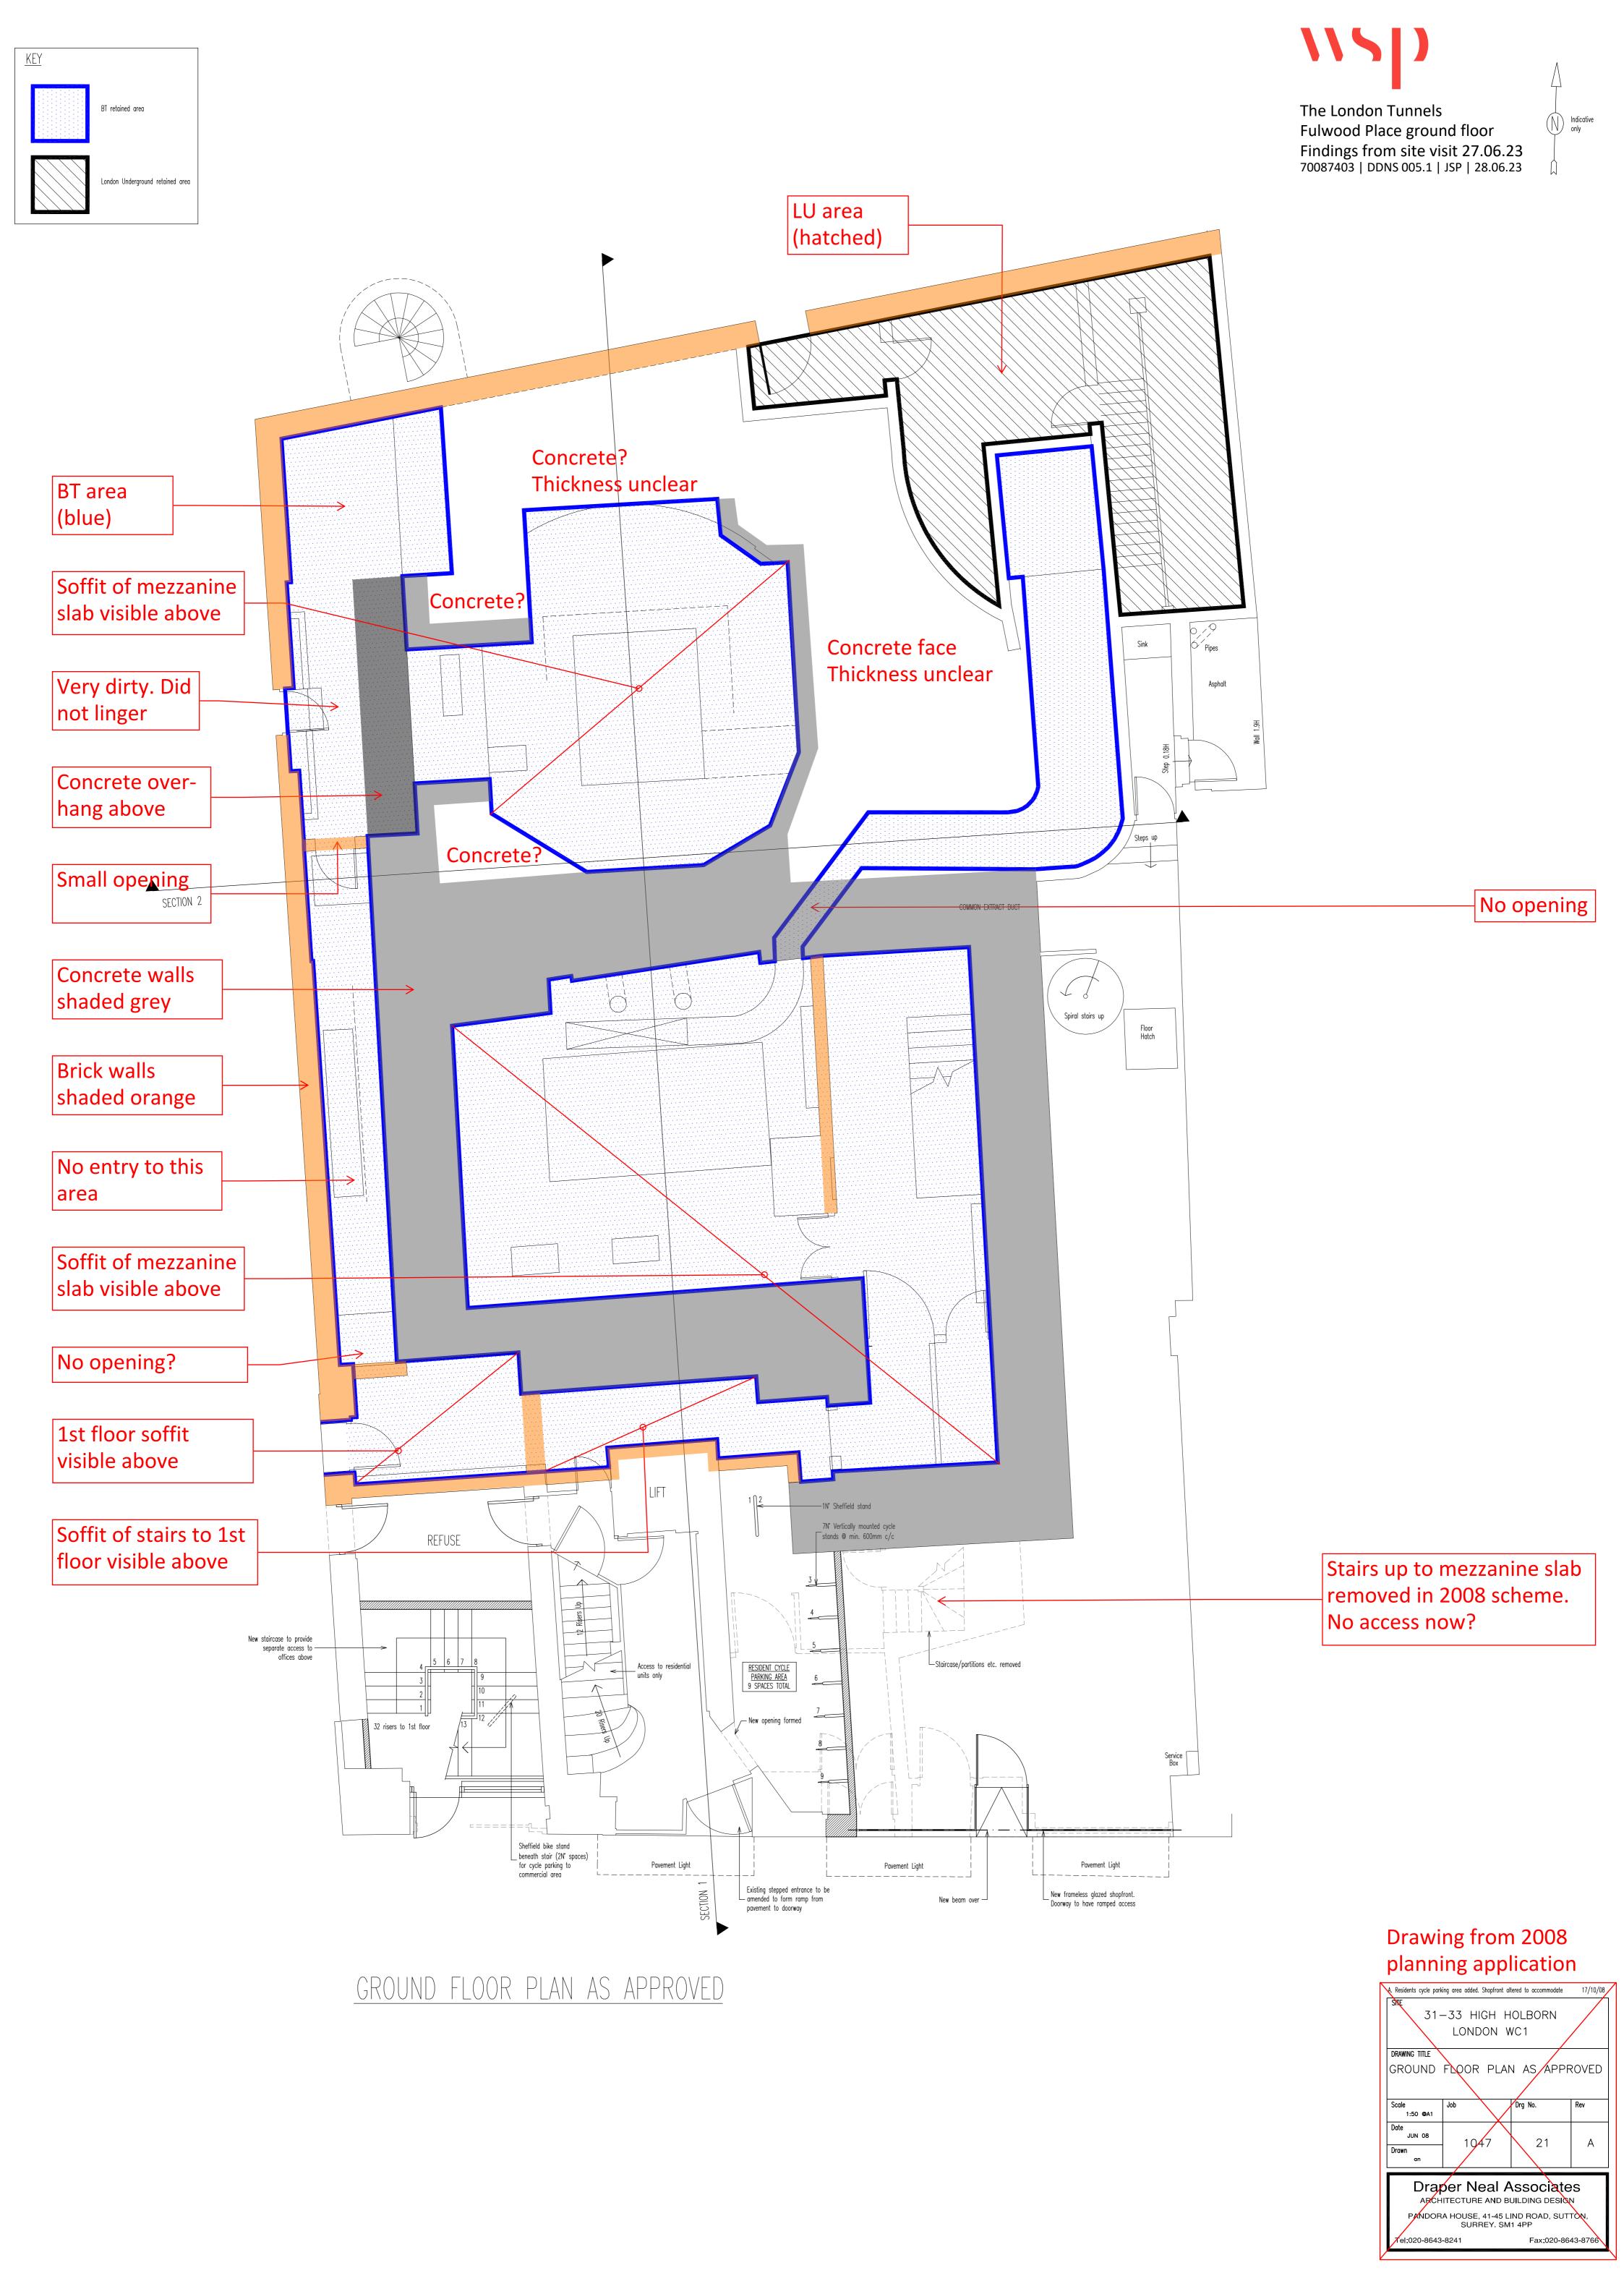

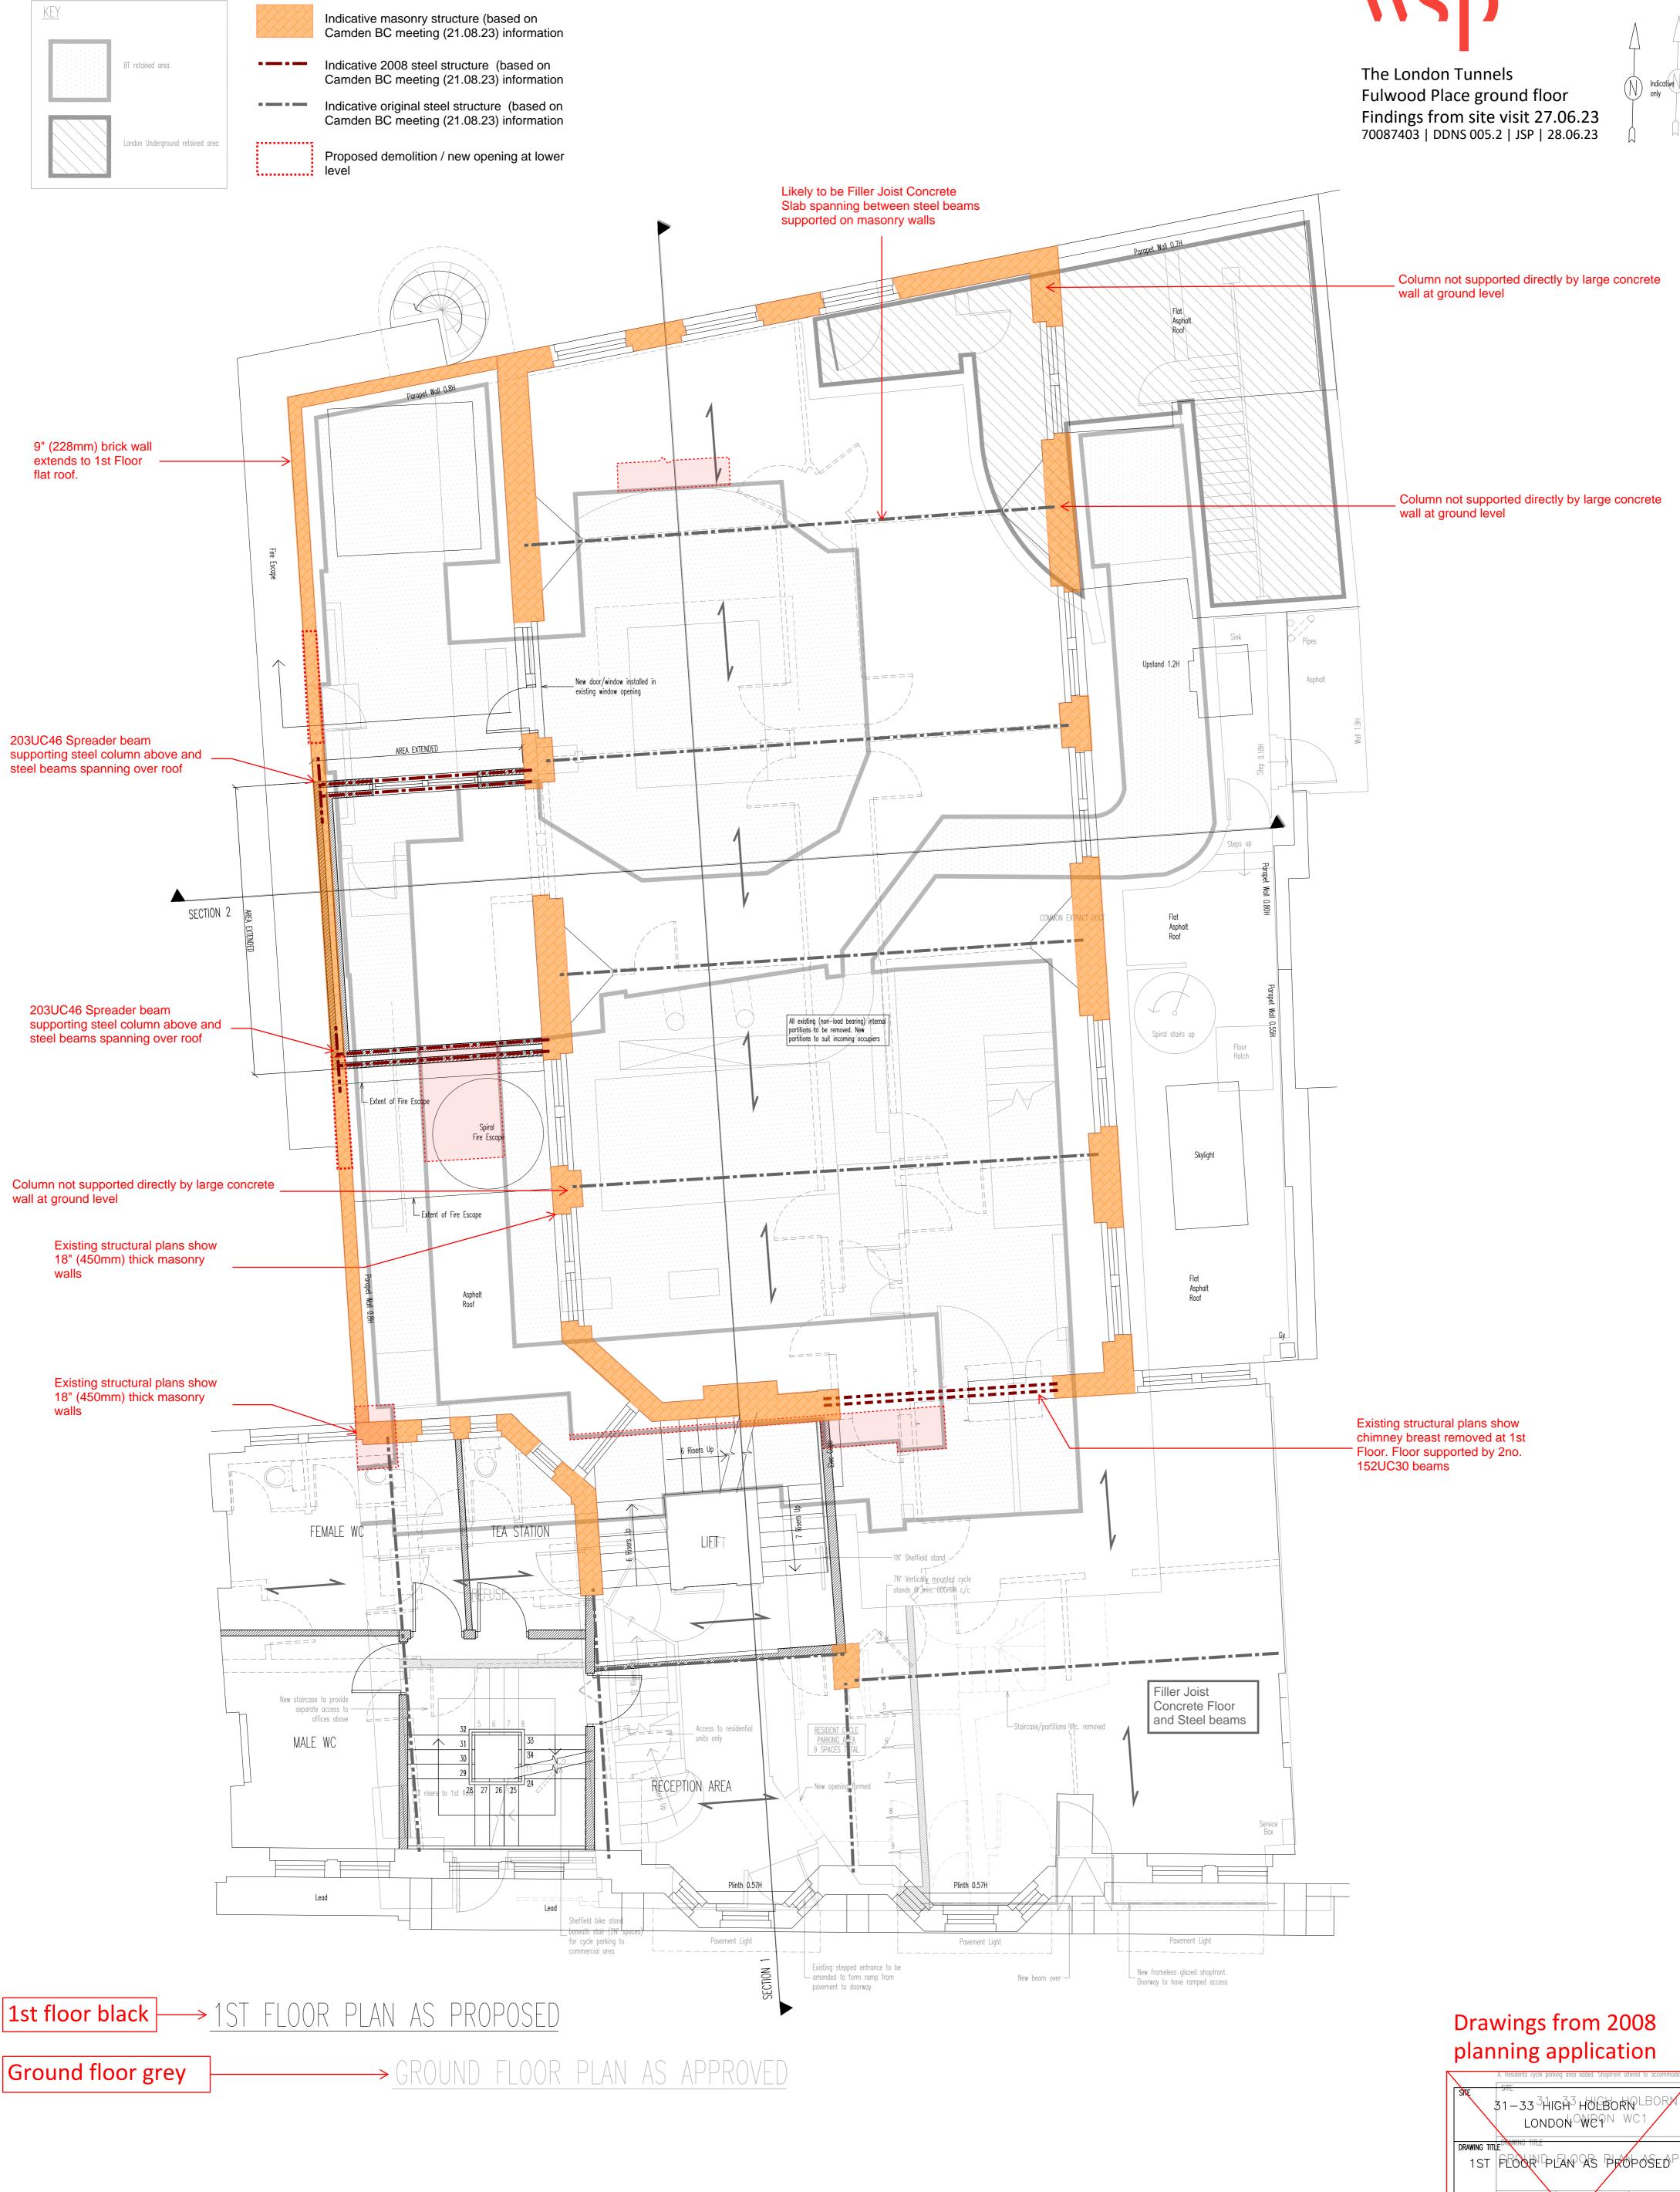

JUN 08


25

Fax:020-8643-8766


Draper Neal Associates


ARCHITECTURE AND BUILDING BESIGN PANDORA HOUSE, 41-45 LIND ROAD, SUTTON,
SURREY, SM1 4PP

## 31-33 High Holborn - Structural Assumptions

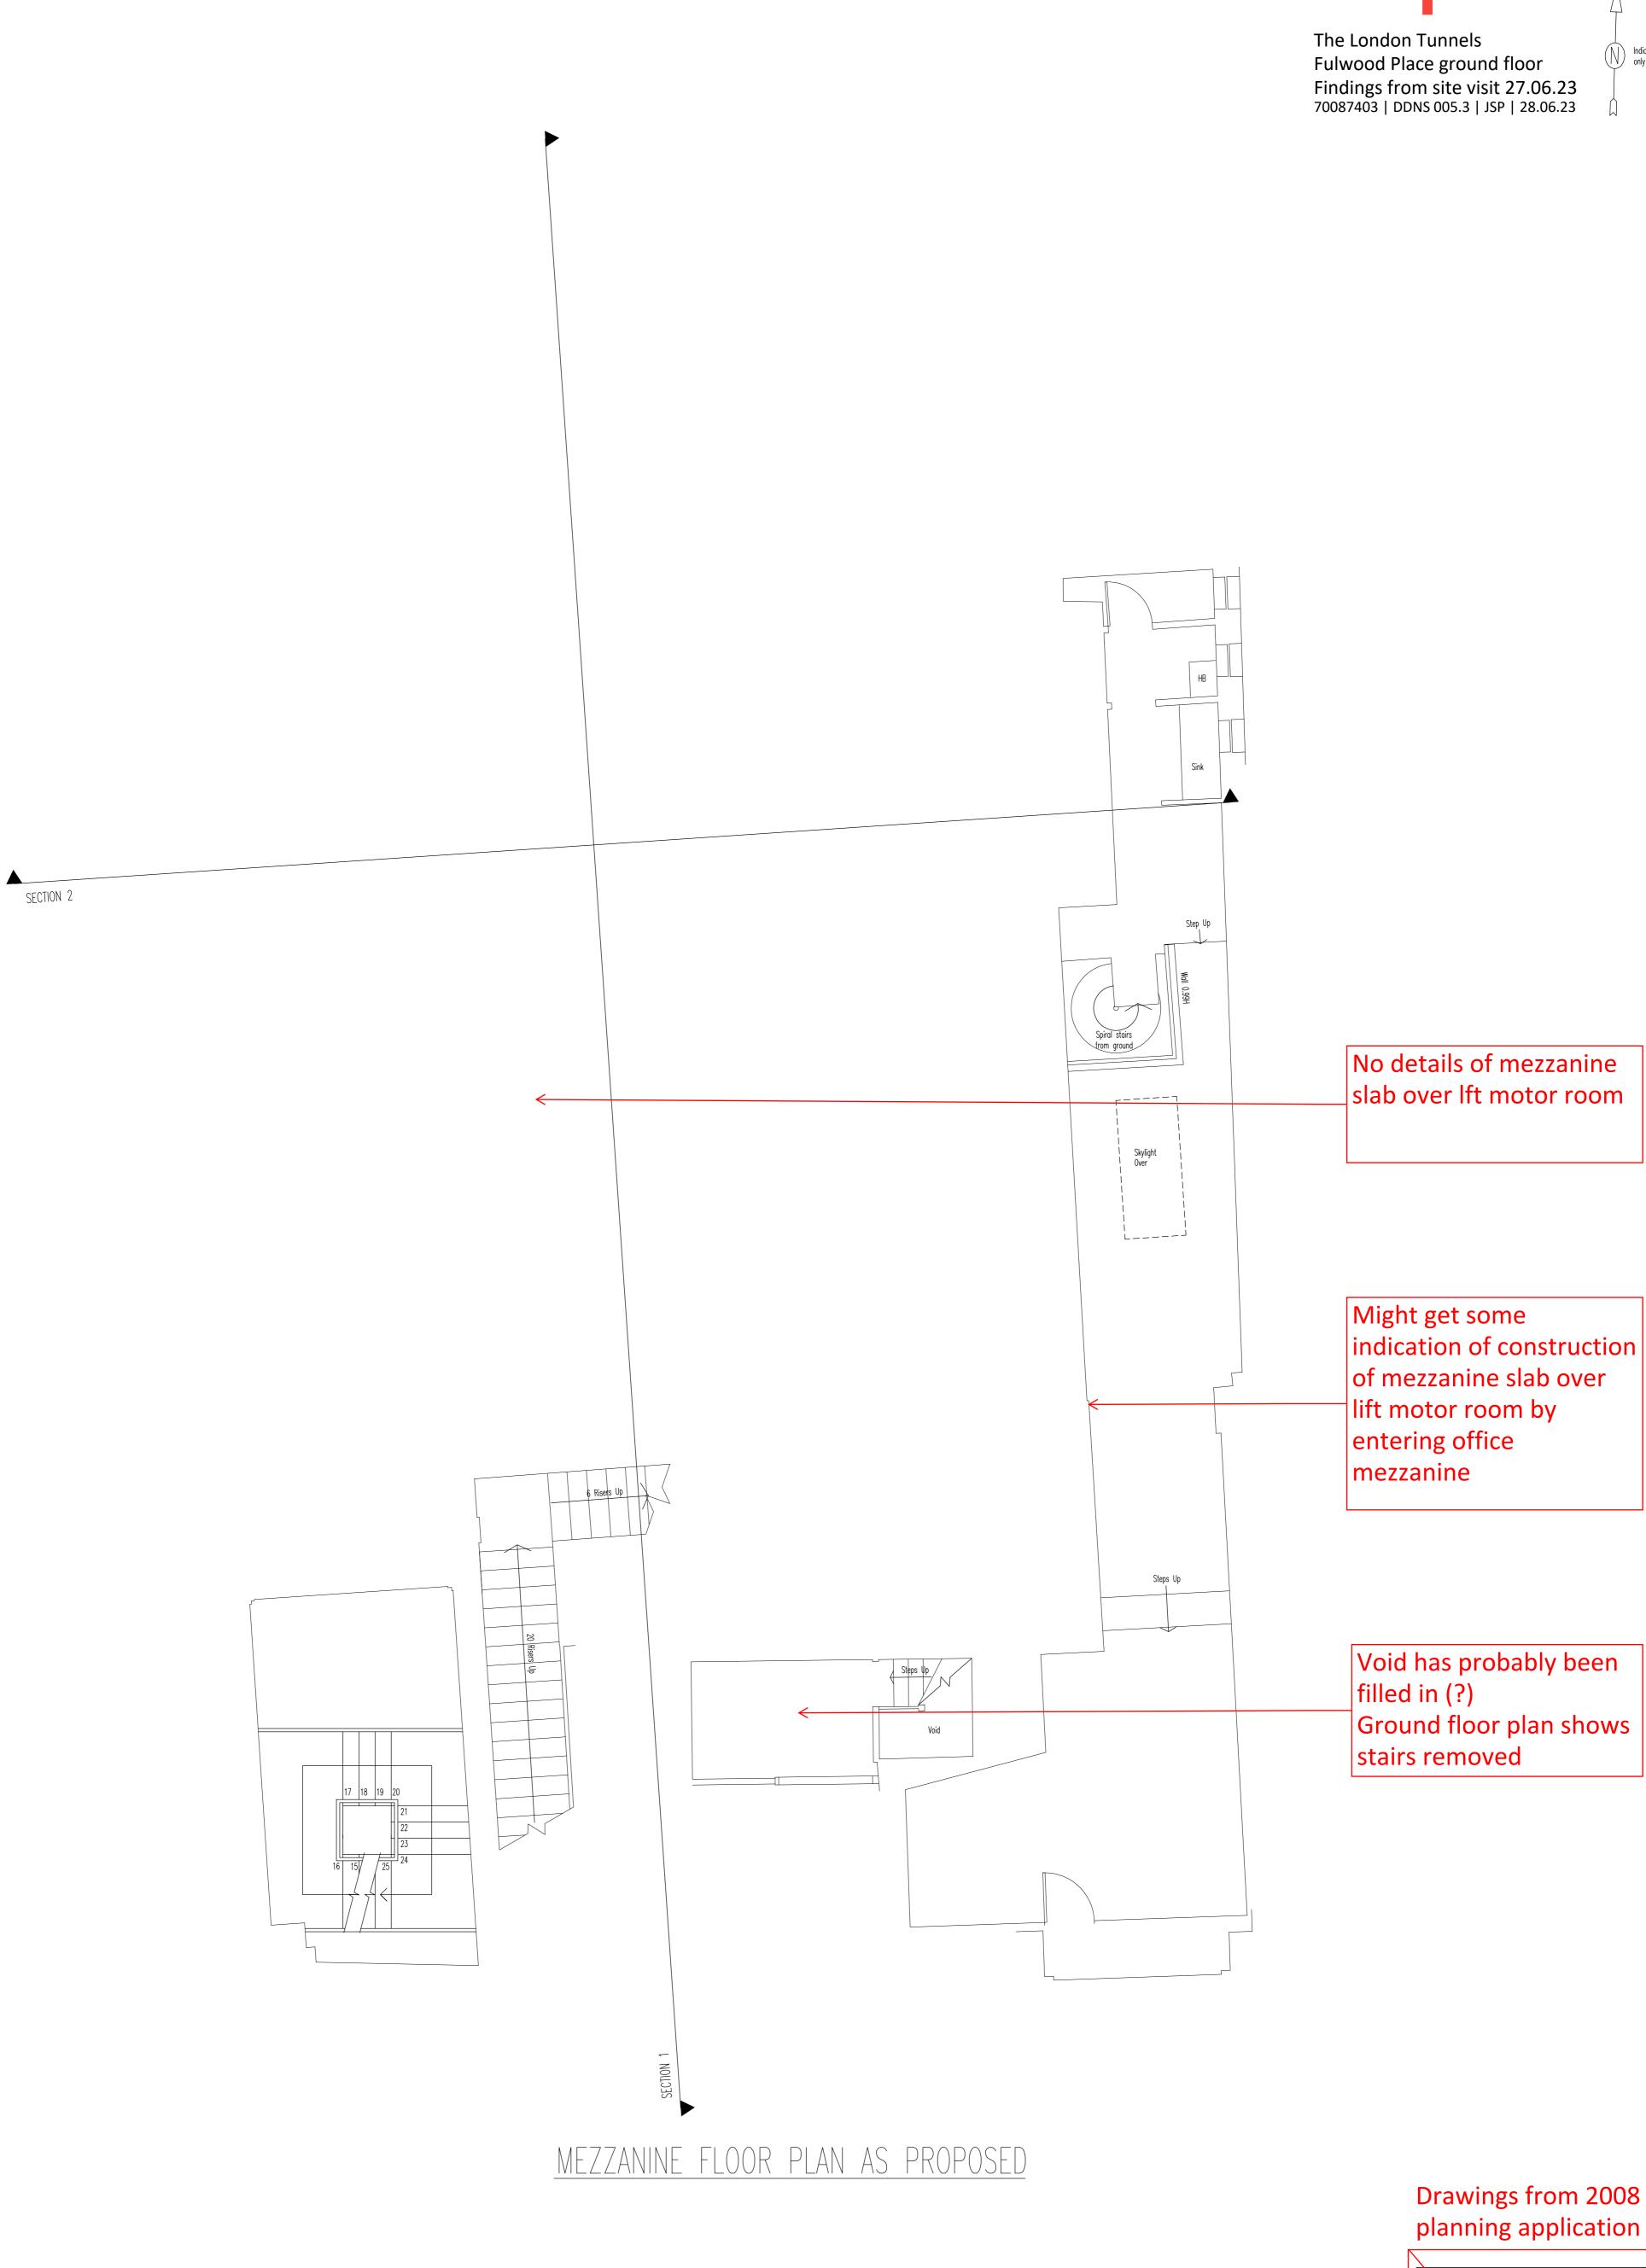

Drawings from 2008

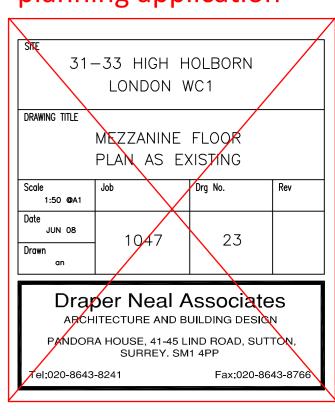

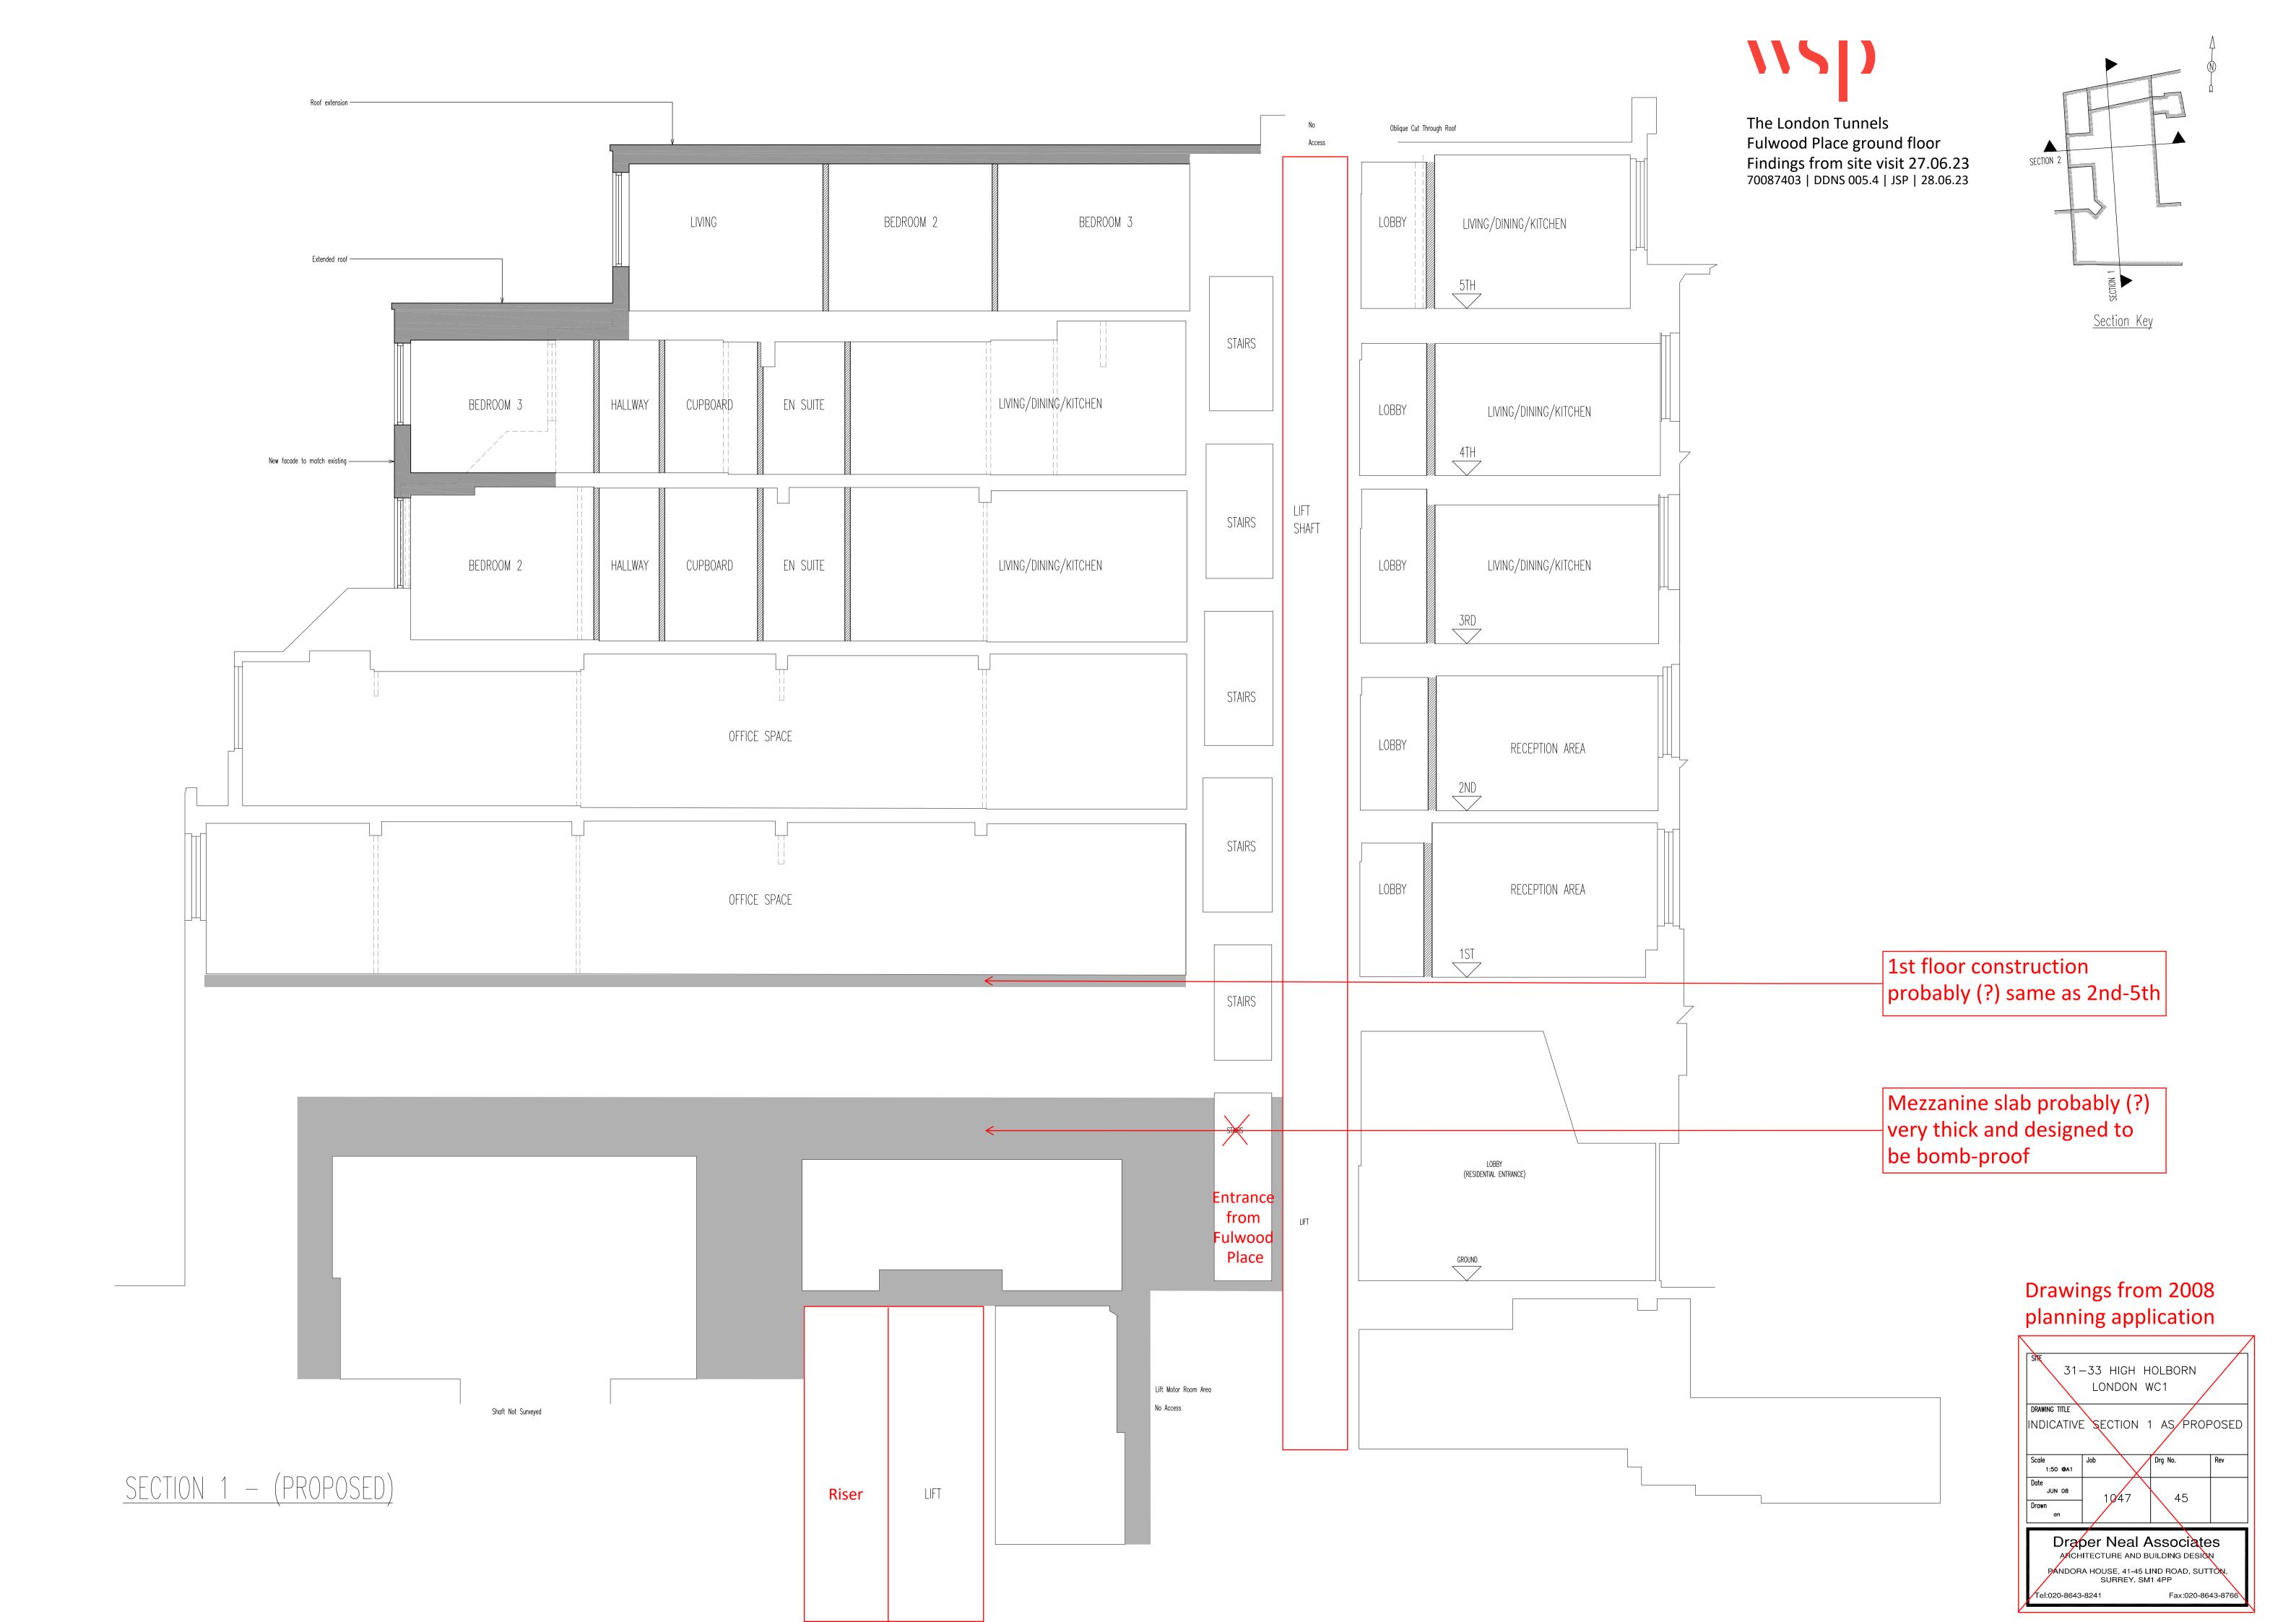



WSP House 70 Chancery Lane London WC2A 1AF

wsp.com



WSP House
70 Chancery Lane
London
WC2A 1AF

Phone: +44 20 7314 5000

WSP.com