

Legend:

Uninsulated ground floor slab

Insulated ground floor slab (over)



Insulated ground floor slab (under)

Break in the slab

Grid line to slab edge

Break in the slab dimension

HB structural markup to MNP

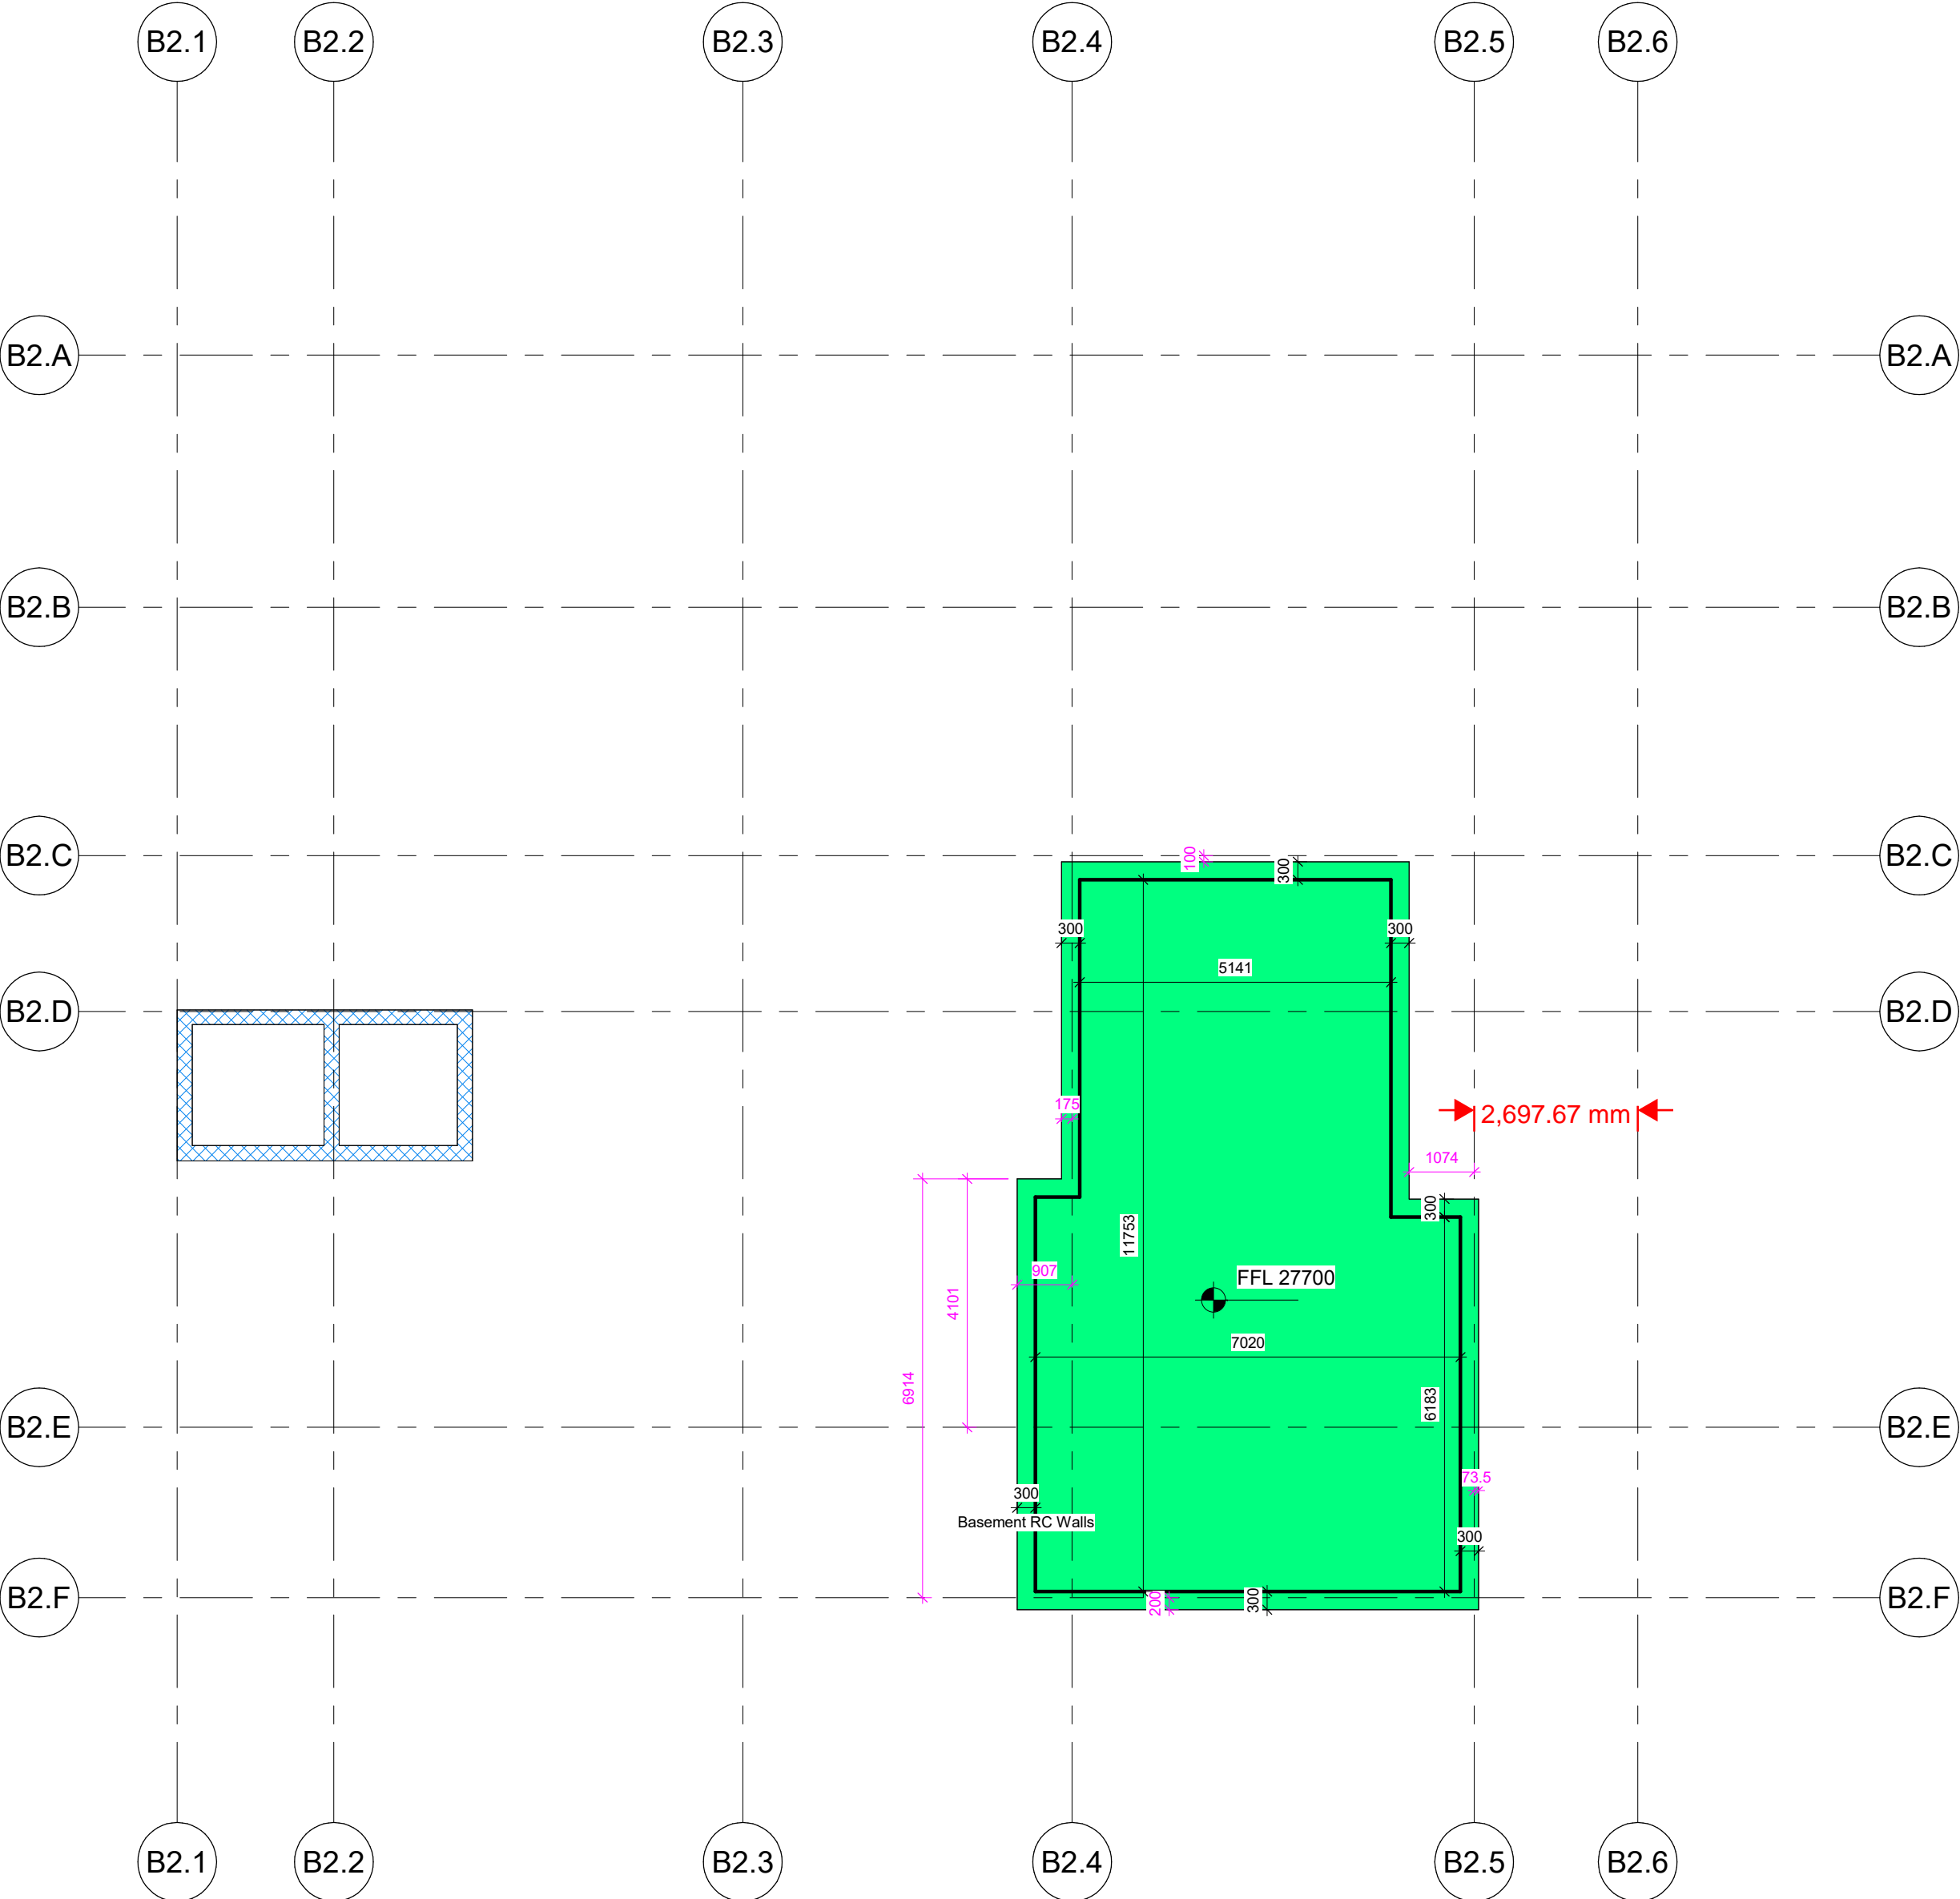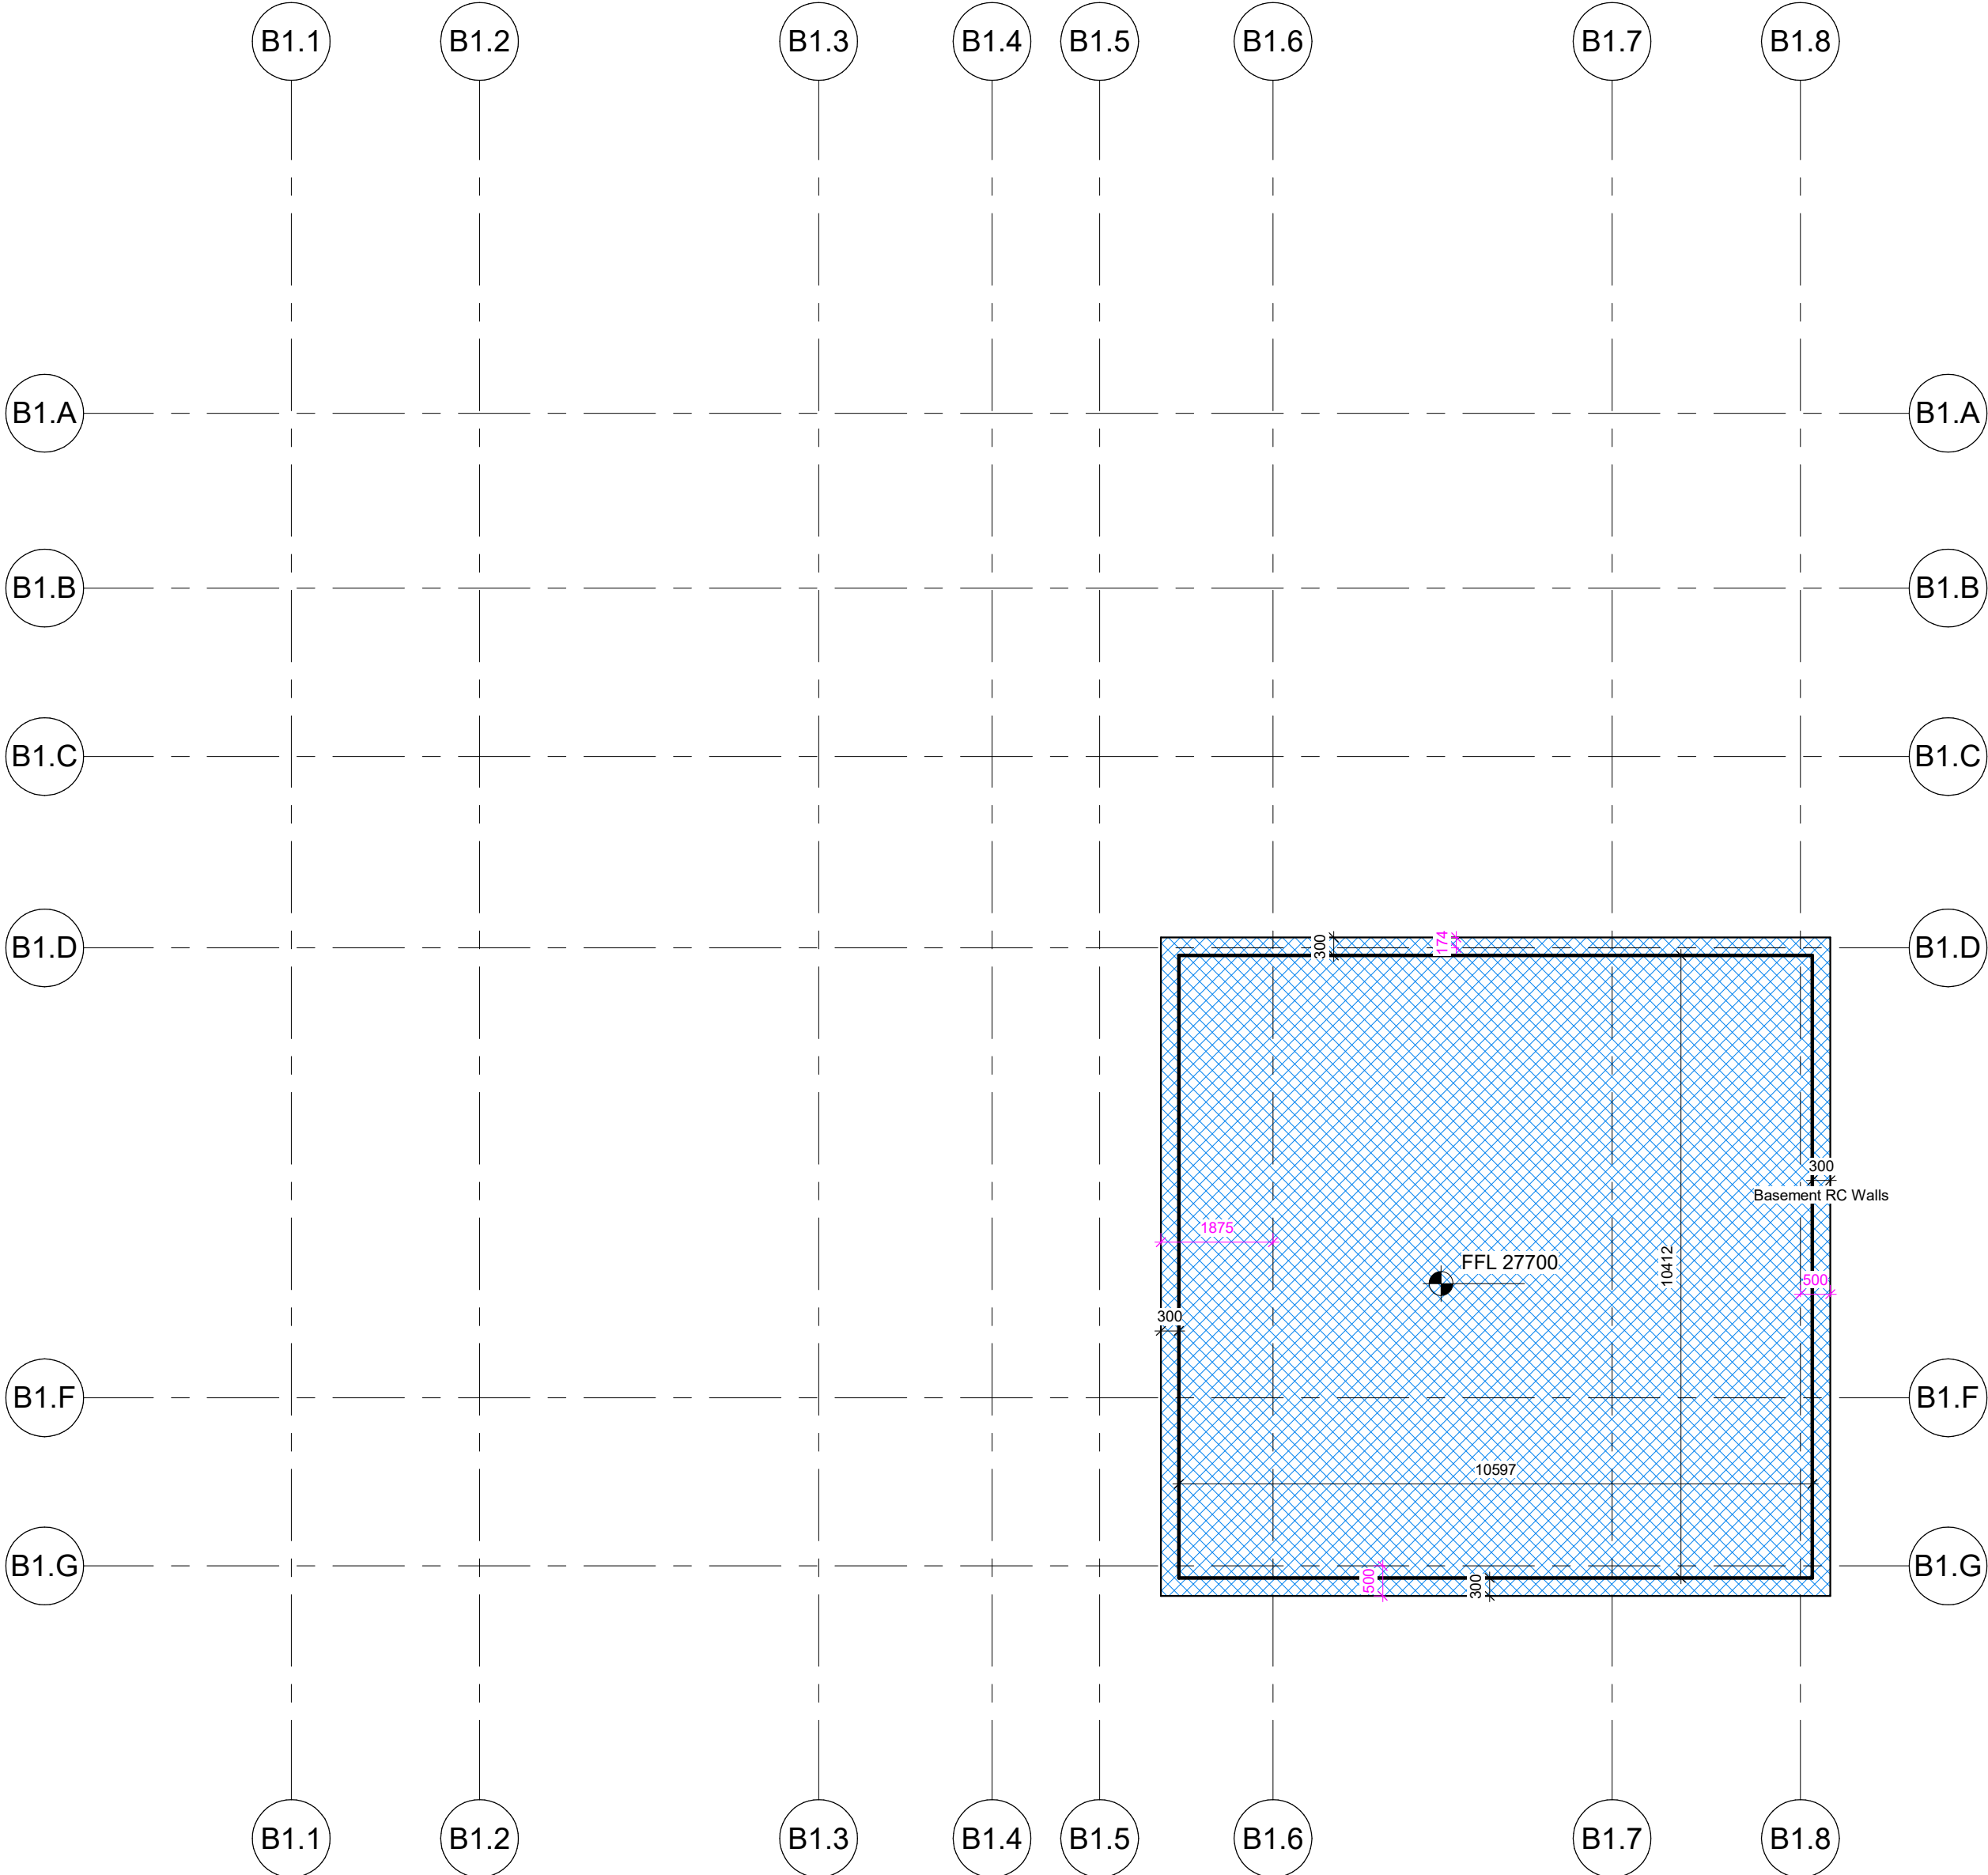

Copyright Hawkins\Brown Architects

No implied licence exists. This drawing should not be used to calculate areas for the purposes of valuation. Do not scale this drawing. All dimensions to be checked on the site by the contractor and such dimensions to be their responsibility. All work must comply with relevant *British Standards and Building Regulations* requirements. Drawing errors and omissions to be reported to the architect. To be read in conjunction with Architect's specification and other consultant information.

KEYPLAN

NOTES


P1	Issued for Review and Comment	18/12/23
Rev	Description	Date

159 St John Street  
London EC1V 4QJ

mail@hawkinsbrown.com  
hawkinsbrown.com

Hawkins\Brown

Project  
Agar Grove - Block B  
Estate Development Site  
London  
NW19SN

Drawing  
Lower Ground Floor Slab Edge  
Plan

Scale @ A1 As indicated	Date 12/23
----------------------------	---------------

Drawn By MH	Checked By MH
----------------	------------------

Job Number	Status	Purpose of Issue
1423D	S3	For Review and Comment

Drawing No.	Rev
AGV-HBA-BZ-ZZ-DR-A-330120	P1