

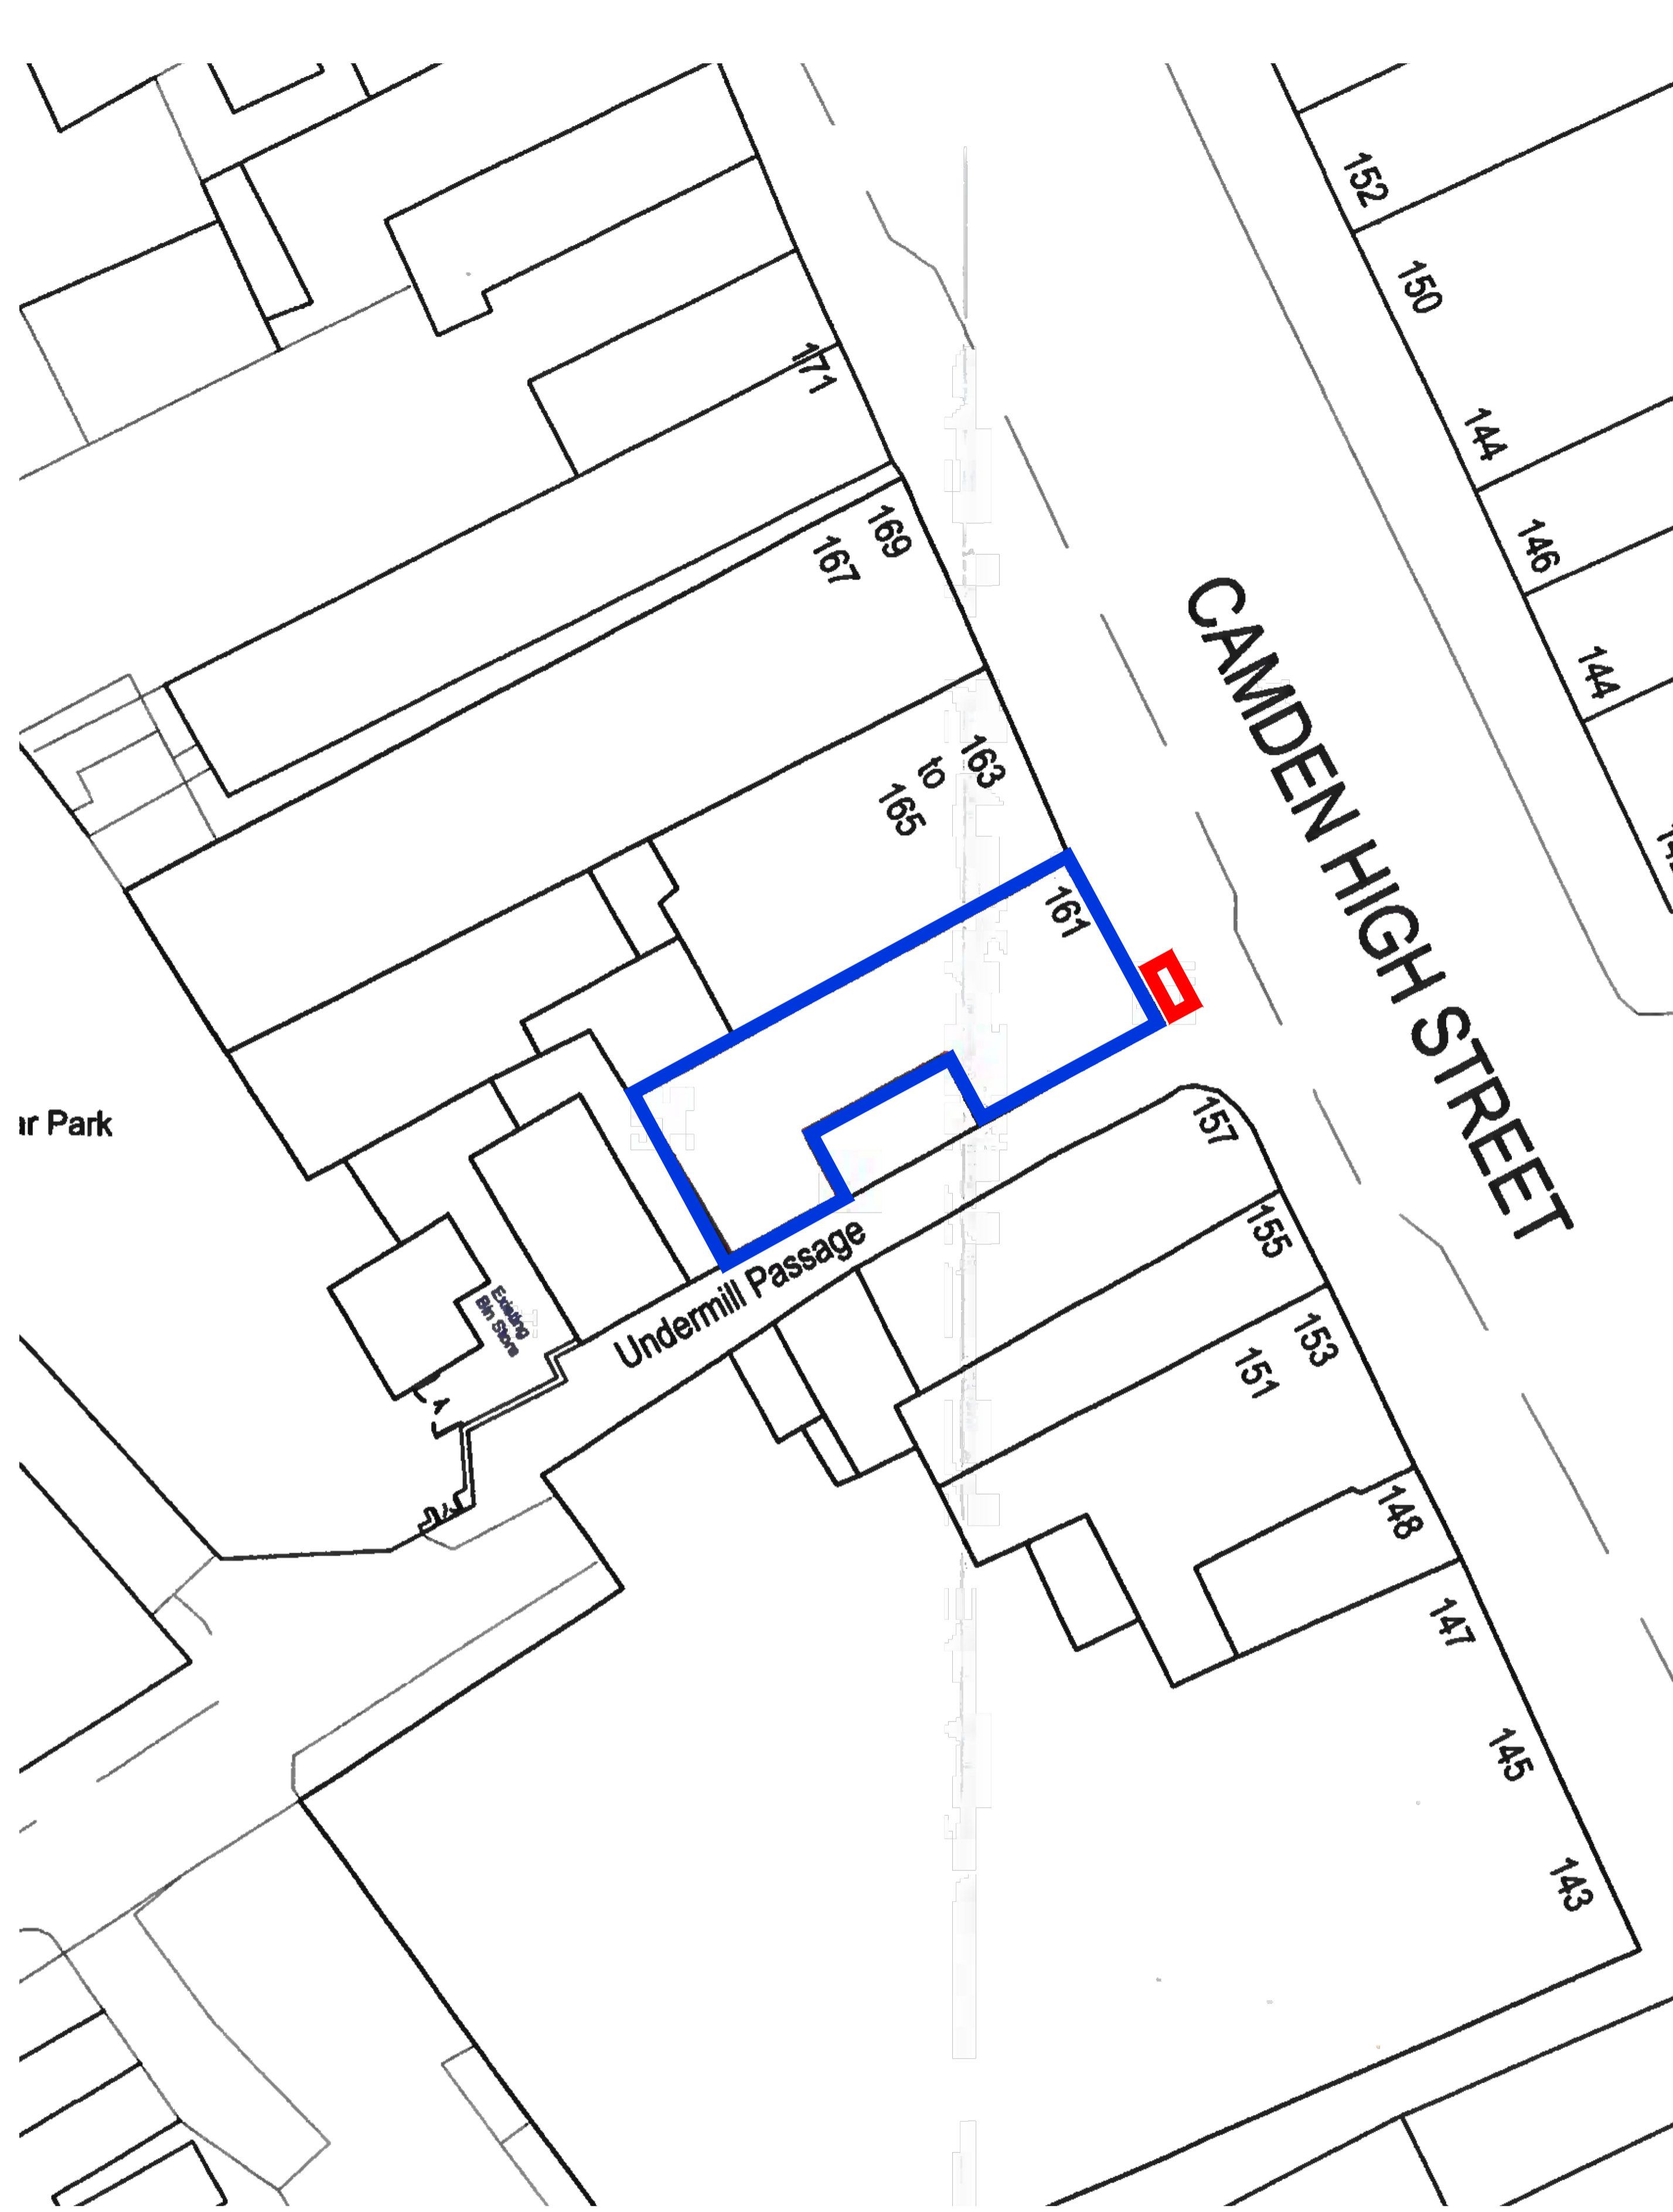


Rev	By	Date	Comment
A	SY	02.09.2022	AS BUILT ISSUE

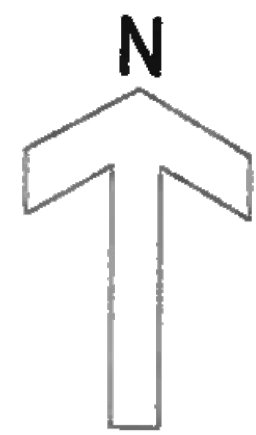

Key

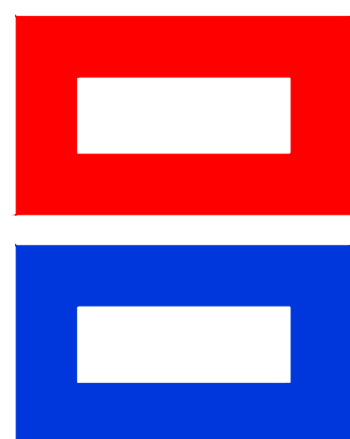

Indicates Location of Proposed A-Board

Indicates Location of Existing site

**AS BUILT**

CLIENT	CHIKN
PROJECT	159-161 Camden High Street NW1 7YH
TITLE	Existing Site Plan
DRAWN	CHECKED
JW	
SCALE @ A1	DATE
No To Scale	January 2024
DRAWING NO.	4884/00