




NOTE : No external alterations proposed as part of this application

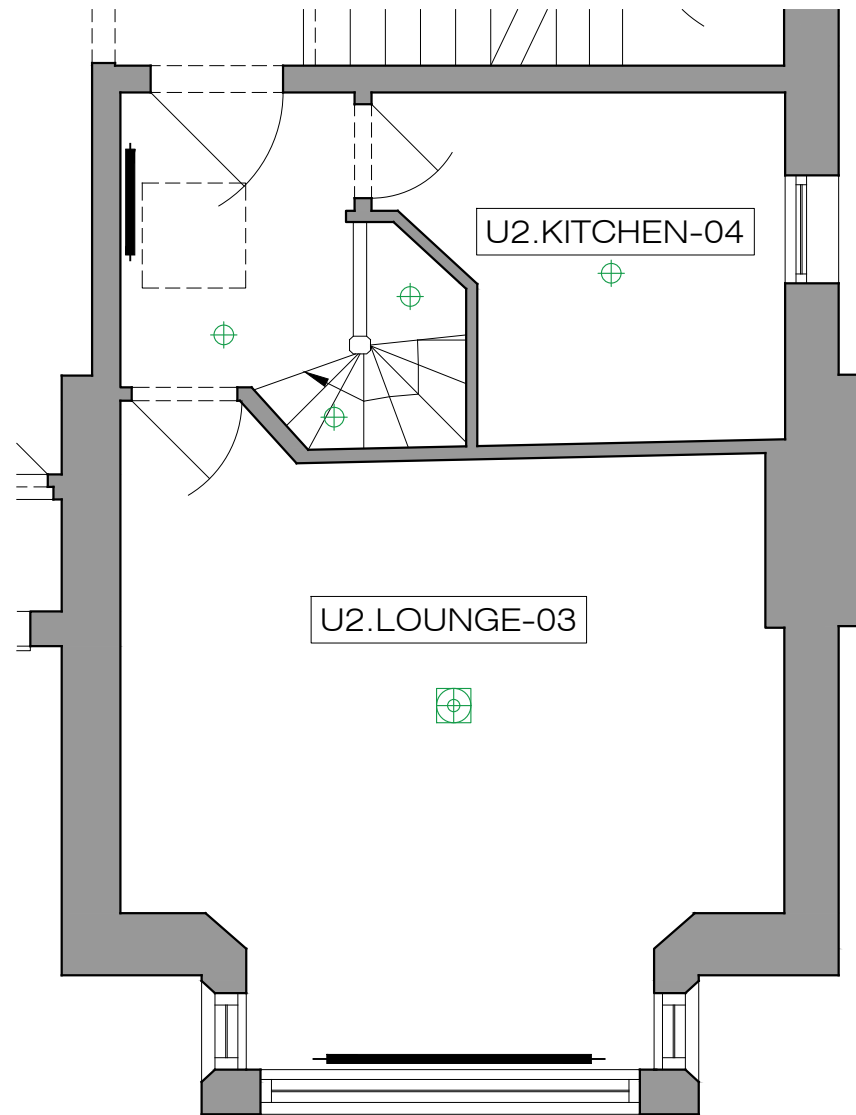


X EXISTING
Upper Ground Floor Extract 1:50@A3

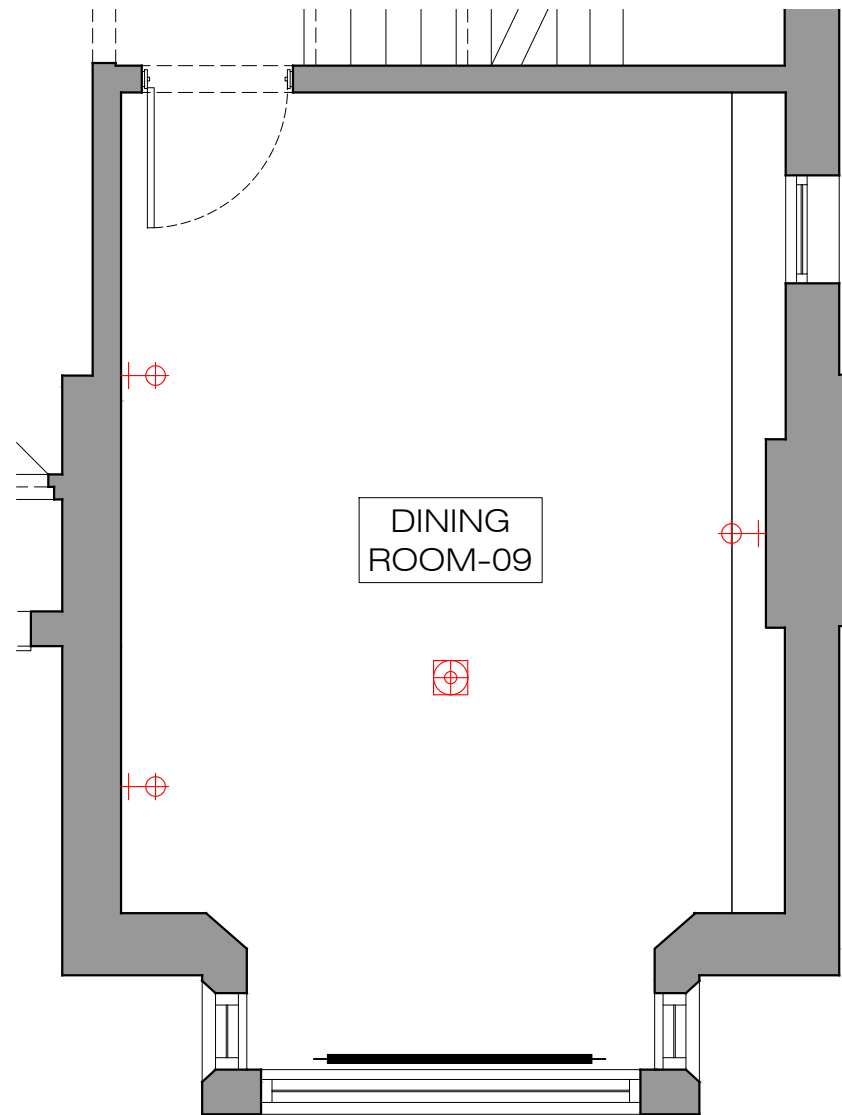

X PROPOSED
Upper Ground Floor Extract 1:50@A3

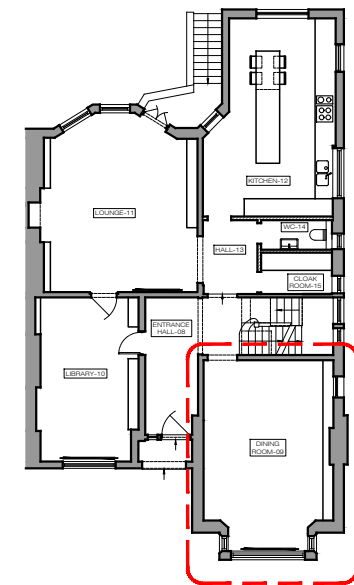

- Proposed pendant light
- Proposed wall mounted light
- Existing recessed spotlight
- Proposed recessed spotlight
- Existing pendant light

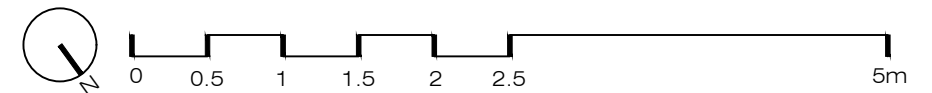

Ground Floor Office
33 Belsize Lane
London NW3 5AS
Office: +44 (0) 207 431 9014
info@xularchitecture.co.uk
www.xularchitecture.co.uk

PLEASE NOTE:

1. All dimensions to be checked on site before fabrication,
2. Contractor to refer to engineers drawings before proceeding with works.
3. All drawings and designs are covered by design right (intellectual property), and may not be distributed, copied or issued without written permission by the Architect.
4. All design concepts are the sole property of the Architect and no adaptations, reproductions or copies may be made without written permission of the Architect.
5. These drawings are subject to any variation required or recommendation by any statutory authority, or for the better carrying out of the works.
6. Samples to be provided by contractor for XUL Architecture's approval.
7. All finishes to XUL Architecture's satisfaction.
8. All drawings to be approved by XUL Architecture prior to construction.

ADDITIONAL NOTE:

Issue key:

- Information (I)
- Planning (P)
- Tender (T)
- Construction (C)
- As Built (B)

Project Address
33 Ferncroft Ave, NW3 7PG

| | | | | |
|-----------|----------|---------------------------------|-------|-----------|
| Scale | 1:50@A3 | EXISTING & PROPOSED | | |
| Rev. Date | 02.02.24 | Lighting Layout UGF Dining Room | | |
| Drawn | AK | Dwg. No. | PA-07 | Rev. P-00 |
| Checked | IW | Project Number | 23033 | |

Issue For:
PLANNING