


PARSIFAL COLLEGE BUILDING


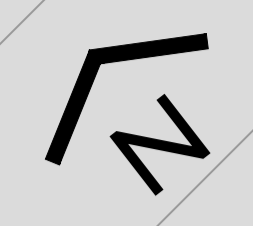


THESE NOTES ARE IMPORTANT

If you are in any doubt about something - ASK

This drawing must be read in conjunction with all necessary architectural, structural, services drawings and scope of works

This drawing is copyright protected and unless specifically agreed with Markwick Architects can only be used for the project noted in the title box below.

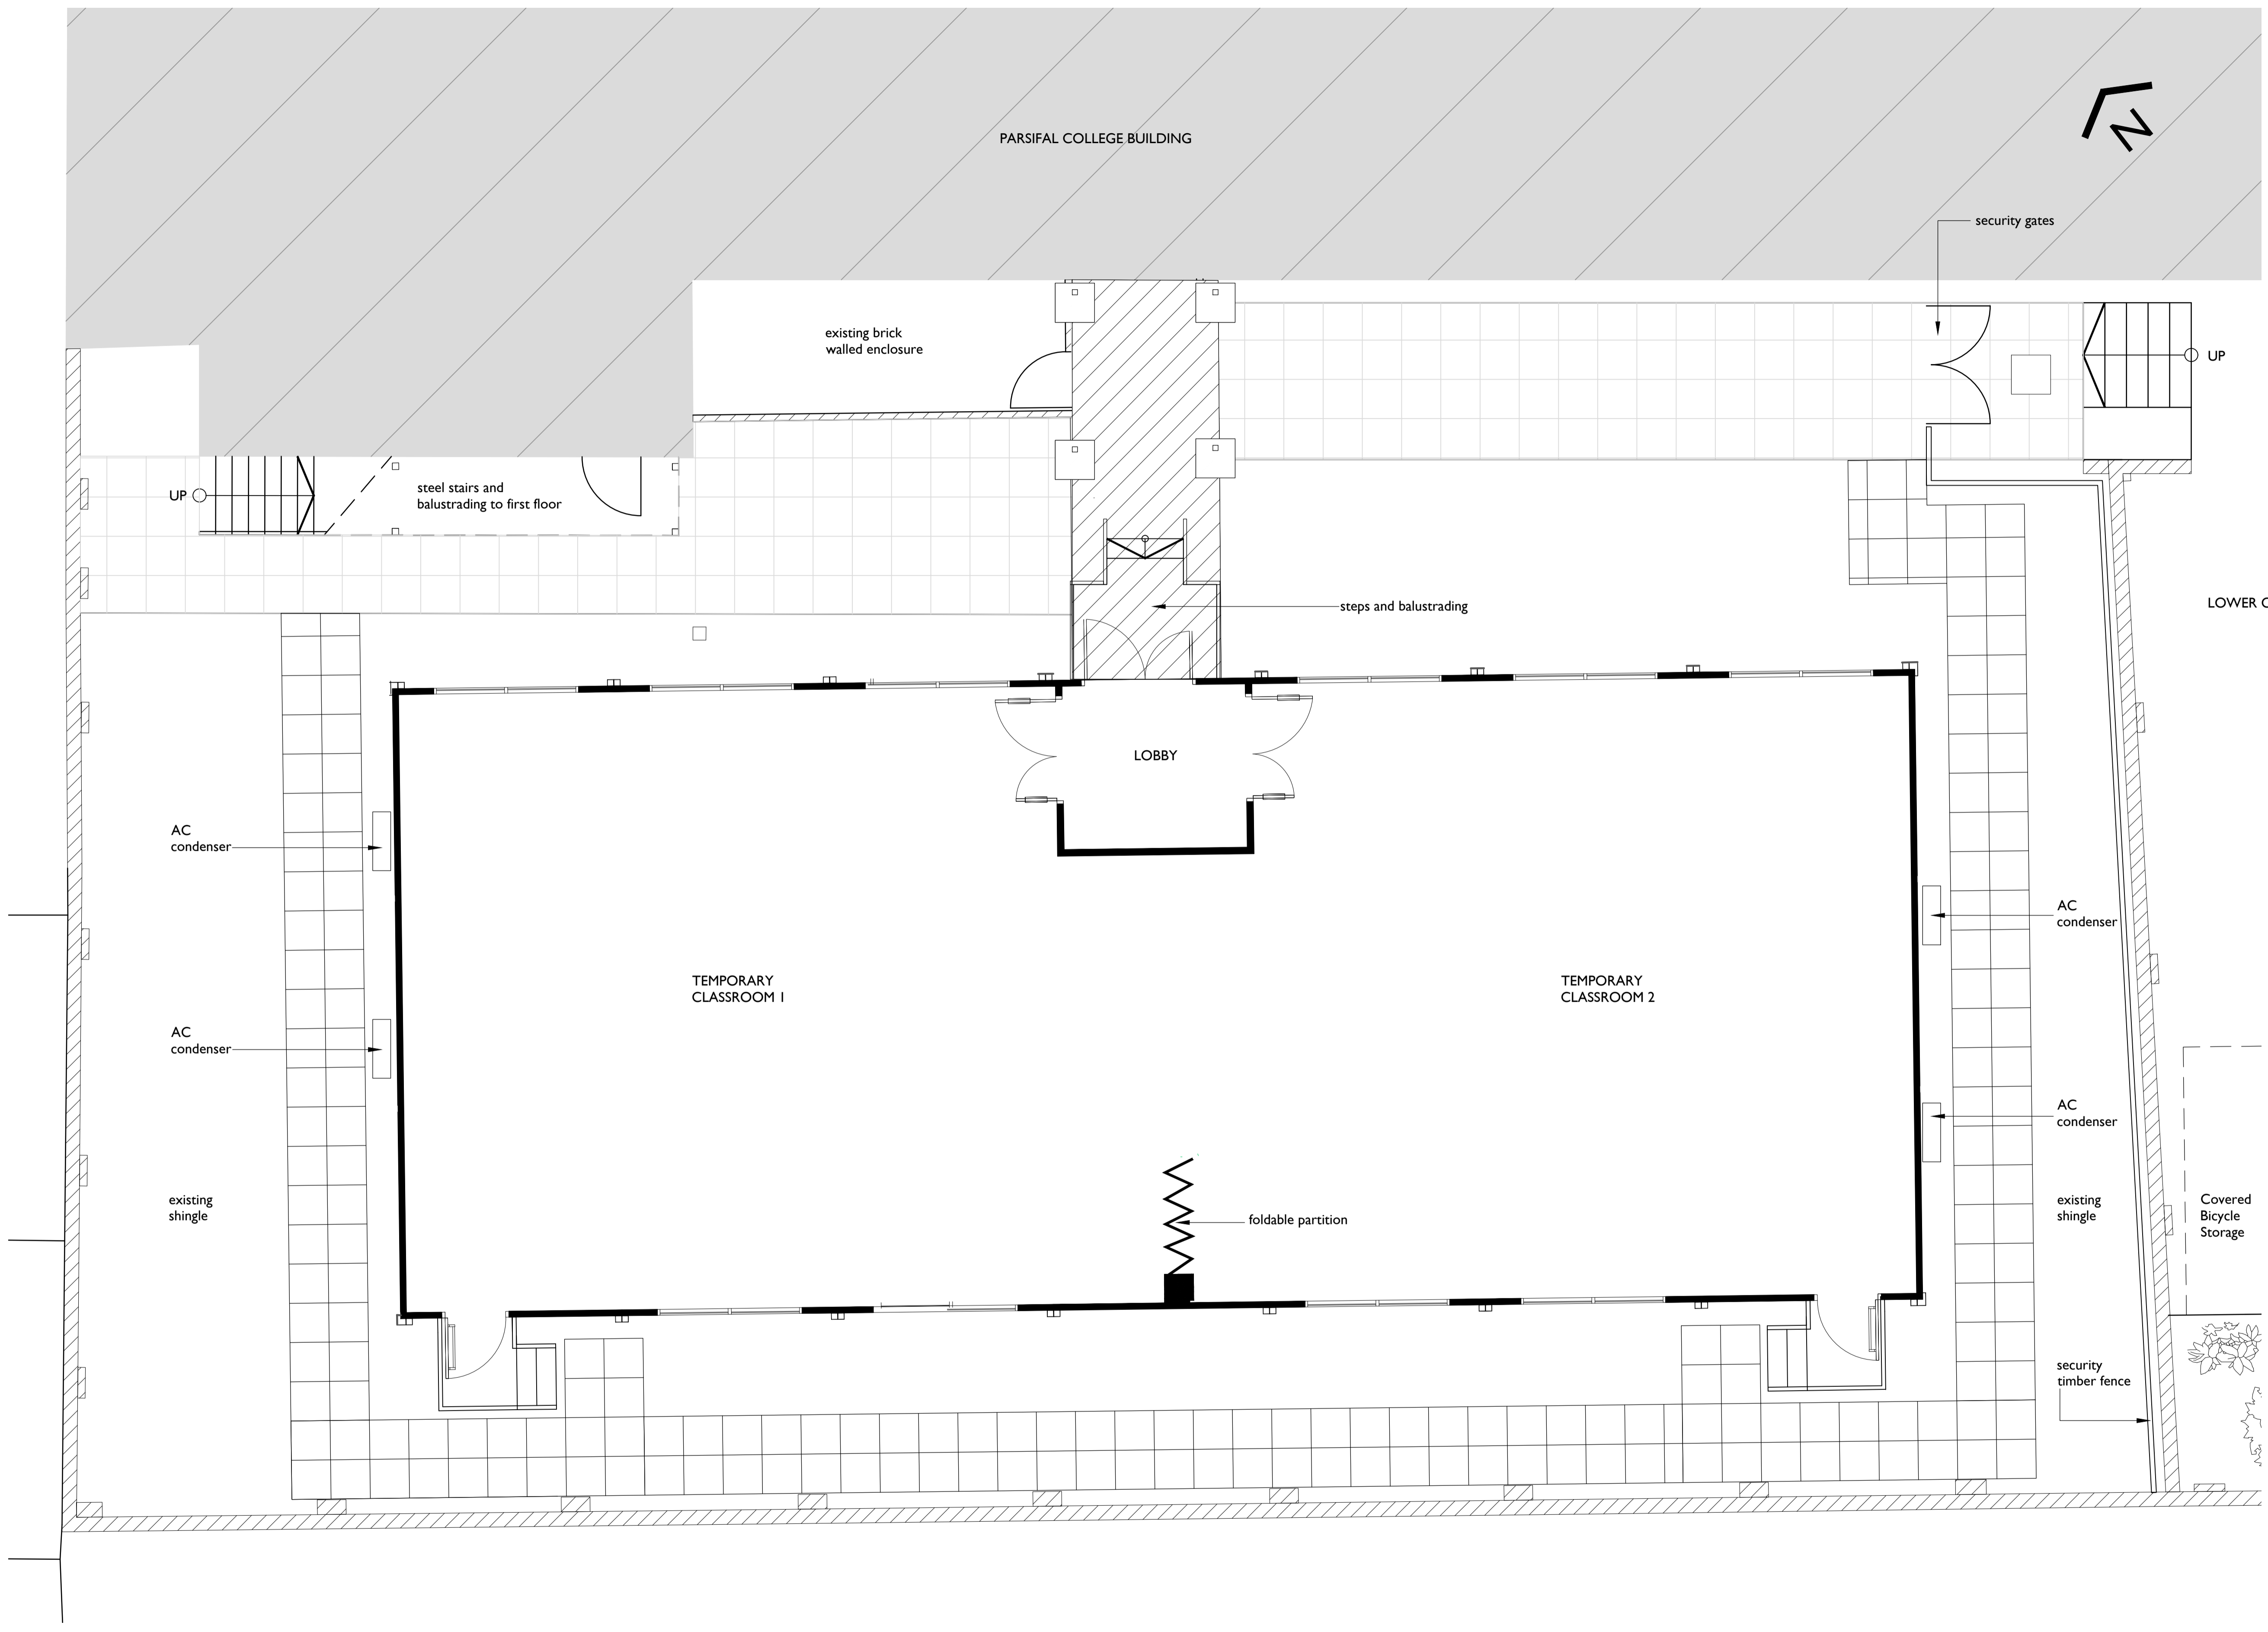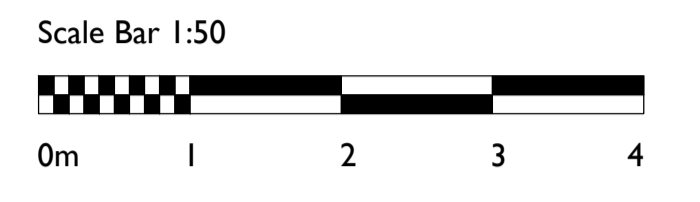

LOWER CAR PARK LEVEL

ISSUED FOR PLANNING 09.02.24 TC TM
 REV. DESCRIPTION DATE DRN CHKD.

MARKWICK ARCHITECTS
 THE OLD DAIRY
 51a ST. PETERS STREET
 SOUTH CROYDON SURREY CR2 7DG
 TELEPHONE 020 8686 2955
 E-MAIL ma@markwickarchitects.co.uk

CLIENT
ESCP Europe Business School

PROJECT
**527, Finchley Road,
 London NW3 7BG**

DRAWING TITLE
**As Built
 Classroom Plan**

DATE
February 2024 SCALE
1:50 @ A1

DRAWING NUMBER
2213 / P / 691 DRAWING REVISION

DRAWN BY
TC CHECKED BY
TM

RAISED AREA