

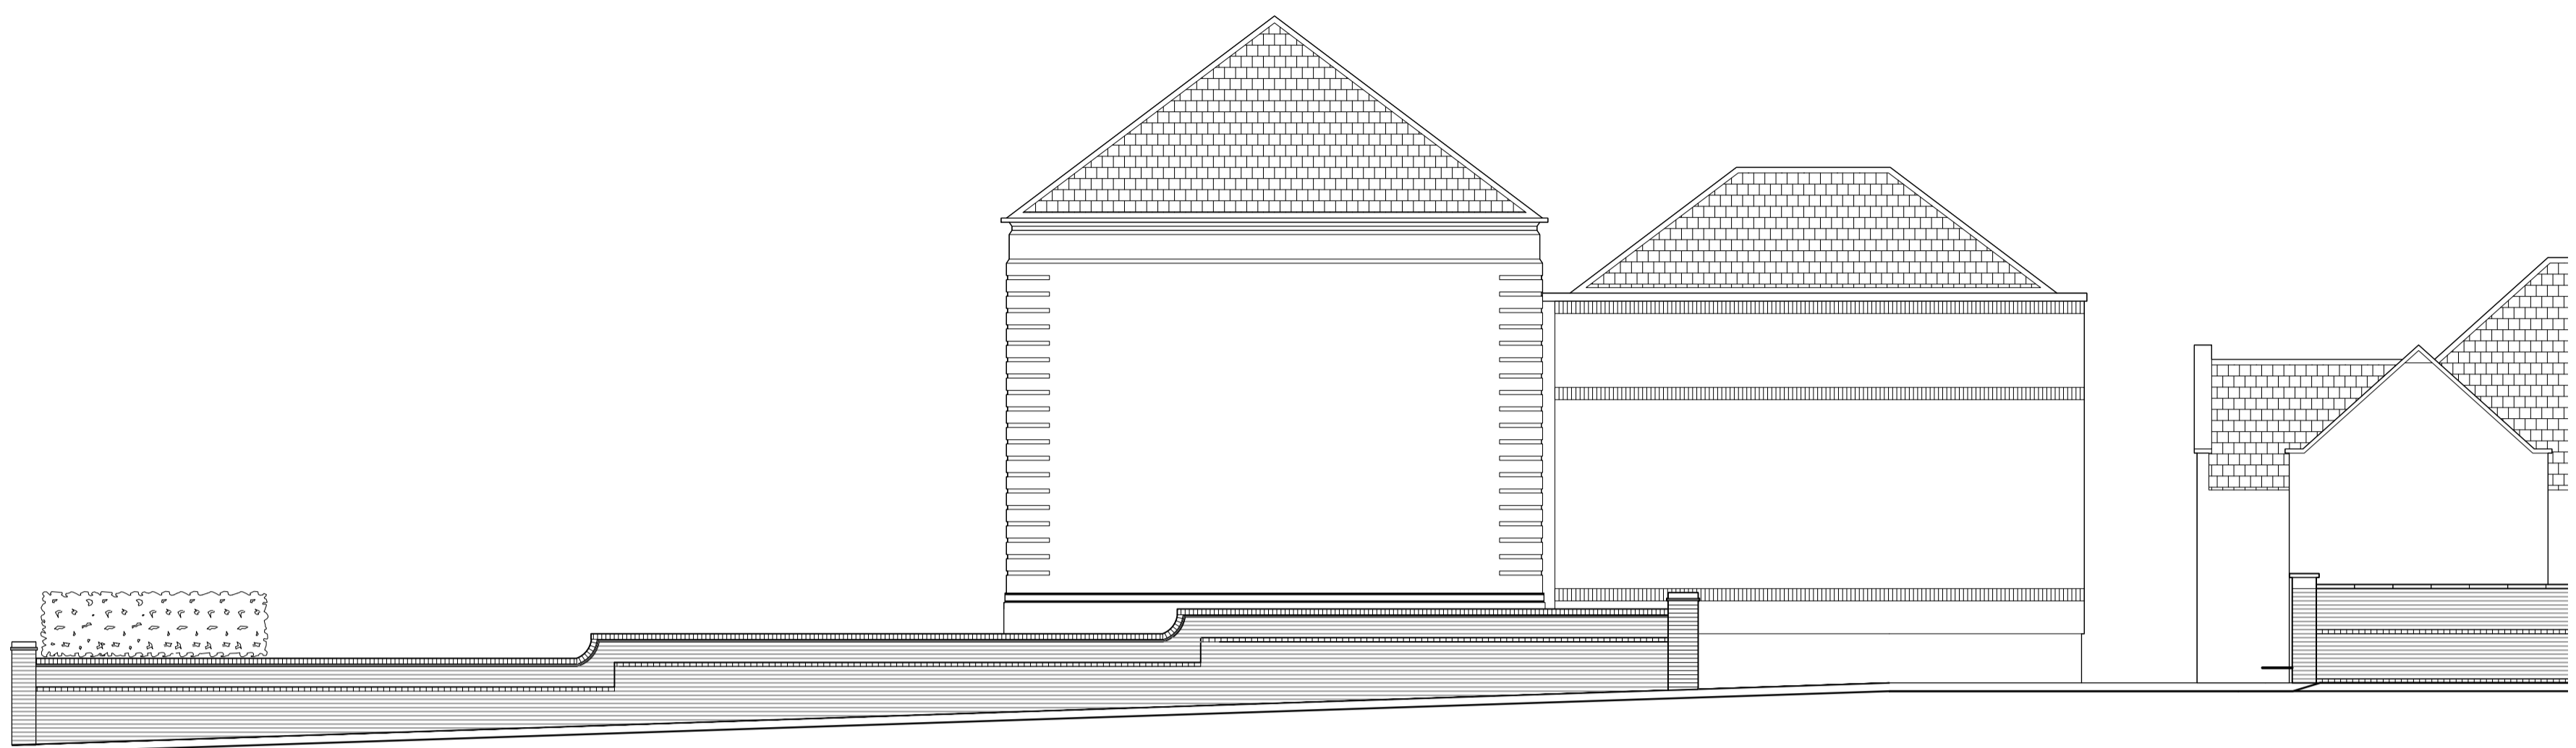


THESE NOTES ARE IMPORTANT
 If you are in any doubt about something - ASK
 This drawing must be read in conjunction with all necessary architectural, structural, services drawings and scope of works
 This drawing is copyright protected and unless specifically agreed with Markwick Architects can only be used for the project noted in the title box below.

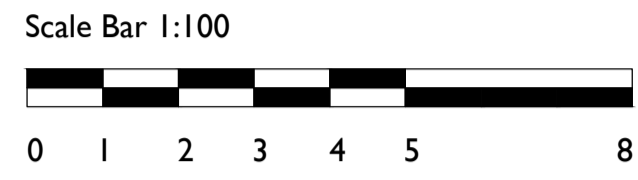

PRE EXISTING PARSIFAL ROAD ENTRANCE

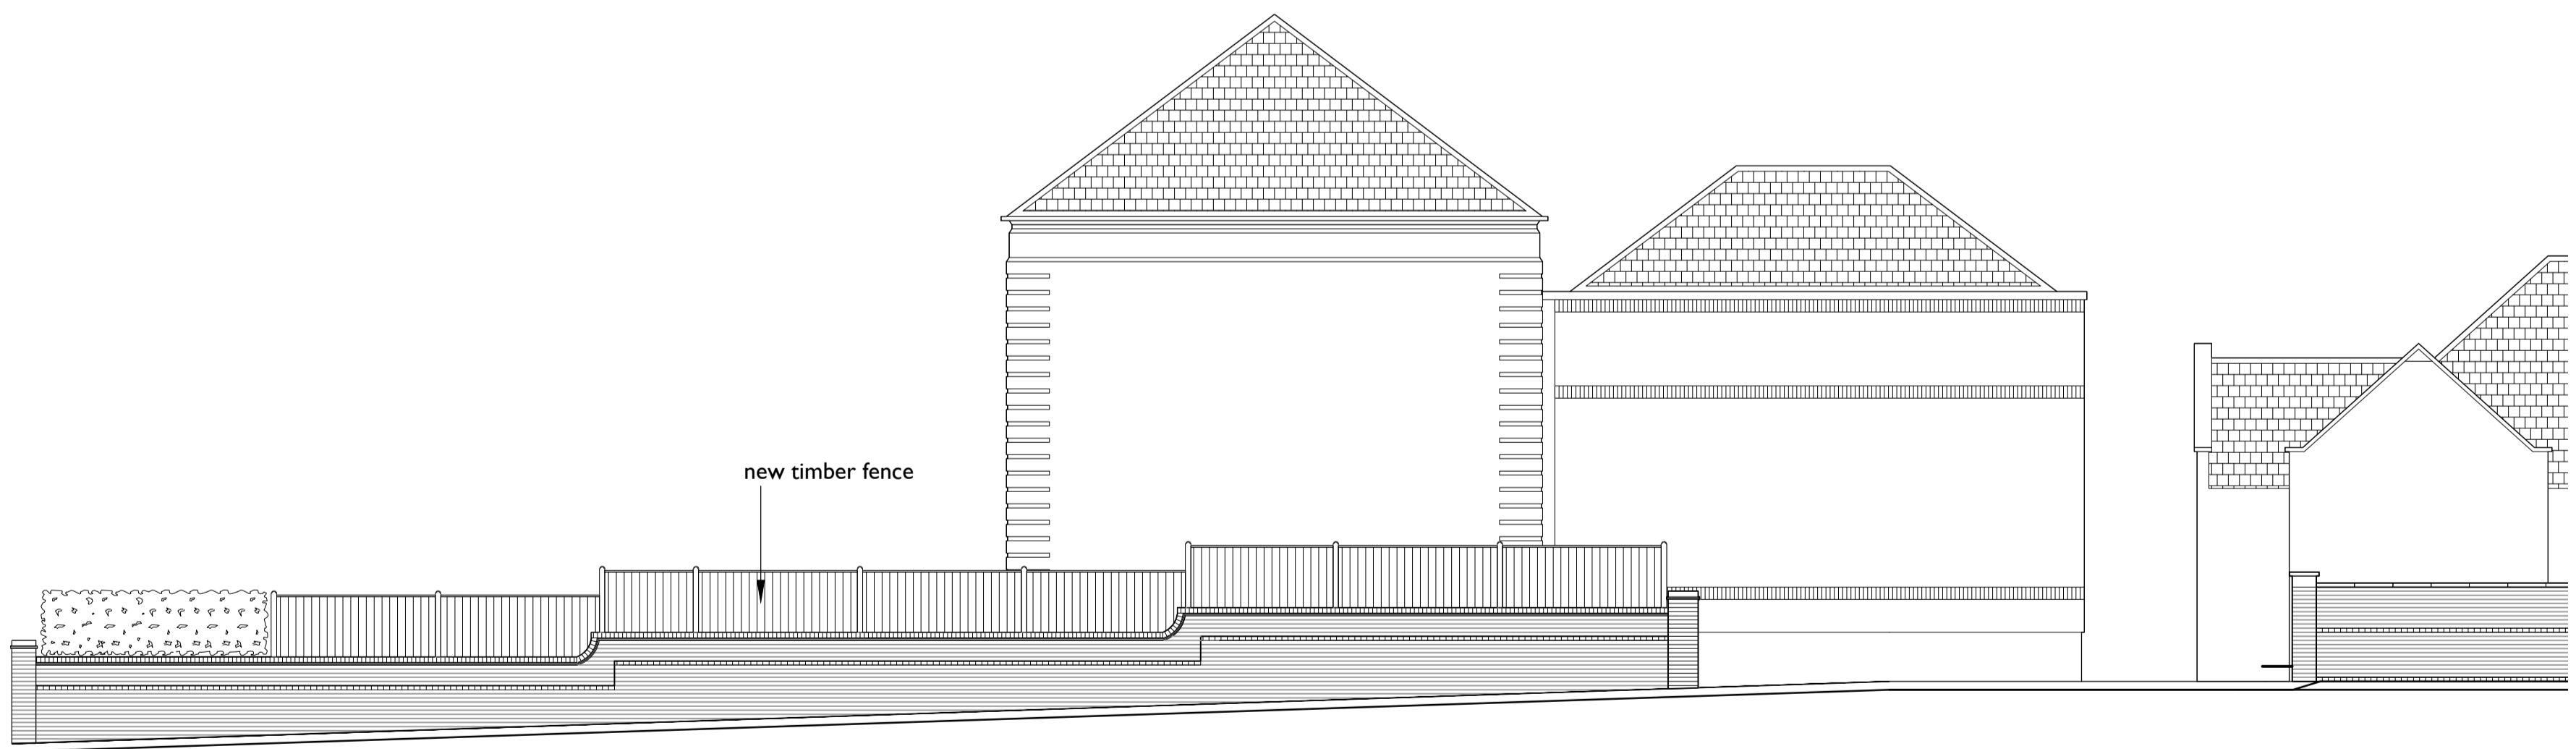

AS BUILT PARSIFAL ROAD ENTRANCE

* ISSUED FOR PLANNING 09.02.24 TC TM
 REV. DESCRIPTION DATE DRN. CHKD.

M A R K W I C K
A R C H I T E C T S
 T H E O L D D A I R Y
 5 1 a S T . P E T E R S S T R E E T
 S O U T H C R O Y D O N S U R R E Y C R 2 7 D G
 T E L E P H O N E 0 2 0 8 6 8 6 2 9 5 5
 E - M A I L m a @ m a r k w i c k a r c h i t e c t s . c o . u k

CLIENT
ESCP Europe Busines School

PROJECT
**527 Finchley Road
 London, NW3 7BG**

DRAWING TITLE
**Pre Existing & As Built
 Parsifal Road Entrance Elevations**

DATE	SCALE
February 2024	1:100 @ A1
DRAWING NUMBER	DRAWING REVISION
2213 / P / 694	*
DRAWN BY	CHECKED BY
TC	TM