
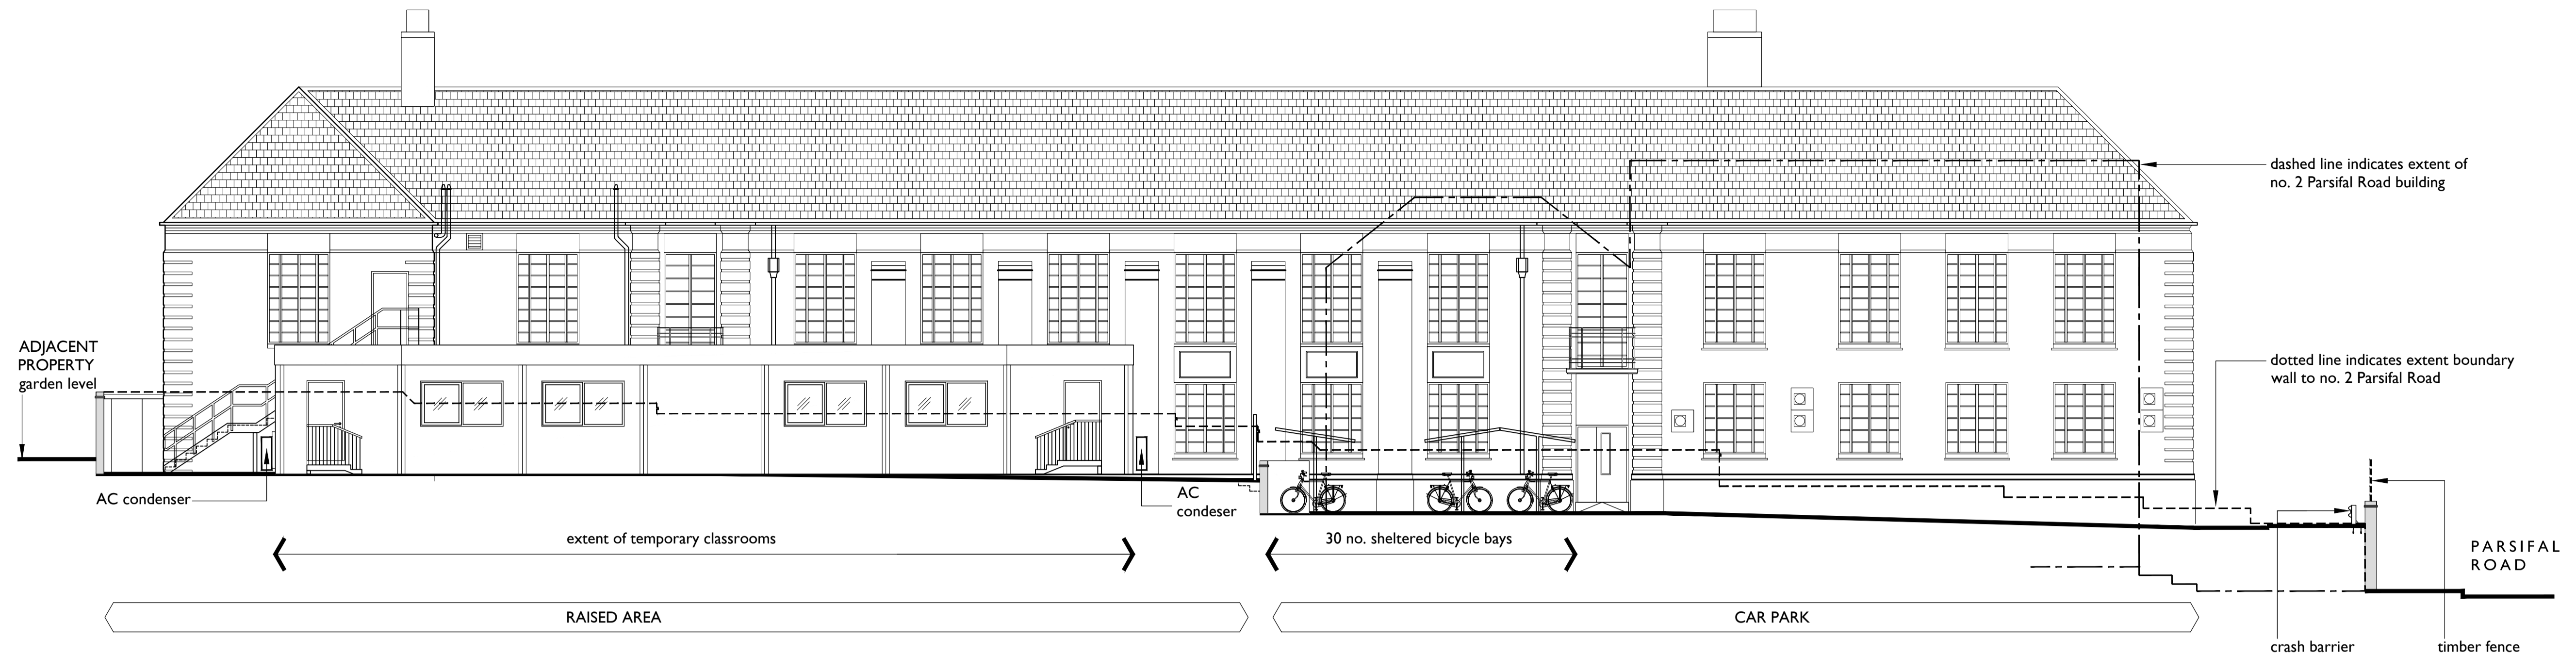
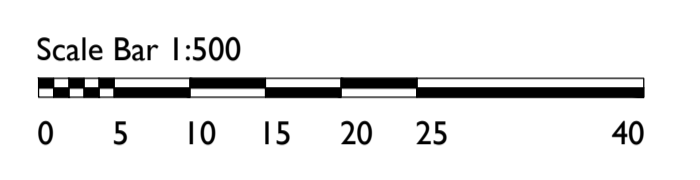


THESE NOTES ARE IMPORTANT


If you are in any doubt about something - ASK

This drawing must be read in conjunction with all necessary architectural, structural, services drawings and scope of works


This drawing is copyright protected and unless specifically agreed with Markwick Architects can only be used for the project noted in the title box below.

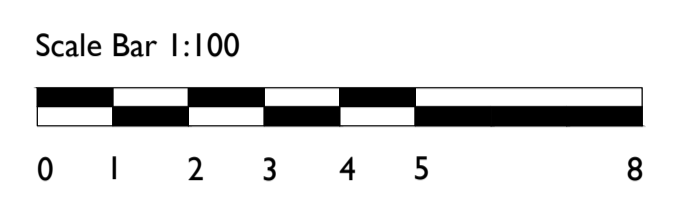


ELEVATION A (FROM CAR PARK)
Scale 1:100

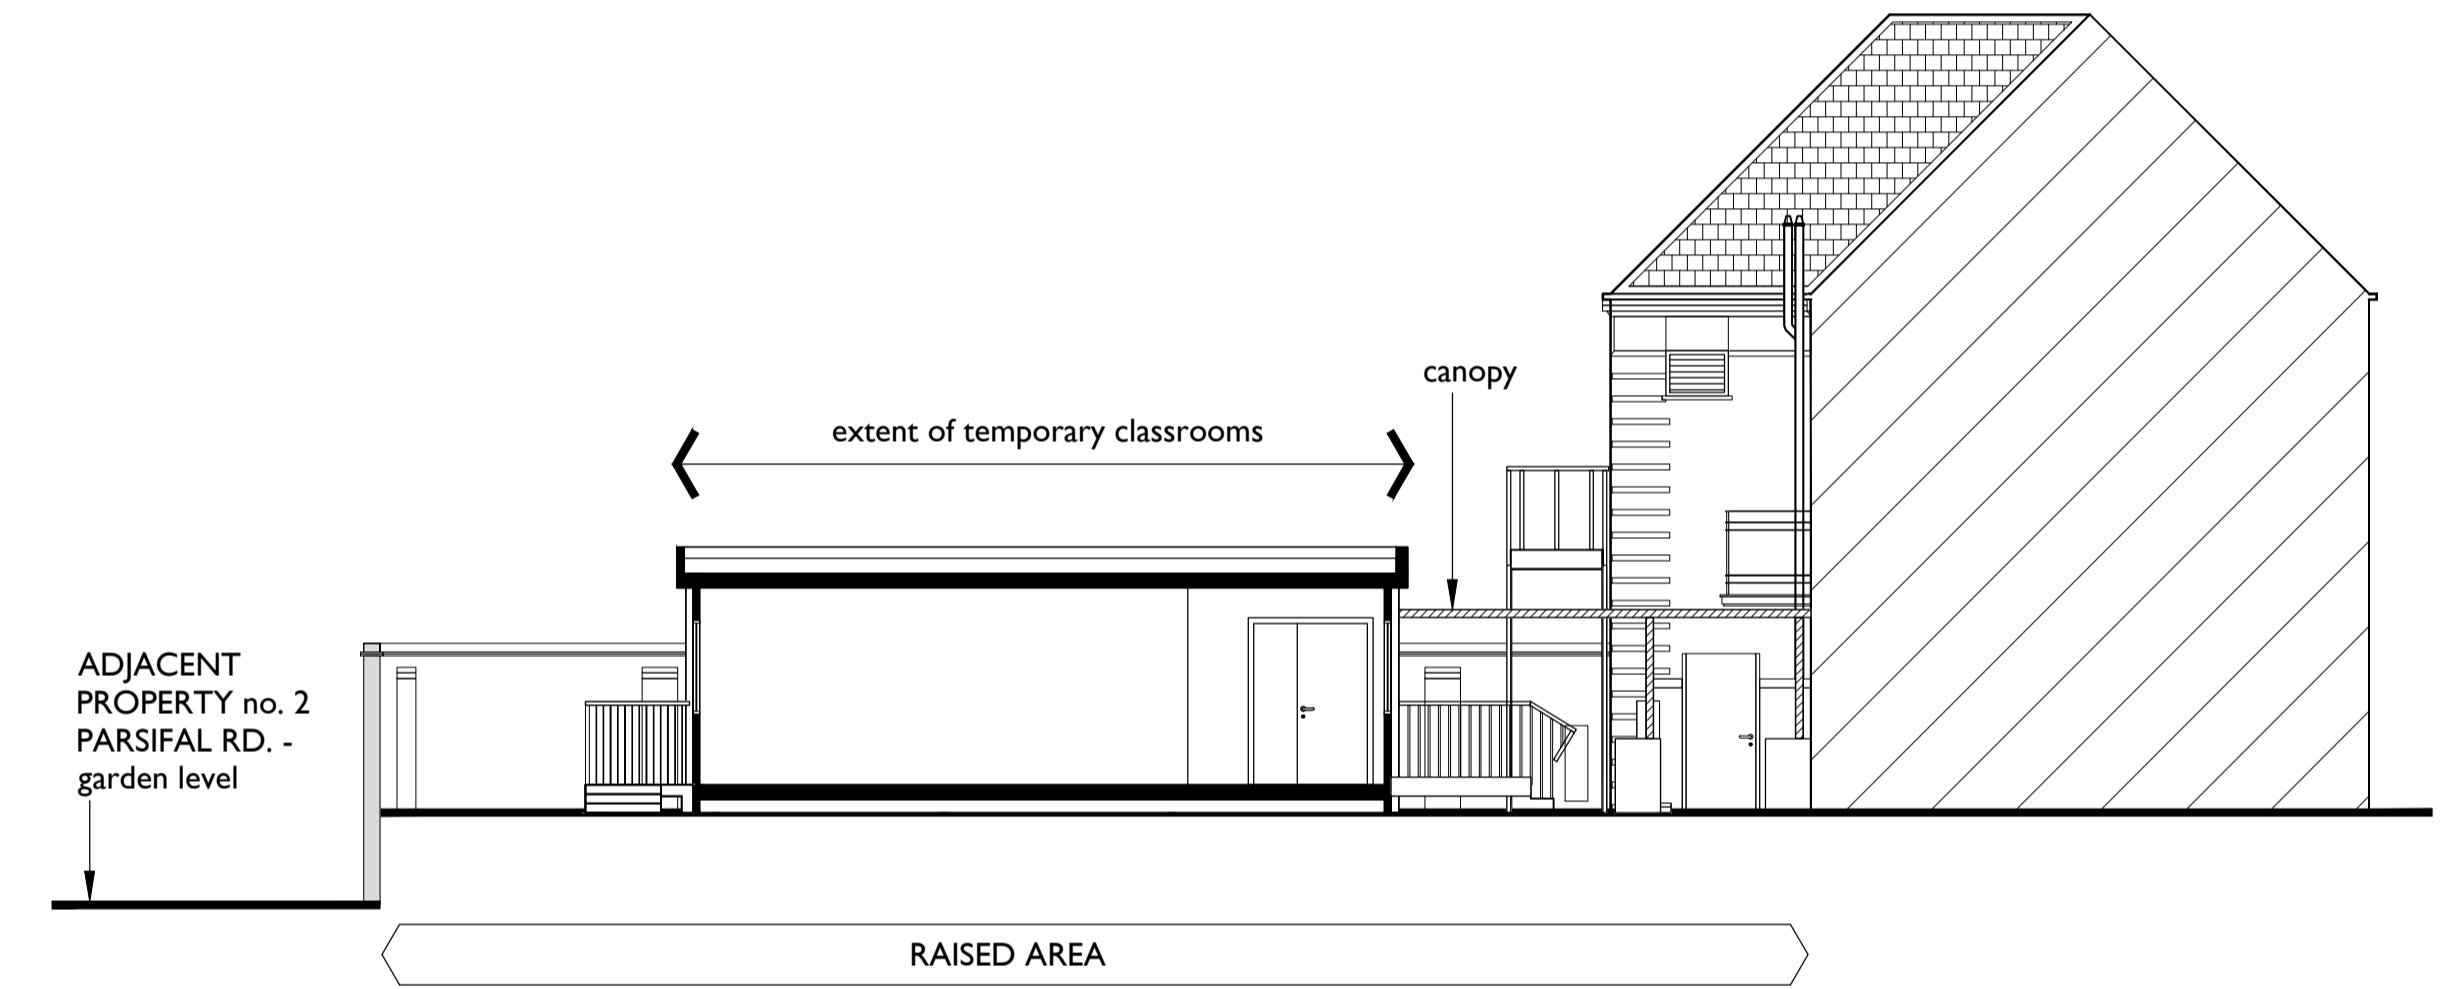

SECTION B (THROUGH RAISED AREA)
Scale 1:100

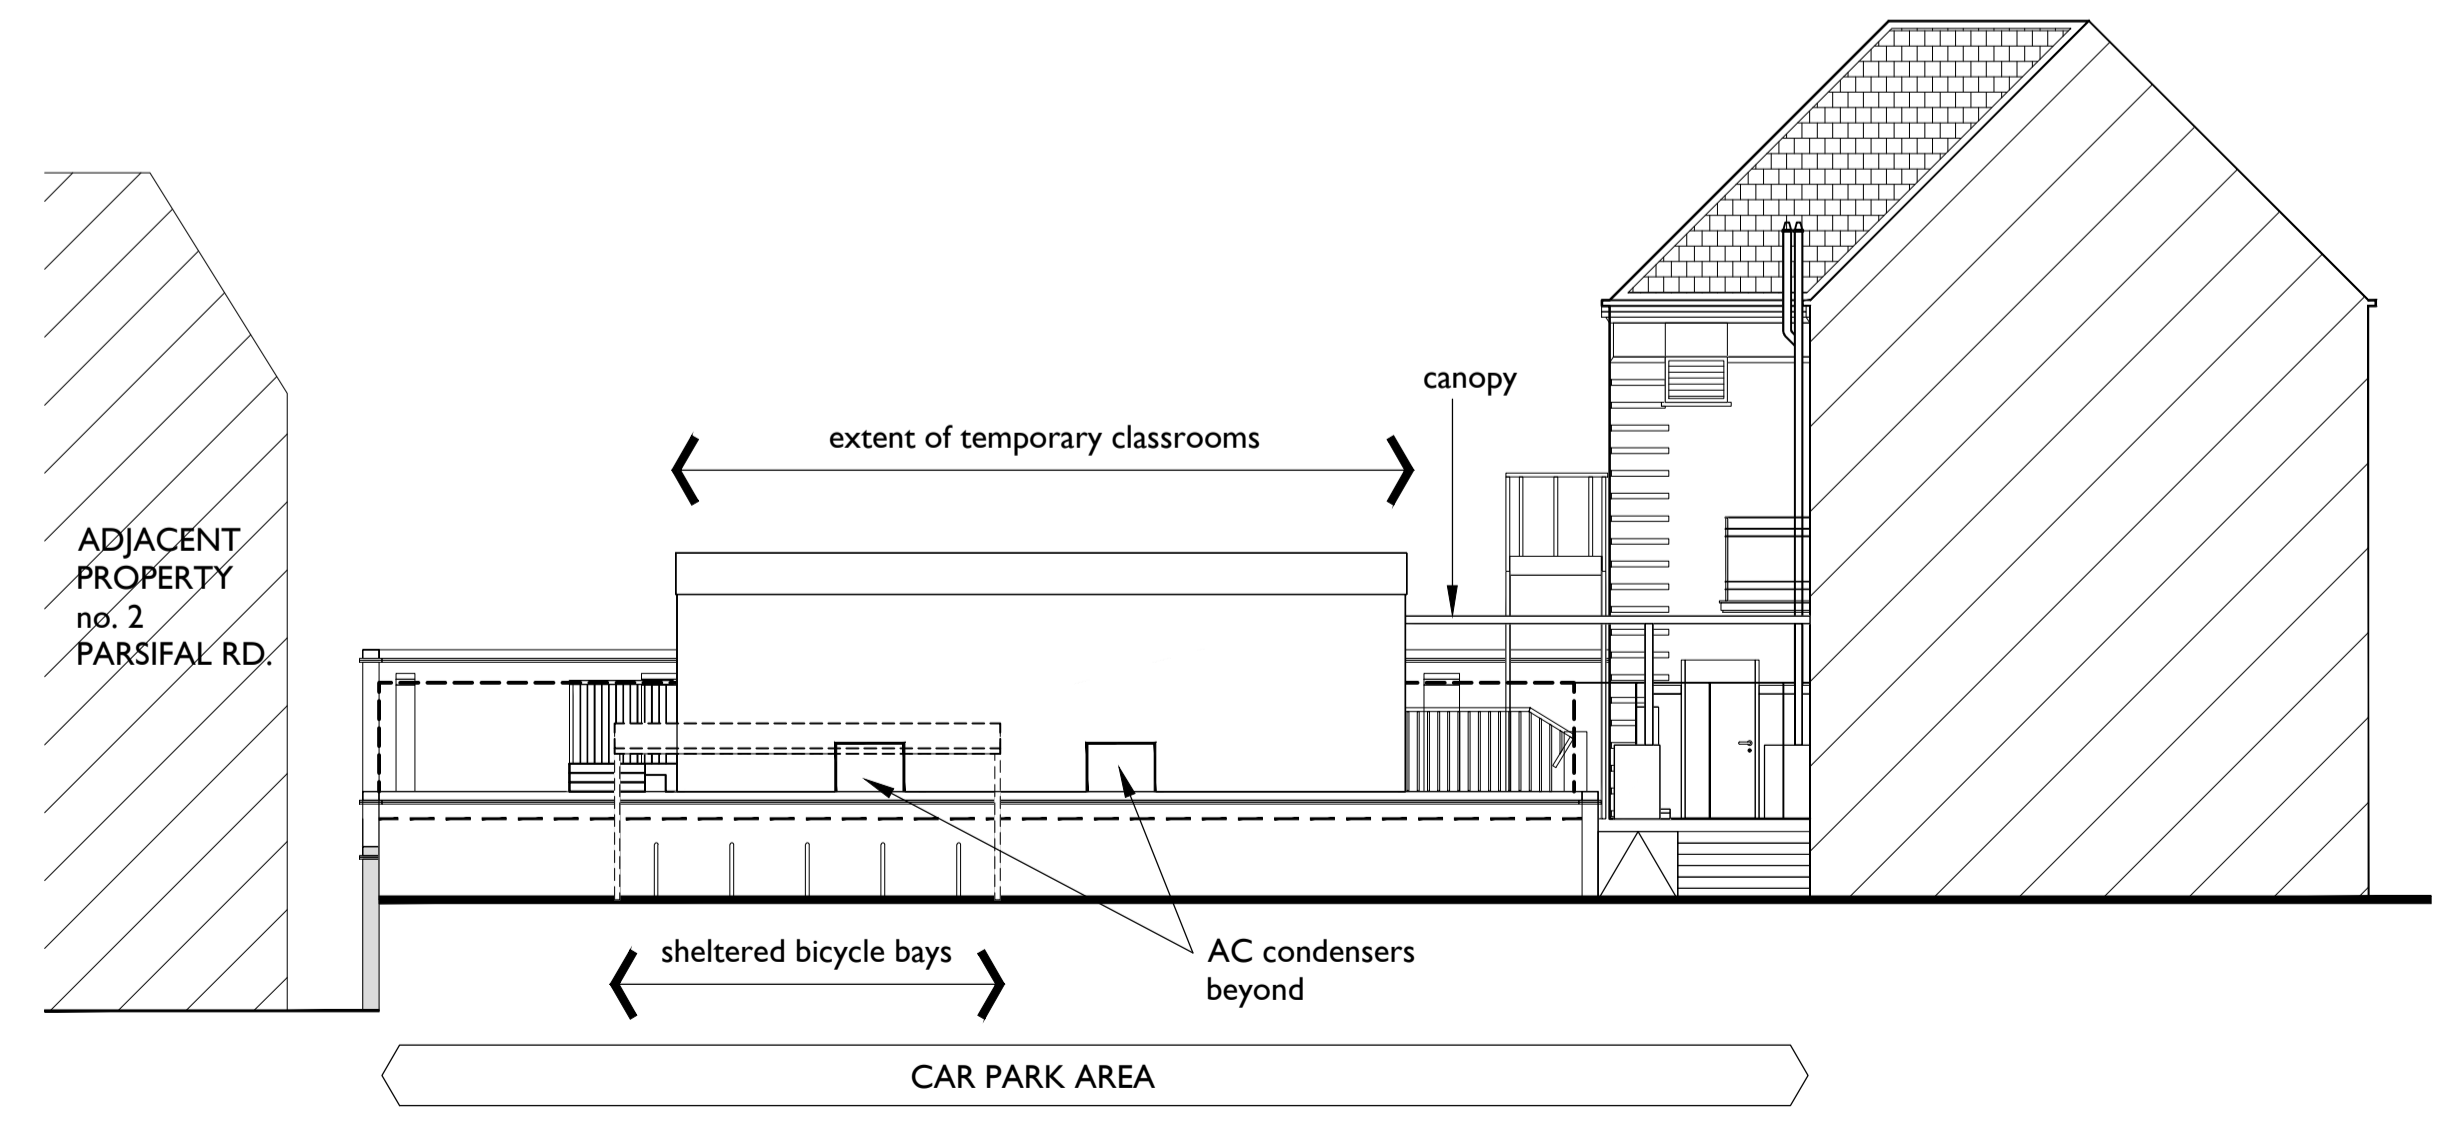

SECTION C (THROUGH CAR PARK AREA)
Scale 1:100

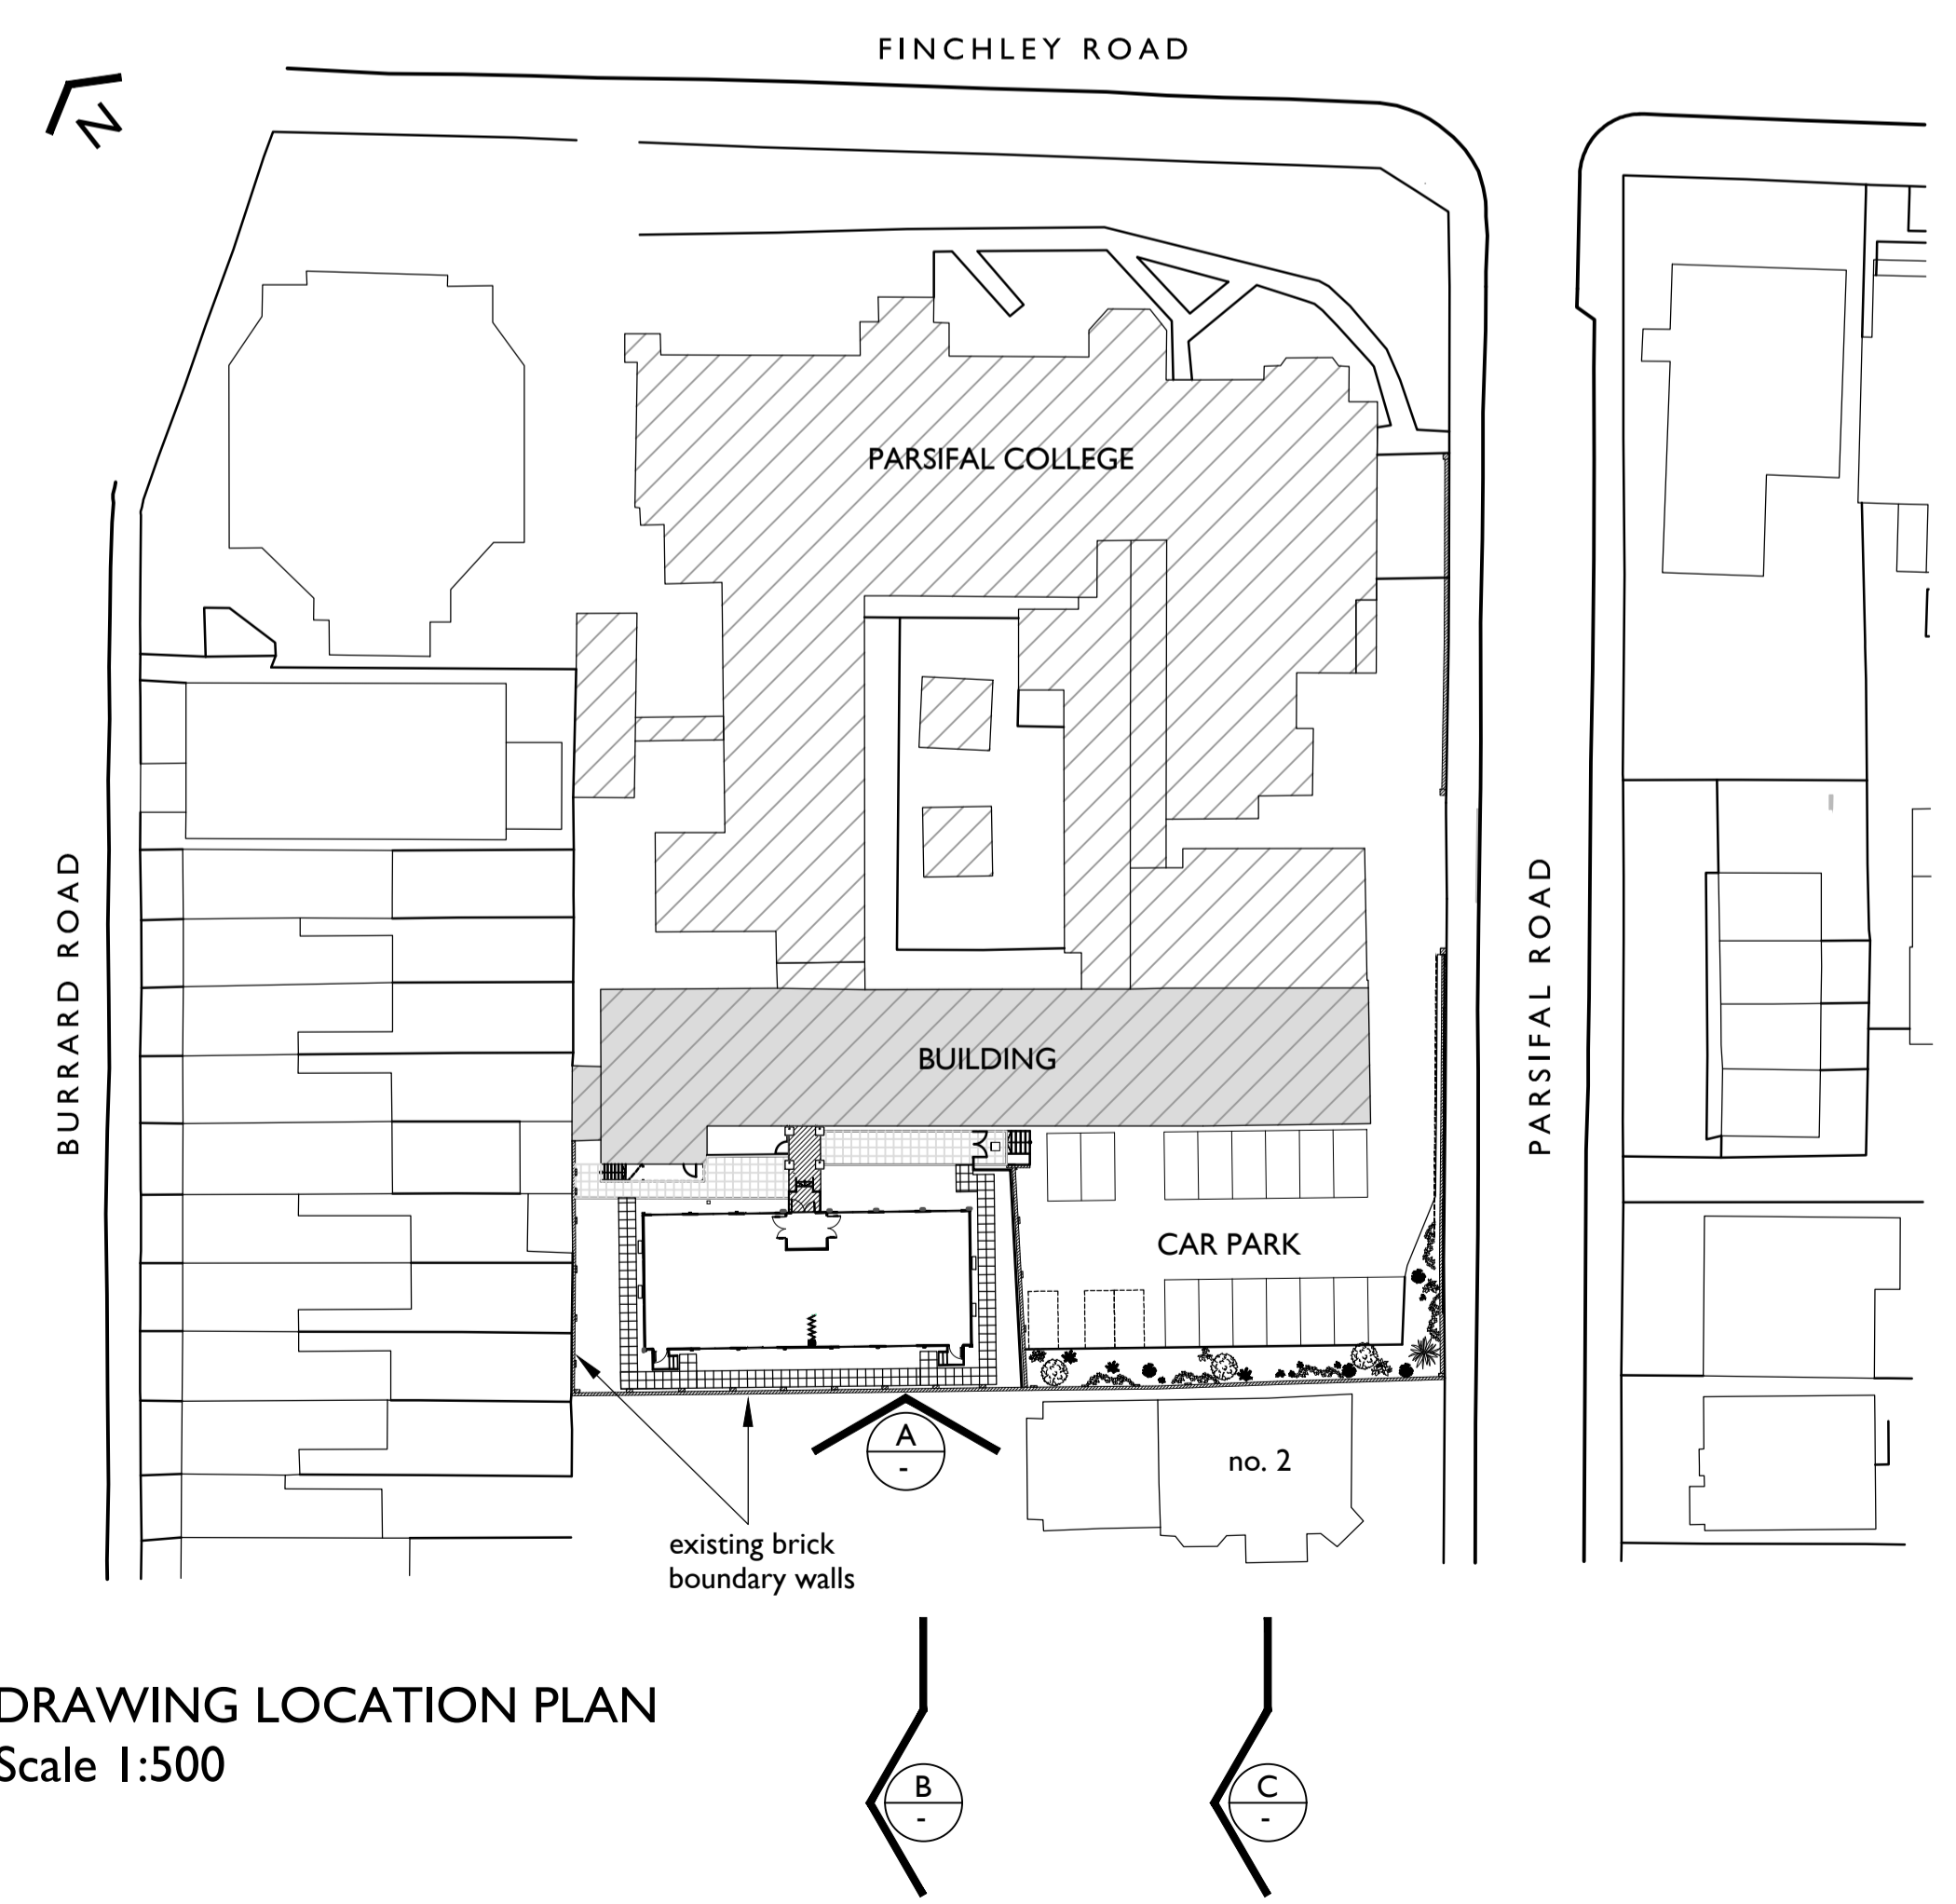

DRAWING LOCATION PLAN
Scale 1:500

* ISSUED FOR PLANNING 09.02.24 TC TM
REV. DESCRIPTION DATE DRN CHKD.

MARKWICK ARCHITECTS
THE OLD DAIRY
51a ST. PETERS STREET
SOUTH CROYDON SURREY CR2 7DG
TELEPHONE 020 8686 2955
E-MAIL ma@markwickarchitects.co.uk

CLIENT
ESCP Europe Business School

PROJECT
**527, Finchley Road,
London NW3 7BG**

DRAWING TITLE
**As Built
Section & Elevations**

DATE February 2024 SCALE as shown @ A1

DRAWING NUMBER 2213 / P / 692 DRAWING REVISION *

DRAWN BY TC CHECKED BY TM