


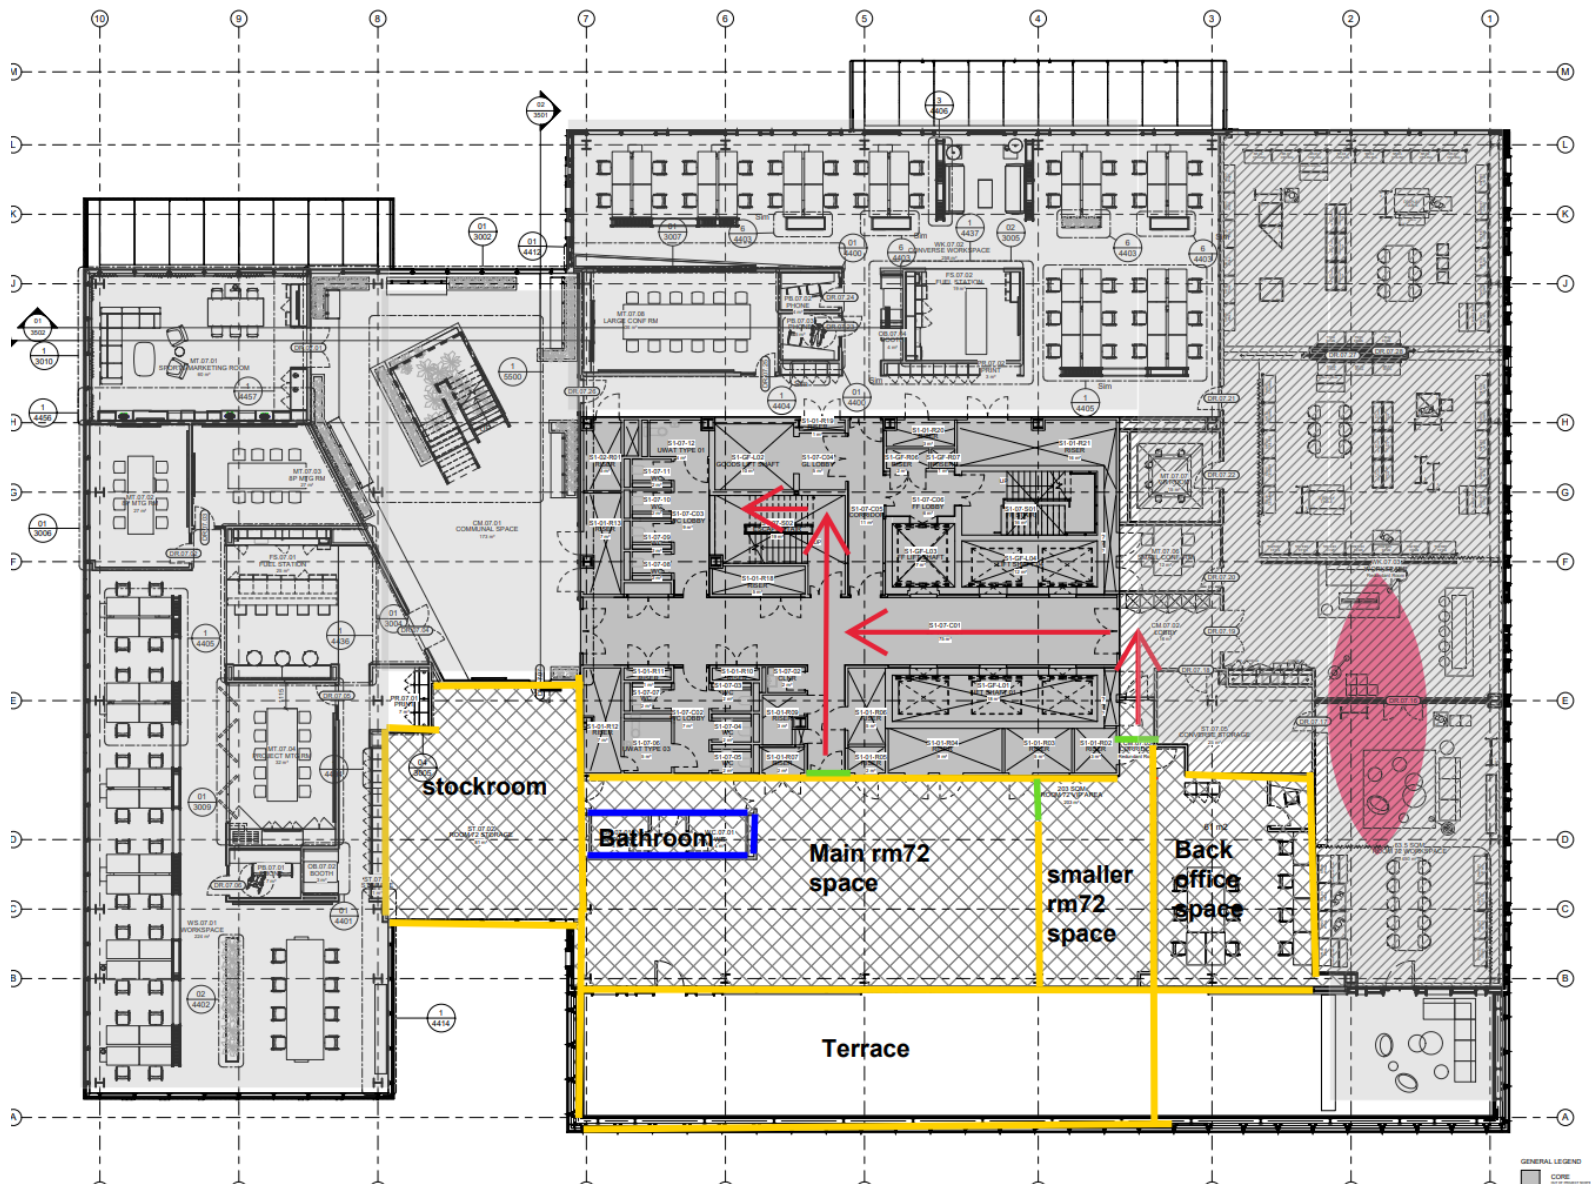

Approval	
Tender	
Contract	
Record Drawing	
Key Diagram	
DRAFT SUBMISSION	
Notes	
T4 14.05.20 STAGE 3 TENDER SUBMISSION SB NK T3 06.05.20 ROOM 72 LAYOUT UPDATED SB NK T2 01.05.20 STAGE 3 TENDER SUBMISSION SB NK T1 24.04.20 STAGE 3 DRAFT TENDER SUBMISSION SB NK	
Rev	Date Description By C/A
Client: NIKE WORKPLACE DESIGN & CONNECTIVITY	
Project: NIKE - LONDON HQ KINGS CROSS S1 HANDYSIDE STREET	
Title: LEVEL 07 - GENERAL ARRANGEMENT	
Scale:	Date:
As indicated @A1	03/27/20
Drawn By:	Checked By:
SB	MJ
Drawing No:	Revision:
0676_BDG_XX_107_DR_A_2001	
East Studio Riverside Walk. See Containers, 18 Upper ground.	