

Designed by: LS Checked by: JBF Project: 1952


Drawing name:
Proposed Basement
General arrangement

Drawing reference:
011_FB Revision B

Date: 30/09/22 Scale: @A3 NTS Drawing Status: AB

Filename:
011_FB - Proposed Basement GA

Revision: AB Description: AS BUILT Date: 30.09.22

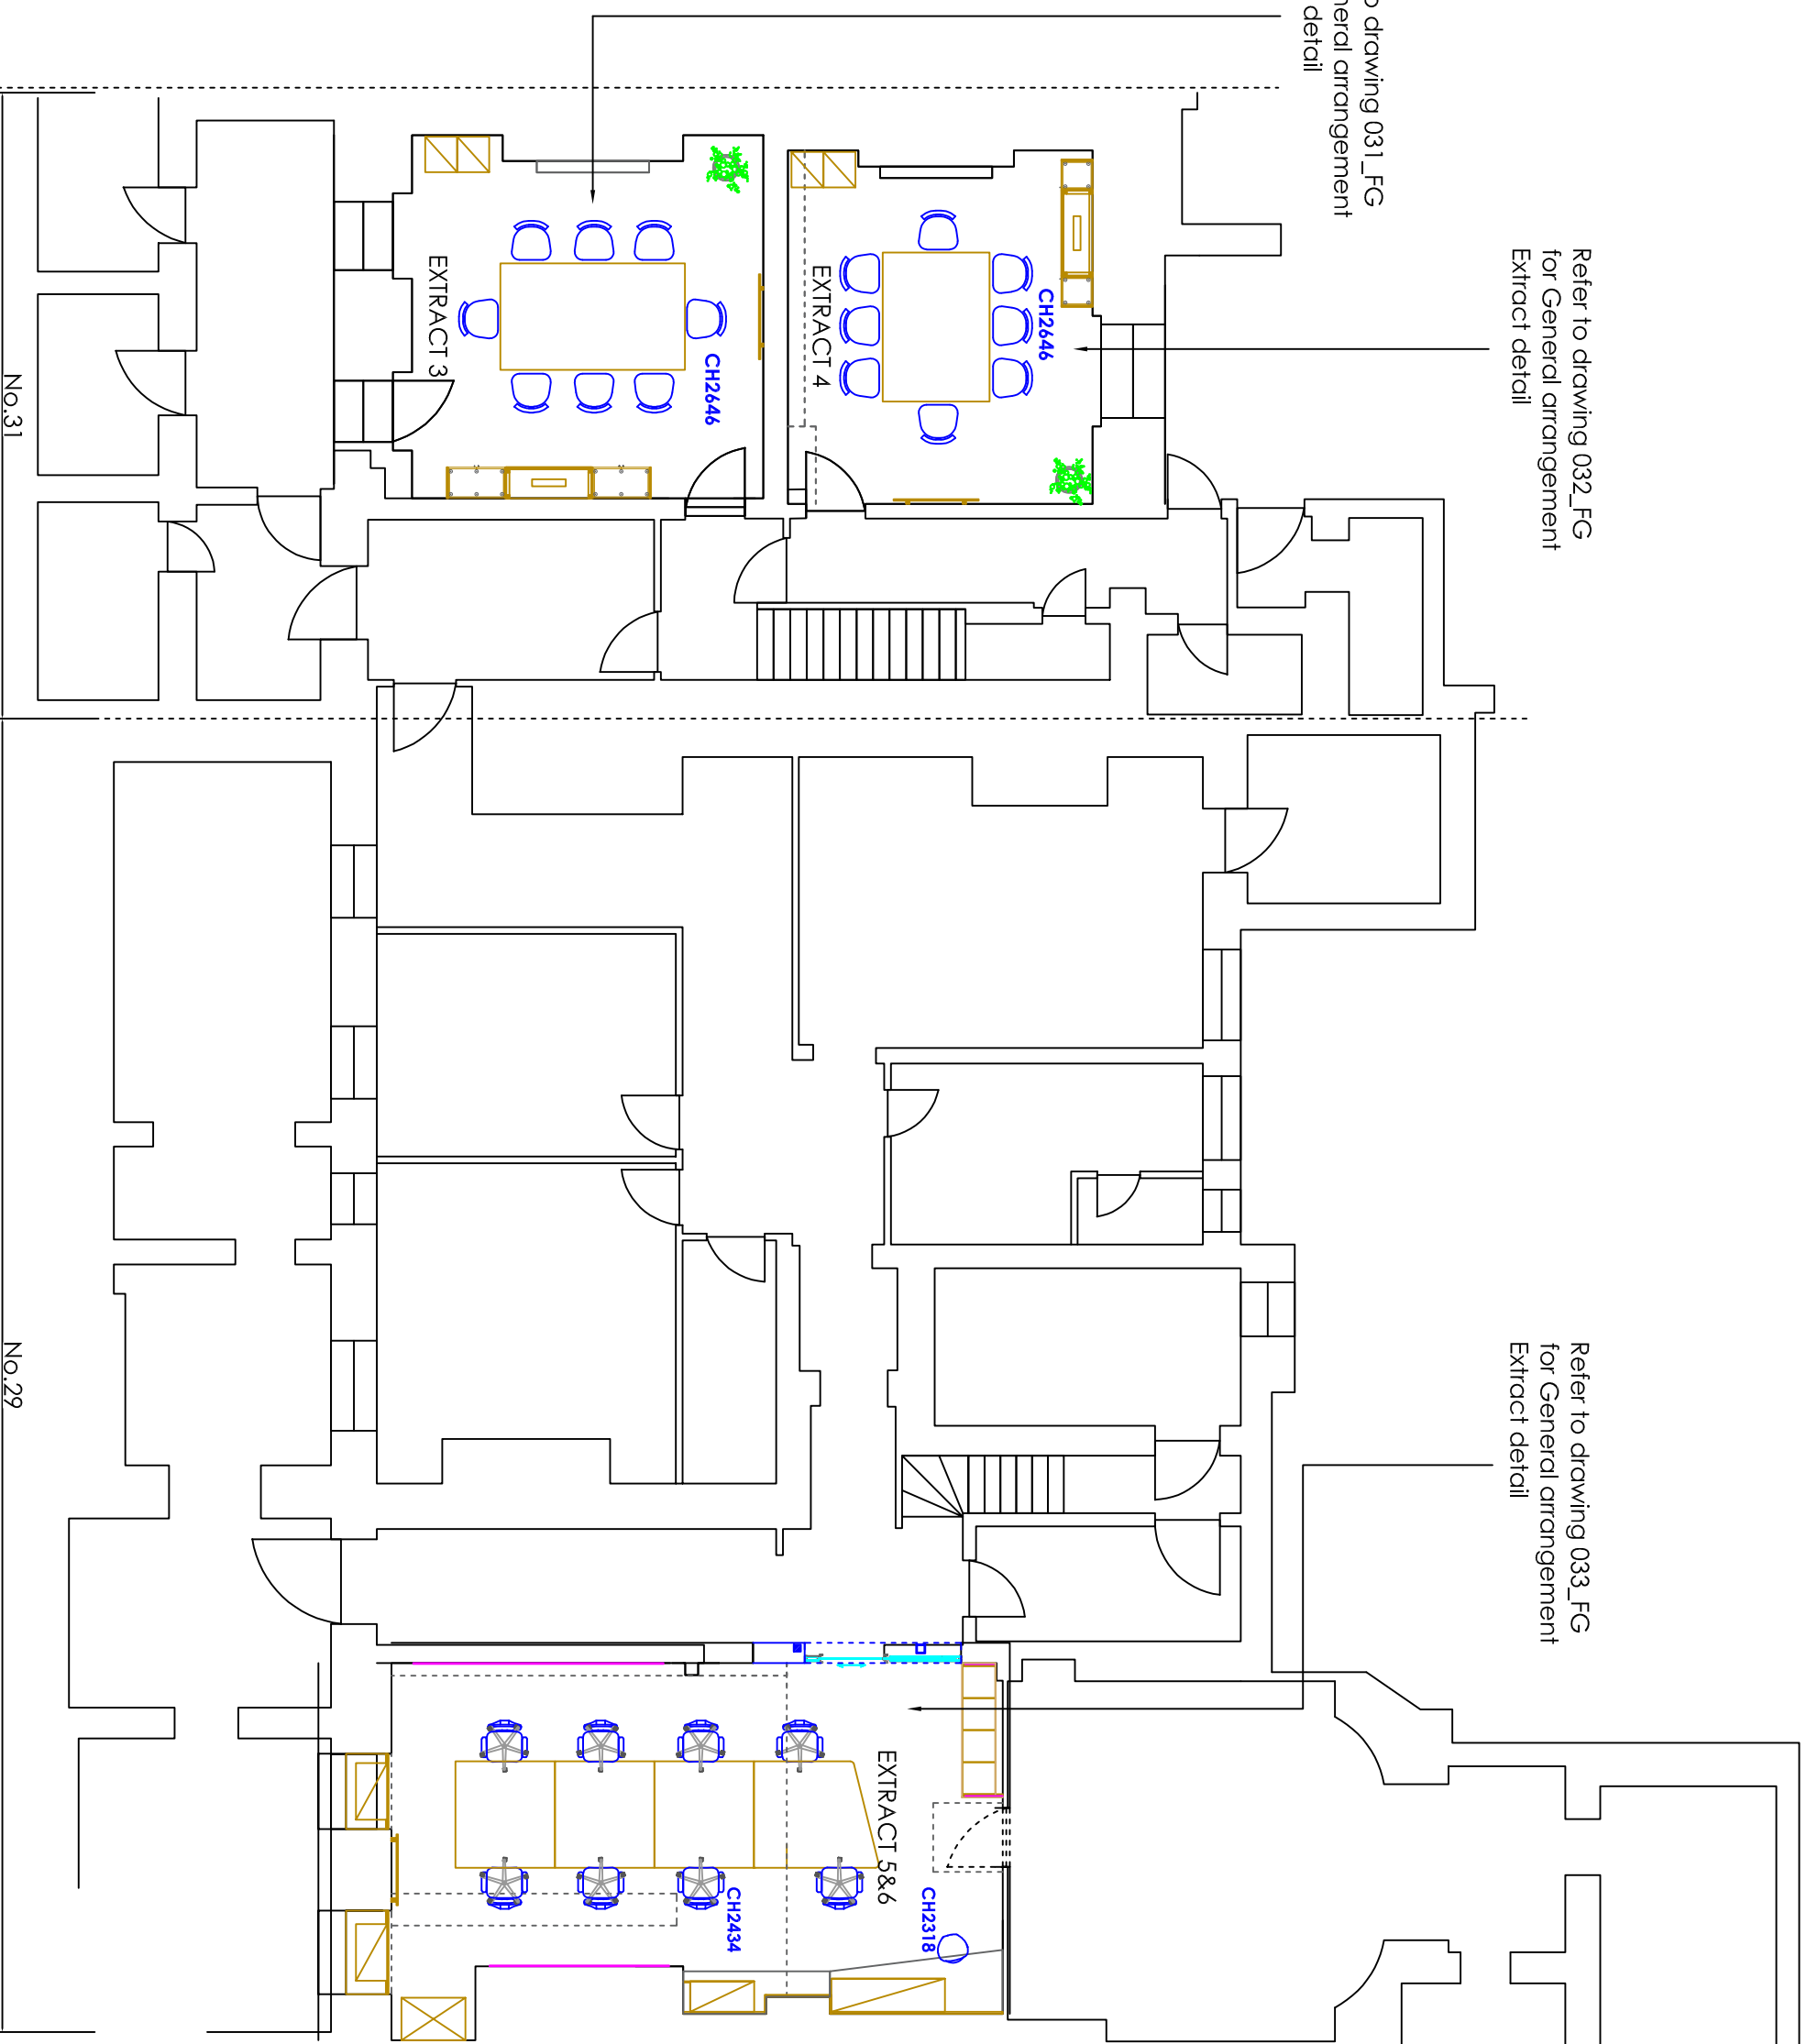

Refer to drawing 032_FG
for General arrangement
Extract detail

Refer to drawing 031_FG
for General arrangement
Extract detail

Refer to drawing 033_FG
for General arrangement
Extract detail

Not drawn to scale

Do not scale from this drawing. All dimensions to be verified on site prior to the commencement of any work or the production of any shop drawing.

This drawing remains the property of Progress, and is not to be disclosed or discussed with any third party without prior written authorization from Progress. All rights reserved.