

Designed by: MC Checked by: JBF Project: 1952

Drawing name:
 Basement Extract 5&6
 Proposed general arrangement


Drawing reference:
 033_FB Revision E

Date: 30/09/22 Scale: @A3 1:50 Drawing Status: AB

Filename:
 033_FB - Basement Extract 5&6

Revision: AB Description: AS BUILT Date: 30.09.22

Survey Dimensions 15.08.22

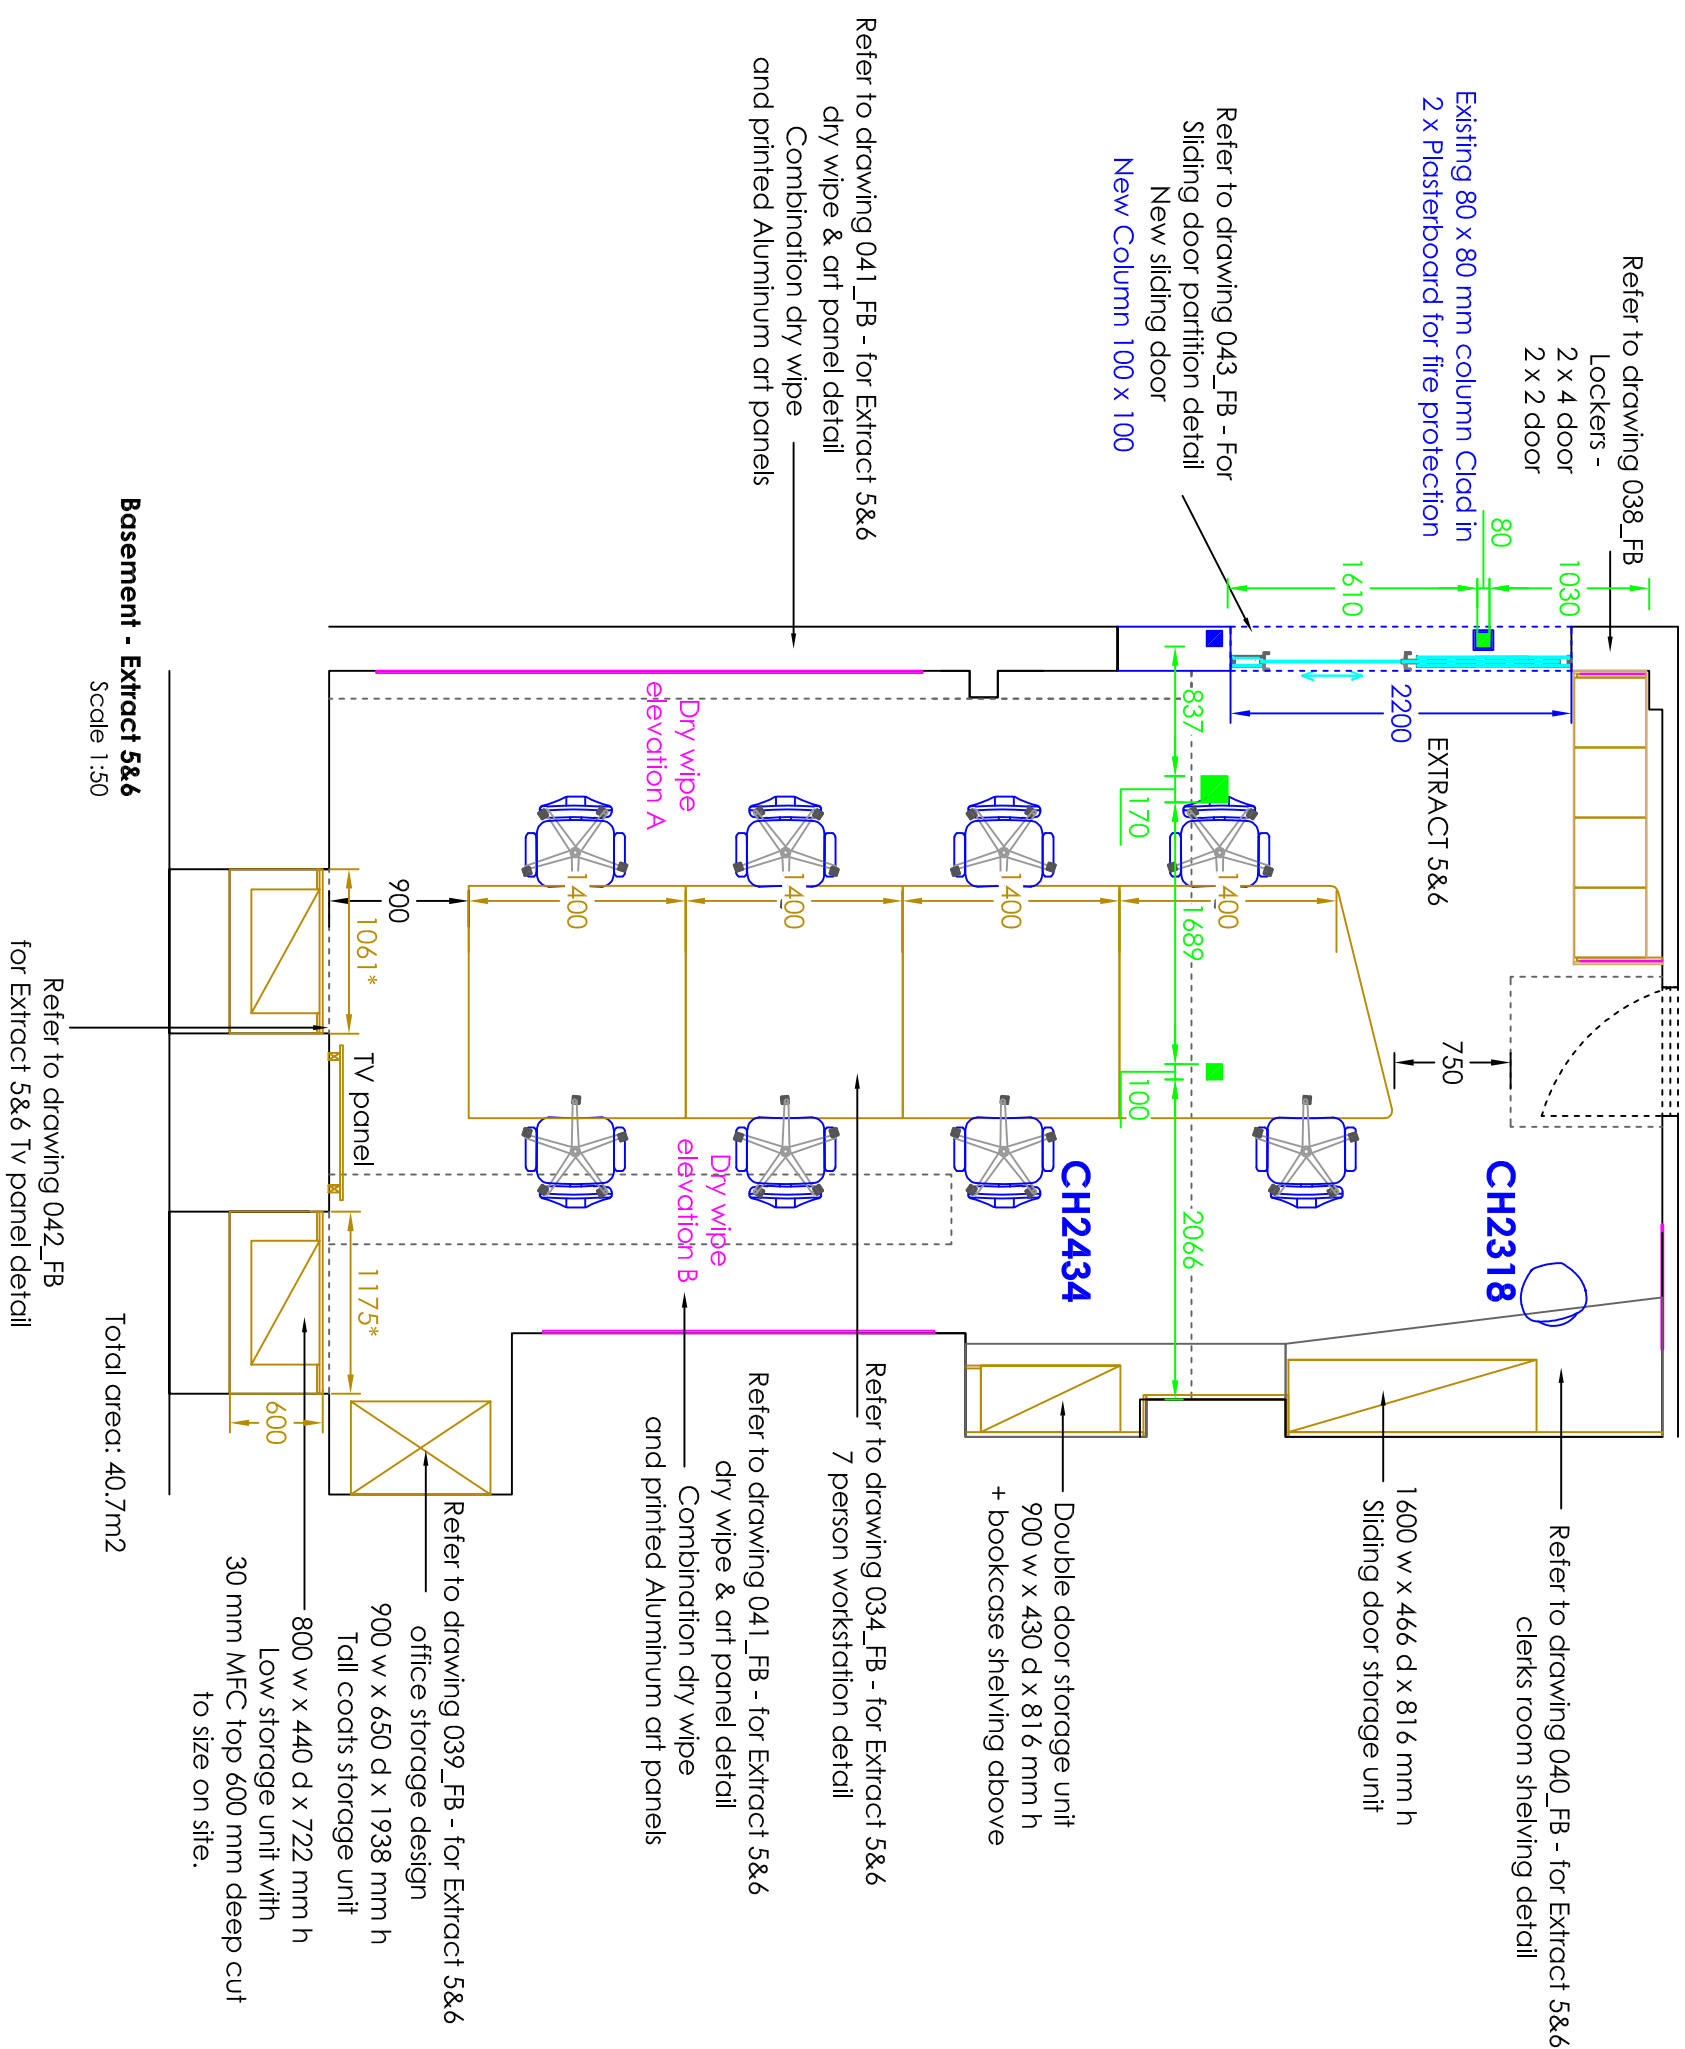

Basement - Extract 5&6
 Scale 1:50

Refer to drawing 042_FB
 for Extract 5&6 Tv panel detail

Do not scale from this drawing. All dimensions to be verified on site prior to the commencement of any work or the production of any shop drawing.

This drawing remains the property of Progress, and is not to be disclosed or discussed with any third party without prior written authorization from Progress. All rights reserved.