


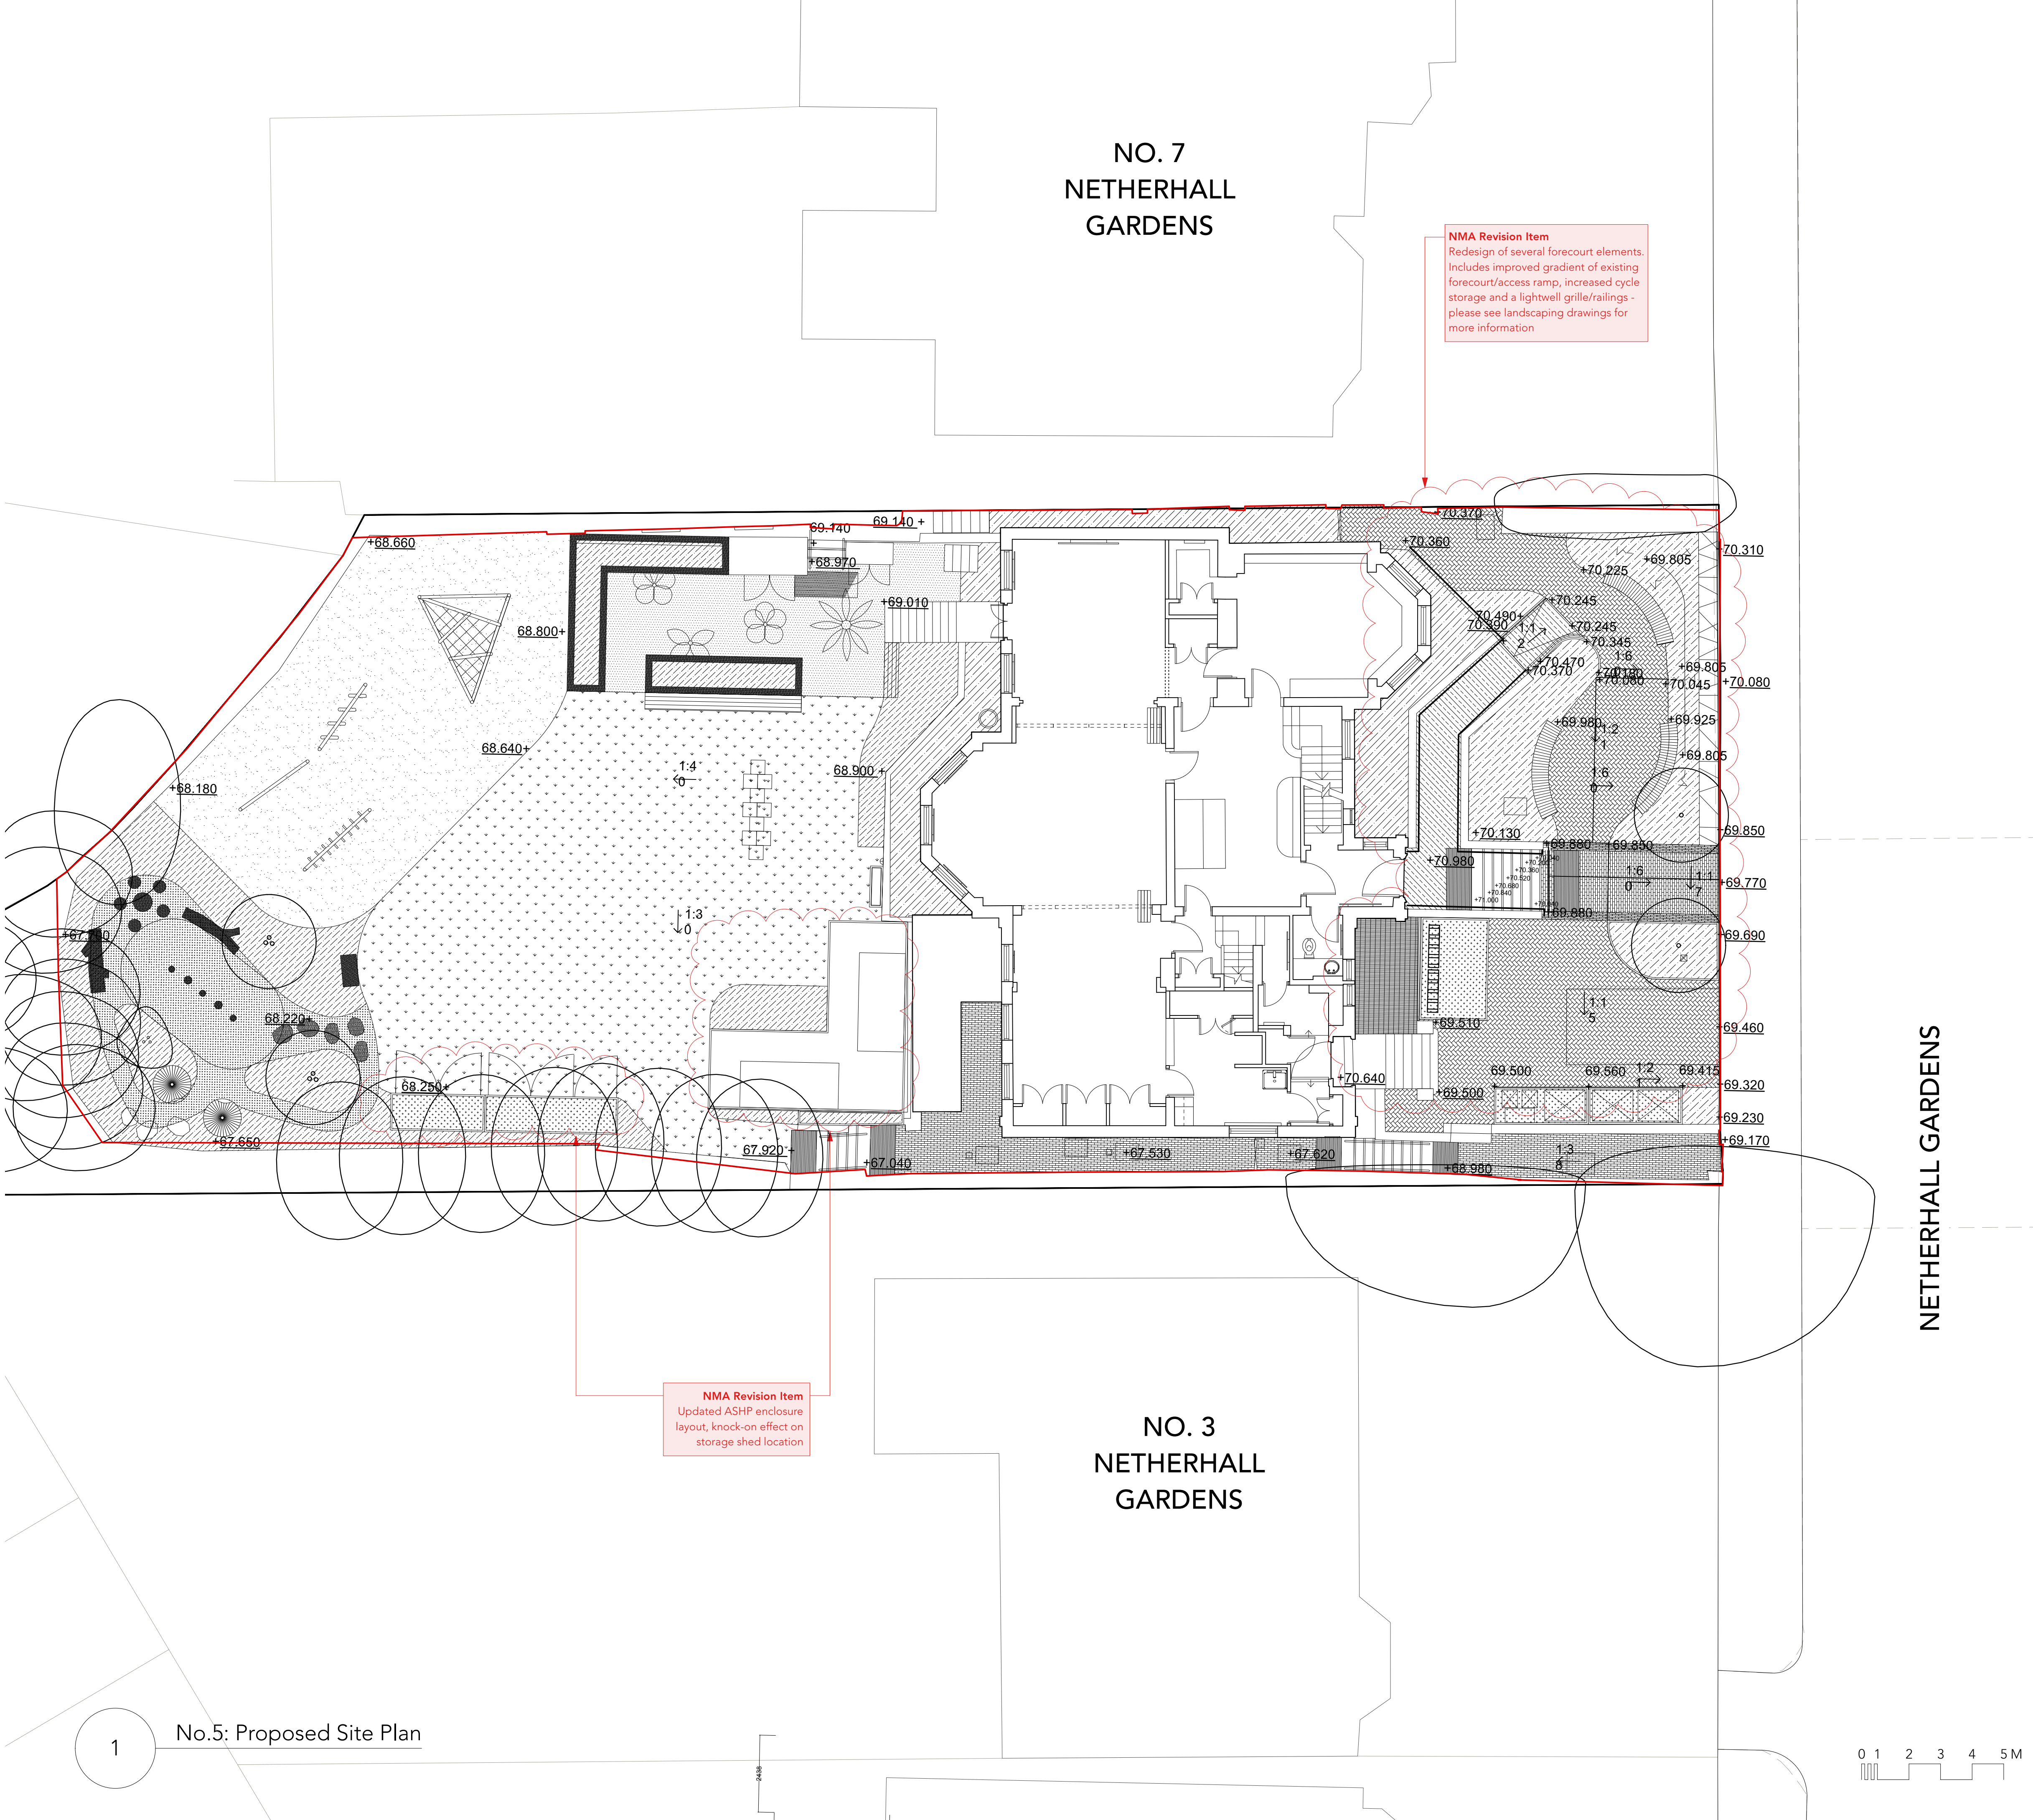

NO. 7
NETHERHALL
GARDENS

NMA Revision Item
Redesign of several forecourt elements.
Includes improved gradient of existing
forecourt/access ramp, increased cycle
storage and a lightwell grille/railings -
please see landscaping drawings for
more information

NMA Revision Item
Updated ASHP enclosure
layout, knock-on effect on
storage shed location


NETHERHALL GARDENS


NO. 3
NETHERHALL
GARDENS

KEY

Red Line Boundary

Please read alongside drawings by BJD
Landscape Architects for more information
relating the the NMA updates, specifically
relating to landscaping proposal and
boundary treatments.

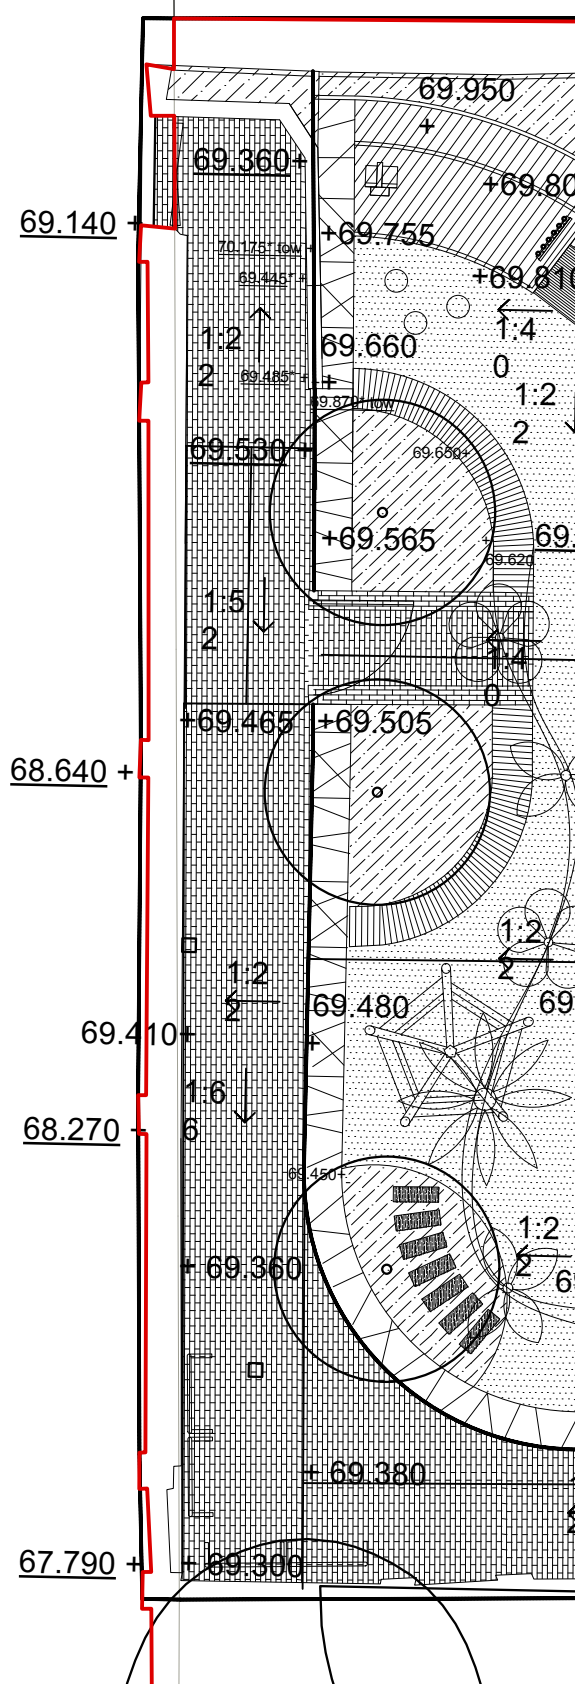

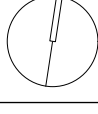19/02/2024		A	Update as part of NMA submission. Changes highlighted.		CB
date		revision		revision	
Do not scale from drawings Confirm all dimensions on site prior to manufacture Confirm discrepancies with Architect prior to proceeding Refer to all Engineers' documentation					
job no.		job title			
628		SHJS Netherhall Gardens			
date		dwg. title			
01/12/2022		No.5: Proposed Site Plan			
CB	drawn	Client: GDST			
SW	checked	Scale: 1:50 @ A1 / 1:100 @ A3			
		dwg. no.		rev. no.	
628_P503				A	
PLANNING					
© Sarah Wigglesworth Architects					
T +44 (0)20 7607 9200 F +44 (0)20 7607 5800 E mail@swarch.co.uk W www.swarch.co.uk					

No.5: Proposed Site Plan