
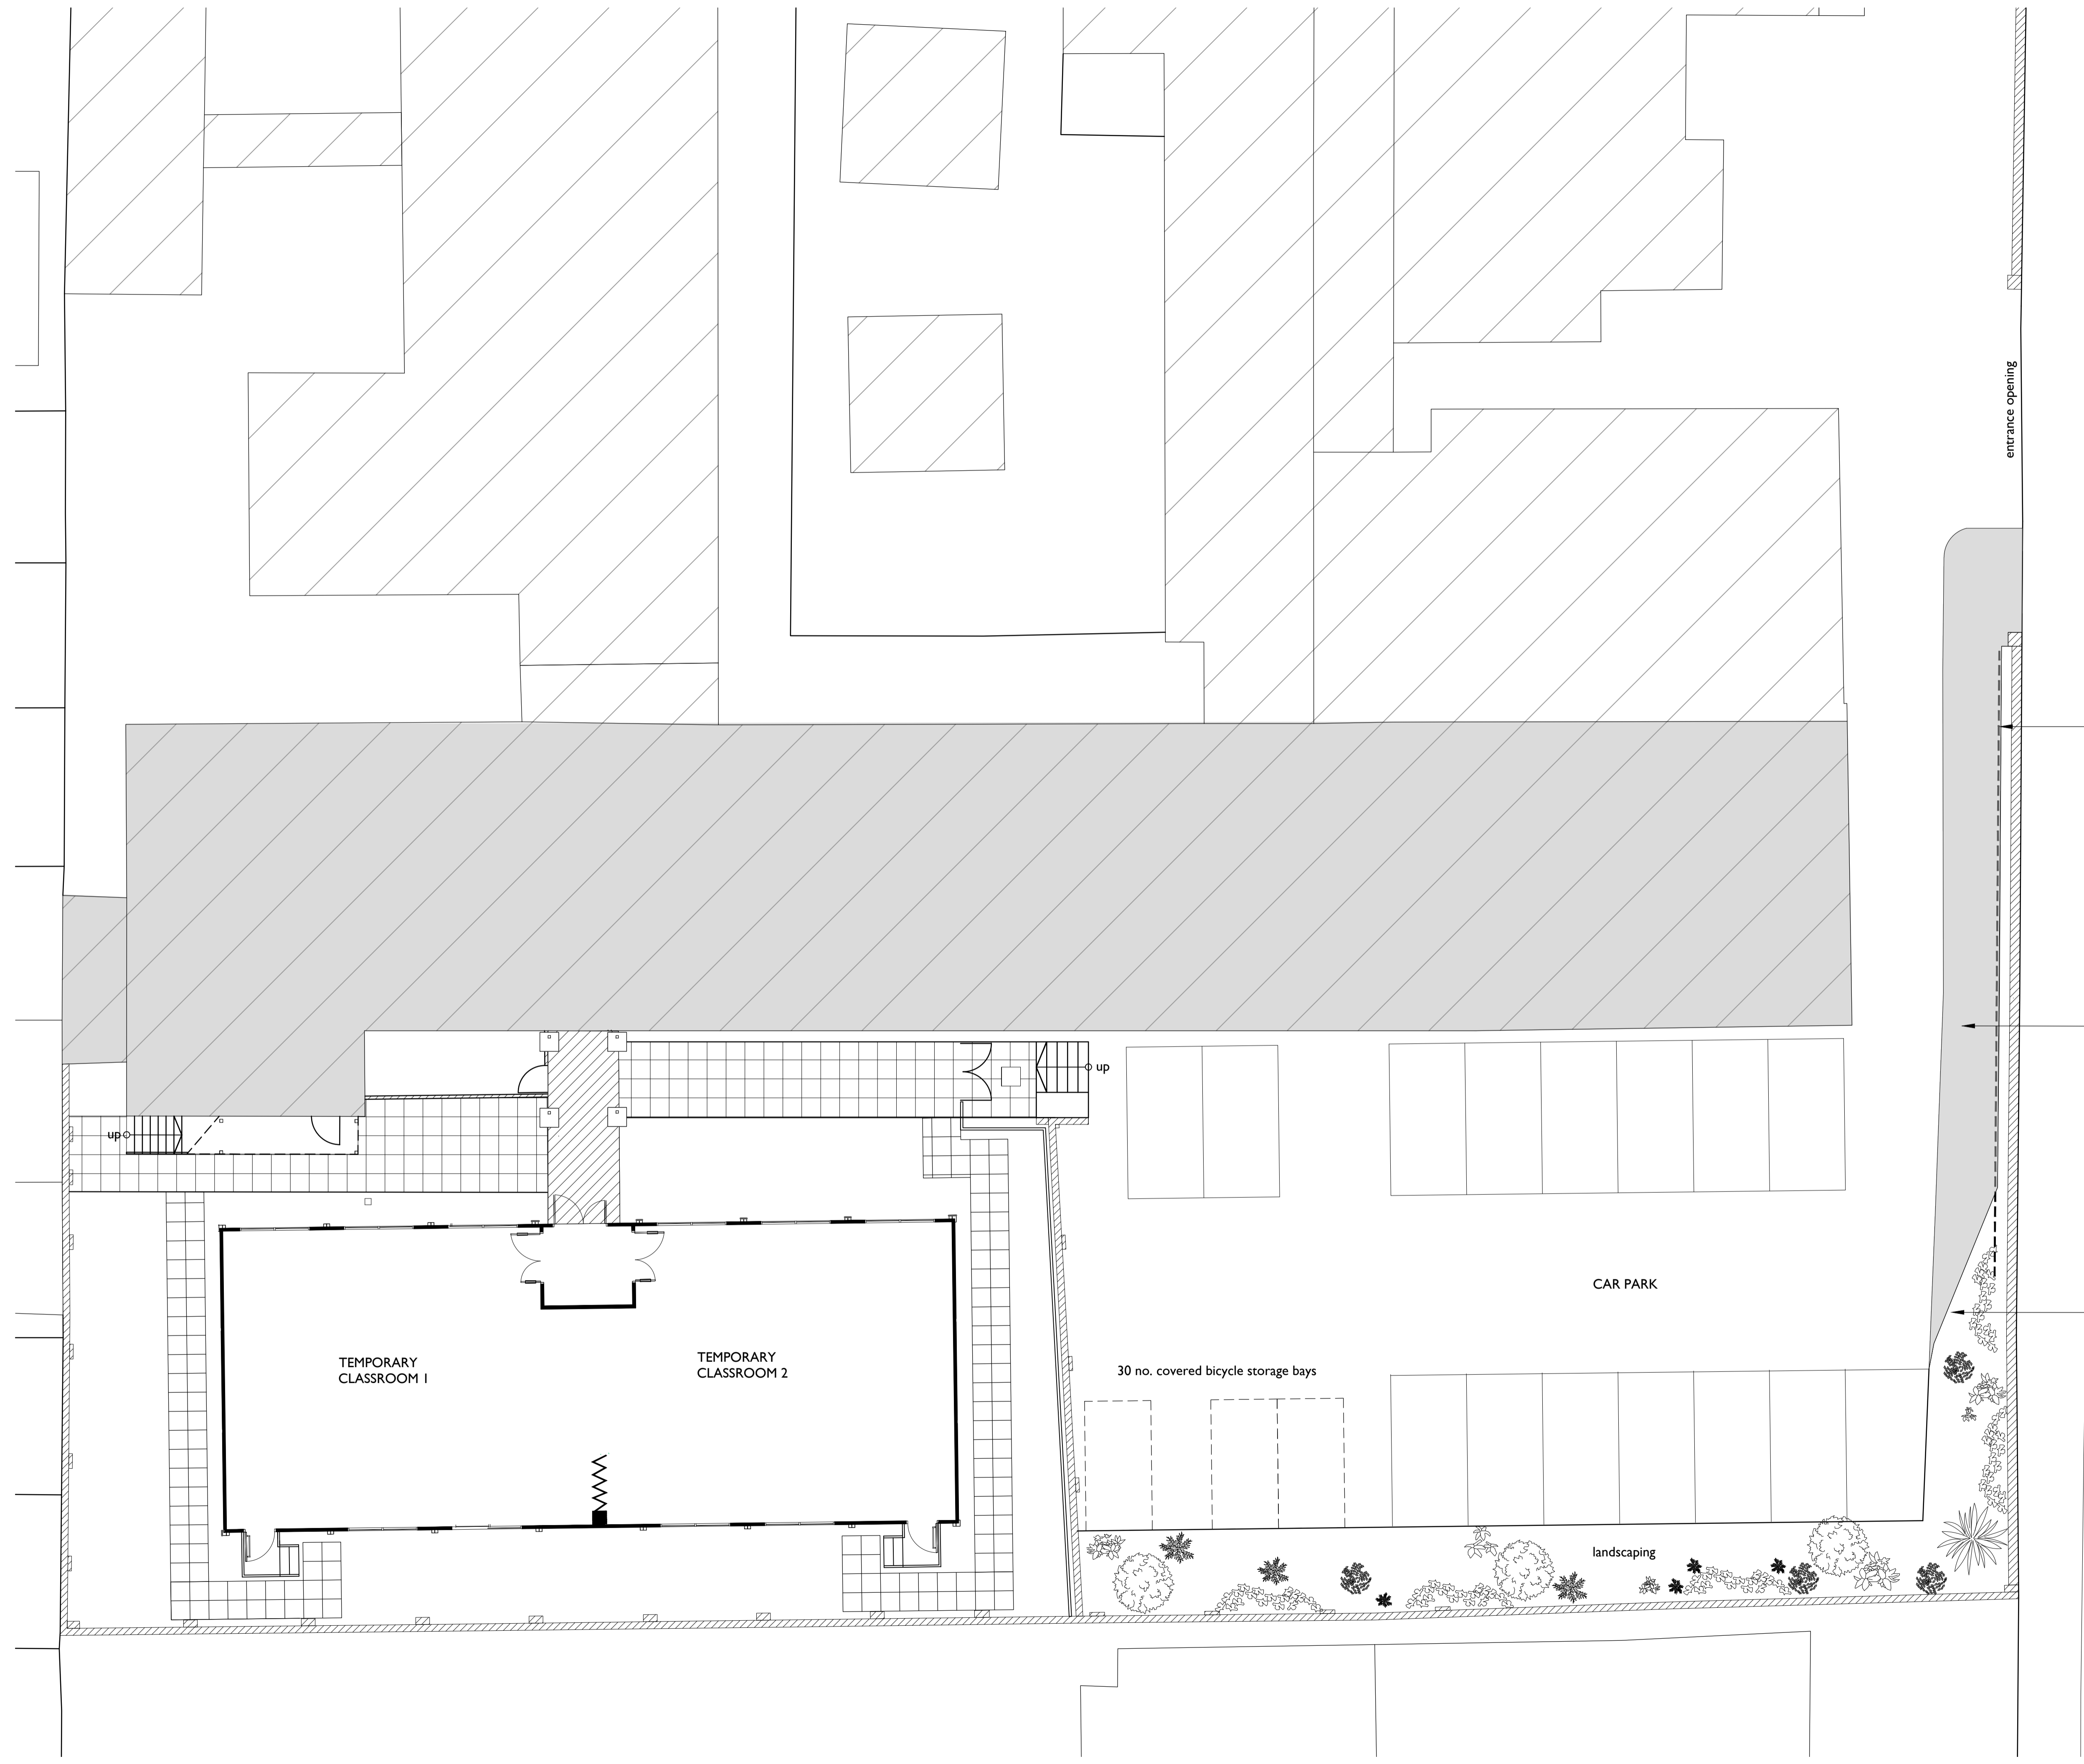


THESE NOTES ARE IMPORTANT
 If you are in any doubt about something - ASK
 This drawing must be read in conjunction with all necessary architectural, structural, services drawings and scope of works
 This drawing is copyright protected and unless specifically agreed with Markwick Architects can only be used for the project noted in the title box below.

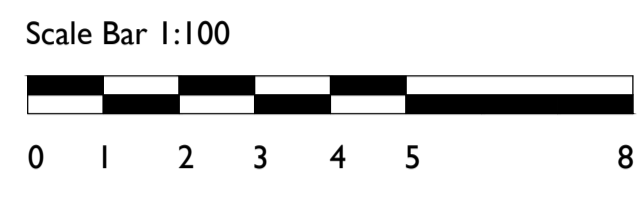

vehicle crash barrier

PARSIFAL ROAD

new handstanding area = 45m²

kerbline

CAR PARK

30 no. covered bicycle storage bays

landscaping

TEMPORARY CLASSROOM 1

TEMPORARY CLASSROOM 2

* ISSUED FOR PLANNING 09.02.24 TC TM
 REV. DESCRIPTION DATE DRN CHKD.

MARKWICK ARCHITECTS
 THE OLD DAIRY
 51a ST. PETERS STREET
 SOUTH CROYDON SURREY CR2 7DG
 TELEPHONE 020 8686 2955
 E-MAIL ma@markwickarchitects.co.uk

CLIENT
ESCP European Business School

PROJECT
**527, Finchley Road
 London NW**

DRAWING TITLE
**As Built
 Site Plan**

DATE
February 2024 SCALE
1:100 @ A1

DRAWING NUMBER
2213 / P / 696 DRAWING REVISION

DRAWN BY
TC CHECKED BY
TM