

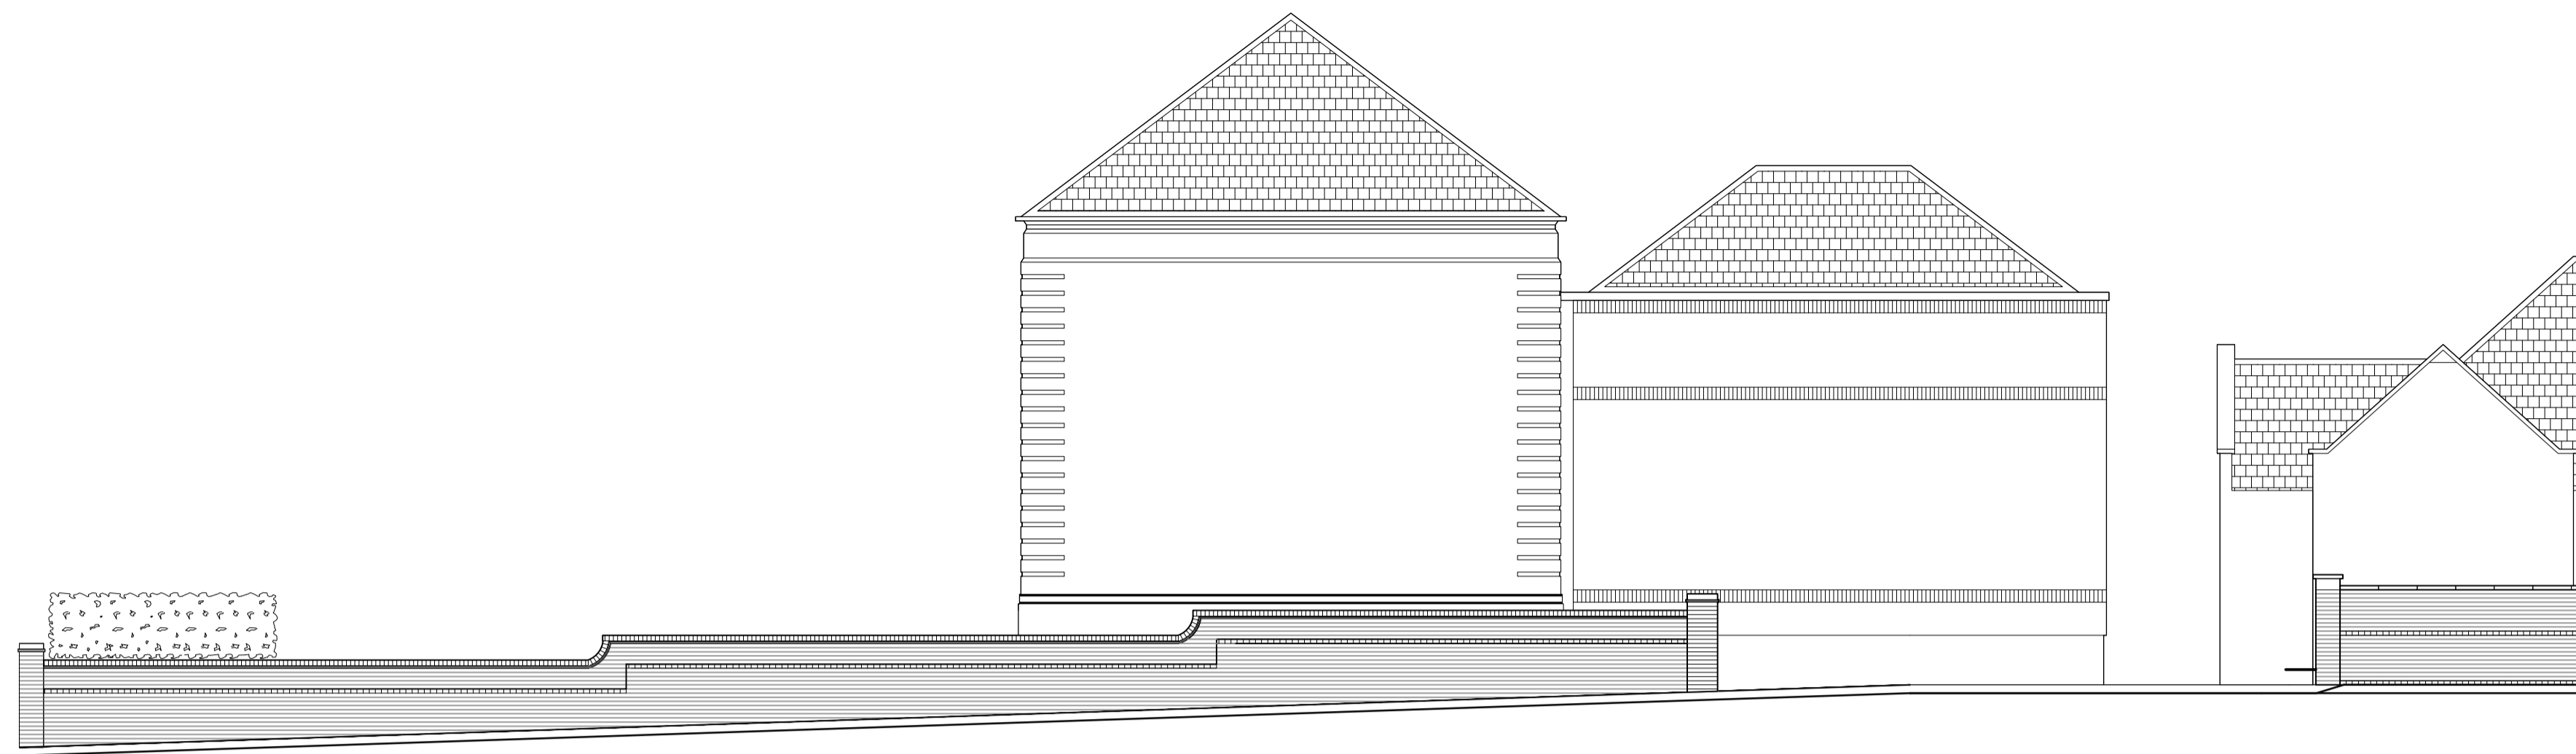



THESE NOTES ARE IMPORTANT  
 If you are in any doubt about something - ASK  
 This drawing must be read in conjunction with all necessary architectural, structural, services drawings and scope of works  
 This drawing is copyright protected and unless specifically agreed with Markwick Architects can only be used for the project noted in the title box below.

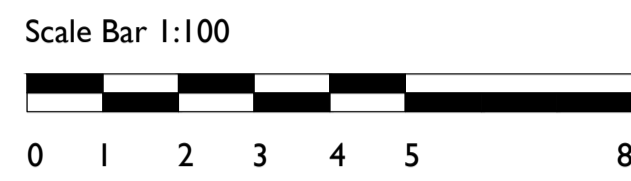

PRE EXISTING PARSIFAL ROAD ENTRANCE

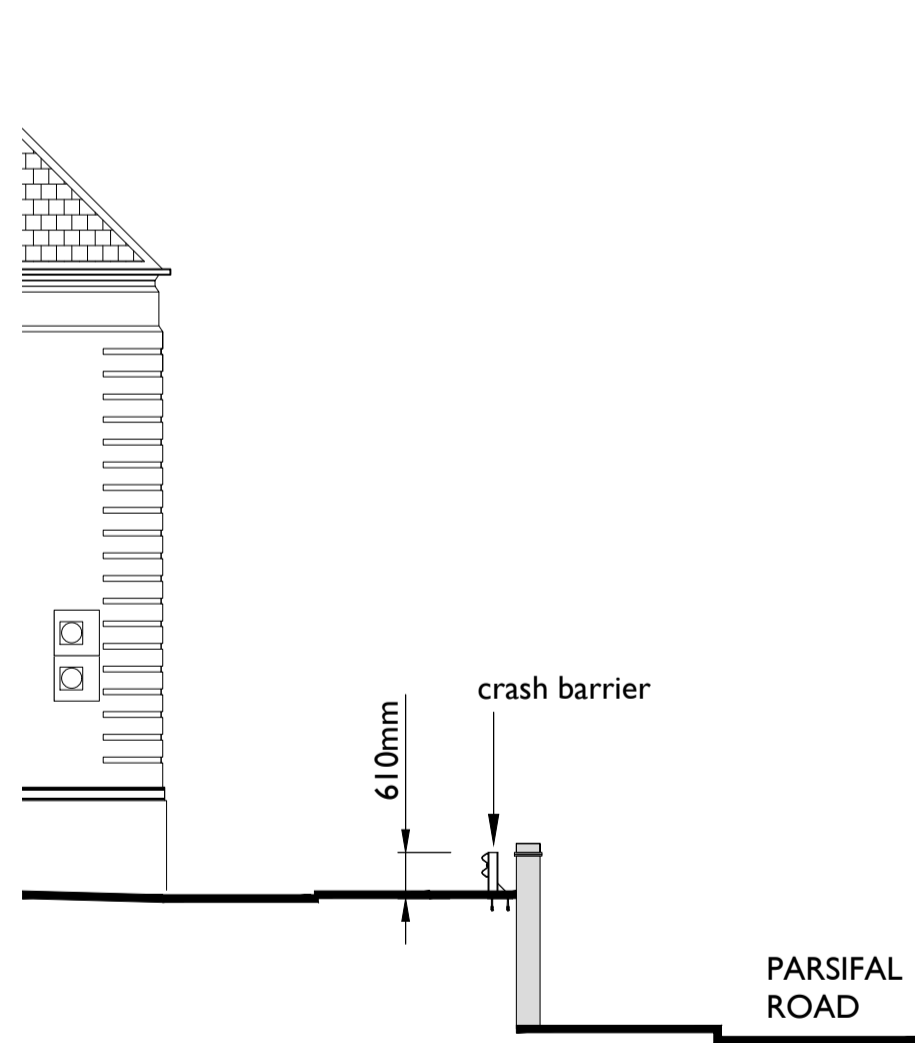

SECTION A - A

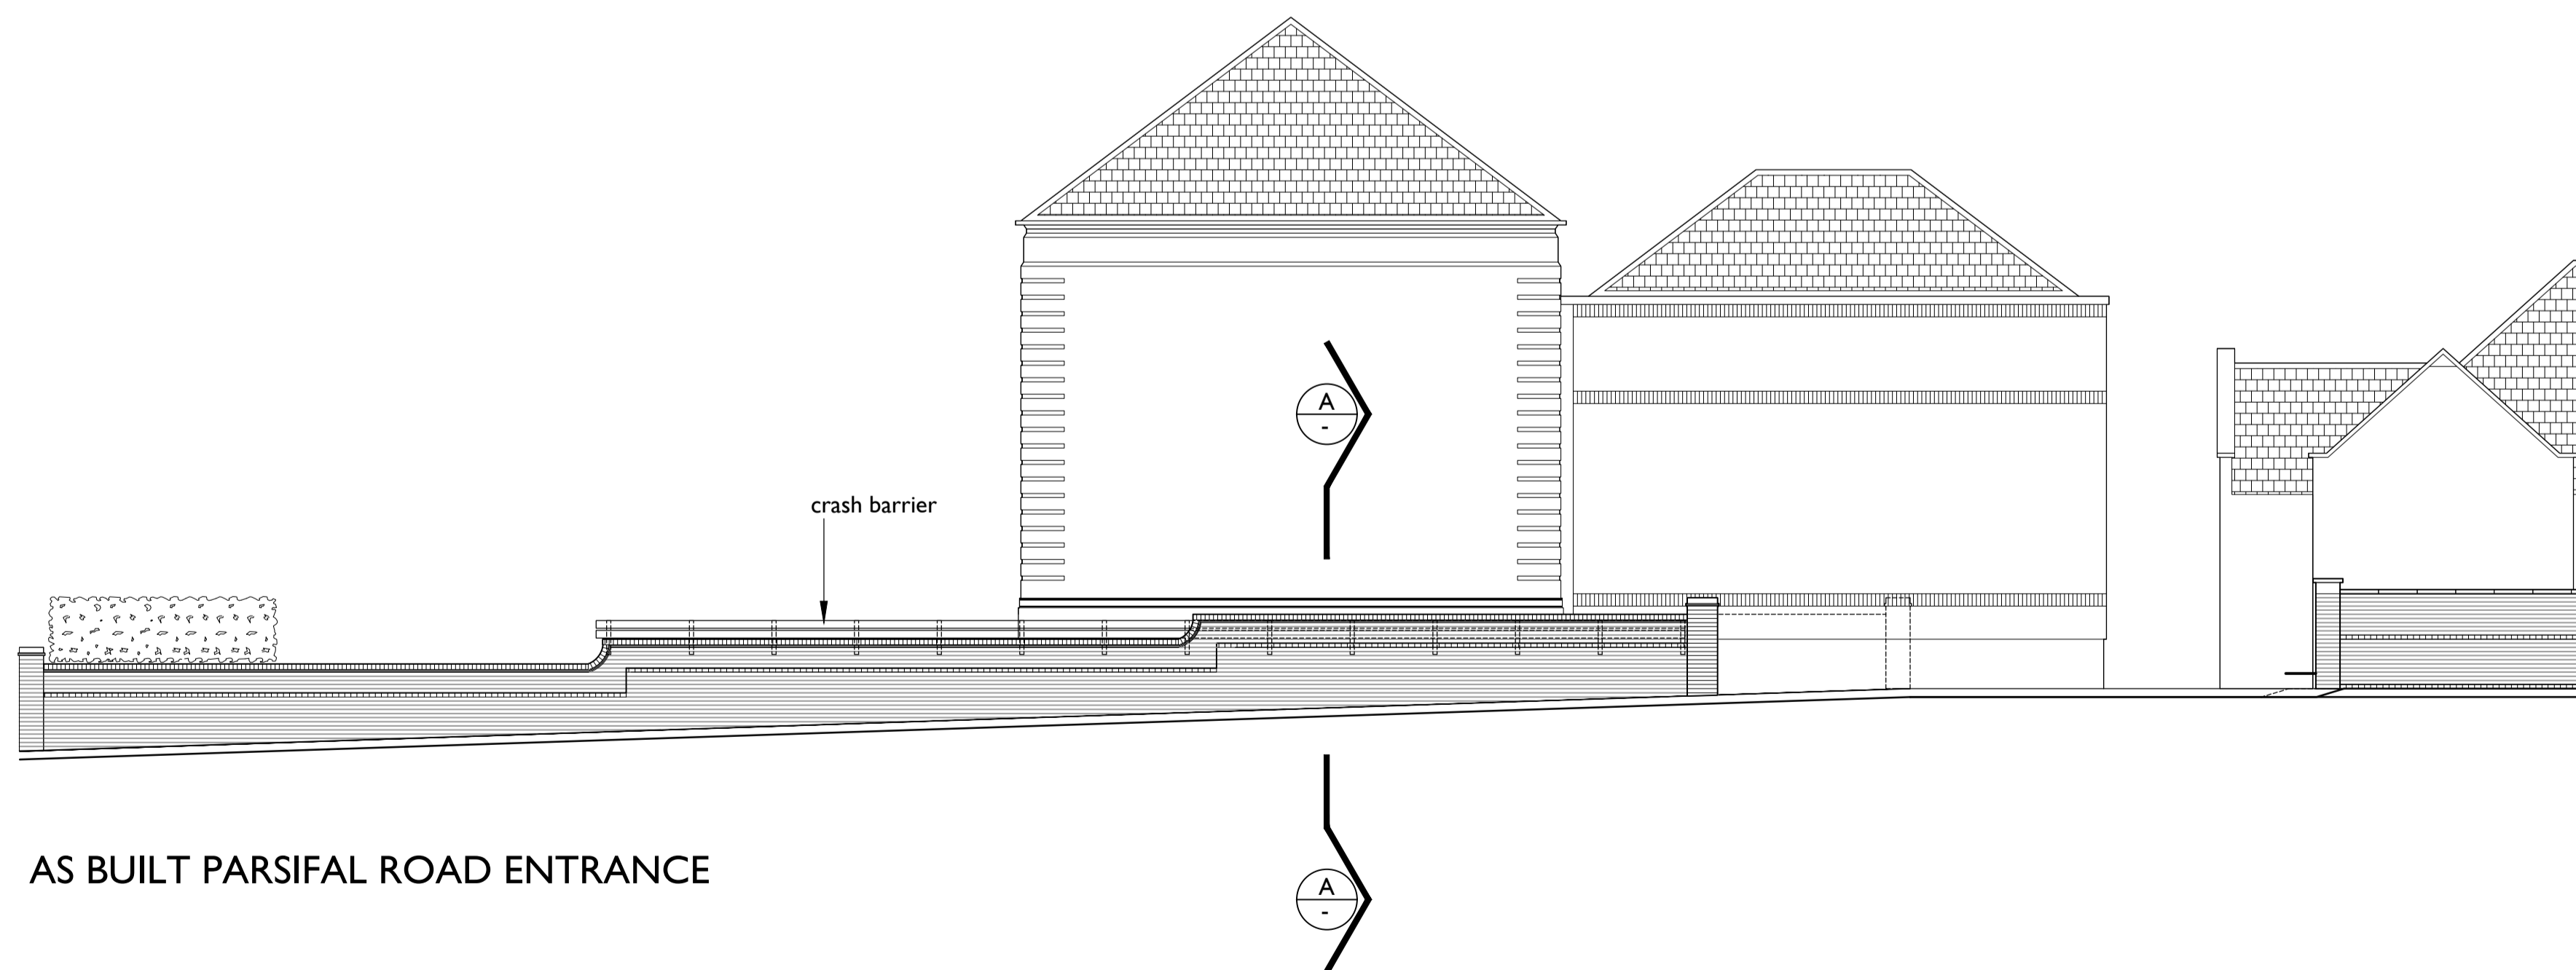

AS BUILT PARSIFAL ROAD ENTRANCE

\* ISSUED FOR PLANNING 09.02.24 TC TM  
 REV. DESCRIPTION DATE DRN CHKD.

**MARKWICK ARCHITECTS**  
 THE OLD DAIRY  
 51a ST. PETERS STREET  
 SOUTH CROYDON SURREY CR2 7DG  
 TELEPHONE 020 8686 2955  
 E-MAIL ma@markwickarchitects.co.uk

CLIENT  
**ESCP Europe Busines School**

PROJECT  
**527 Finchley Road  
 London, NW3 7BG**  
 DRAWING TITLE  
**Pre Existing & As Built  
 Parsifal Road Entrance Elevations**

DATE	SCALE
February 2024	1:100 @ A1
DRAWING NUMBER	DRAWING REVISION
2213 / P / 697	*
DRAWN BY	CHECKED BY
TC	TM