

THIS IS NOT A CONSTRUCTION DRAWING. IT IS UNSUITABLE FOR THE PURPOSE OF CONSTRUCTION AND MUST ON NO ACCOUNT BE USED AS SUCH.

Key

1. Existing Fridge + Cabinet: Partial removal of full height unit and fridge to allow for below counter fridge freezer.

2. Cooker: Existing cooker requires replacement.


3. Individual Unit: Large upper unit to be removed due to poor condition and cumbersome size and location (assumed to be non original). To be replaced with an alternative matching unit.

4. Sink: Existing sink and taps require upgrading. Raised countertop to be replaced here.


5. Existing wall tiles to be removed. Assumed non original.

6. Units: Units are generally tired with some poor workmanship. Refurbishment required throughout.


7. Existing electrical port to be removed and relocated to be flush with the wall.

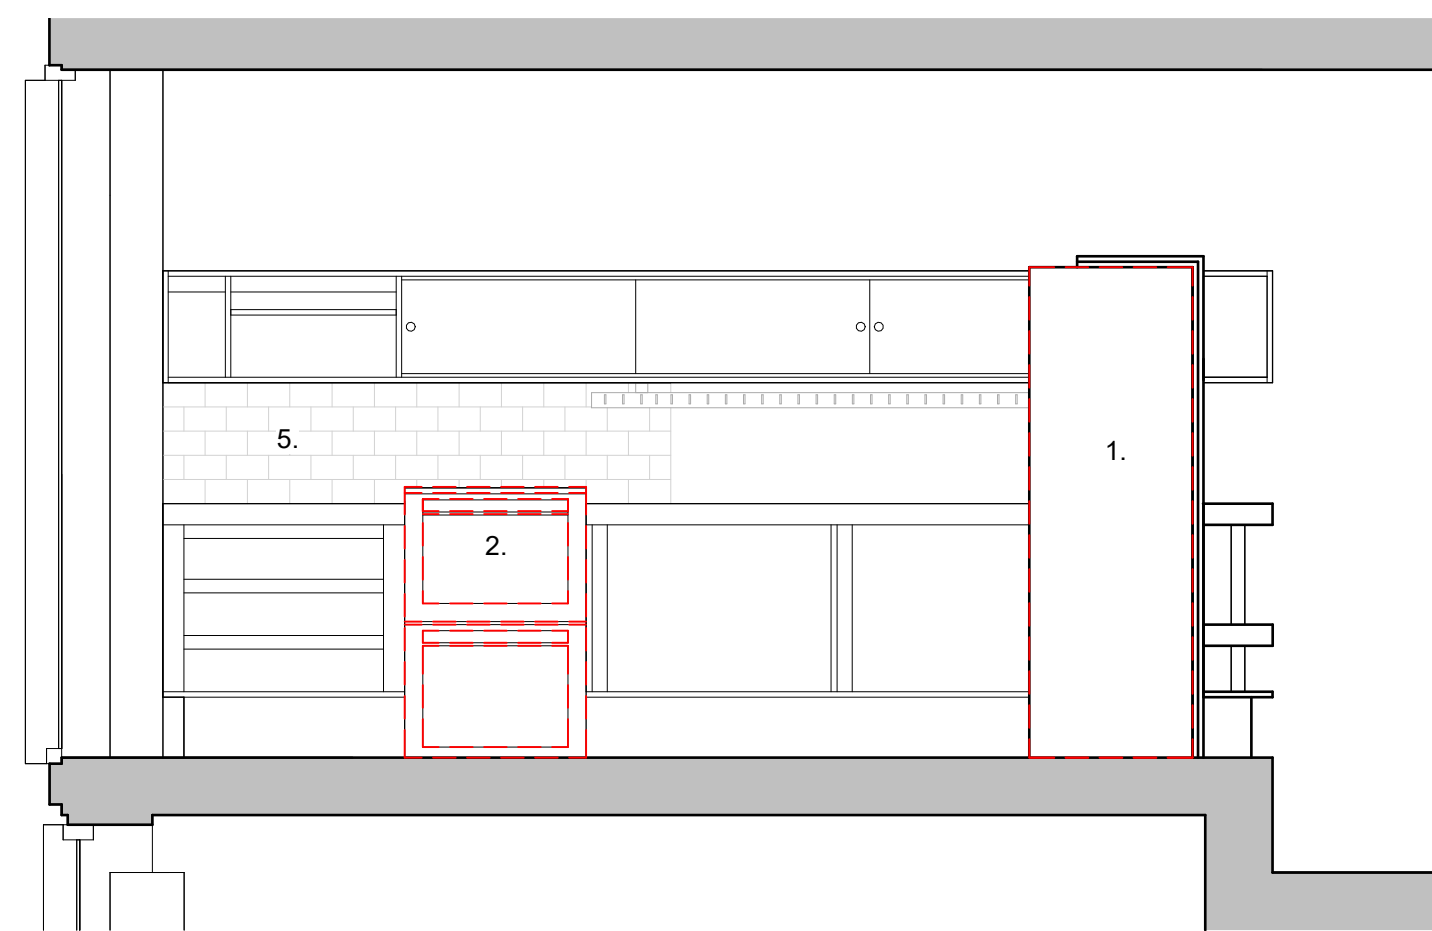


Existing/Demolition Kitchen Elevation 1
1:25

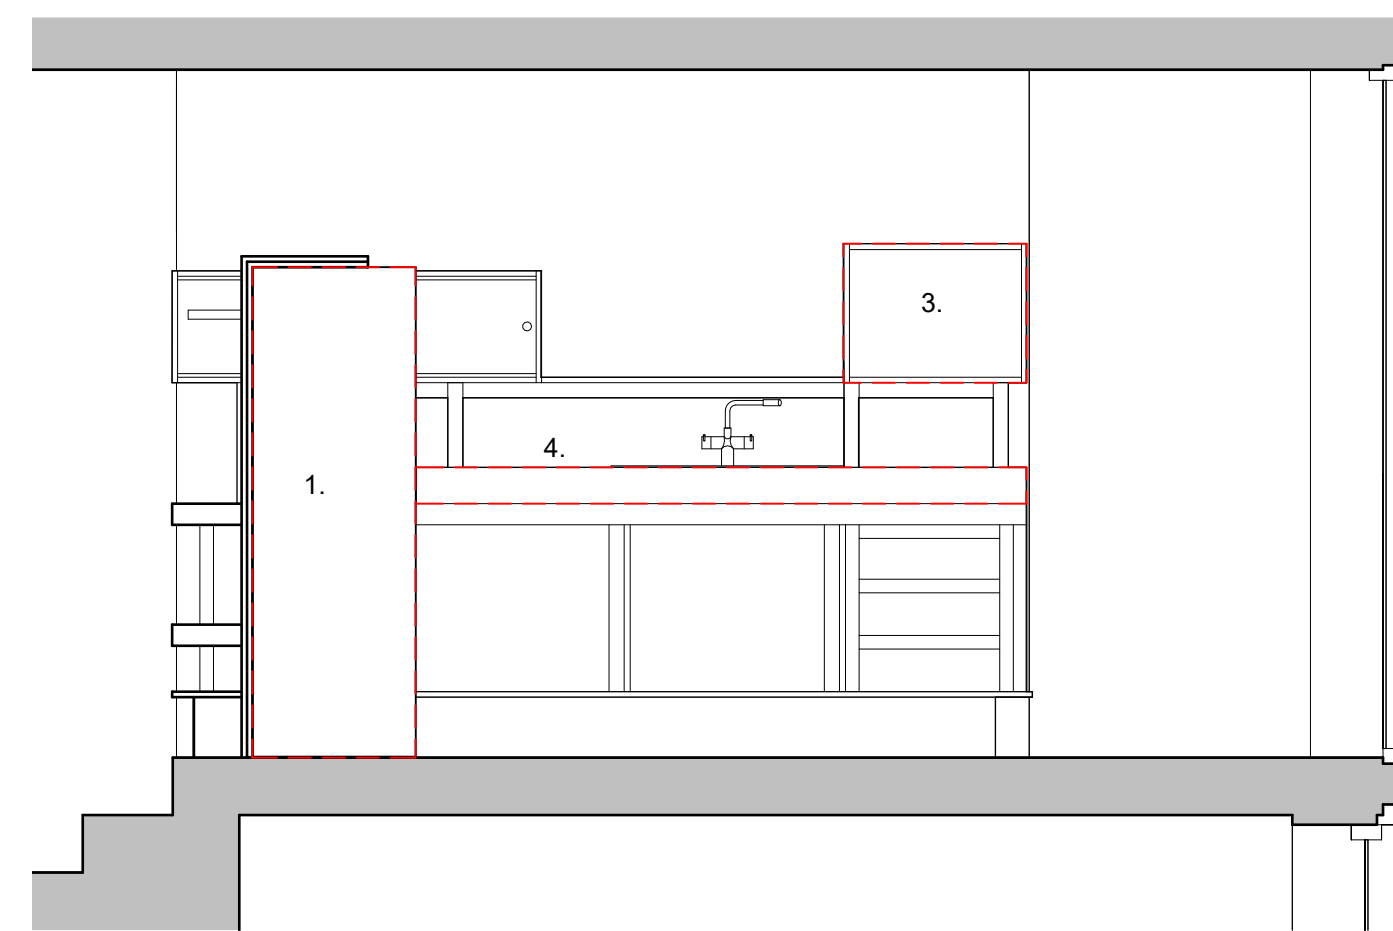


Existing/Demolition Kitchen Elevation 2
1:25

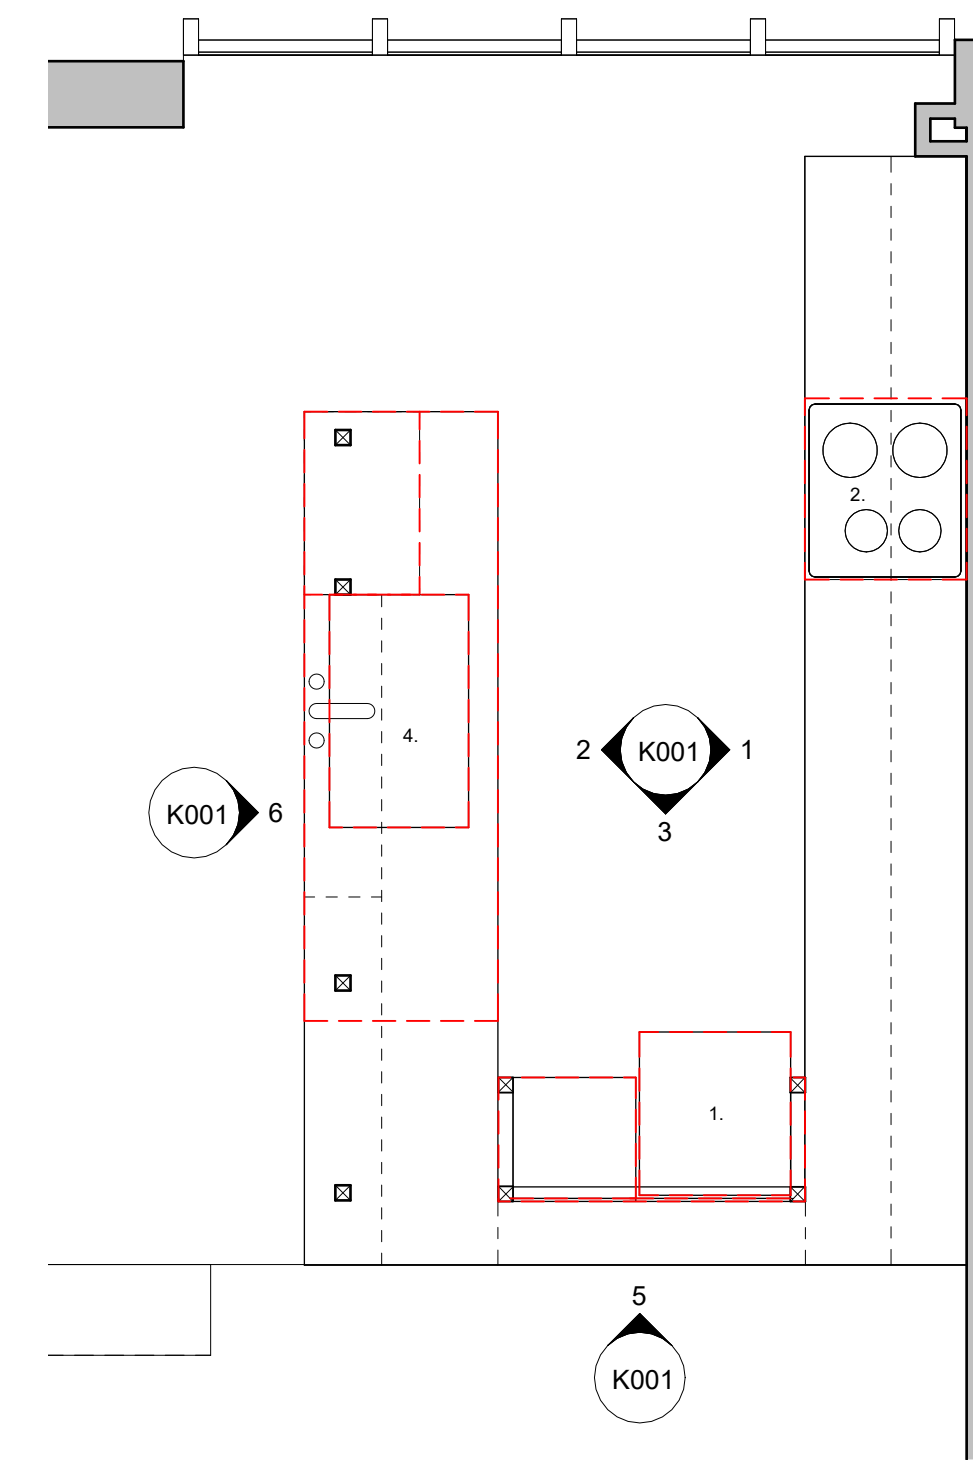


Existing/Demolition Kitchen Plan
1:25

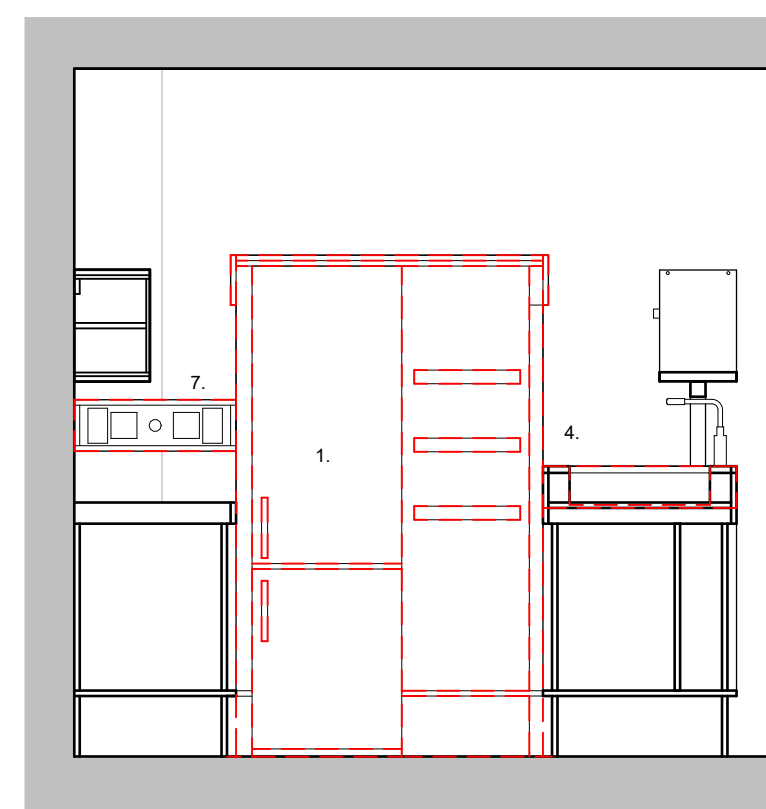

Existing/Demolition Kitchen Elevation 3
1:25

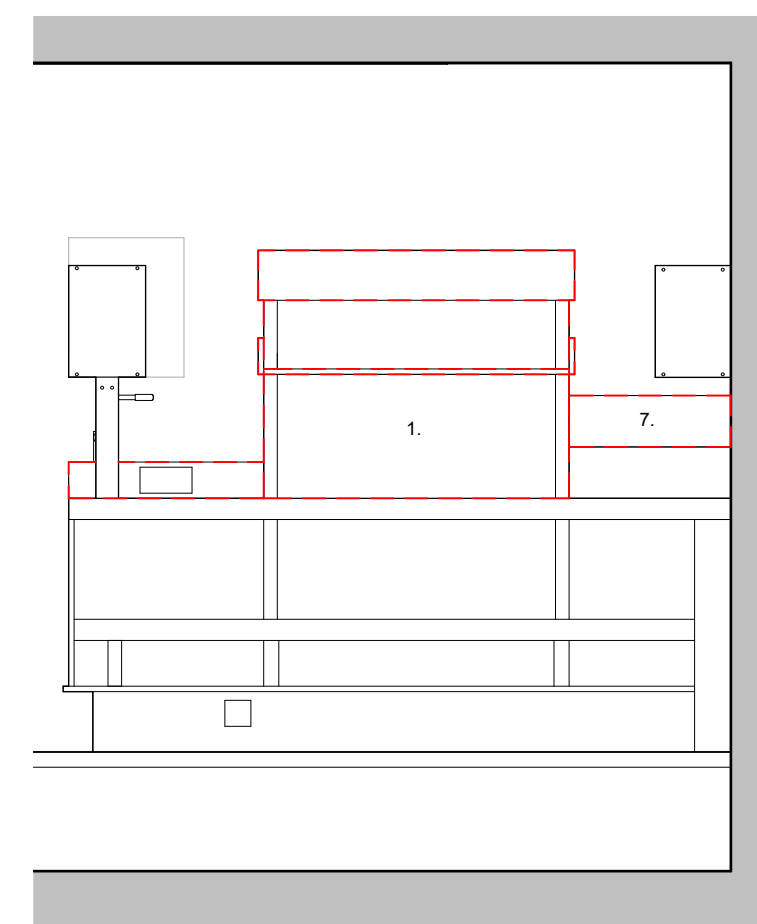

Existing/Demolition Kitchen Elevation 4
1:25

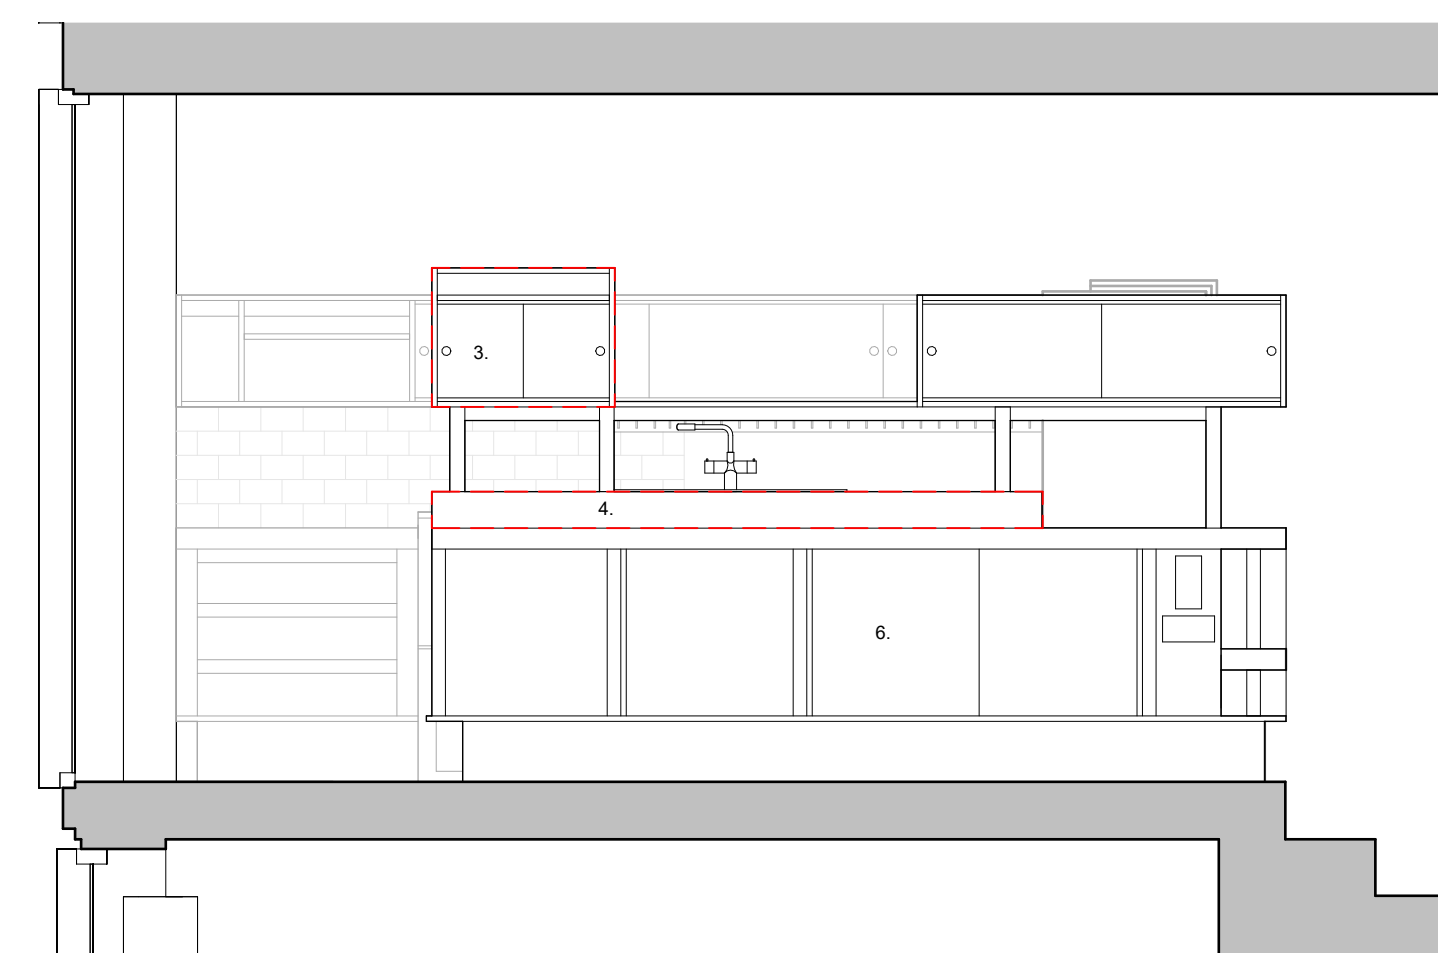

Existing/Demolition Kitchen Elevation 5
1:25

Red line indicates items to be removed.

rev	date	note

CODE	SUITABILITY DESCRIPTION

STATUS	PURPOSE OF ISSUE
	PLANNING

MAP 3rd Floor
99-101 Farrington Road
London, EC1R 3BT
tel: 020 7096 5007
email: studio@map-architecture.co.uk

PROJECT NO:

2306

PROJECT

31 South Hill Park

TITLE
Existing Kitchen Drawings

CLIENT
Mark Sutcliffe

DRAWN BY	CHECKED BY	DATE
FP	MP	21.03.2024

SCALE (@ A1)	PROJECT NUMBER
1:25	2306

DRAWING NUMBER	REV
K001	