



1 LOWER GROUND FLOOR PLAN - AS BUILT (75SQM)
Scale: 1:100

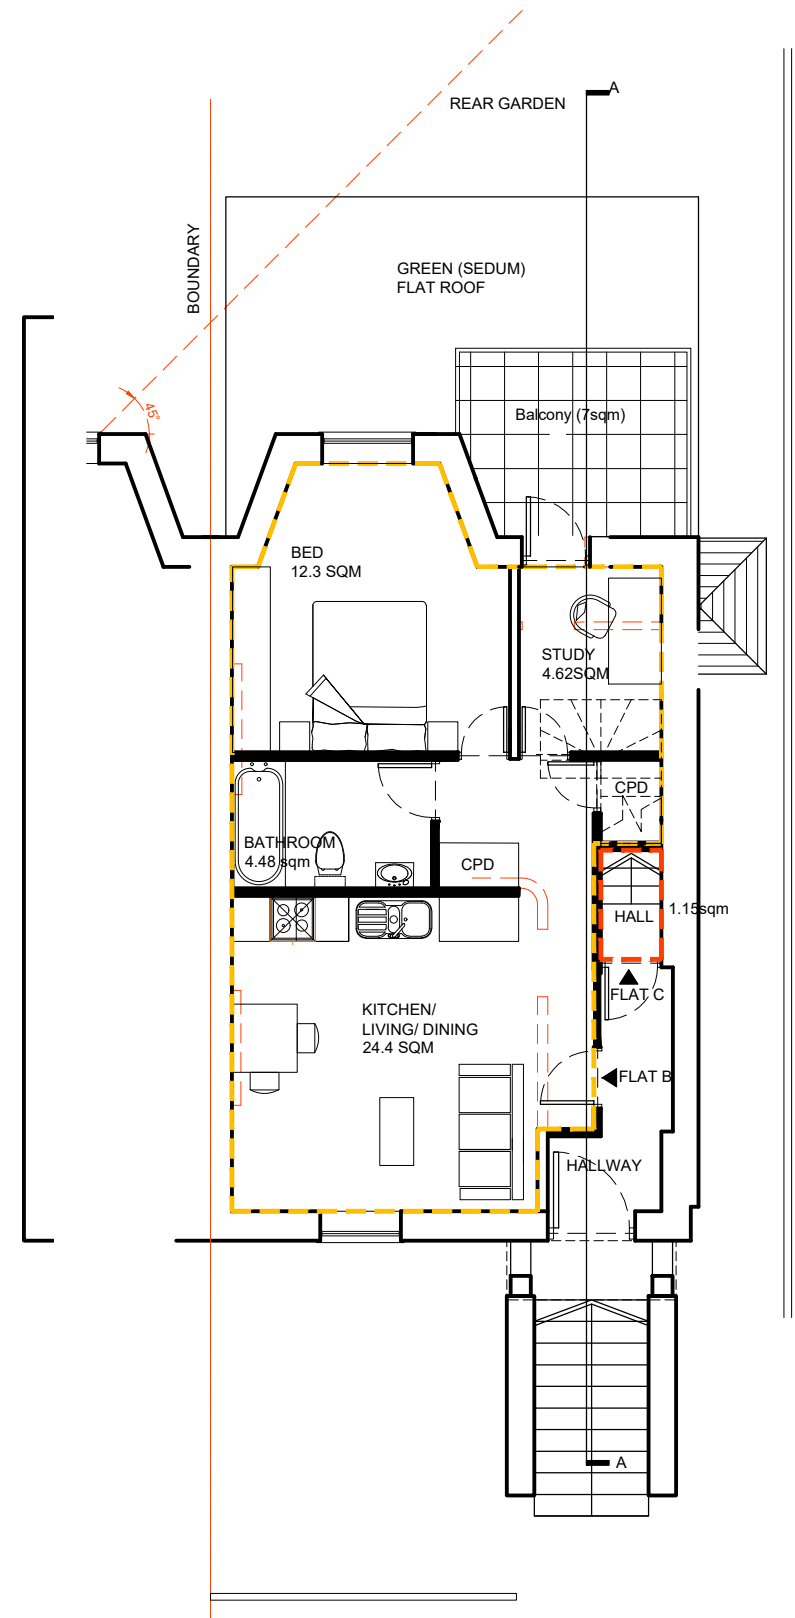


2 GROUND FLOOR PLAN - AS BUILT (46.5 SQM)
Scale: 1:100


2 SEDUM ROOF - AS BUILT (46.5 SQM)
Scale: 1:100

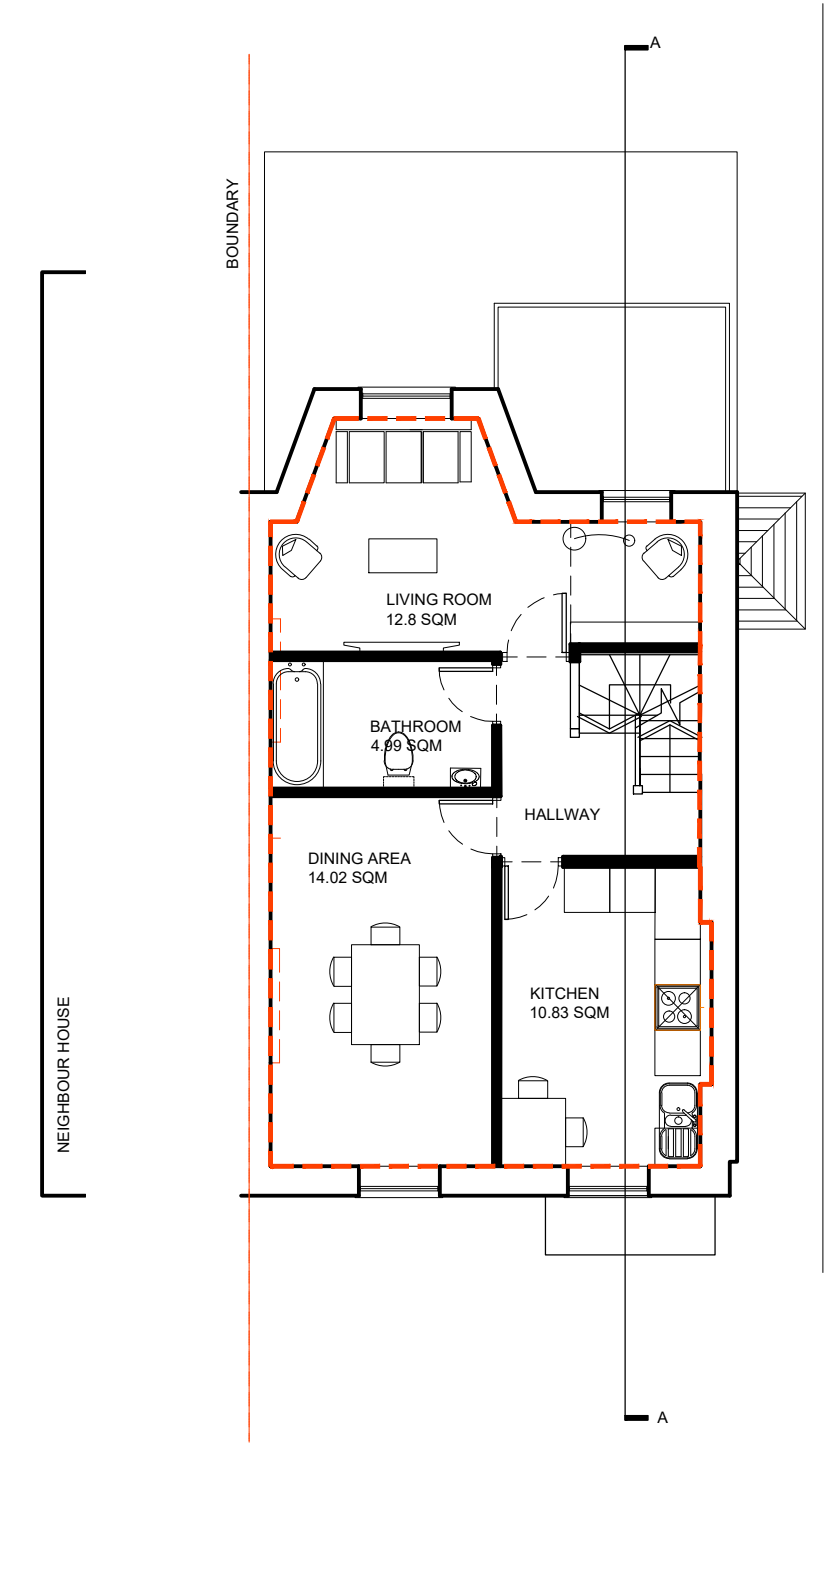

3 FIRST FLOOR PLAN - AS BUILT (52 SQM)
Scale: 1:100

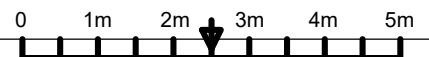

General Notes: 1. Copyright: this drawing cannot be reproduced without the consent of the owner; 2. Do not scale from this drawing. All dimensions are to be checked on site prior to commencement of work. Any discrepancies should be brought to the designers attention.

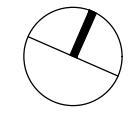

AS BUILT/PROPOSED
(15.04.2024)

YOUR LIVING SPACE ©

FLAT CONVERSION
65 AGAR GROVE, LONDON. NW1 9UE

AS BUILT/PROPOSED ELEVATIONS

Scale: 1:100 @ A3	NOV 2019	Dwg. 19_100_A1
-------------------	----------	----------------