





General Notes: 1. Copyright: this drawing cannot be reproduced without the consent of the owner; 2. Do not scale from this drawing. All dimensions are to be checked on site prior to commencement of work. Any discrepancies should be brought to the designers attention.

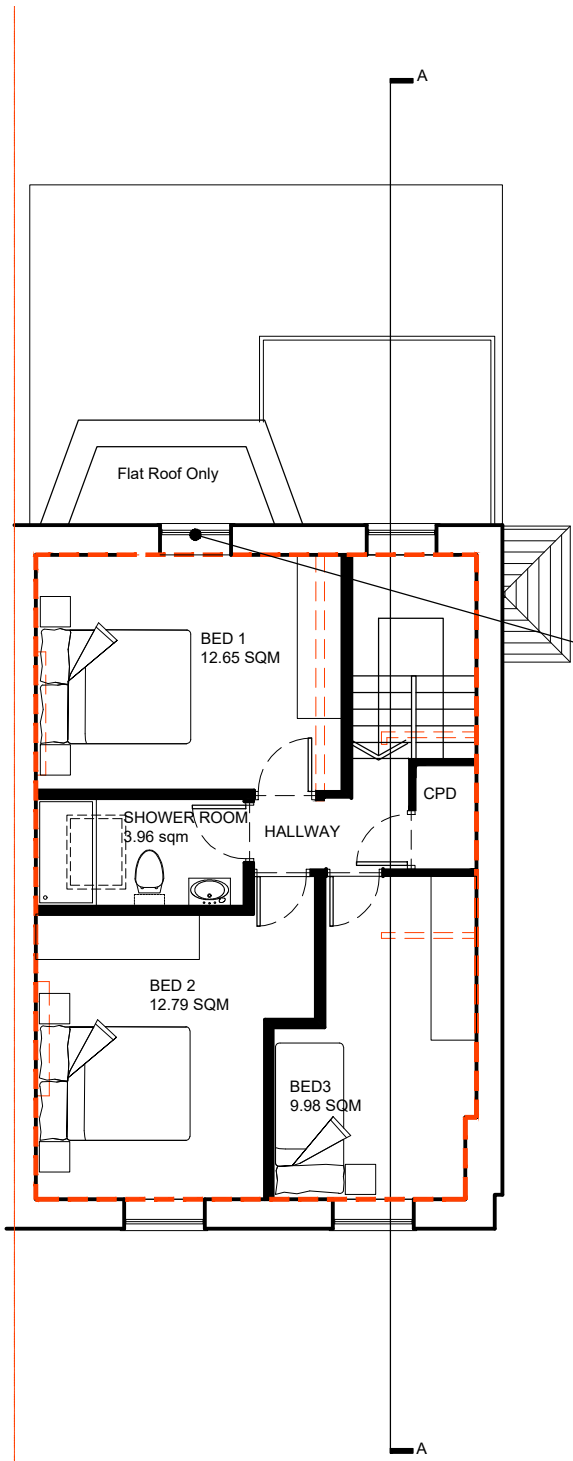


1 SECOND FLOOR PLAN - AS BUILT (49.5 SQM)
Scale: 1:100

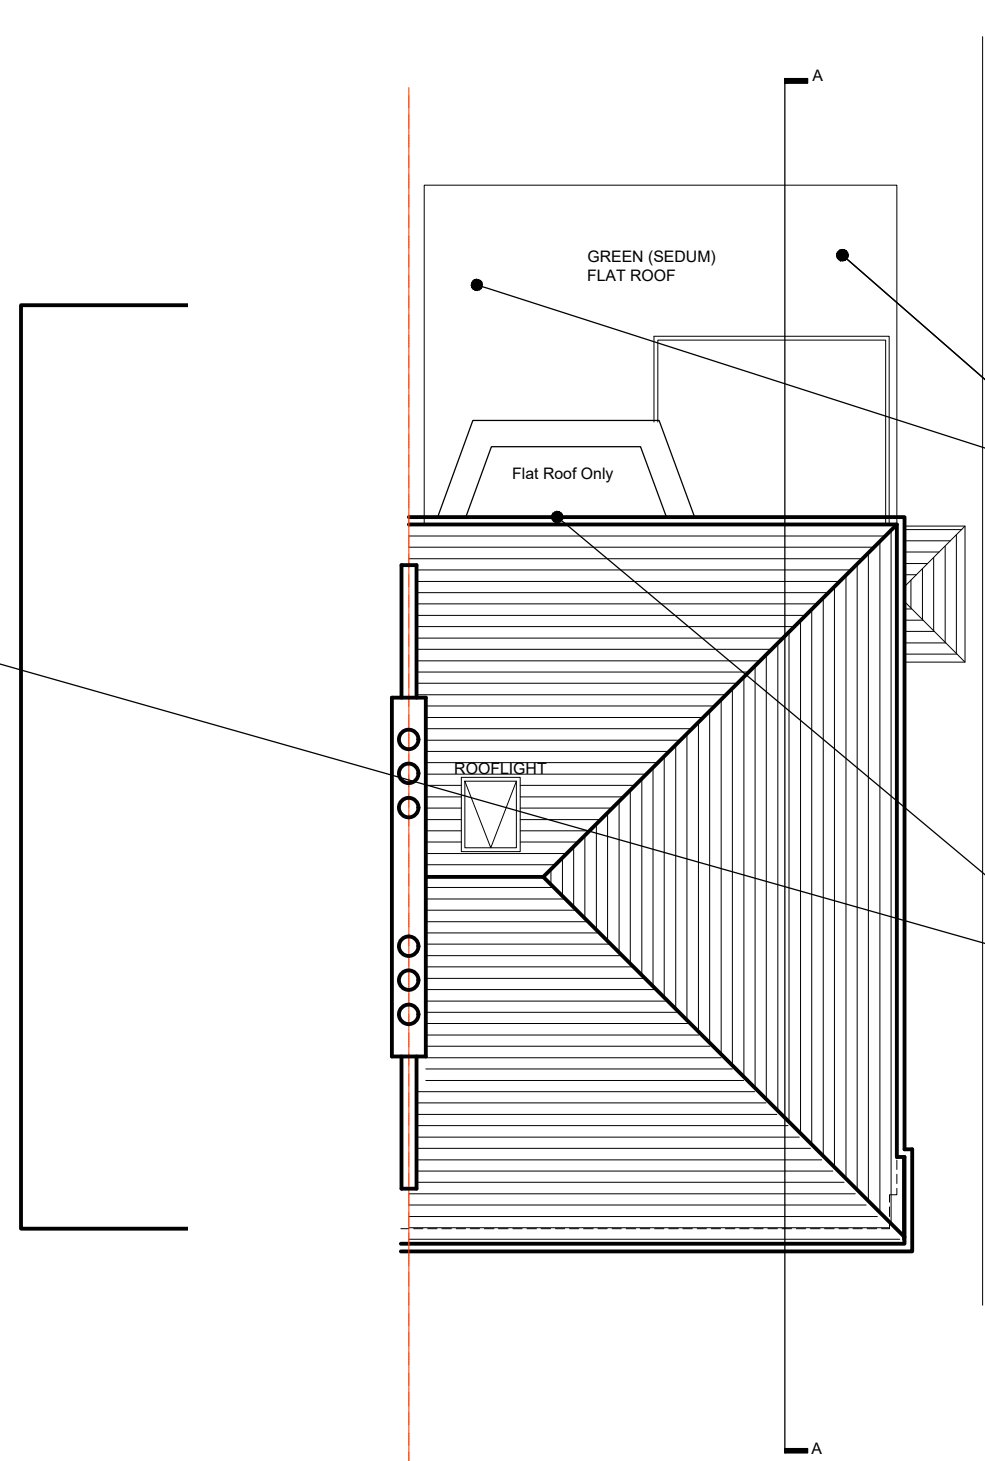

2 ROOF PLAN - AS BUILT
Scale: 1:100

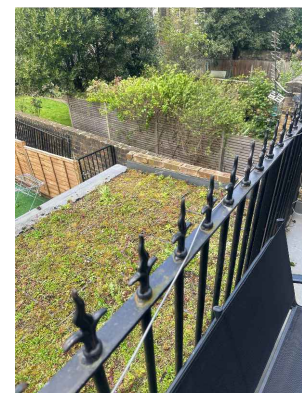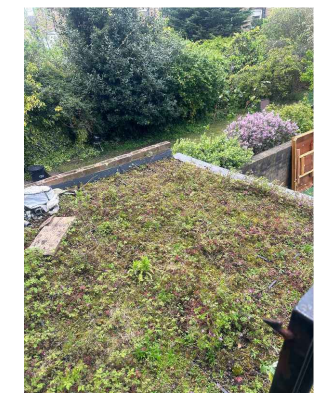

3 SEDUM ROOF & EXTERNAL RAILING REMOVED - AS BUILT
Scale: NTS

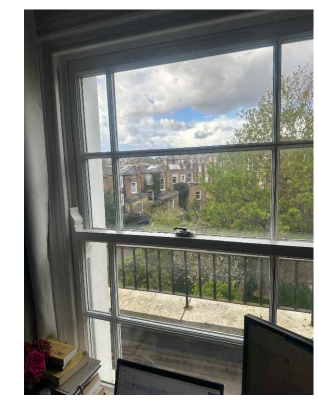



4 EVIDENCE OF NO BALCONY AT 2nd FLOOR BED 1 - AS BUILT
Scale: NTS

Existing UPVC panel to be replaced with facing brick & soldier course above



Existing UPVC Door to be replaced with a traditional timber door with brick surround and soldier course above

5 EVIDENCE OF NO RAILING AT GROUND FLOOR REAR EXTENSION - AS BUILT
Scale: NTS

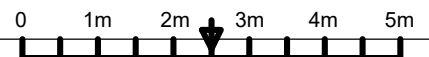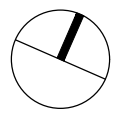

AS BUILT/PROPOSED
(15.04.2024)

YOUR LIVING SPACE ©

FLAT CONVERSION
65 AGAR GROVE, LONDON. NW1 9UE

AS BUILT/PROPOSED PLANS

Scale: 1:100 @ A3	APR 2024	Dwg. 19_100_A2
-------------------	----------	----------------