




General Notes: 1. Copyright: this drawing cannot be reproduced without the consent of the owner; 2. Do not scale from this drawing. All dimensions are to be checked on site prior to commencement of work. Any discrepancies should be brought to the designers attention.

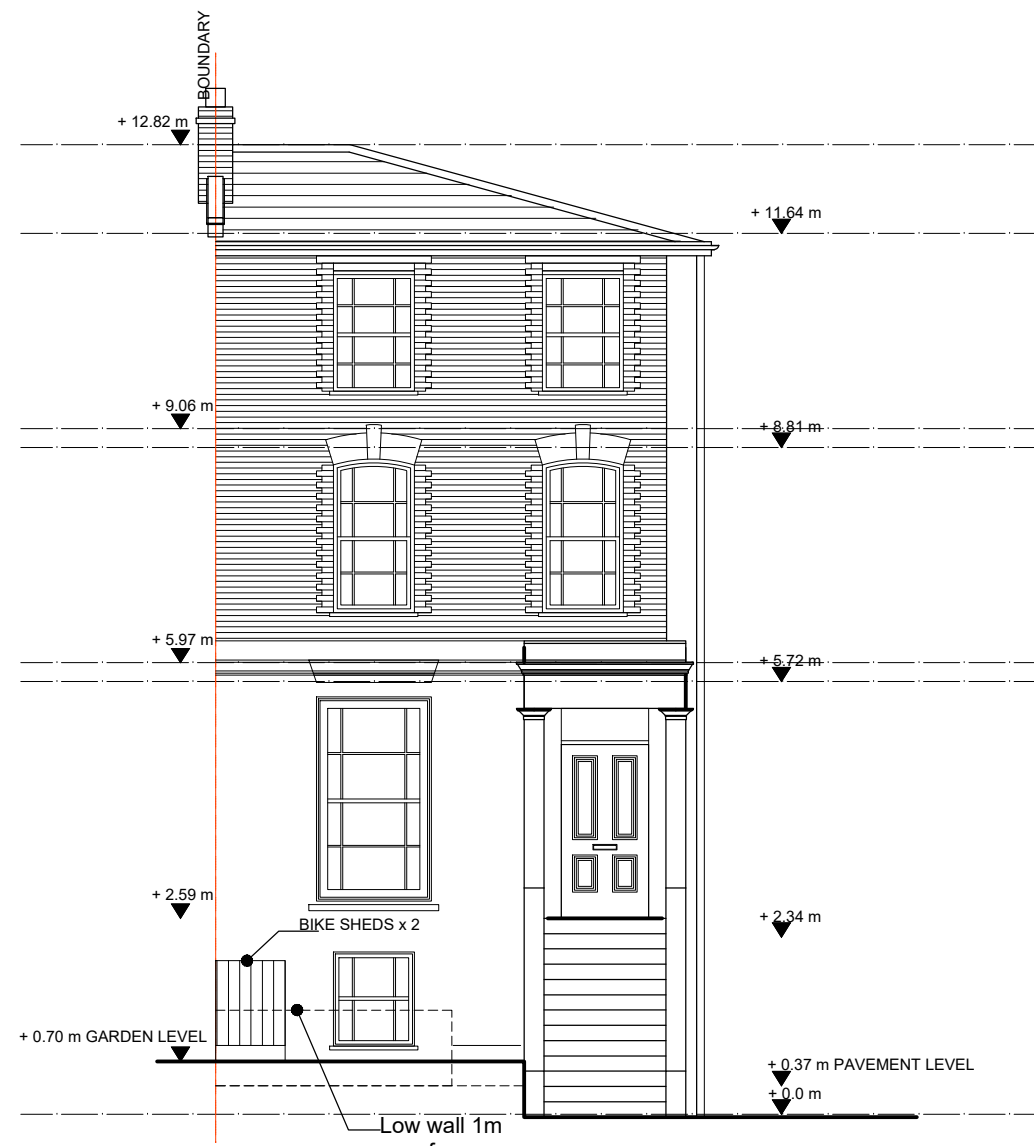

1 FRONT ELEVATION - AS BUILT
Scale: 1:100

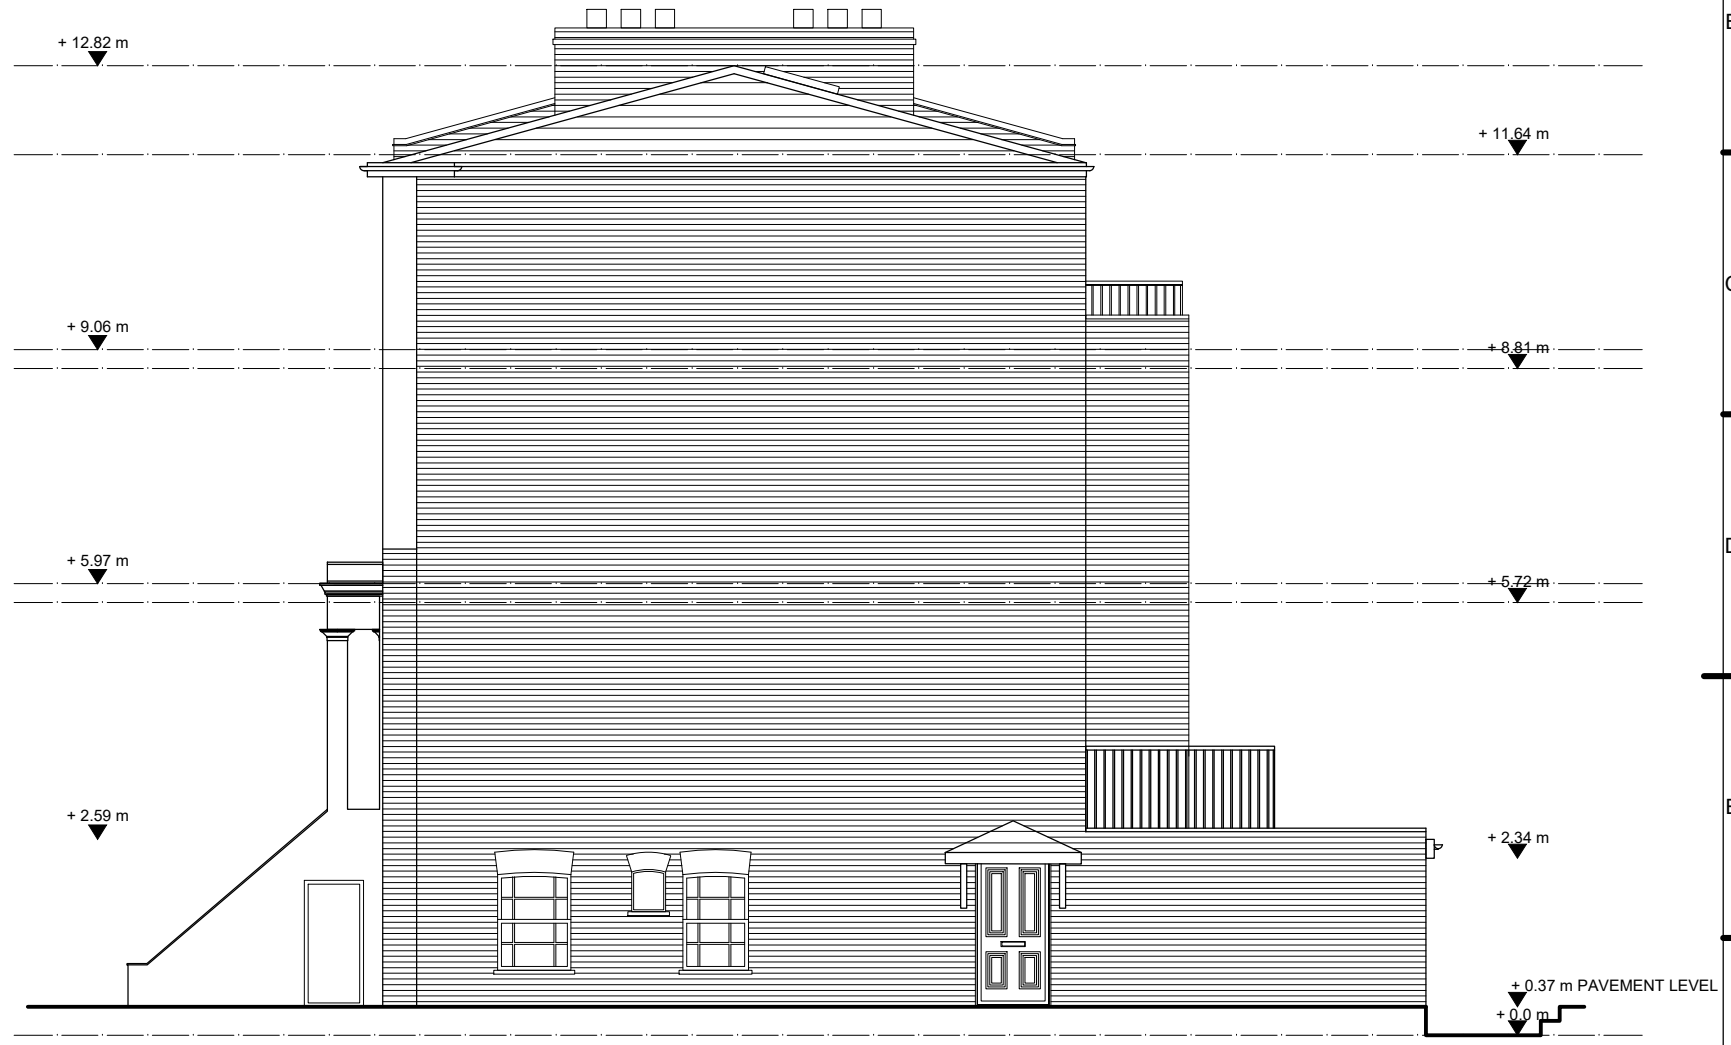

2 SIDE ELEVATION - AS BUILT
Scale: 1:100

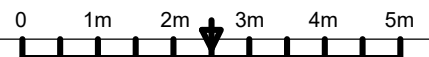

AS BUILT/PROPOSED
(15.04.2024)

YOUR LIVING SPACE ©

FLAT CONVERSION 65 AGAR GROVE, LONDON. NW1 9UE		
AS BUILT/PROPOSED ELEVATIONS		
Scale: 1:100 @ A3	APR 2024	Dwg. 19_100_A3