



**X** EXISTING  
Site Plan 1:200@A3

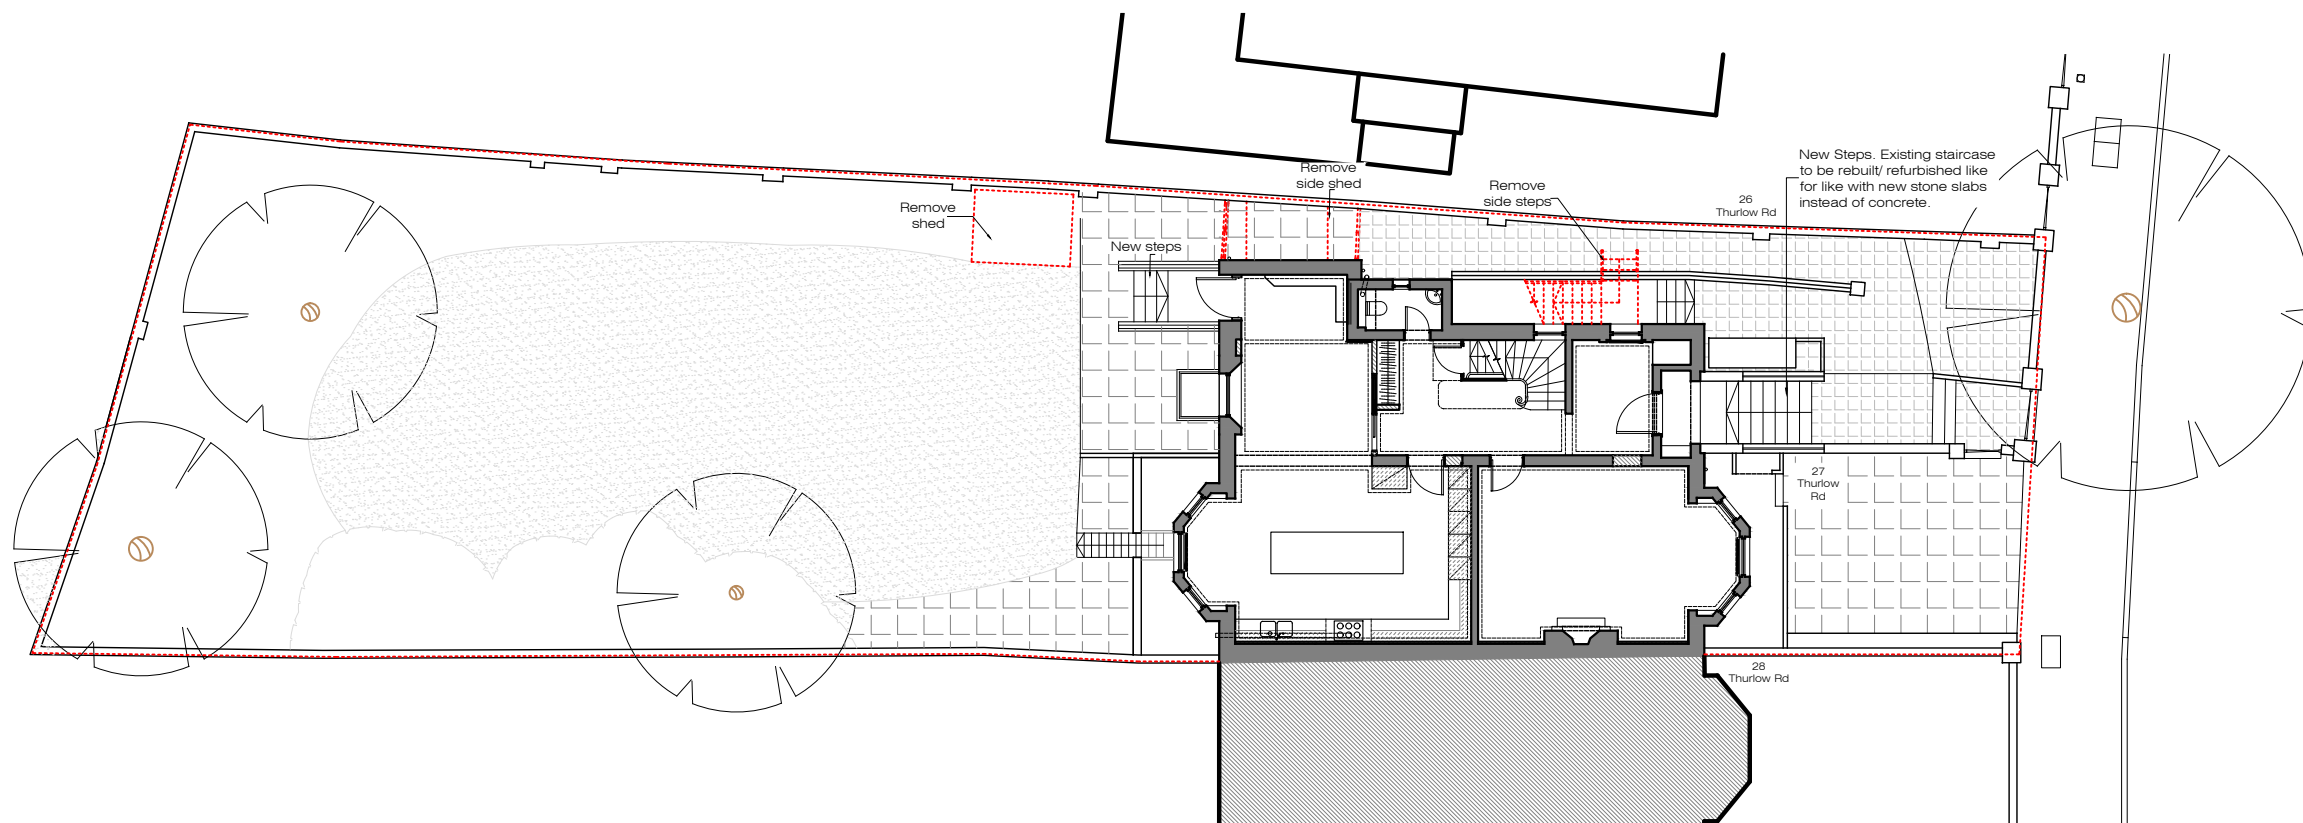

**X** PROPOSED  
Site Plan 1:200@A3

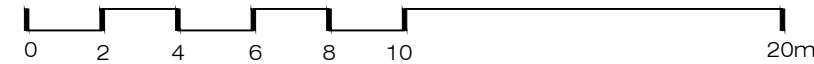

Ground Floor Office  
33 Belsize Lane  
London NW3 5AS  
Office: +44 (0) 207 431 9014  
info@xularchitecture.co.uk  
www.xularchitecture.co.uk

PLEASE NOTE:

1. All dimensions to be checked on site before fabrication.
2. Contractor to refer to engineers drawings before proceeding with works.
3. All drawings and designs are covered by design right (intellectual property), and may not be distributed, copied or issued without written permission by the Architect.
4. All design concepts are the sole property of the Architect and no adaptations, reproductions or copies may be made without written permission of the Architect.
5. These drawings are subject to any variation required or recommendation by any statutory authority, or for the better carrying out of the works.
6. Samples to be provided by contractor for XUL Architecture's approval.
7. All finishes to XUL Architecture's satisfaction.
8. All drawings to be approved by XUL Architecture prior to construction.

ADDITIONAL NOTE:

Issue key:

Information (I)  
Planning (P)  
Tender (T)  
Construction (C)  
As Built (B)

Project Address

27 Thurlow Road, NW3 5PP

Issue For:

Planning

Scale 1:200@A3 Existing and Proposed

Rev. Date 10.04.24 Site Plan

Drawn SL Dwg. No. PSP-00 Rev. P-00


Checked IW Project Number 23152




- NOTES :**
1. All exterior doors to be replaced with new doors
  2. All existing single glazed windows to be replaced with like-for-like double glazed conservation area style windows.
  3. All existing windows secondary glazing to be removed. All existing window security bars at basement and ground floor level to be removed. Basement floor front and side elevation window security bars only to be replaced with new security bars.




- |  |  |   |
|--|--|---|
| 1. All dimensions to be checked on site before fabrication and construction.   | 4. All design concepts are the sole property of the Architect and no adaptations, reproductions or copies may be made without written permission of the Architect. | 6. Samples to be provided by contractor for XUL Architecture's approval.  |
| 2. Contractor to refer to engineers drawings before proceeding with works.   | 5. These drawings are subject to any variation required or recommendation by any statutory authority, or for the better carrying out of the works.                 | 7. All finishes to XUL Architecture's satisfaction.                       |
| 3. All drawings and designs are covered by design right (intellectual property), and may not be distributed, copied or issued without written permission by the Architect. |  | 8. All drawings to be approved by XUL Architecture prior to construction. |

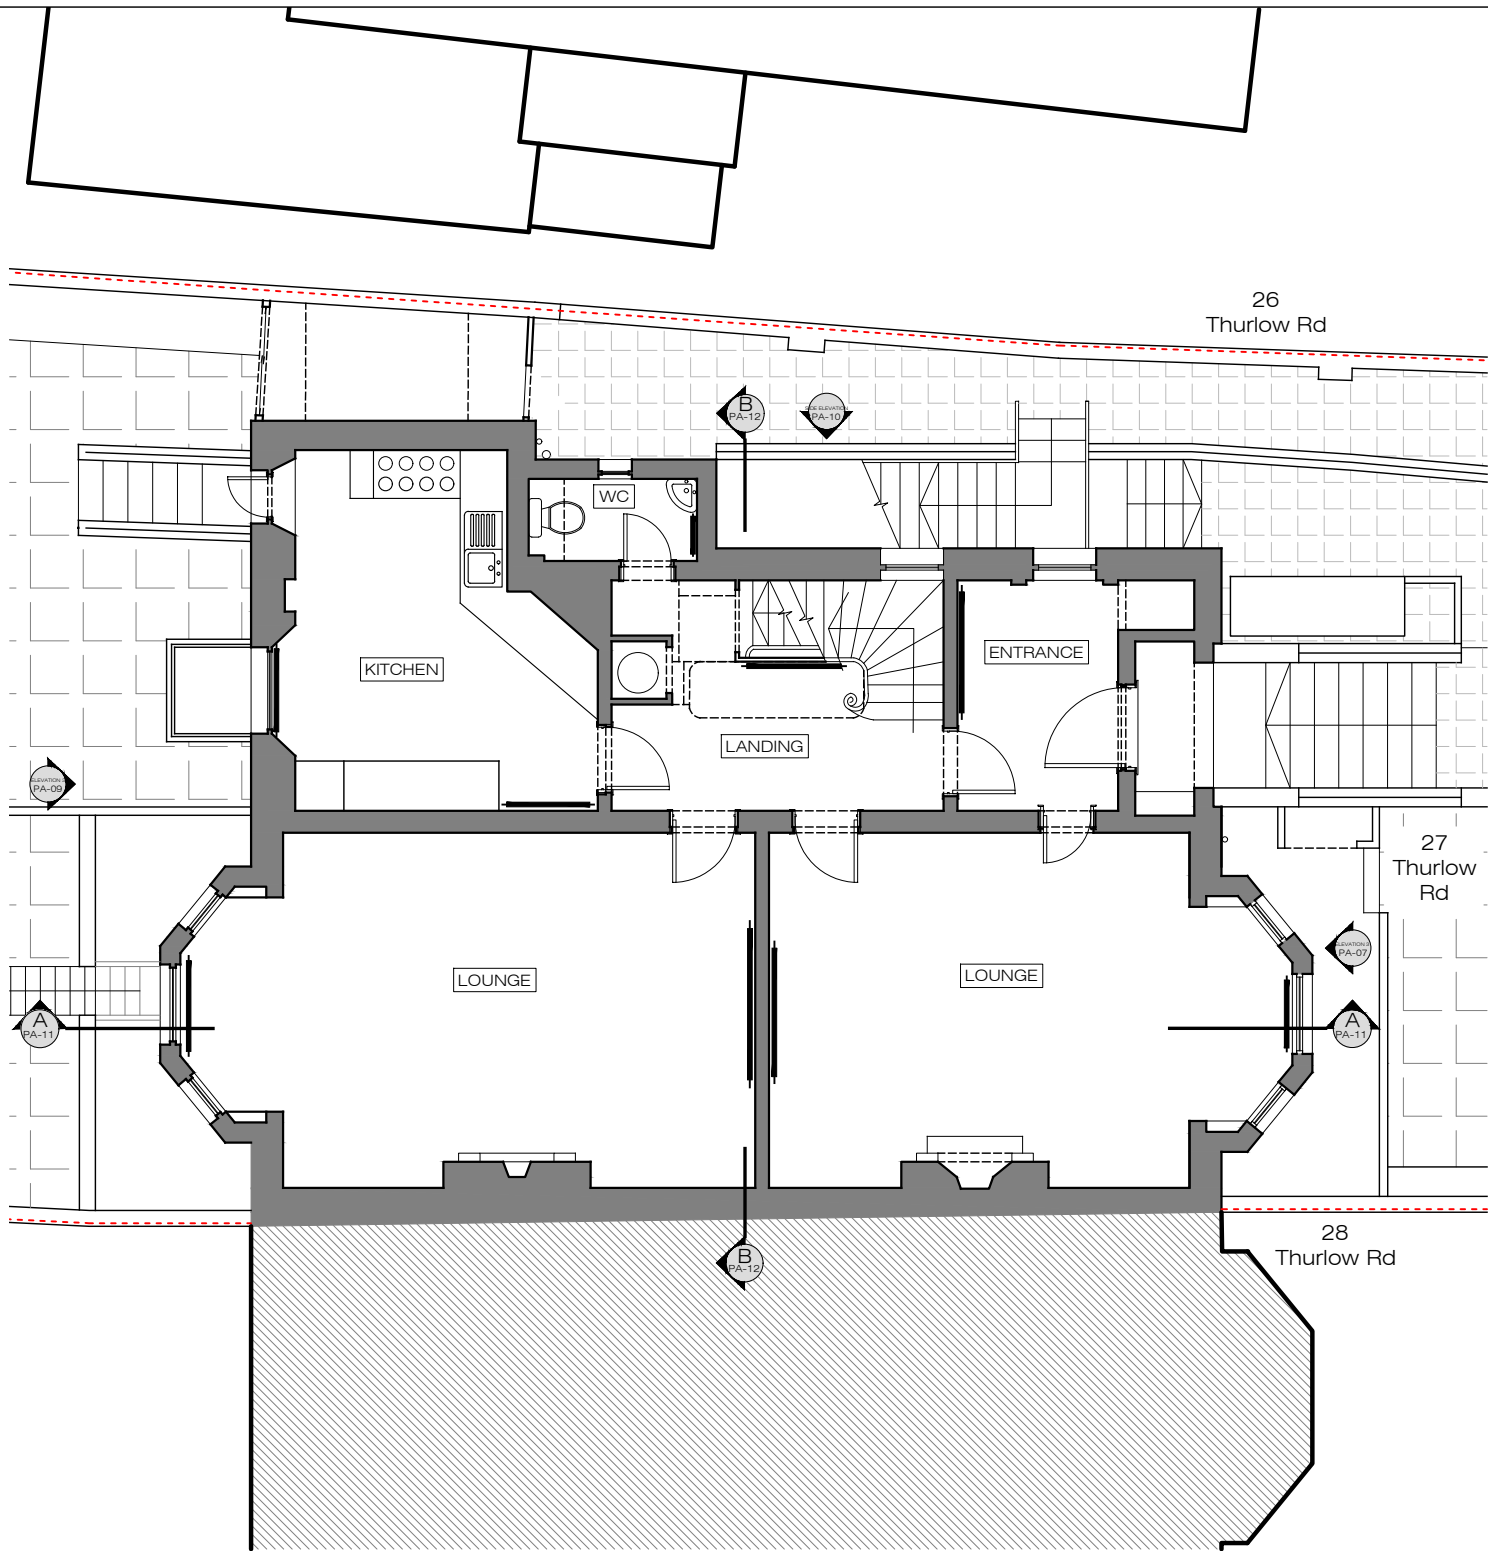

**X** EXISTING  
Ground Floor Plan 1:100@A3

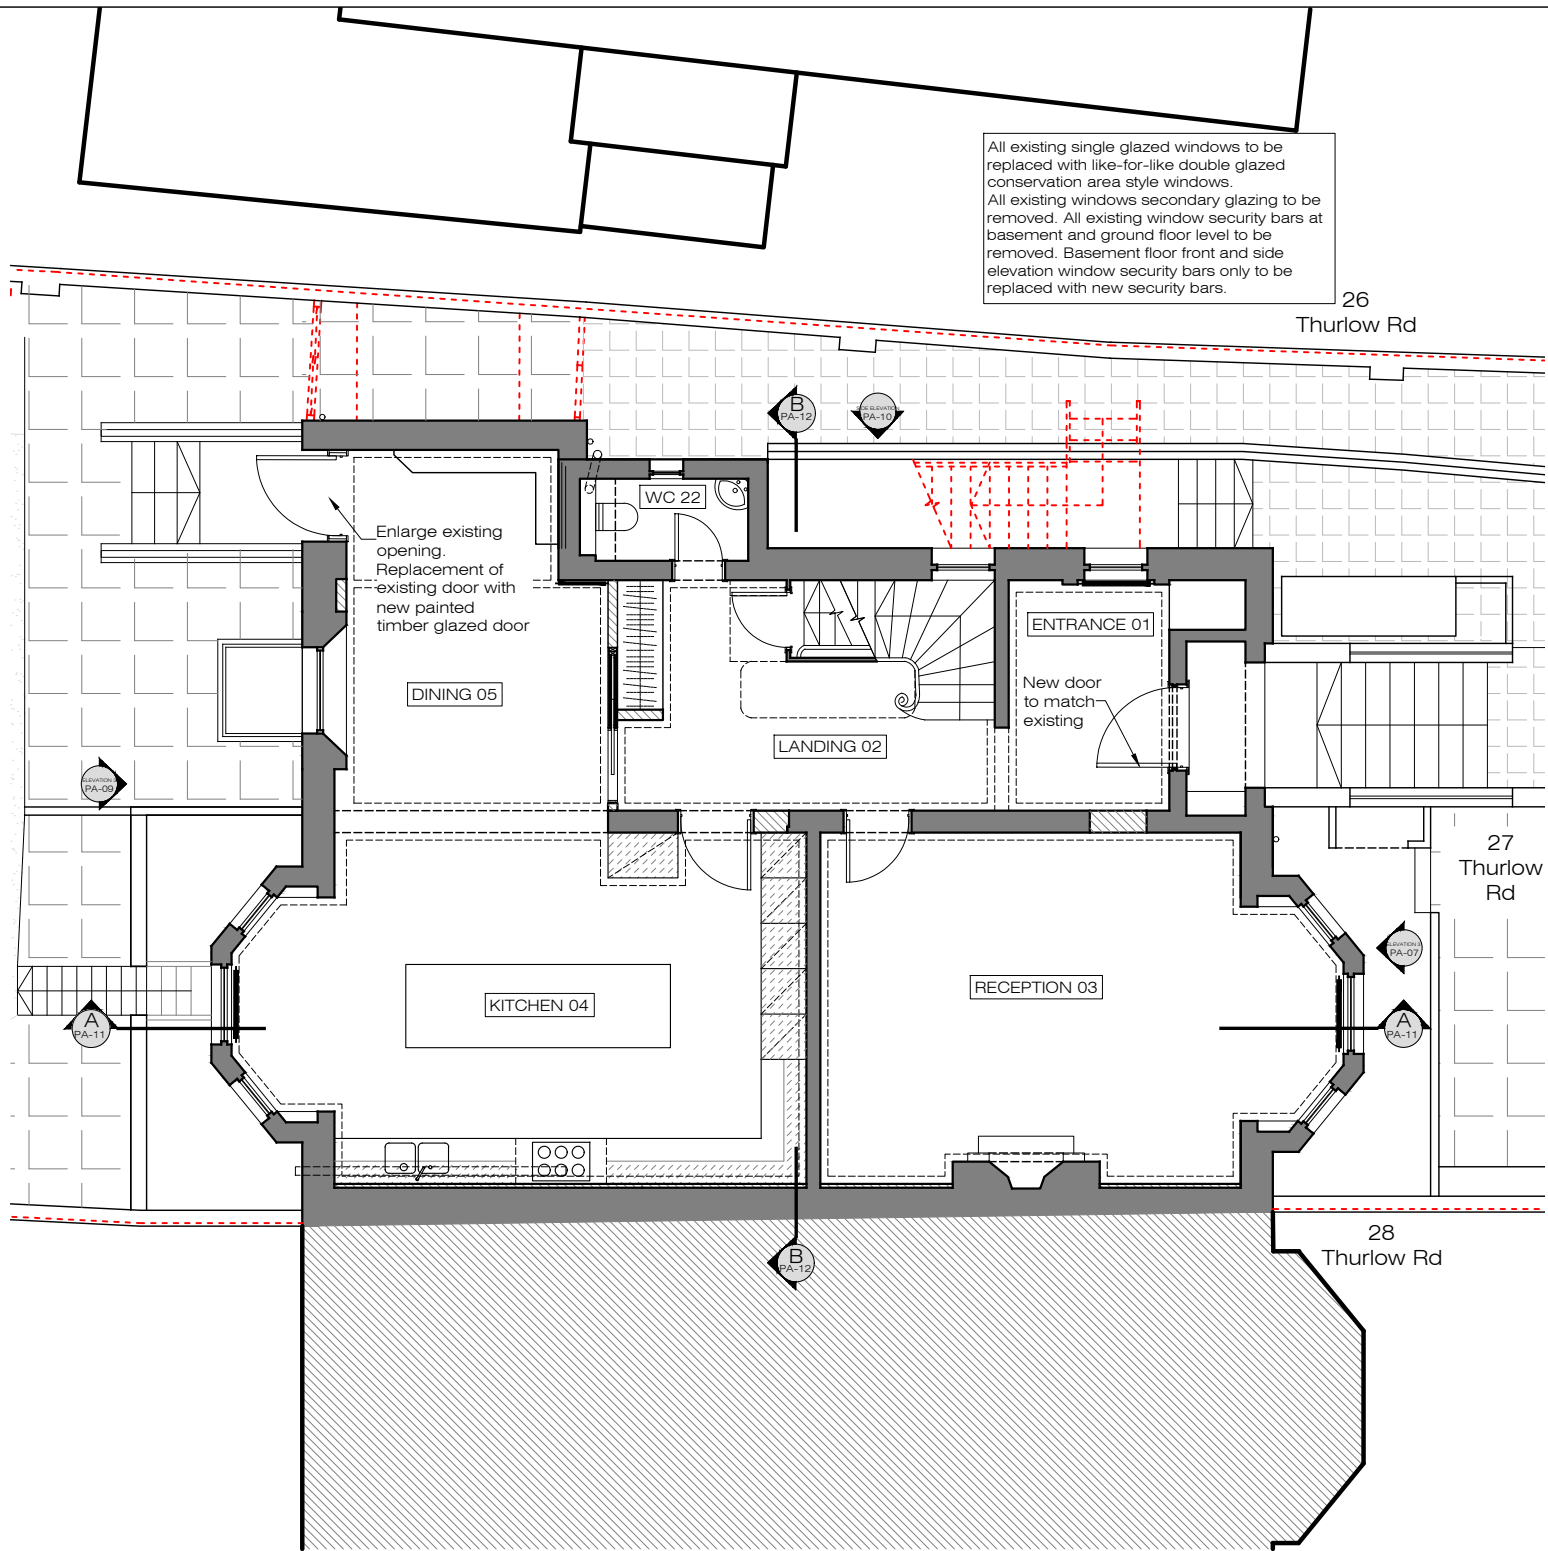

**X** PROPOSED  
Ground Floor Plan 1:100@A3

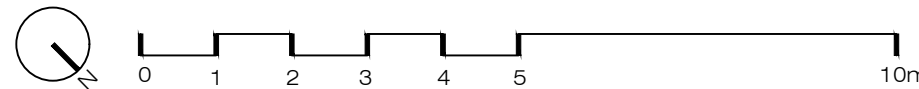

Ground Floor Office  
33 Belsize Lane  
London NW3 5AS  
Office: +44 (0) 207 431 9014  
info@xularchitecture.co.uk  
www.xularchitecture.co.uk

PLEASE NOTE:

1. All dimensions to be checked on site before fabrication,
2. Contractor to refer to engineers drawings before proceeding with works.
3. All drawings and designs are covered by design right (intellectual property), and may not be distributed, copied or issued without written permission by the Architect.
4. All design concepts are the sole property of the Architect and no adaptations, reproductions or copies may be made without written permission of the Architect.
5. These drawings are subject to any variation required or recommendation by any statutory authority, or for the better carrying out of the works.
6. Samples to be provided by contractor for XUL Architecture's approval.
7. All finishes to XUL Architecture's satisfaction.
8. All drawings to be approved by XUL Architecture prior to construction.

ADDITIONAL NOTE:

Issue key:

Information (I)  
Planning (P)  
Tender (T)  
Construction (C)  
As Built (B)


Project Address

27 Thurlow Road, NW3 5PP  
Scale 1:50@A3  
Rev. Date 10.04.24  
Drawn SL  
Checked IW


Existing and Proposed  
Ground Floor Plan  
Dwg. No. PA-02  
Project Number 23152

Issue For:


Planning  
Rev. P-01

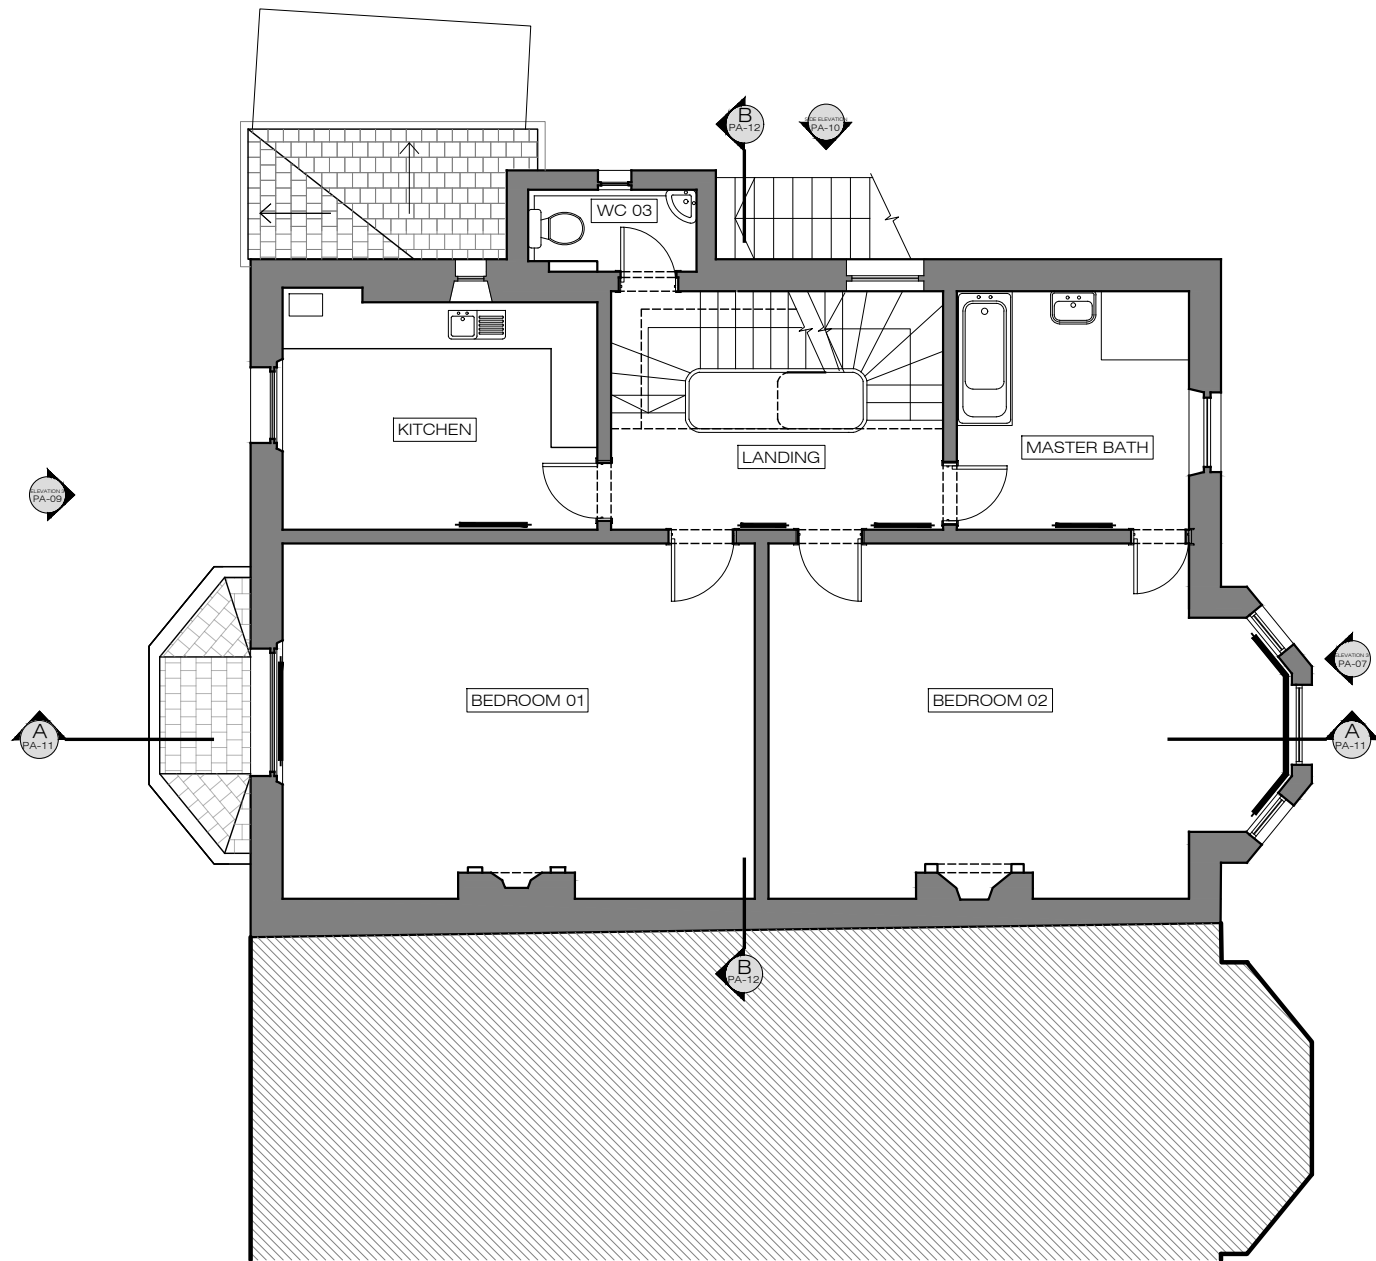

**X** EXISTING  
First Floor Plan 1:100@A3

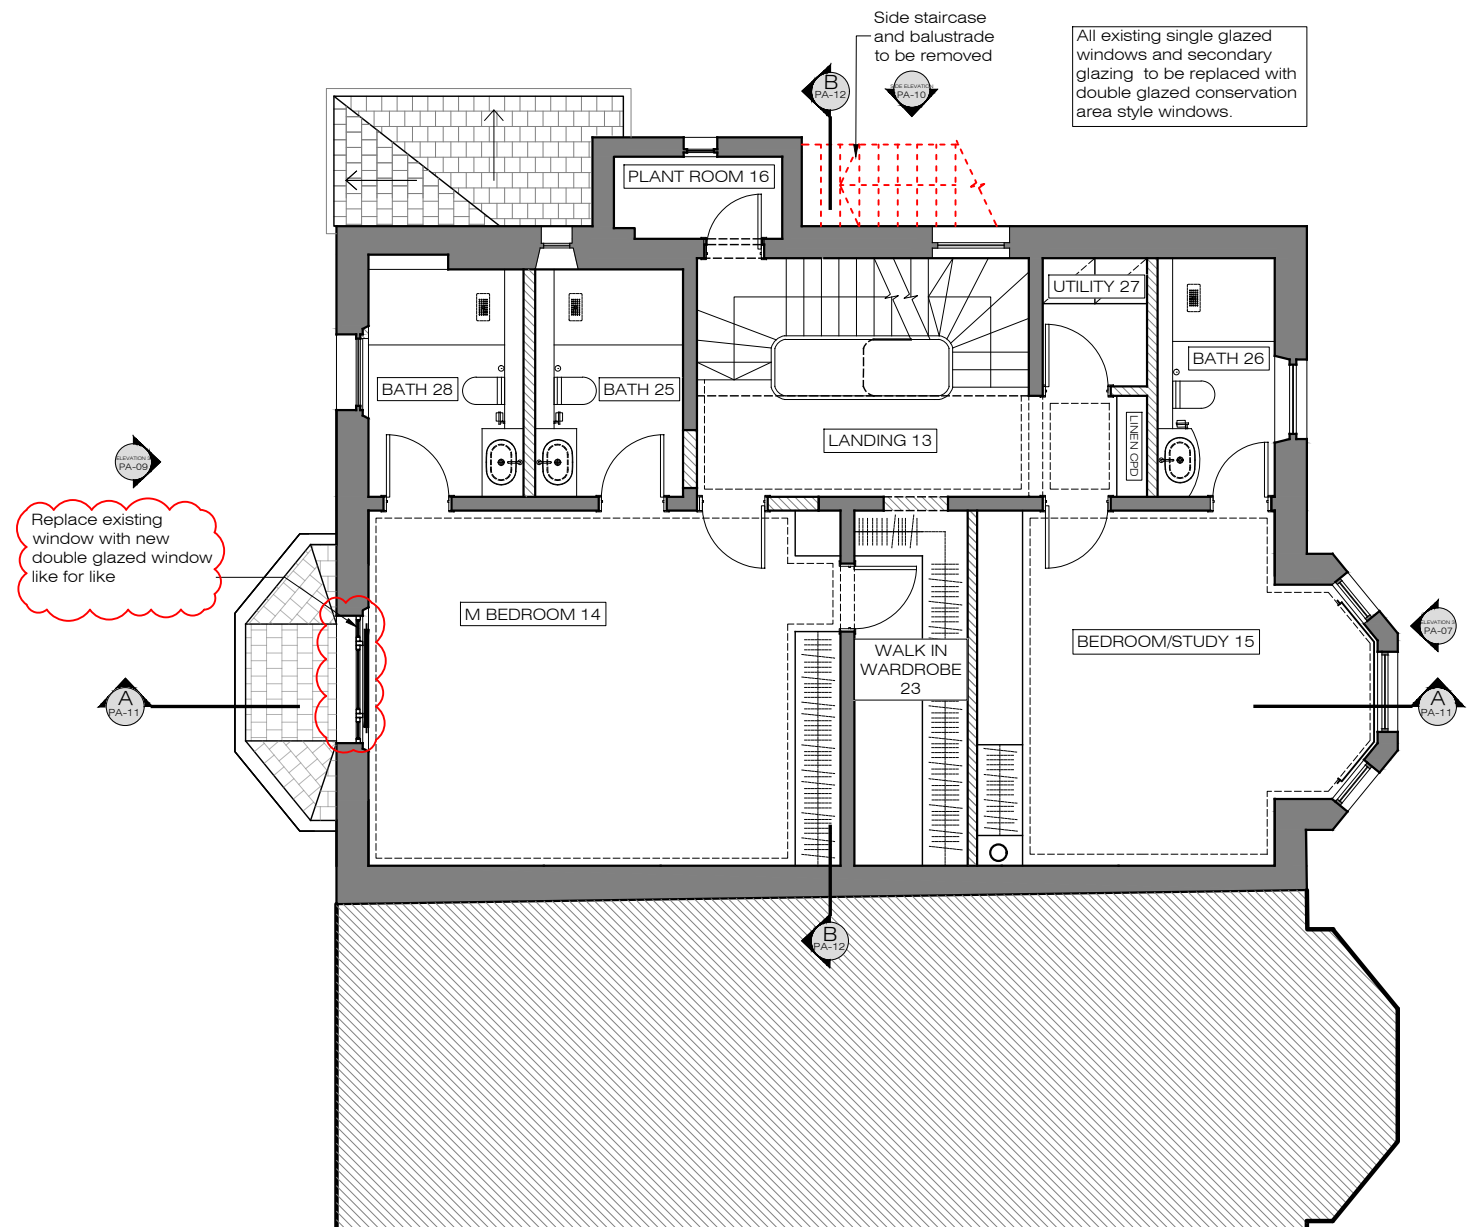

**X** PROPOSED  
First Floor Plan 1:100@A3

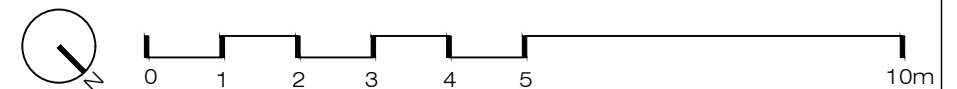

Ground Floor Office  
33 Belsize Lane  
London NW3 5AS  
Office: +44 (0) 207 431 9014  
info@xularchitecture.co.uk  
www.xularchitecture.co.uk

PLEASE NOTE:

1. All dimensions to be checked on site before fabrication,
2. Contractor to refer to engineers drawings before proceeding with works.
3. All drawings and designs are covered by design right (intellectual property), and may not be distributed, copied or issued without written permission by the Architect.
4. All design concepts are the sole property of the Architect and no adaptations, reproductions or copies may be made without written permission of the Architect.
5. These drawings are subject to any variation required or recommendation by any statutory authority, or for the better carrying out of the works.
6. Samples to be provided by contractor for XUL Architecture's approval.
7. All finishes to XUL Architecture's satisfaction.
8. All drawings to be approved by XUL Architecture prior to construction.

ADDITIONAL NOTE:

Issue key:

Information (I)

Planning (P)

Tender (T)

Construction (C)

As Built (B)

Project Address

27 Thurlow Road, NW3 5PP

Scale 1:100@A3

Rev. Date 26.04.24

Drawn SL

Checked IW

Existing and Proposed

First Floor Plan


Dwg. No. PA-03

Project Number 23152


Issue For:

Planning


Rev. P-02

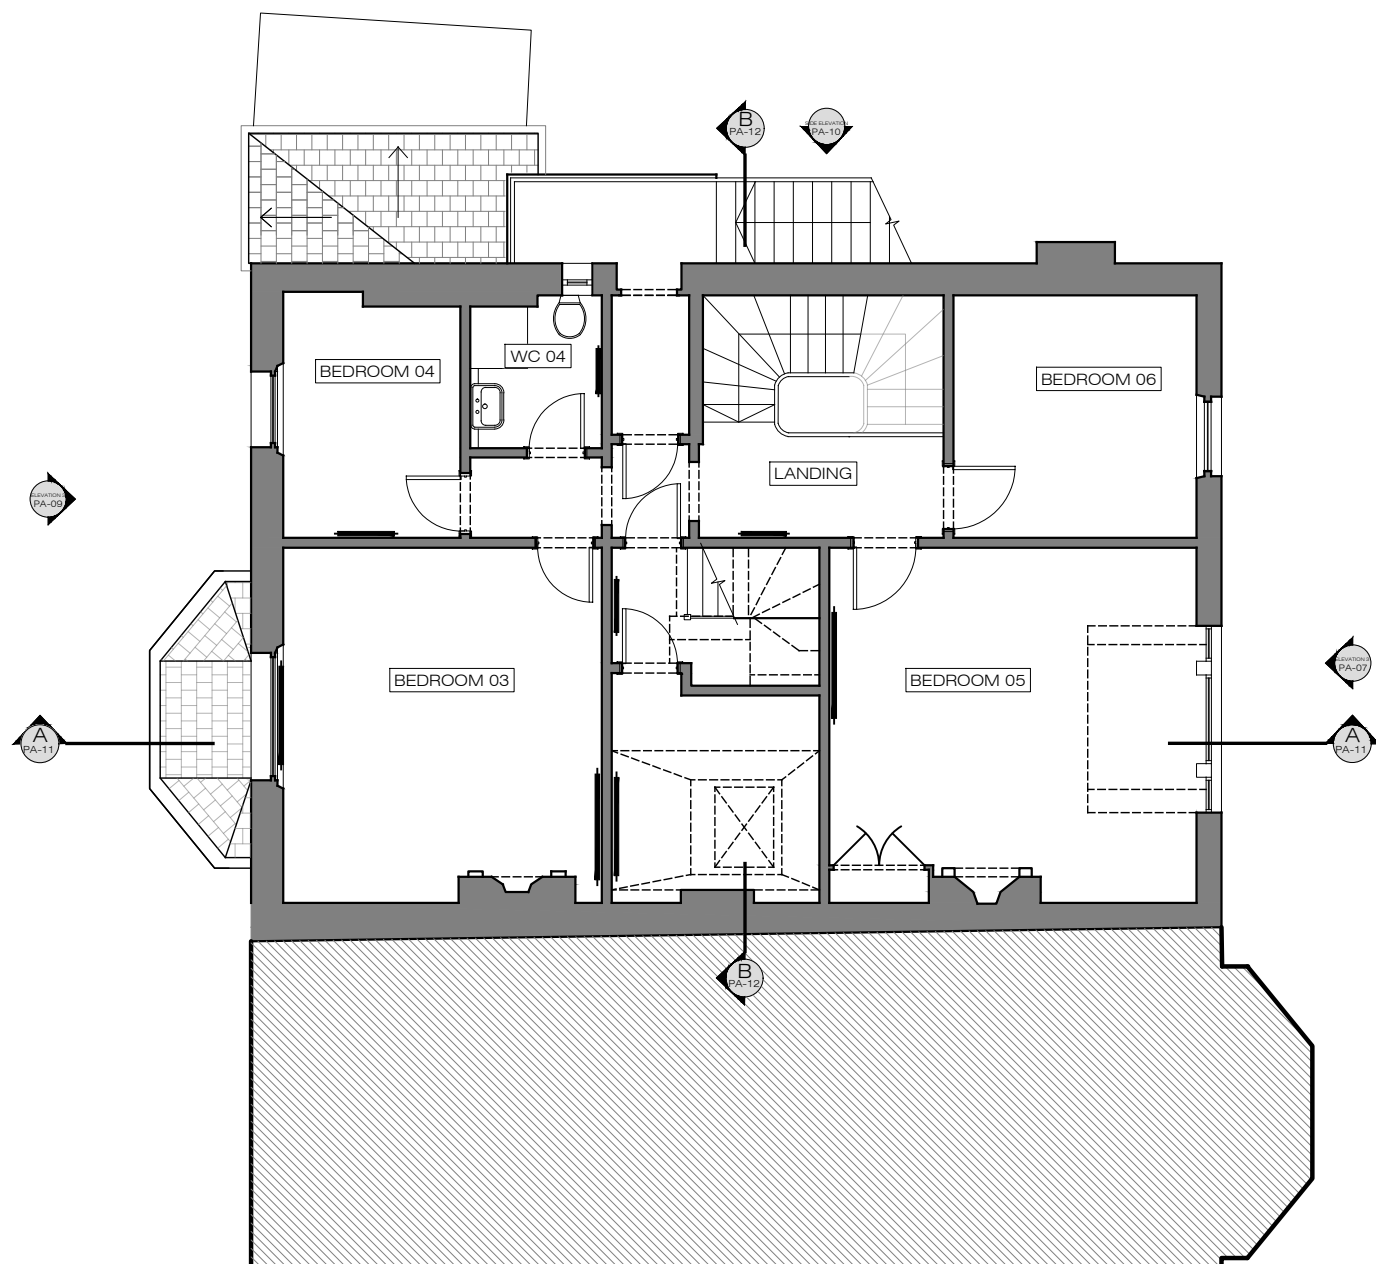

**X** EXISTING  
Second Floor Plan 1:100@A3

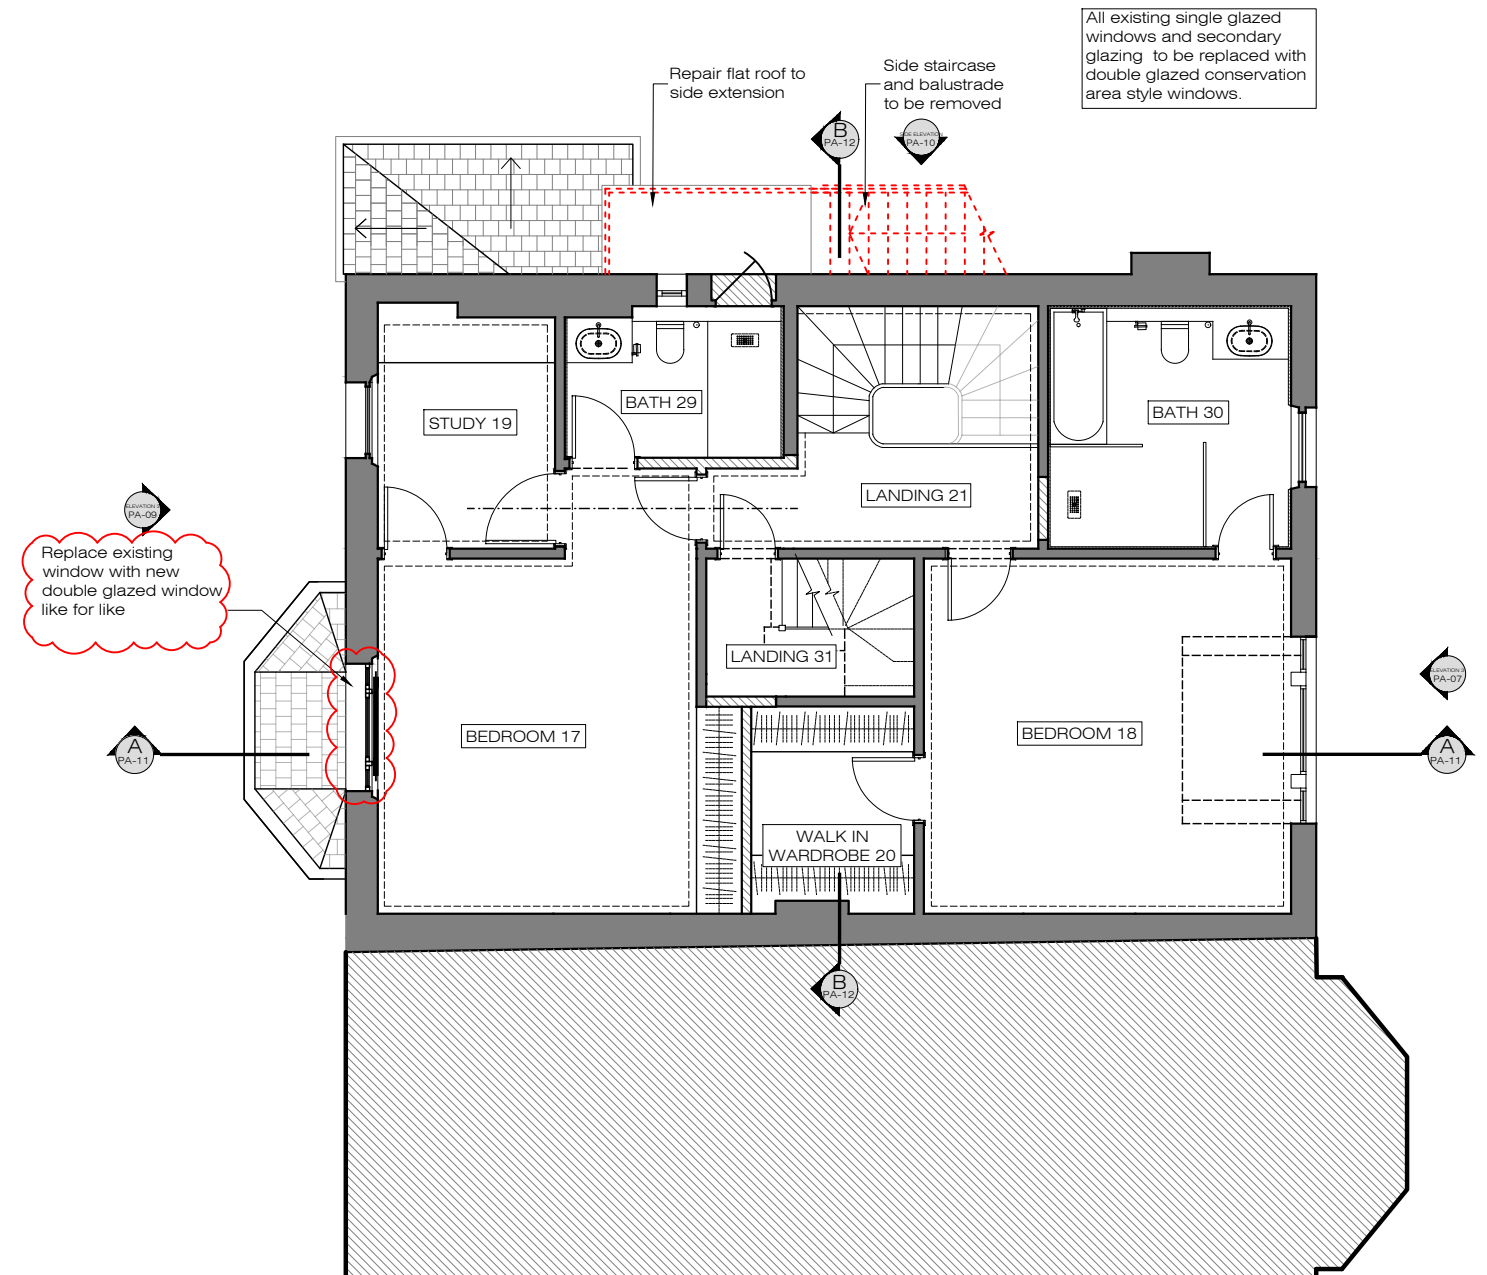

**X** PROPOSED  
Second Floor Plan 1:100@A3

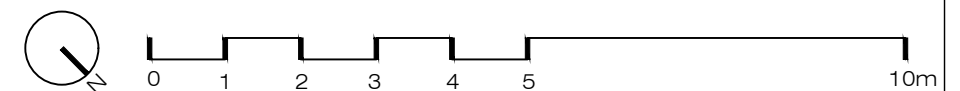

Ground Floor Office  
33 Belsize Lane  
London NW3 5AS  
Office: +44 (0) 207 431 9014  
info@xularchitecture.co.uk  
www.xularchitecture.co.uk

**PLEASE NOTE:**

- All dimensions to be checked on site before fabrication.
- Contractor to refer to engineers drawings before proceeding with works.
- All drawings and designs are covered by design right (intellectual property), and may not be distributed, copied or issued without written permission by the Architect.
- All design concepts are the sole property of the Architect and no adaptations, reproductions or copies may be made without written permission of the Architect.
- These drawings are subject to any variation required or recommendation by any statutory authority, or for the better carrying out of the works.
- Samples to be provided by contractor for XUL Architecture's approval.
- All finishes to XUL Architecture's satisfaction.
- All drawings to be approved by XUL Architecture prior to construction.

**ADDITIONAL NOTE:**

**Issue key:**

Information (I)  
Planning (P)  
Tender (T)  
Construction (C)  
As Built (B)

**Project Address**

27 Thurlow Road, NW3 5PP

Scale 1:100@A3

Rev. Date 26.04.24

Drawn SL

Checked IW

Existing and Proposed

Second Floor Plan


Dwg. No. PA-04

Project Number 23152


**Issue For:**

Planning

Rev. P-02

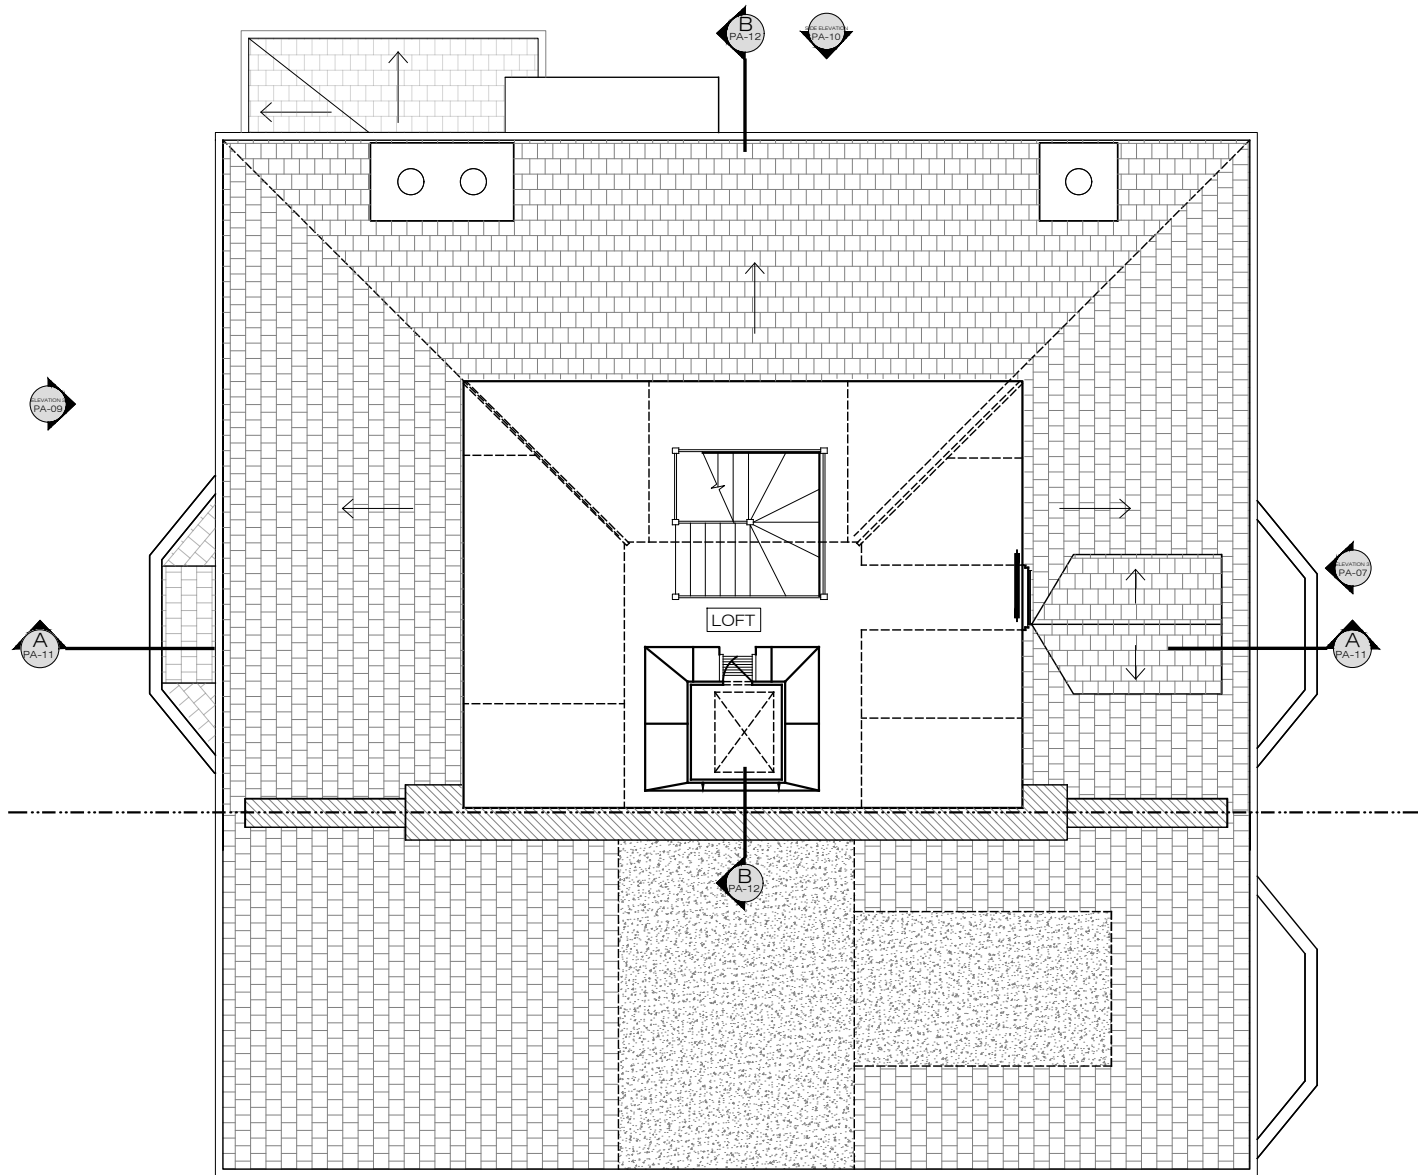


**X** EXISTING  
Loft Floor Plan 1:100@A3

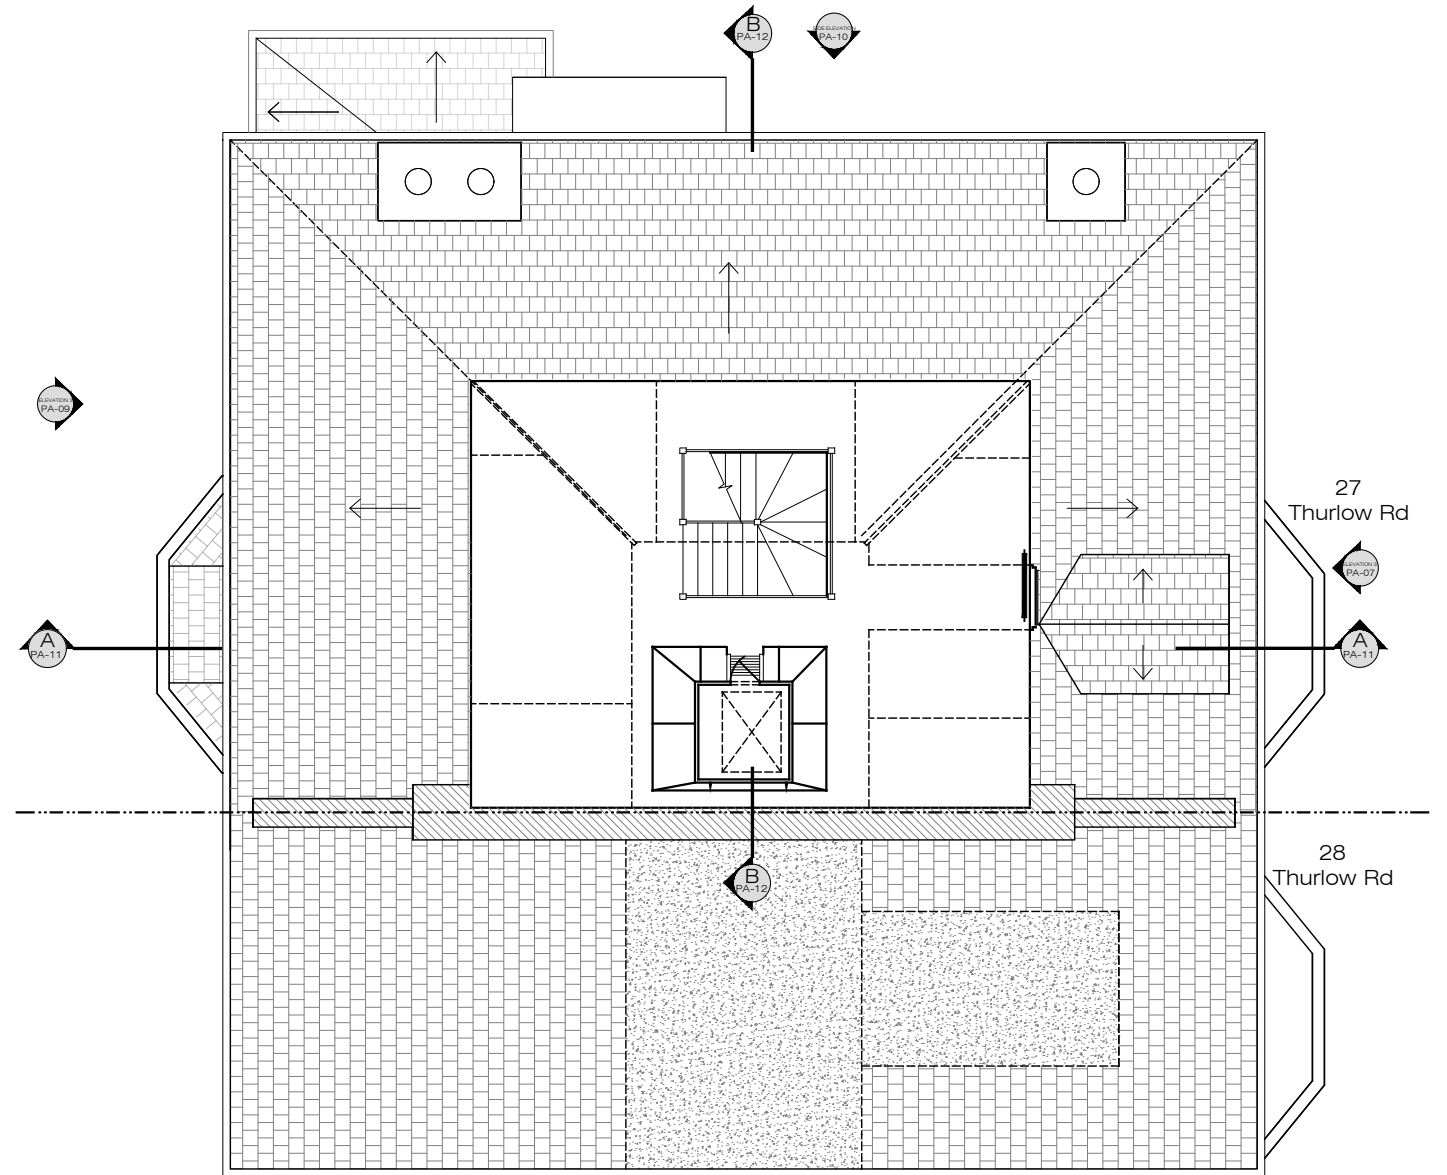

**X** PROPOSED  
Loft Floor Plan 1:100@A3

No alterations proposed  
at loft floor and roof level

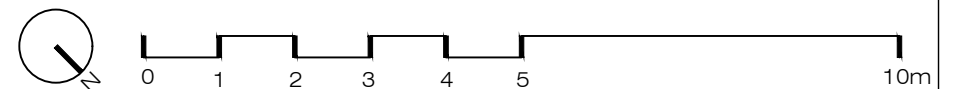

Ground Floor Office  
33 Belsize Lane  
London NW3 5AS  
Office: +44 (0) 207 431 9014  
info@xularchitecture.co.uk  
www.xularchitecture.co.uk

PLEASE NOTE:

1. All dimensions to be checked on site before fabrication.
2. Contractor to refer to engineers drawings before proceeding with works.
3. All drawings and designs are covered by design right (intellectual property), and may not be distributed, copied or issued without written permission by the Architect.
4. All design concepts are the sole property of the Architect and no adaptations, reproductions or copies may be made without written permission of the Architect.
5. These drawings are subject to any variation required or recommendation by any statutory authority, or for the better carrying out of the works.
6. Samples to be provided by contractor for XUL Architecture's approval.
7. All finishes to XUL Architecture's satisfaction.
8. All drawings to be approved by XUL Architecture prior to construction.

ADDITIONAL NOTE:

Issue key:

Information (I)

Planning (P)

Tender (T)

Construction (C)

As Built (B)

Project Address

27 Thurlow Road, NW3 5PP

Scale 1:100@A3

Rev. Date 10.04.24

Drawn SL

Checked IW

Existing and Proposed

Loft Floor Plan


Dwg. No. PA-05

Project Number 23152


Issue For:

Planning

Rev. P-01

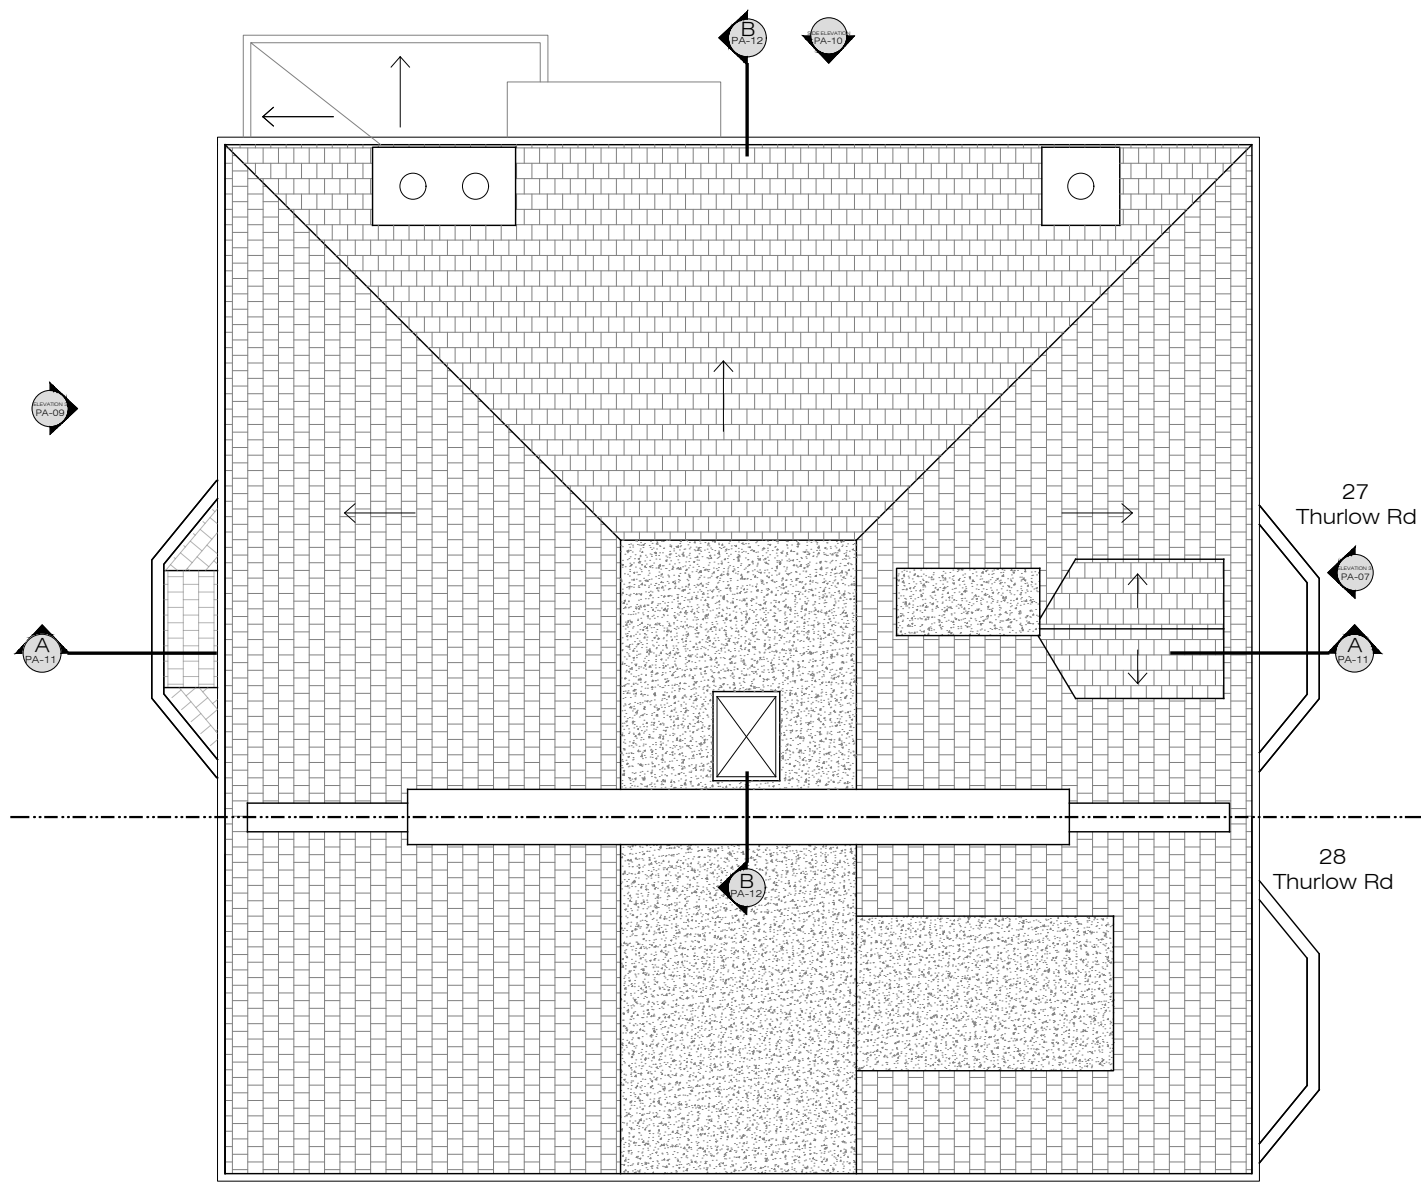


**X** EXISTING  
Roof Plan  
1:100@A3

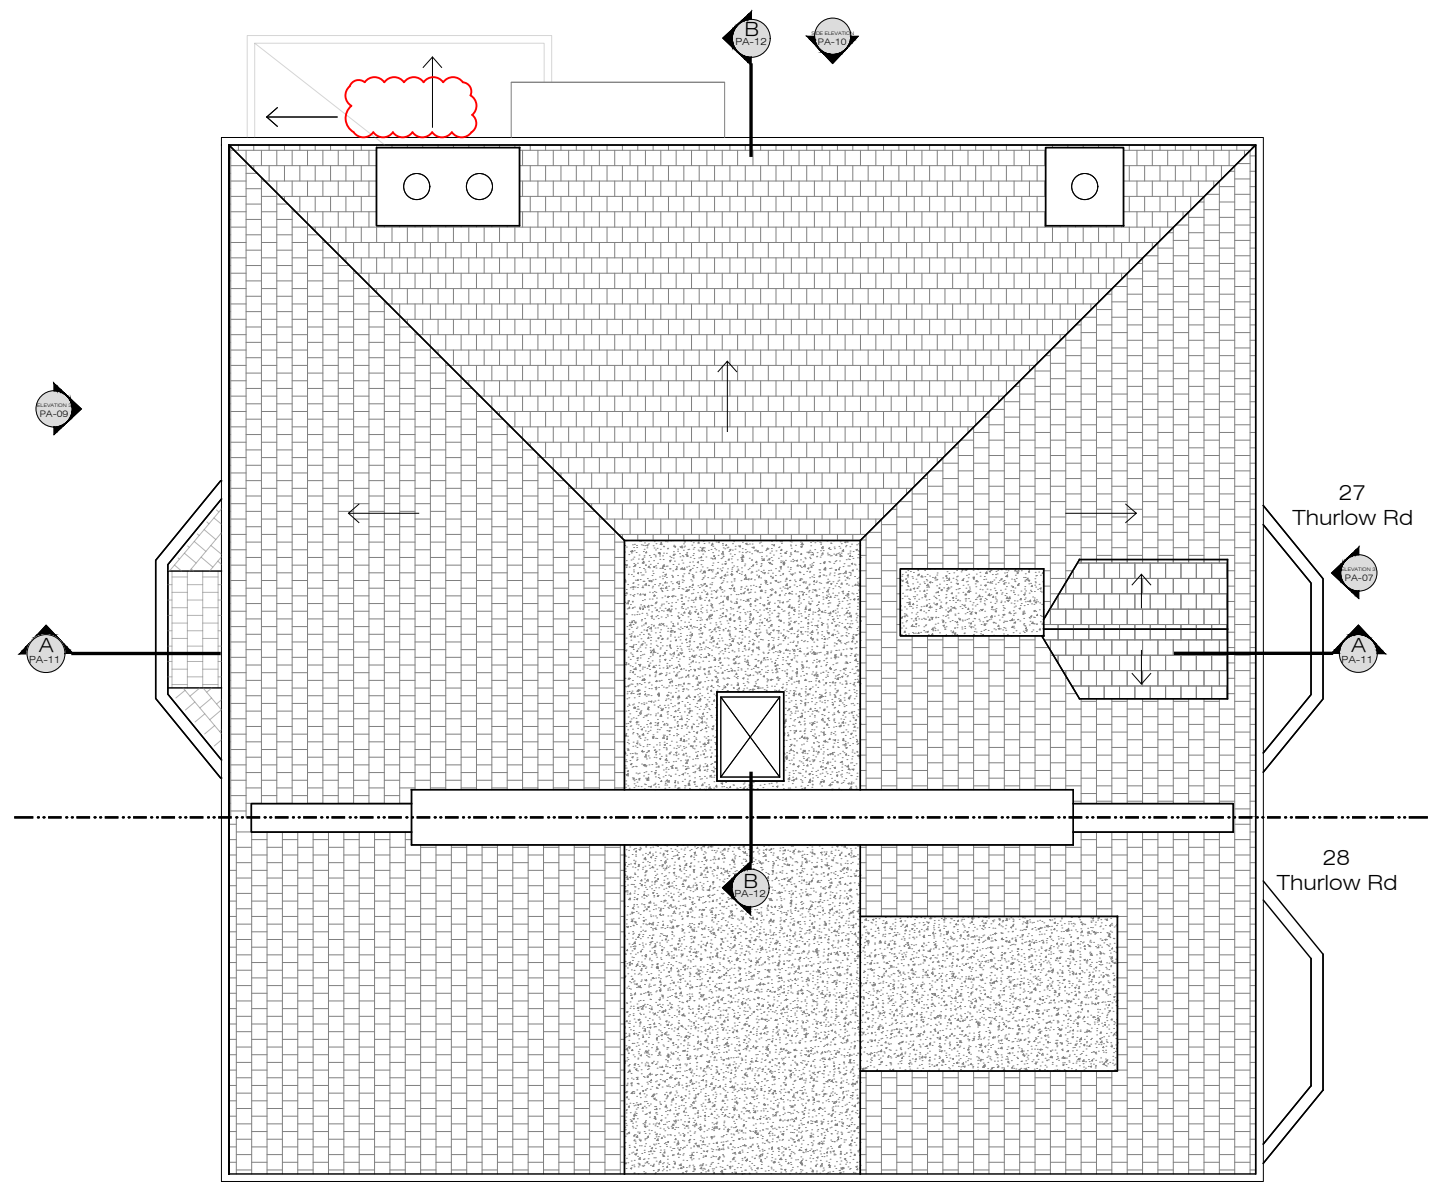

**X** PROPOSED  
Roof Plan  
1:100@A3

No alterations proposed  
at loft floor and roof level

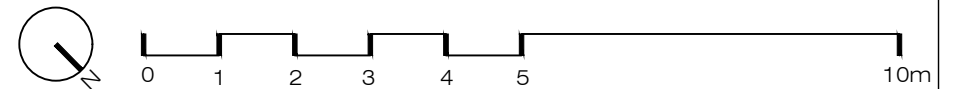

**XUL**  
ARCHITECTURE

Ground Floor Office  
33 Belsize Lane  
London NW3 5AS  
Office: +44 (0) 207 431 9014  
info@xularchitecture.co.uk  
www.xularchitecture.co.uk

PLEASE NOTE:

1. All dimensions to be checked on site before fabrication.
2. Contractor to refer to engineers drawings before proceeding with works.
3. All drawings and designs are covered by design right (intellectual property), and may not be distributed, copied or issued without written permission by the Architect.
4. All design concepts are the sole property of the Architect and no adaptations, reproductions or copies may be made without written permission of the Architect.
5. These drawings are subject to any variation required or recommendation by any statutory authority, or for the better carrying out of the works.
6. Samples to be provided by contractor for XUL Architecture's approval.
7. All finishes to XUL Architecture's satisfaction.
8. All drawings to be approved by XUL Architecture prior to construction.

ADDITIONAL NOTE:

Issue key:

Information (I)

Planning (P)

Tender (T)

Construction (C)

As Built (B)

Project Address

27 Thurlow Road, NW3 5PP

Scale 1:100@A3

Rev. Date 10.04.24

Drawn SL

Checked IW

Existing and Proposed

Roof Plan

Dwg. No. PA-06

Project Number

Issue For:

Planning

Rev. P-01


Rev. P-01

Rev. P-01


Rev. P-01



**X** EXISTING  
Front Elevation 1:100@A3

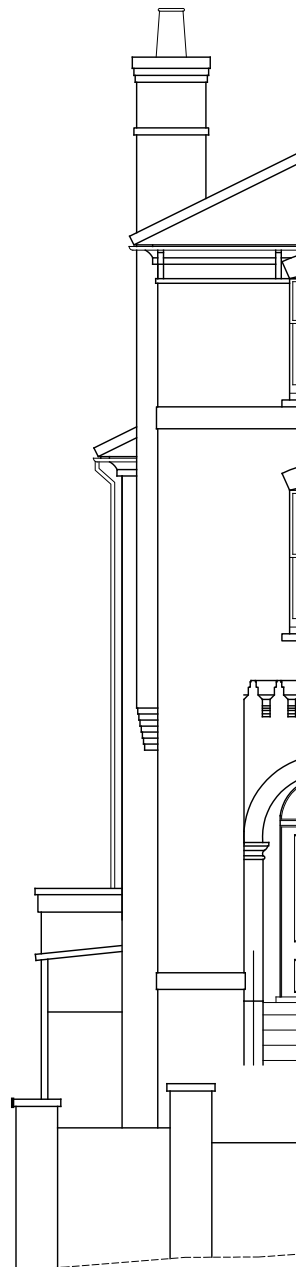

**X** PROPOSED  
Front Elevation 1:100@A3

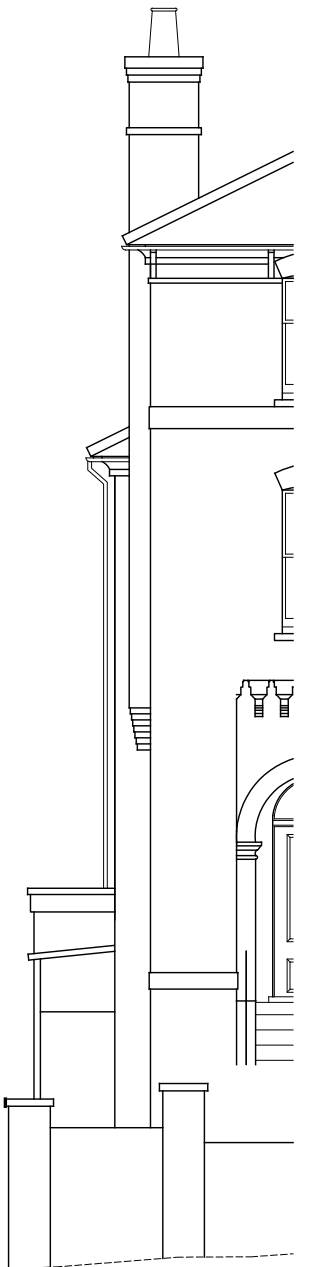


- NOTES :
1. All exterior doors to be replaced with new doors
  2. All existing windows and secondary glazing to be replaced for double glazed (Conservation Area style)
  3. Ground and Basement floor window security bars to be removed and replaced with new security bars design

Pointing as necessary and repairs to damaged brickwork.

New Door to match existing

Existing security bars to be replaced with new security bars with 3 nos horizontal bars painted white

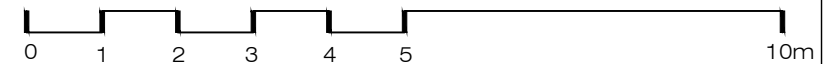

Ground Floor Office  
33 Belsize Lane  
London NW3 5AS  
Office: +44 (0) 207 431 9014  
info@xularchitecture.co.uk  
www.xularchitecture.co.uk

PLEASE NOTE:

1. All dimensions to be checked on site before fabrication,
2. Contractor to refer to engineers drawings before proceeding with works.
3. All drawings and designs are covered by design right (intellectual property), and may not be distributed, copied or issued without written permission by the Architect.
4. All design concepts are the sole property of the Architect and no adaptations, reproductions or copies may be made without written permission of the Architect.
5. These drawings are subject to any variation required or recommendation by any statutory authority, or for the better carrying out of the works.
6. Samples to be provided by contractor for XUL Architecture's approval.
7. All finishes to XUL Architecture's satisfaction.
8. All drawings to be approved by XUL Architecture prior to construction.

ADDITIONAL NOTE:

Issue key:

Information (I)  
Planning (P)  
Tender (T)  
Construction (C)  
As Built (B)

Project Address

27 Thurlow Road, NW3 5PP

Scale 1:100@A3

Rev. Date 10.04.24

Drawn SL

Checked IW

Existing and Proposed

Front Elevation

Dwg. No. PA-07 Rev. P-01

Project Number 23152

Issue For:


Planning



**X** EXISTING  
Front Elevation  
1:100@A3



**X** PROPOSED  
Front Elevation  
1:100@A3

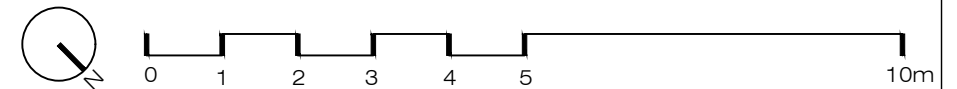

Ground Floor Office  
33 Belsize Lane  
London NW3 5AS  
Office: +44 (0) 207 431 9014  
info@xularchitecture.co.uk  
www.xularchitecture.co.uk

PLEASE NOTE:

1. All dimensions to be checked on site before fabrication,
2. Contractor to refer to engineers drawings before proceeding with works.
3. All drawings and designs are covered by design right (intellectual property), and may not be distributed, copied or issued without written permission by the Architect.
4. All design concepts are the sole property of the Architect and no adaptations, reproductions or copies may be made without written permission of the Architect.
5. These drawings are subject to any variation required or recommendation by any statutory authority, or for the better carrying out of the works.
6. Samples to be provided by contractor for XUL Architecture's approval.
7. All finishes to XUL Architecture's satisfaction.
8. All drawings to be approved by XUL Architecture prior to construction.

ADDITIONAL NOTE:

Issue key:

Information (I)

Planning (P)

Tender (T)

Construction (C)

As Built (B)

Project Address

27 Thurlow Road, NW3 5PP

Scale 1:100@A3

Rev. Date 10.04.24

Drawn SL

Checked IW

Existing and Proposed

Front Elevation (street view)

Dwg. No. PA-08 Rev. P-01


Project Number 23152

Issue For:


Planning



**X** EXISTING  
Rear Elevation 1:100@A3

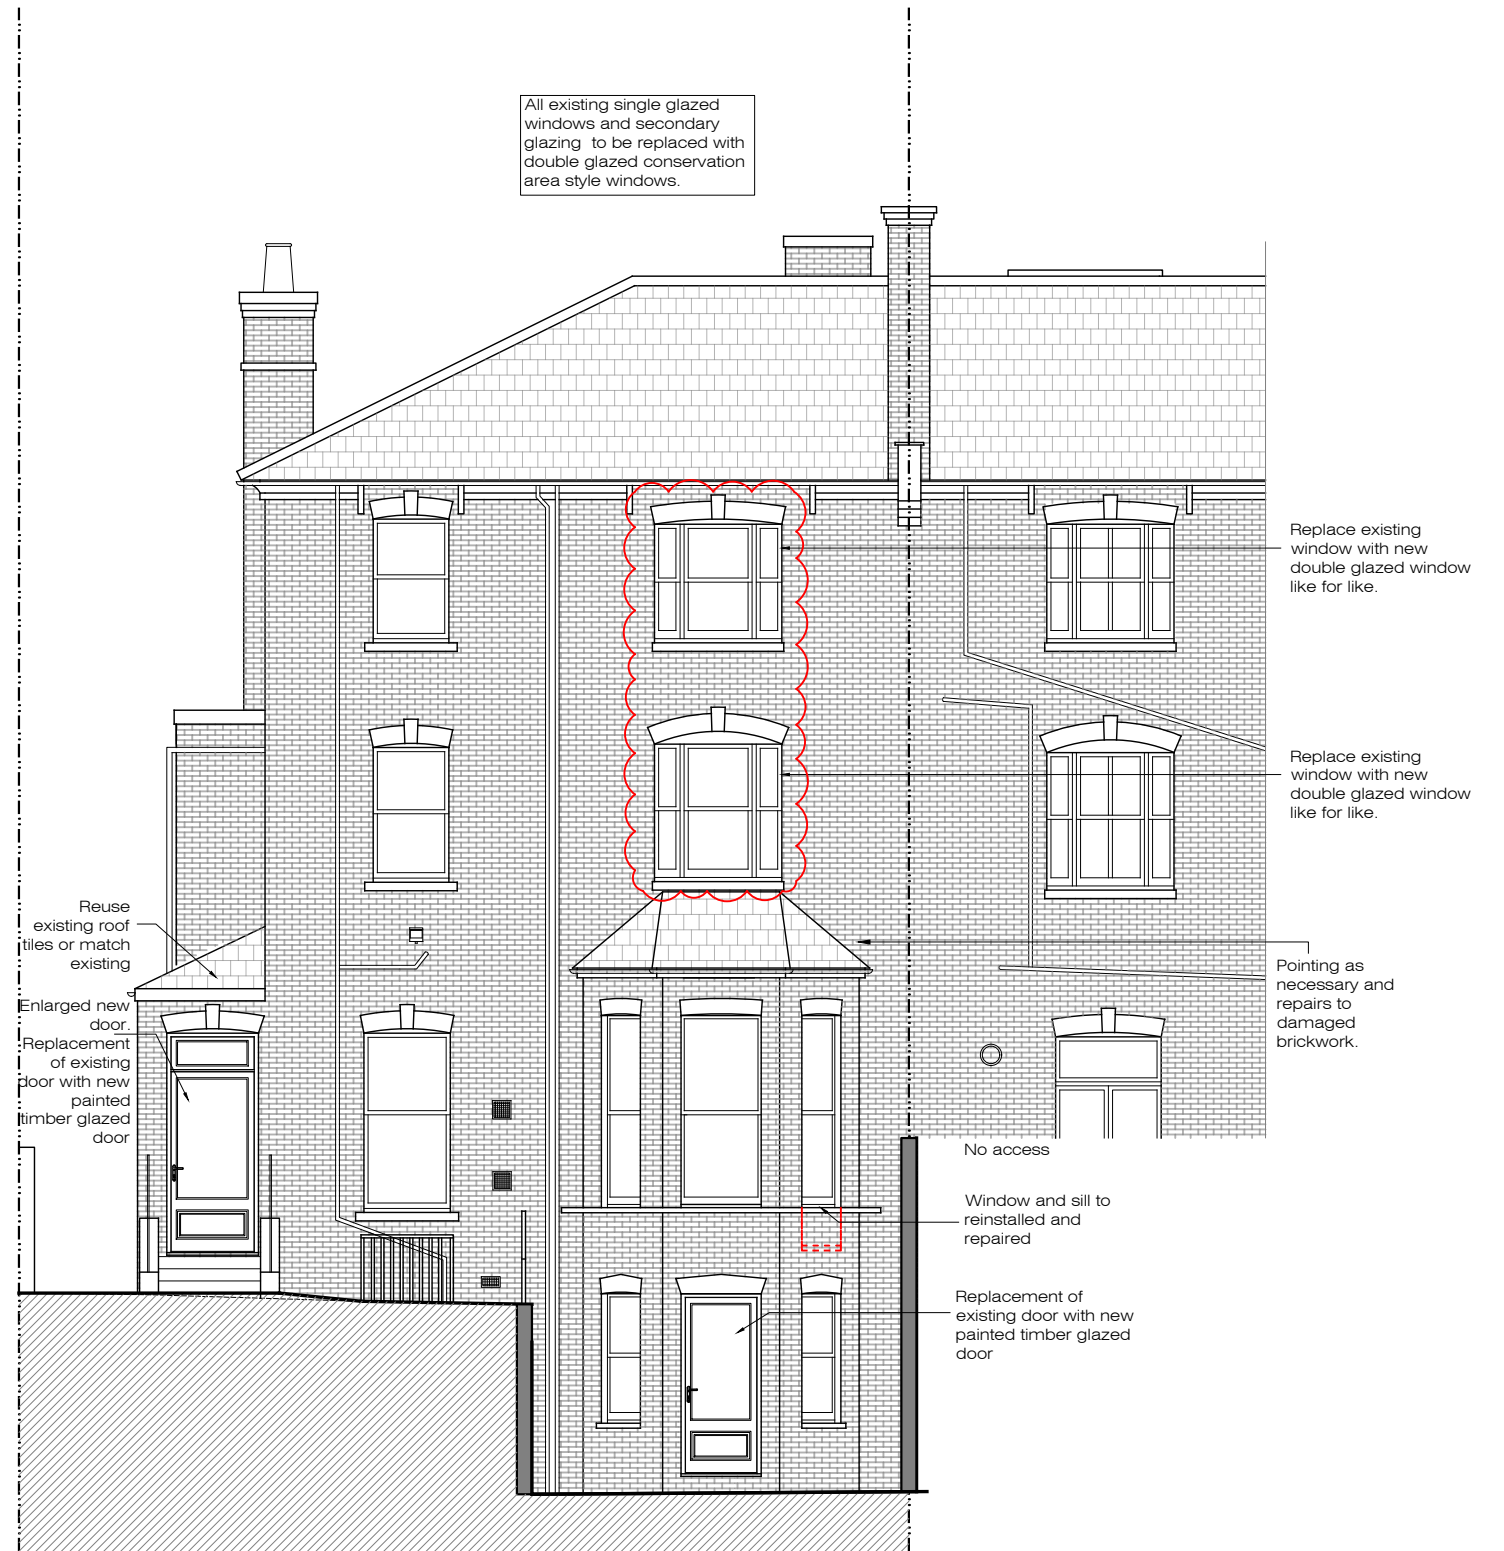

**X** PROPOSED  
Rear Elevation 1:100@A3

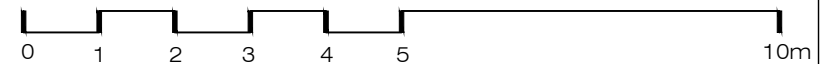

**PLEASE NOTE:**

- All dimensions to be checked on site before fabrication.
- Contractor to refer to engineers drawings before proceeding with works.
- All drawings and designs are covered by design right (intellectual property), and may not be distributed, copied or issued without written permission by the Architect.
- All design concepts are the sole property of the Architect and no adaptations, reproductions or copies may be made without written permission of the Architect.
- These drawings are subject to any variation required or recommendation by any statutory authority, or for the better carrying out of the works.
- Samples to be provided by contractor for XUL Architecture's approval.
- All finishes to XUL Architecture's satisfaction.
- All drawings to be approved by XUL Architecture prior to construction.

**ADDITIONAL NOTE:**

**Issue key:**

Information (I)  
Planning (P)  
Tender (T)  
Construction (C)  
As Built (B)

**Project Address**

27 Thurlow Road, NW3 5PP

Scale 1:100@A3

Rev. Date 26.04.24

Drawn SL

Checked IW

Existing and Proposed

Rear Elevation

Dwg. No. PA-09

Project Number

**Issue For:**


Planning

Rev. P-02

Rev. P-02

Rev. P-02

Rev. P-02

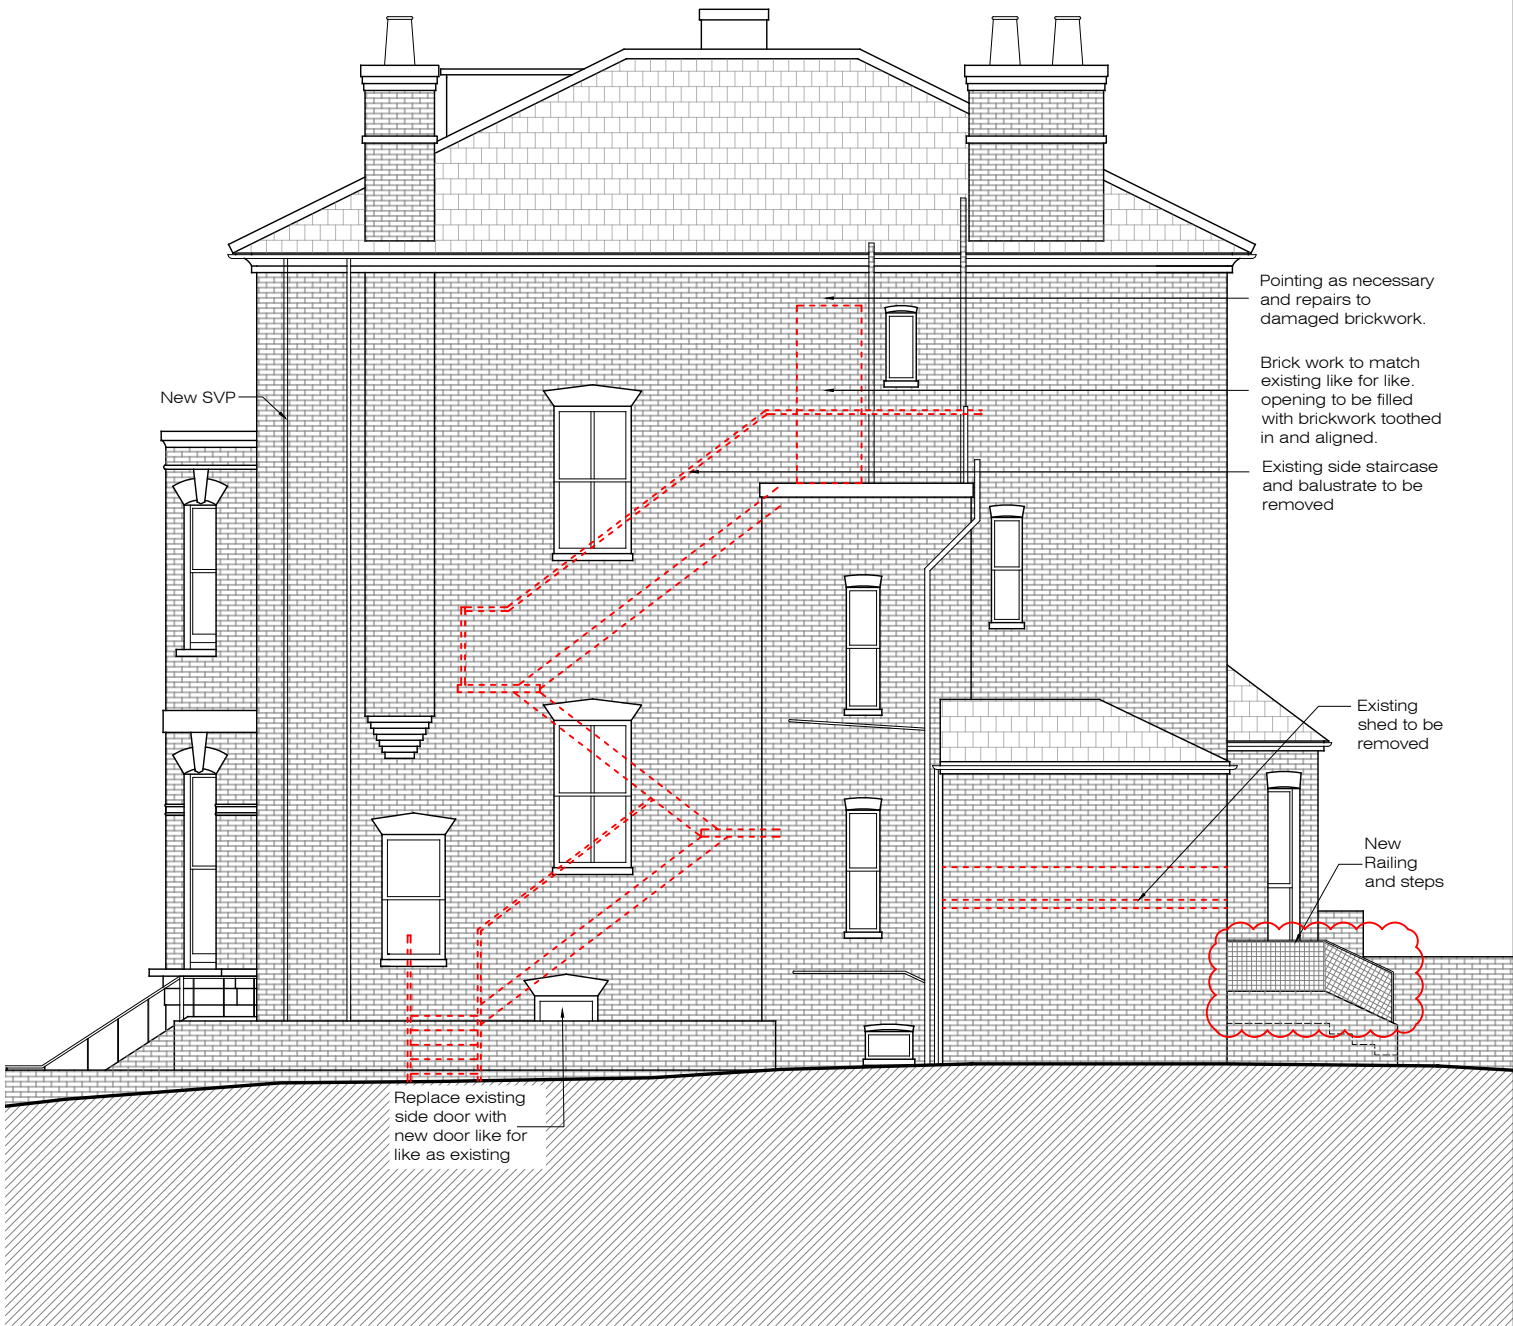

All existing single glazed windows and secondary glazing to be replaced with double glazed conservation area style windows.

Pointing as necessary and repairs to damaged brickwork.

Brick work to match existing like for like. opening to be filled with brickwork toothed in and aligned.

Existing side staircase and balustrade to be removed


Existing shed to be removed

New Railing and steps

Replace existing side door with new door like for like as existing

**X** EXISTING  
Side Elevation 1:100@A3

**X** PROPOSED  
Side Elevation 1:100@A3

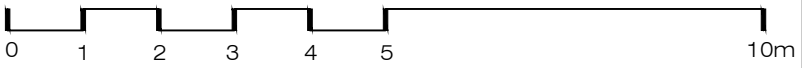

Ground Floor Office  
33 Belsize Lane  
London NW3 5AS  
Office: +44 (0) 207 431 9014  
info@xularchitecture.co.uk  
www.xularchitecture.co.uk

PLEASE NOTE:

1. All dimensions to be checked on site before fabrication,
2. Contractor to refer to engineers drawings before proceeding with works.
3. All drawings and designs are covered by design right (intellectual property), and may not be distributed, copied or issued without written permission by the Architect.
4. All design concepts are the sole property of the Architect and no adaptations, reproductions or copies may be made without written permission of the Architect.
5. These drawings are subject to any variation required or recommendation by any statutory authority, or for the better carrying out of the works.
6. Samples to be provided by contractor for XUL Architecture's approval.
7. All finishes to XUL Architecture's satisfaction.
8. All drawings to be approved by XUL Architecture prior to construction.

ADDITIONAL NOTE:

Issue key: Information (I) Planning (P) Tender (T) Construction (C) As Built (B)	Project Address 27 Thurlow Road, NW3 5PP		Issue For: Planning	
	Scale	1:100@A3	Existing and Proposed	
	Rev. Date	10.04.24	Side Elevation	
	Drawn	SL	Dwg. No.	PA-10 Rev. P-01
	Checked	IW	Project Number	23152